

# WOODLINKS VILLAGE - STAGE 16

## COLLINGWOOD DRIVE, COLLINGWOOD PARK

### FOR 'CANBERRA ESTATES CONSORTIUM NO. 36 PTY LIMITED'

#### DRAWING LIST



19-0023-100 COVER PLAN

#### EARTHWORKS, ROADWORKS AND DRAINAGE

- 19-0023-101 GENERAL NOTES
- 19-0023-102 BULK EARTHWORKS LAYOUT PLAN
- 19-0023-103 BULK EARTHWORKS TYPICAL SECTIONS SHEET 1 OF 2
- 19-0023-104 BULK EARTHWORKS TYPICAL SECTIONS SHEET 2 OF 2
- 19-0023-105 ROADWORKS AND DRAINAGE LAYOUT PLAN
- 19-0023-106 SURVEY SETOUT AND KERB TYPES LAYOUT PLAN
- 19-0023-107 PERIDOT STREET LONGITUDINAL SECTION AND CROSS SECTIONS
- 19-0023-108 ELDER PARADE LONGITUDINAL SECTION AND CROSS SECTIONS
- 19-0023-109 ELDER PARADE CROSS SECTIONS
- 19-0023-110 QUARTZ ROAD LONGITUDINAL SECTION AND CROSS SECTIONS
- 19-0023-111 QUARTZ ROAD CROSS SECTIONS
- 19-0023-112 CARNELIAN CRESCENT LONGITUDINAL SECTIONS AND CROSS SECTIONS
- 19-0023-113 INTERSECTION DETAILS LAYOUT PLAN SHEET 1 OF 2
- 19-0023-114 INTERSECTION DETAILS LAYOUT PLAN SHEET 2 OF 2
- 19-0023-115 SIGNS AND LINEMARKING LAYOUT PLAN
- 19-0023-116 STORMWATER DRAINAGE CATCHMENT LAYOUT PLAN
- 19-0023-117 STORMWATER DRAINAGE LONGITUDINAL SECTIONS SHEET 1 OF 2
- 19-0023-118 STORMWATER DRAINAGE LONGITUDINAL SECTIONS SHEET 2 OF 2
- 19-0023-119 STORMWATER DRAINAGE CALCULATIONS TABLE SHEET 1 OF 2
- 19-0023-120 STORMWATER DRAINAGE CALCULATIONS TABLE SHEET 2 OF 2
- 19-0023-121 STORMWATER DRAINAGE STRUCTURE DETAILS
- 19-0023-130 BULK EARTHWORKS SPOIL AREA LAYOUT PLAN

#### SEWERAGE AND WATER RETICULATION

- 19-0023-300 SEWERAGE RETICULATION COVER PLAN
- 19-0023-301 SEWERAGE RETICULATION LAYOUT PLAN SHEET 1 OF 2
- 19-0023-302 SEWERAGE RETICULATION LAYOUT PLAN SHEET 2 OF 2
- 19-0023-303 SEWERAGE RETICULATION LONGITUDINAL SECTIONS - SHEET 1 OF 3
- 19-0023-304 SEWERAGE RETICULATION LONGITUDINAL SECTIONS - SHEET 2 OF 3
- 19-0023-305 SEWERAGE RETICULATION LONGITUDINAL SECTIONS - SHEET 3 OF 3
- 19-0023-306 WATER RETICULATION COVER PLAN
- 19-0023-307 WATER RETICULATION LAYOUT PLAN

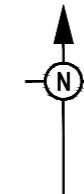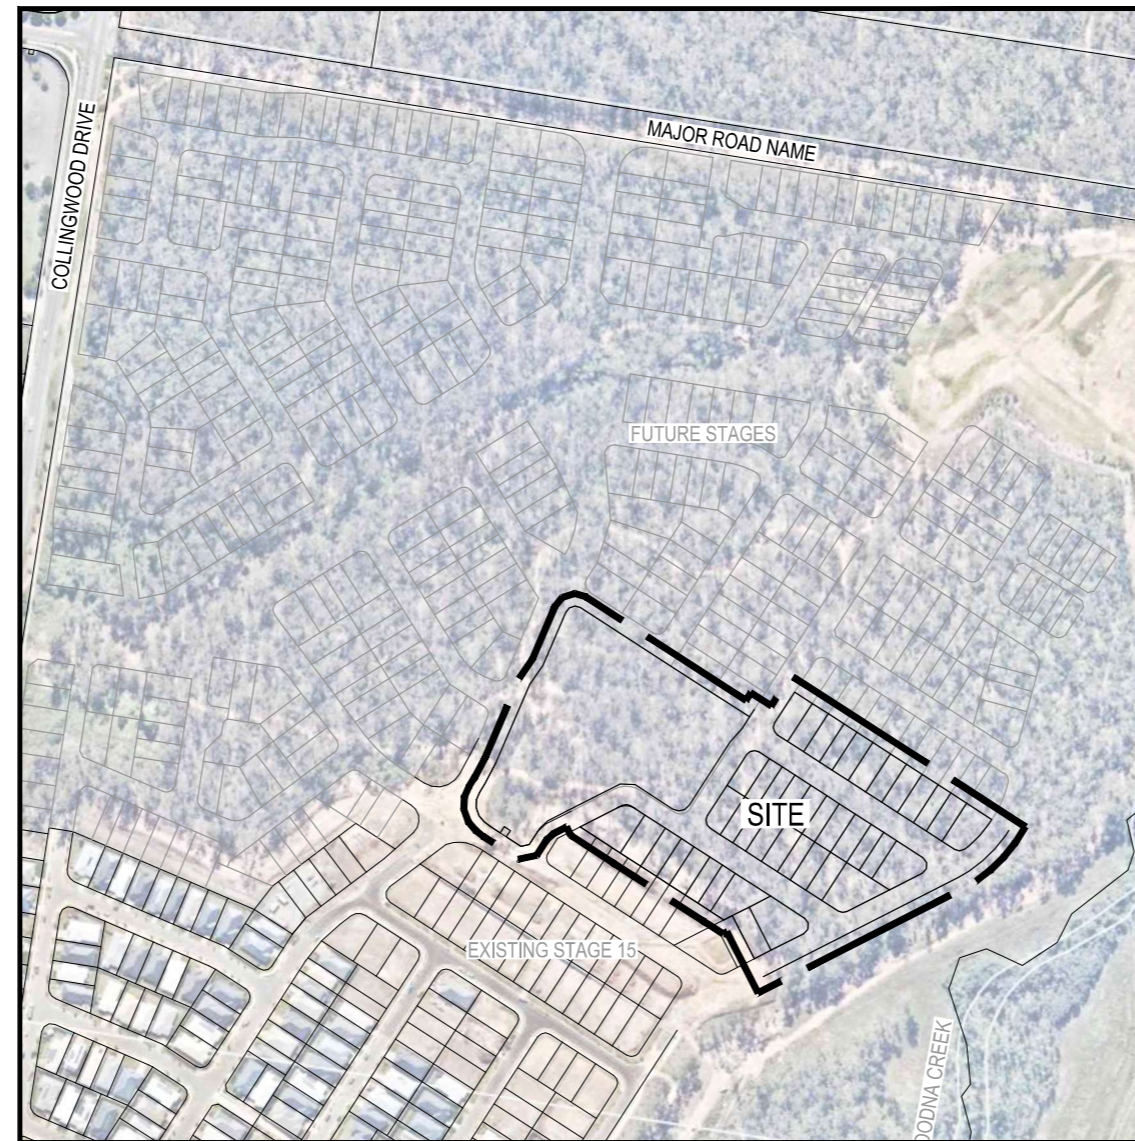

PROJECT INFORMATION SUMMARY:	
No. OF LOTS =	42
AREA OF SITE =	4.8 ha
RP DESCRIPTION	LOT 5507 ON SP266999
DATUM LEVEL AND LOCATION	P.M. 110122 RL 40.320 AHD
LOCAL AUTHORITY:	IPSWICH CITY COUNCIL
COUNCIL REFERENCE NUMBER:	4280/15/MAMC/A

NOTE:	
THESE DRAWINGS ARE TO BE READ IN CONJUNCTION WITH:	
-	VEGETATION MANAGEMENT PLAN
-	LANDSCAPE ARCHITECT'S PLANS
-	ELECTRICAL, COMMUNICATIONS AND GAS CONSULTANT'S PLANS
-	SEDIMENT AND EROSION HAZARD ASSESSMENT
-	SAFETY IN DESIGN REPORT

**AS-CONSTRUCTED CERTIFICATION**  
 Signature: \_\_\_\_\_ Date: 26/06/20  
 ANDREW NGO RPEQ No. 12329  
 For and on behalf of Peakurban PTY LTD

LOCALITY PLAN  
 SCALE 1:2500 (A1)  
 SCALE 1:5000 (A3)

REV	DATE	DESIGN	DRAWN	REVISION DETAILS	DRAWN	STATUS	SCALE	CLIENT	PROJECT NAME	DRAWING TITLE
A	02.12.19	AC	CL	ISSUED FOR CONSTRUCTION						
B	22.05.20	TD	SC	AS CONSTRUCTED	TD	<b>AS CONSTRUCTED</b>	1:2500 50 0 50 100 A1 1:5000	<b>CANBERRA ESTATES CONSORTIUM NO. 36 PTY LIMITED</b>	<b>WOODLINKS VILLAGE - STAGE 16</b>	<b>COVER PLAN</b>
					DESIGN	APPROVED ANDREW NGO RPEQ 12329		ASSOCIATED CONSULTANT SAUNDERS HAVILL GROUP PH: 1300 123 744	COLLINGWOOD DRIVE, COLLINGWOOD PARK	PROJECT No. <b>19-0023</b>
						FOR AND ON BEHALF OF PEAKURBAN PTY LTD				DRAWING No. <b>100</b>
										REVISION <b>B</b>

**GENERAL NOTES:**

- THE CONTRACTOR SHALL SUPPLY ALL LABOR, MATERIALS, PLANT AND EQUIPMENT TO CONSTRUCT THE WORKS AS DOCUMENTED AND STRICTLY IN ACCORDANCE WITH THE RELEVANT AUTHORITY STANDARDS, SPECIFICATIONS AND REQUIREMENTS.
- THE EXISTING SERVICES THAT ARE SHOWN ON THE DRAWINGS ARE PROVIDED FOR INFORMATION PURPOSES ONLY. NO RESPONSIBILITY IS TAKEN BY THE SUPERINTENDENT OR THE PRINCIPAL FOR INFORMATION THAT HAS BEEN SUPPLIED BY OTHERS, OR ANY EXISTING SERVICES THAT MAY BE PRESENT NOT SHOWN ON THE DRAWINGS. THE CONTRACTOR SHALL VERIFY THE POSITION OF ANY UNDERGROUND SERVICES WITHIN THE AREAS OF WORKS AND SHALL BE RESPONSIBLE FOR MAKING GOOD ANY DAMAGE THERETO. ANY ALTERATION WORKS TO SERVICES WILL BE CARRIED OUT ONLY BY THE SERVICE OWNER AUTHORITY UNLESS APPROVED OTHERWISE.
- ALL CONSTRUCTION ACTIVITIES UNDERTAKEN SHALL COMPLY WITH CURRENT WORKPLACE HEALTH AND SAFETY REQUIREMENTS AND LEGISLATION.
- PRIOR TO COMMENCING WORK, THE CONTRACTOR IS RESPONSIBLE FOR OBTAINING ALL RELEVANT LOCAL AUTHORITY PERMITS.
- THE CONTRACTOR SHALL NOT COMMENCE THE DEMOLITION OF ANY EXISTING BUILDINGS AND/OR STRUCTURES WITHOUT APPROVAL FROM THE SUPERINTENDENT.
- THE CONTRACTOR SHALL APPLY INDUSTRY BEST PRACTICE SO WORKS SHALL NOT DISTURB OR AFFECT NEARBY RESIDENTS EITHER BY DUST, NOISE, FLOODING OR DISCONNECTION OF SERVICES. CONTRACTOR TO ENSURE THAT ACCESS AND SERVICES TO EXISTING PROPERTIES ARE AVAILABLE AT ALL TIMES.
- THE CONTRACTOR SHALL VERIFY LEVELS OF EXISTING SERVICE CROSSINGS AND CONNECTION POINTS PRIOR TO COMMENCEMENT OF WORKS AND NOTIFY SUPERINTENDENT OF ANY DISCREPANCIES BETWEEN ACTUAL AND PROPOSED DESIGN LEVELS.
- THESE ENGINEERING DRAWINGS ARE TO BE READ IN CONJUNCTION WITH THE APPROVED VEGETATION MANAGEMENT PLAN, WHERE APPLICABLE. WHEN IN DOUBT, ALL EXISTING TREES ARE TO REMAIN UNLESS DIRECTED OTHERWISE.
- HOLD POINT:** ONCE THE BASE OF MANHOLES, INSPECTION PITS, GULLIES AND FIELD INLETS FOR STORMWATER DRAINAGE AND SEWER RETICULATION HAVE BEEN POURED, CONSTRUCTION SHALL ONLY RE-COMMENCE ONCE THE SUPERINTENDENT AND/OR ENGINEER HAVE INSPECTED THE WORKS.
- THE CONTRACTOR SHALL NOTE DURING THE COURSE OF THE WORKS WHEN JOINT INSPECTIONS WITH THE AUTHORITY AND THE SUPERINTENDENT ARE REQUIRED. THESE INCLUDE PRE-STARTS, SUBGRADES, PRE-SEALS, CLEARING, AND OTHER SUCH INSPECTIONS AS NOMINATED IN THE APPROVAL AND THE SPECIFICATIONS. THE CONTRACTOR SHALL ENSURE NO WORKS PROCEED PAST THE INSPECTION POINT UNTIL THE JOINT INSPECTION HAS BEEN SUCCESSFULLY COMPLETED.
- THE CONTRACTOR SHALL BE RESPONSIBLE FOR PROVIDING A SAFE MOVEMENT OF TRAFFIC AND THE PROTECTION OF PERSON AND PROPERTY THROUGH AND AROUND THE SITE. THE CONTRACTOR IS RESPONSIBLE FOR ALL TRAFFIC MANAGEMENT INCLUDING THE DESIGN, CONSTRUCTION, MAINTENANCE AND REMOVAL OF TEMPORARY ROADWAYS, DETOURS, SIGNS, LIGHTS AND BARRIER AS REQUIRED STRICTLY IN ACCORDANCE WITH THE RELEVANT AUTHORITY REQUIREMENTS.

**BULK EARTHWORKS NOTES**

- NOTWITHSTANDING THE EXTENTS OF CUTTING AND FILLING SHOWN ON DRAWINGS, THE SUPERINTENDENT RESERVES THE RIGHT TO ADJUST THE FINISHED SURFACE LEVELS AND EARTHWORKS EXTENTS THROUGH WRITTEN DIRECTION.
- THE CONTRACTOR SHALL UNDERTAKE ALL CLEARING USING INDUSTRY BEST PRACTICE INCLUDING CONSIDERATION OF FAUNA RELOCATION.
- THE CONTRACTOR SHALL UNDERTAKE ALL EARTHWORKS IN ACCORDANCE WITH AS3798-2007 AND LOCAL AUTHORITY REQUIREMENTS. LEVEL 1 SUPERVISION IS REQUIRED.
- THE CONTRACTOR SHALL CONSIDER LOADS GENERATED BY THE EARTHWORKS OPERATIONS SO AS TO AVOID DAMAGE TO ALL PIPES, SERVICES AND STRUCTURES.
- THE EARTHWORKS DRAWINGS ARE TO BE READ IN CONJUNCTION WITH THE PROJECT'S SEDIMENT AND EROSION CONTROL PLAN, WHERE APPLICABLE.
- THE CONTRACTOR SHALL BE RESPONSIBLE FOR THE PLANNING, DESIGN, CERTIFICATION, IMPLEMENTATION AND MAINTENANCE OF AN EROSION AND SEDIMENT CONTROL PLAN THAT IS COMPLIANT WITH THE INTERNATIONAL EROSION CONTROL ASSOCIATION (IECA) GUIDELINE 'BEST PRACTICE EROSION AND SEDIMENT CONTROL' AND RELEVANT COUNCIL POLICIES.

**ROADWORKS AND DRAINAGE NOTES**

- ALL WORKS SHALL BE IN ACCORDANCE WITH THE RELEVANT AUTHORITY'S STANDARD DRAWINGS, METHODS AND SPECIFICATIONS.
- NOTWITHSTANDING THE EXTENTS OF CUTTING AND FILLING SHOWN ON DRAWINGS, THE SUPERINTENDENT RESERVES THE RIGHT TO ADJUST THE FINISHED SURFACE LEVELS AND EARTHWORKS EXTENTS THROUGH WRITTEN DIRECTION.
- NEW CONSTRUCTION SHALL BE NEATLY JOINED TO EXISTING FORMATION. WHERE REQUIRED, THE EXISTING FORMATION SHALL BE SAW CUT IN ACCORDANCE WITH IPWEAQ STD DRG RS-170. LEVELS AND GRADIENTS AT CONNECTIONS WITH EXISTING WORKS MAY BE VARIED AS REQUIRED TO ACHIEVE A SMOOTH CONNECTION.
- THE CONTRACTOR SHALL UNDERTAKE ALL EARTHWORKS IN ACCORDANCE WITH AS3798-2007 AND LOCAL AUTHORITY REQUIREMENTS. LEVEL 1 SUPERVISION IS REQUIRED.
- THE CONTRACTOR SHALL SUPPLY THE SUPERINTENDENT WITH THE SUBGRADE TEST RESULTS NECESSARY FOR ALL PAVEMENT DESIGN.
- THE CONTRACTOR SHALL ENSURE A MINIMUM OF 75mm TOPSOIL TO ALL VERGE AND BATTER AREAS (AND STABILISATION AS ORDERED)
- THE CONTRACTOR SHALL INSTALL ALL FOOTPATH AND PRAM RAMPS IN COMPLIANCE WITH THE AUTHORITY'S STANDARD DRAWINGS. PRAM RAMPS ARE TO BE LOCATED CLEAR OF DRAINAGE GULLY PITS AND FUTURE DRIVEWAY POSITIONS INDICATED ON THE LAYOUT PLANS.
- THE CONTRACTOR SHALL INSTALL SUBSOIL DRAINS UNDER ALL KERBS AS REQUIRED BY THE LOCAL AUTHORITY'S STANDARDS.
- THE CONTRACTOR SHALL ENSURE THAT ALL RETAINING WALL SUBSOIL DRAINS ARE TO CONNECT TO EITHER KERB ADAPTORS, KERB SUBSOIL DRAINS OR STORMWATER DRAINAGE STRUCTURES. CONTRACTOR TO DEMONSTRATE TO SUPERINTENDENT THAT SUITABLE CONNECTIONS HAVE BEEN PROVIDED FOR ALL WALLS.
- ALL STORMWATER DRAINAGE MATERIALS, BEDDING, JOINTING AND STEP IRON REQUIREMENTS SHALL BE IN ACCORDANCE WITH THE RELEVANT AUTHORITY'S STANDARD DRAWINGS, METHODS AND SPECIFICATIONS.
- THE STORMWATER PIPE CLASSES HAVE BEEN DESIGNED FOR SERVICE LOADS ONLY. THE CONTRACTOR SHALL ASSESS THE SUITABILITY OF MACHINERY USED ON SITE AND THE ANTICIPATED CONSTRUCTION LOADS, AND UPGRADE THE PIPE CLASSES IF NECESSARY IN ACCORDANCE WITH AS3725-2007.
- THE TERM D<sub>50</sub> DOCUMENTED ON THE DRAWINGS, IN RELATION TO ROCK ARMORING, CORRESPONDS TO THE REQUIRED MEDIAN DIAMETER OF THE PLACED ROCKS. THE ROCKS USED SHALL NOT VARY IN SIZE BY +/- 30% OF THE PROPOSED D<sub>50</sub> SIZE.

**ROOFWATER NOTES**

- THE GEOMETRIC CENTRE SHALL BE TAKEN AS THE SETOUT POINT FOR ALL STRUCTURES, UNLESS DETAILED OTHERWISE.
- ROOFWATER ALIGNMENT, COVER, MATERIALS, BEDDING, JOINTING AND STEP IRON REQUIREMENTS SHALL BE IN ACCORDANCE WITH THE RELEVANT AUTHORITY'S STANDARD DRAWINGS, METHODS AND SPECIFICATIONS.
- ALL PVC PIPES ARE TO BE MINIMUM CLASS SN8.
- END CAPS SHALL BE INSTALLED ON ENDS OF ALL PIPES AND STUBS.
- WHERE ROOFWATER PIPES ARE ALIGNED BEHIND PROPOSED RETAINING WALLS, THE CONTRACTOR IS TO REFER TO THE SPECIFIC PROJECT DESIGN DETAILS AND CONFIRM CLEARANCES WITH THE SUPERINTENDENT PRIOR TO LAYING OF THE PIPES.
- PROPERTY CONNECTIONS SHALL BE 1000 UNLESS SHOWN OTHERWISE. THE CONTRACTOR SHALL EXTEND CONNECTIONS A MINIMUM OF 1.0m BEYOND ADJACENT SEWER LINES, WHERE APPLICABLE.
- IN INSTANCES WHERE REAR ALLOTMENT DRAINAGE IS NOT PROVIDED, THE CONTRACTOR SHALL INSTALL A ROOFWATER CONNECTION TO EACH PROPERTY BY ONE OF THE FOLLOWING METHODS, AS SHOWN ON THE LAYOUT PLAN:
  - TWO ROOFWATER KERB ADAPTOR 500mm FROM THE DOWNSTREAM BOUNDARY (UNLESS SHOWN ON A DIFFERENT ALIGNMENT). WHERE THERE IS A CONCRETE FOOTPATH, A ROOFWATER PIPE SHALL BE INSTALLED FROM THE PROPERTY BOUNDARY CONNECTED TO THE KERB ADAPTOR AT 1.25% MINIMUM GRADE IN ACCORDANCE WITH COUNCIL'S STANDARDS.
  - ONE 1500 ROOFWATER PIPE CONNECTED TO PROPOSED STORMWATER GULLY PIT OR MANHOLE AT MINIMUM 1.0% GRADE WITH 1.0m COVER.

**AS-CONSTRUCTED CERTIFICATION**  
 Signature:  Date: 26/06/20  
 ANDREW NGO RPEQ No. 12329  
 For and on behalf of Peakurban PTY LTD

REV	DATE	DESIGN	DRAWN	REVISION DETAILS	DRAWN	STATUS	SCALE	CLIENT	PROJECT NAME	DRAWING TITLE
A	02.12.19	AC	CL	ISSUED FOR CONSTRUCTION	TD	<b>AS CONSTRUCTED</b>		<b>CANBERRA ESTATES CONSORTIUM NO. 36 PTY LIMITED</b>	<b>WOODLINKS VILLAGE - STAGE 16</b>	<b>GENERAL NOTES</b>
B	26.05.20	TD	SC	AS CONSTRUCTED						
					DESIGN	APPROVED		ASSOCIATED CONSULTANT	COLLINGWOOD DRIVE, COLLINGWOOD PARK	PROJECT No.
					TD	ANDREW NGO	RPEQ 12329	SAUNDERS HAVILL GROUP		DRAWING No.
						FOR AND ON BEHALF OF PEAKURBAN PTY LTD	ENQUIRIES@PEAKURBAN.COM.AU	PH: 1300 123 744		REVISION
										19-0023
										101
										B

**WARNING! - EXISTING SERVICES**



EXTREME CARE SHOULD BE TAKEN WHEN EXCAVATING IN THIS AREA. THE FOLLOWING EXISTING SERVICES ARE LIKELY TO BE PRESENT IN THE VICINITY OF THE SITE:

- ELECTRICAL CABLES
- TELECOMMUNICATIONS CABLES
- GAS MAINS
- WATER MAINS
- SEWER MAINS

THE CONTRACTOR SHOULD CONTACT THE SERVICE PROVIDER FOR FURTHER INFORMATION AND SATISFY THEMSELVES OF ANY SPECIFIC TREATMENT OR REQUIREMENTS.

**NOTE:**

CONTRACTOR TO PREPARE 'CPSEC' CERTIFIED EROSION AND SEDIMENT CONTROL PLAN PRIOR TO COUNCIL PRE-START MEETING.

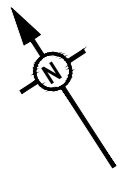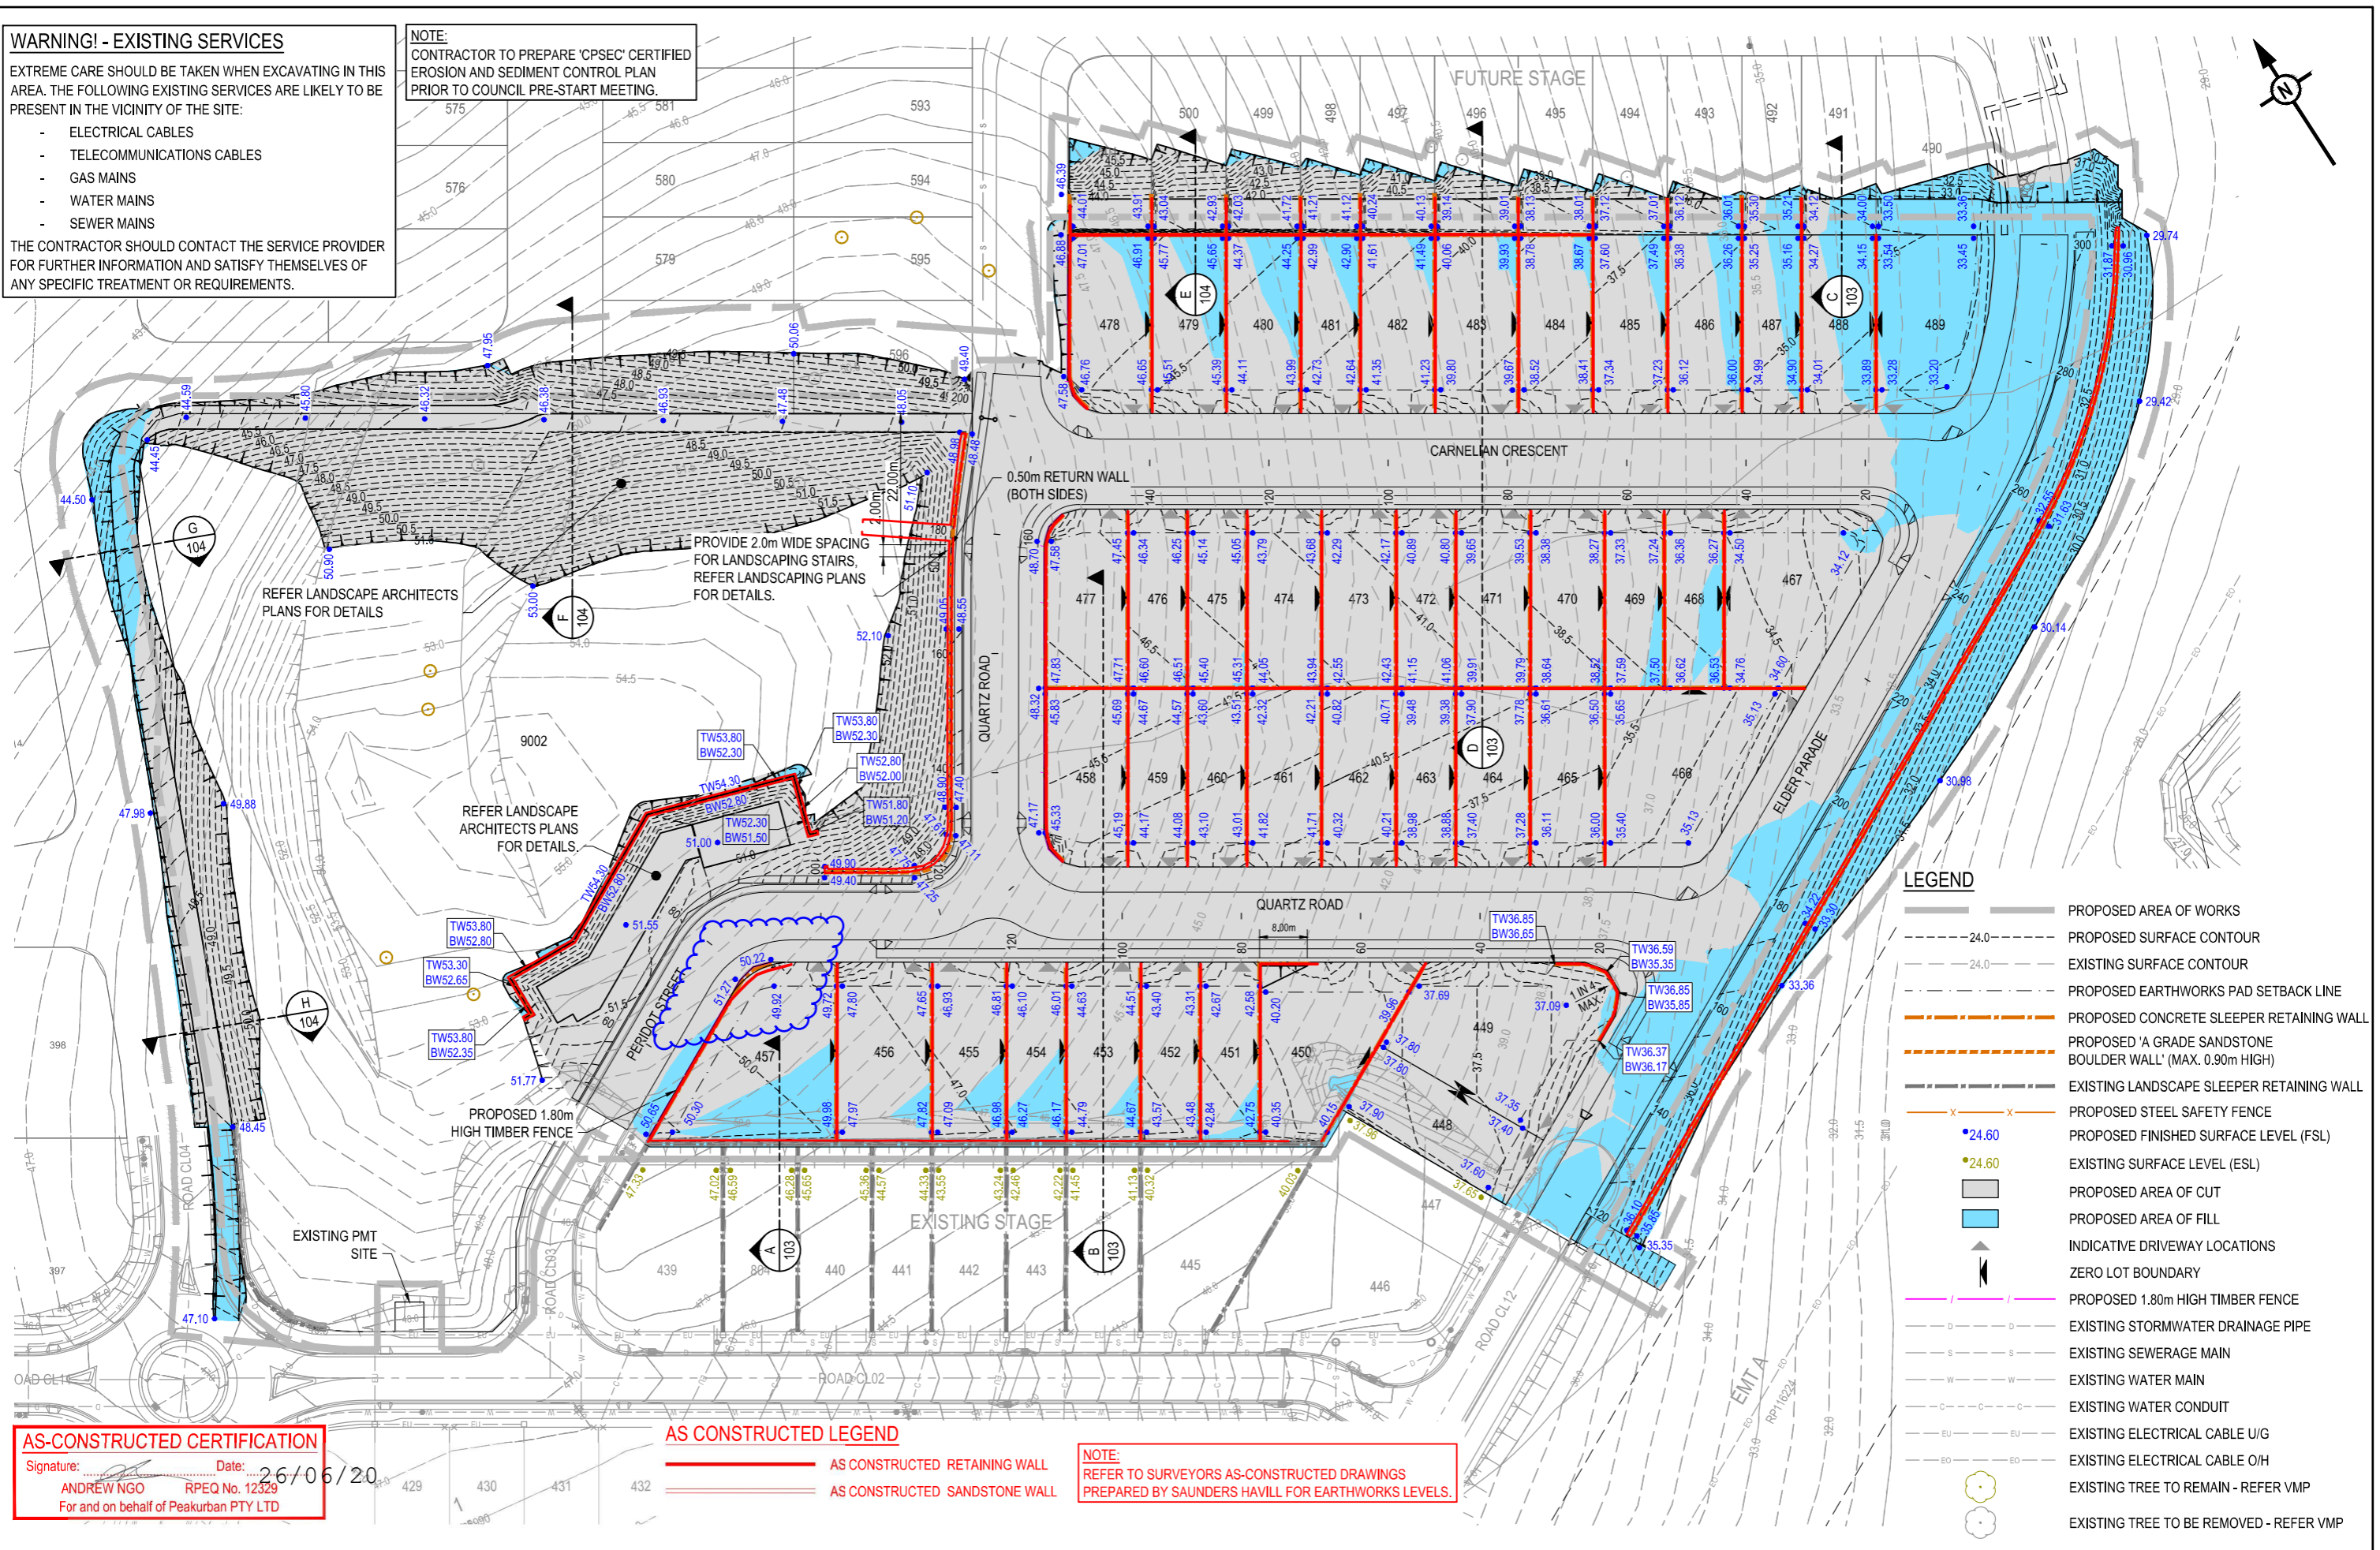

**LEGEND**

- PROPOSED AREA OF WORKS
- 24.0 - PROPOSED SURFACE CONTOUR
- 24.0 - EXISTING SURFACE CONTOUR
- PROPOSED EARTHWORKS PAD SETBACK LINE
- PROPOSED CONCRETE SLEEPER RETAINING WALL
- PROPOSED 'A GRADE SANDSTONE BOULDER WALL' (MAX. 0.90m HIGH)
- EXISTING LANDSCAPE SLEEPER RETAINING WALL
- PROPOSED STEEL SAFETY FENCE
- PROPOSED FINISHED SURFACE LEVEL (FSL)
- EXISTING SURFACE LEVEL (ESL)
- PROPOSED AREA OF CUT
- PROPOSED AREA OF FILL
- INDICATIVE DRIVEWAY LOCATIONS
- ZERO LOT BOUNDARY
- PROPOSED 1.80m HIGH TIMBER FENCE
- EXISTING STORMWATER DRAINAGE PIPE
- EXISTING SEWERAGE MAIN
- EXISTING WATER MAIN
- EXISTING WATER CONDUIT
- EXISTING ELECTRICAL CABLE U/G
- EXISTING ELECTRICAL CABLE O/H
- EXISTING TREE TO REMAIN - REFER VMP
- EXISTING TREE TO BE REMOVED - REFER VMP

**AS-CONSTRUCTED CERTIFICATION**

Signature: *Andrew Ngo* Date: 26/06/20  
 ANDREW NGO RPEQ No. 12329  
 For and on behalf of Peakurban PTY LTD

**AS CONSTRUCTED LEGEND**

- AS CONSTRUCTED RETAINING WALL
- AS CONSTRUCTED SANDSTONE WALL

**NOTE:**

REFER TO SURVEYORS AS-CONSTRUCTED DRAWINGS PREPARED BY SAUNDERS HAVILL FOR EARTHWORKS LEVELS.

REV	DATE	DESIGN	DRAWN	ISSUED FOR CONSTRUCTION	REVISION DETAILS
A	03.12.19	AC	CL	ISSUED FOR CONSTRUCTION	
B	22.01.20	LF	CL	PERIDOT STREET AMENDED, SPOT LEVELS UPDATED, CUT AND FILL HATCH UPDATED	
C	03.02.20	LF	SC	RETAINING WALL ADDED	
D	03.03.20	LF	CL	NORTHERN RETAINING WALL REMOVED, SPOT LEVELS AND NOTE ADDED	
E	10.03.20	AC	CL	RETAINING WALL ADDED TO LOT 501, SANDSTONE BOULDER WALL AMENDED	
F	26.05.20	TD	SC	AS CONSTRUCTED	

**AS CONSTRUCTED**

APPROVED  
ANDREW NGO RPEQ 12329

FOR AND ON BEHALF OF PEAKURBAN PTY LTD

**PEAKURBAN**  
 DEVELOPMENT ENGINEERS - ADVISORS

ENQUIRIES@PEAKURBAN.COM.AU

SCALE

1:500 10 5 0 10 20 A1  
 1:1000

CLIENT

**CANBERRA ESTATES CONSORTIUM NO. 36 PTY LIMITED**

ASSOCIATED CONSULTANT  
 SAUNDERS HAVILL GROUP  
 PH: 1300 123 744

PROJECT NAME

**WOODLINKS VILLAGE - STAGE 16**






COLLINGWOOD DRIVE, COLLINGWOOD PARK

DRAWING TITLE


**BULK EARTHWORKS LAYOUT PLAN**

PROJECT No. **19-0023** DRAWING No. **102** REVISION **F**

NOTE:  
FSL INDICATES FINISHED PAD LEVEL  
AS SHOWN ON THE LAYOUT PLAN

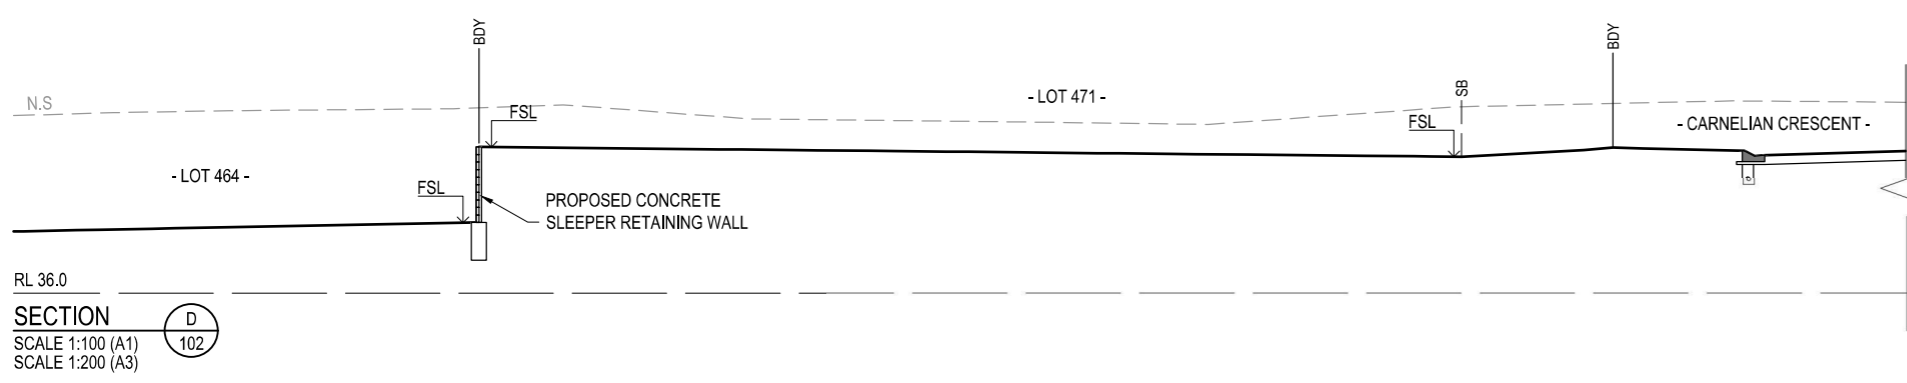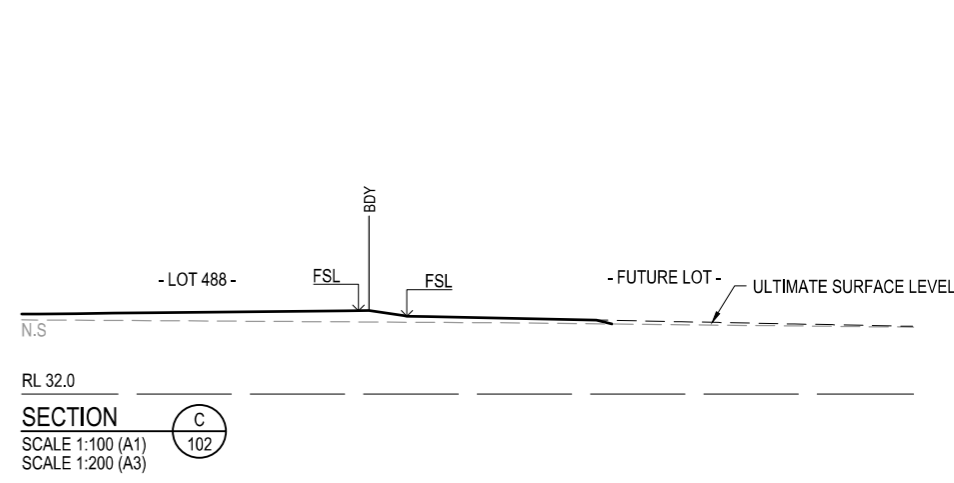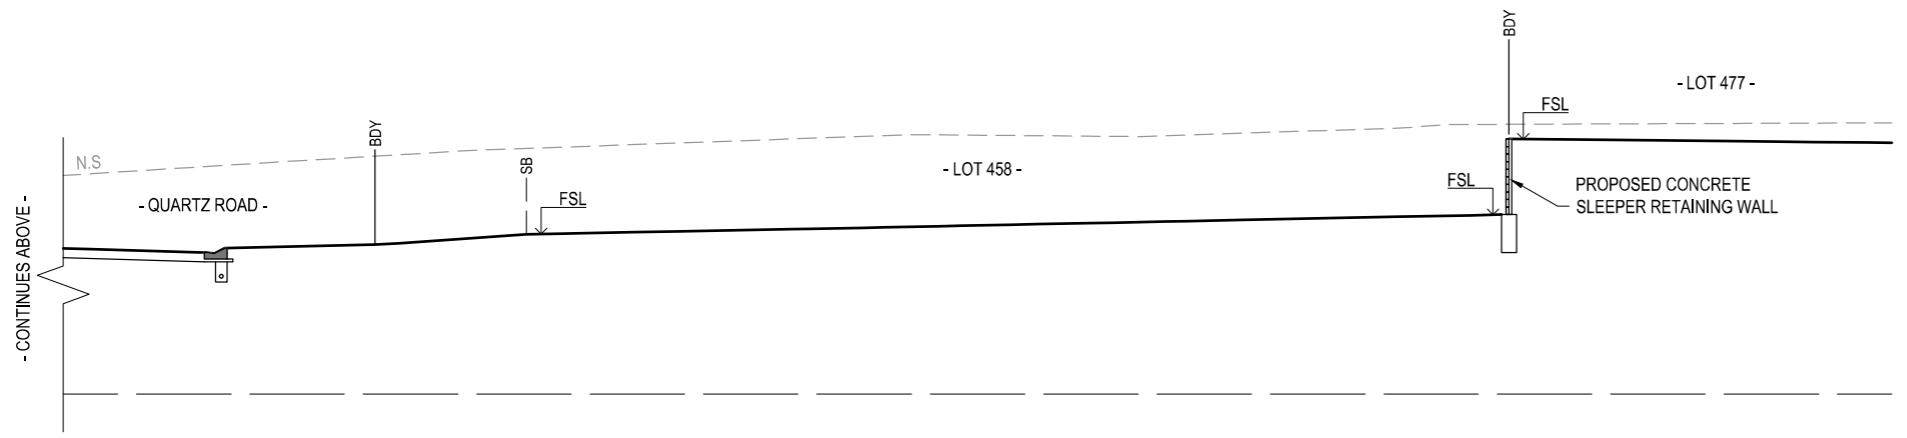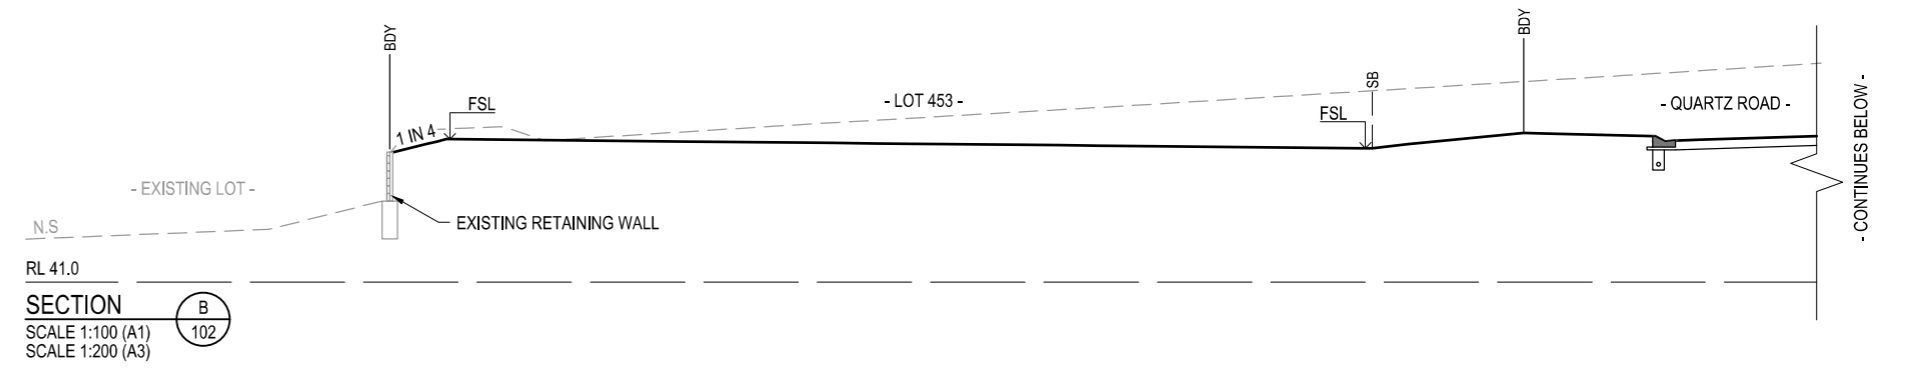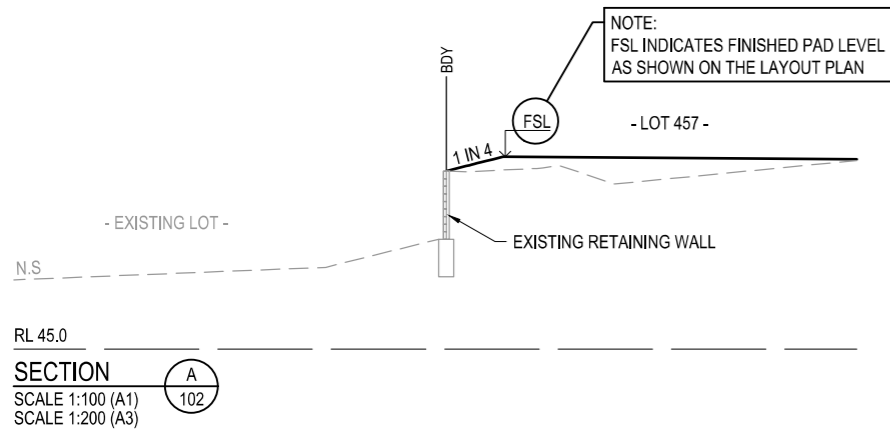


**AS-CONSTRUCTED CERTIFICATION**  
 Signature: *Andrew Ngo* Date: 26/06/20  
 ANDREW NGO RPEQ No. 12329  
 For and on behalf of Peakurban PTY LTD

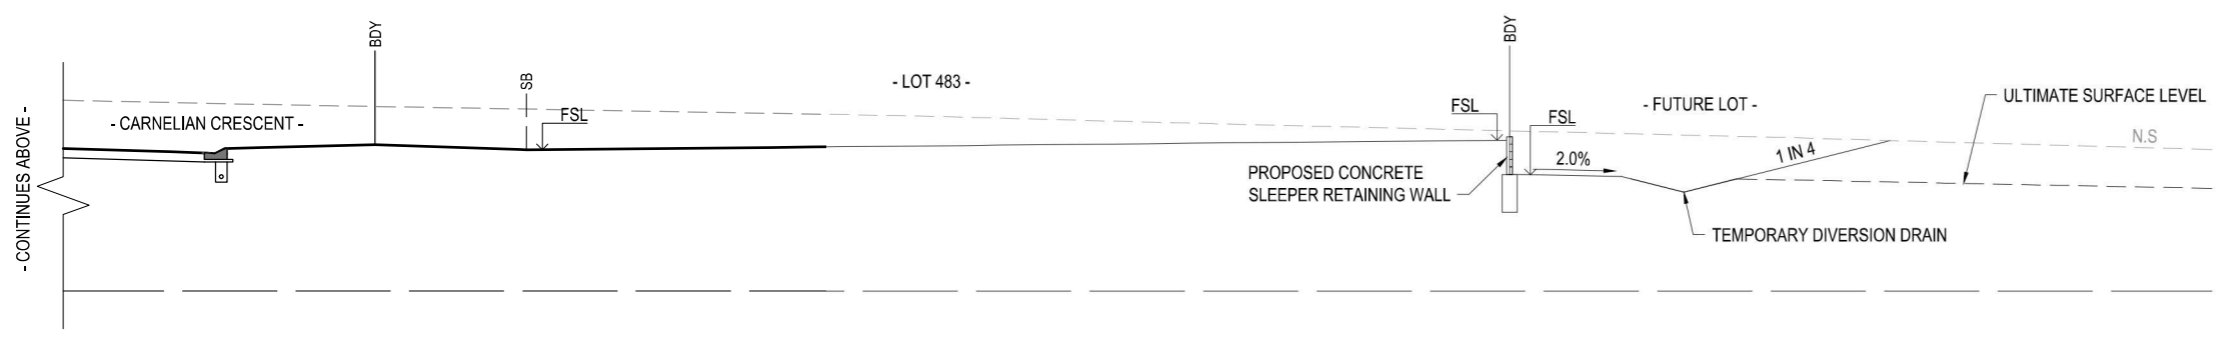

REV	DATE	DESIGN	DRAWN	REVISION DETAILS
A	02.12.19	AC	CL	ISSUED FOR CONSTRUCTION
B	10.03.20	AC	CL	SECTION D UPDATED
C	22.05.20	TD	SC	AS CONSTRUCTED

DRAWN	STATUS
TD	<b>AS CONSTRUCTED</b>
DESIGN	APPROVED ANDREW NGO RPEQ 12329
TD	

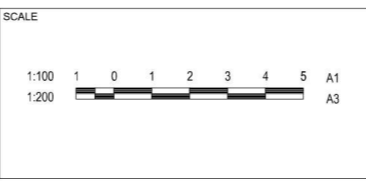





CLIENT  
**CANBERRA ESTATES  
CONSORTIUM NO. 36 PTY LIMITED**

ASSOCIATED CONSULTANT  
SAUNDERS HAVILL GROUP  
PH: 1300 123 744


PROJECT NAME  
**WOODLINKS VILLAGE - STAGE 16**

COLLINGWOOD DRIVE,  
COLLINGWOOD PARK

DRAWING TITLE		
<b>BULK EARTHWORKS TYPICAL SECTIONS SHEET 1 OF 2</b>		
PROJECT No.	DRAWING No.	REVISION
19-0023	103	C

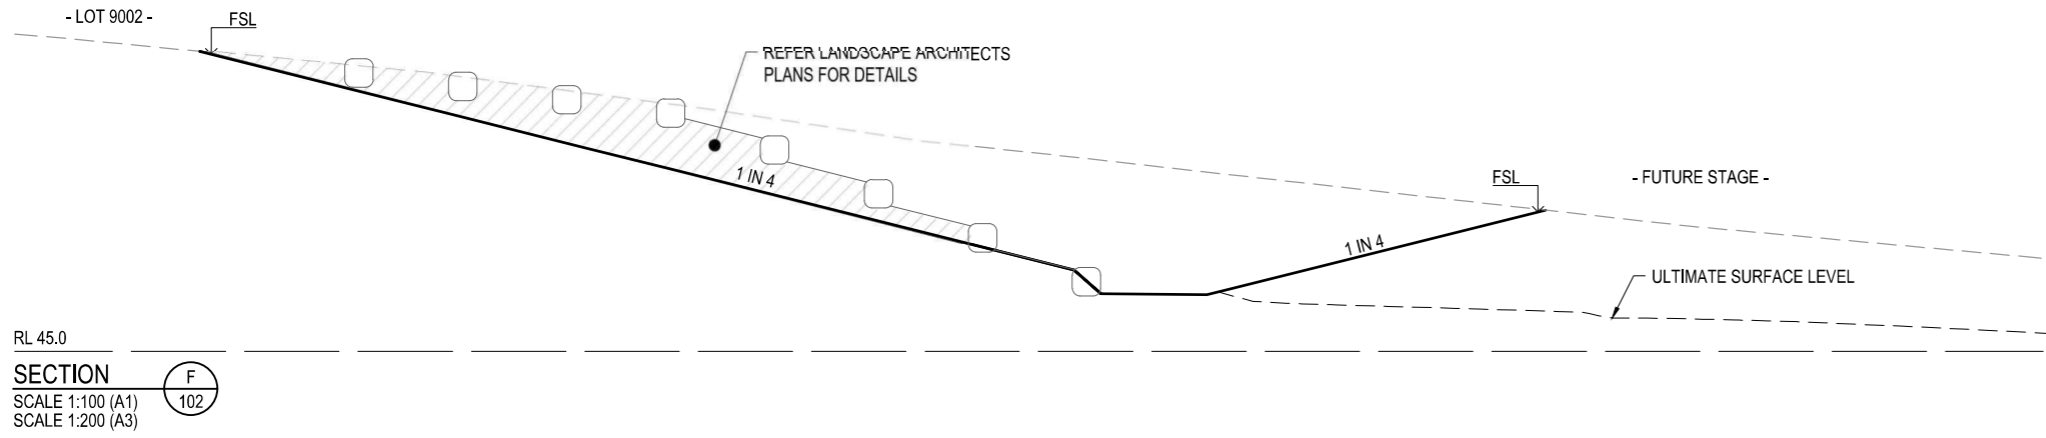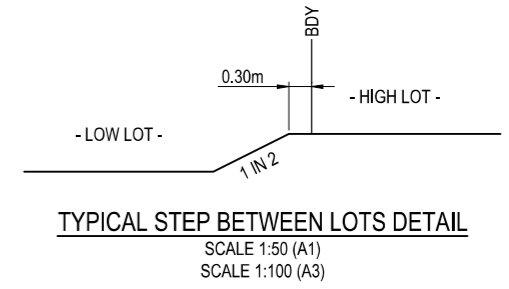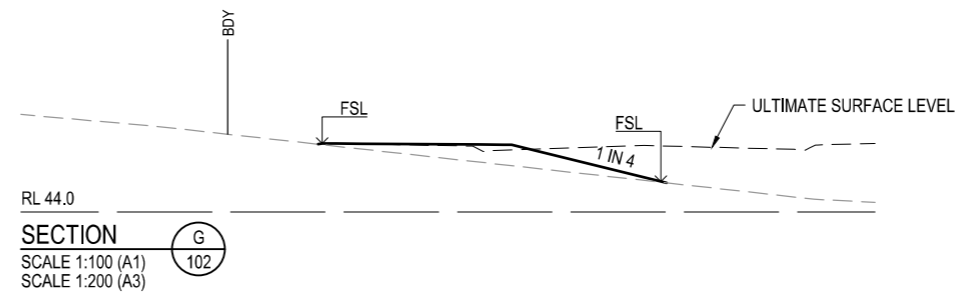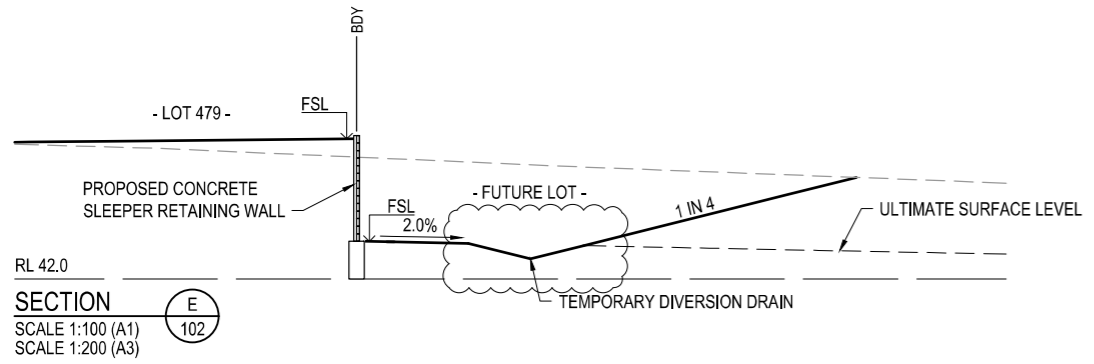


- RETAINING WALL NOTES:**
1. ALL RETAINING WALLS ARE TO BE DELIVERED UNDER DESIGN AND CONSTRUCTION ARRANGEMENT - FORMS 15 AND 16 CERTIFICATIONS ARE TO BE PROVIDED BY THE CONTRACTOR.
  2. DESIGN OF WALLS TO CONSIDER ALL LOADS (FENCES, DWELLINGS ETC) AND ASSOCIATED IMPACTS FROM ANY ADJACENT SERVICES - FOOTING DEPTHS TO BE EXTENDED AS REQUIRED.
  3. GEOTECHNICAL CONDITIONS ARE TO BE CONFIRMED AND APPROPRIATELY CONSIDERED FOR ALL WALLS.
  4. REFER LANDSCAPE DRAWINGS FOR FURTHER INFORMATION ON RETAINING WALLS, PARTICULARLY RELATING TO FINISHES.
  5. TEMPORARY SAFETY FENCING TO BE INSTALLED BEHIND ALL WALLS 1.0m HIGH AND GREATER.

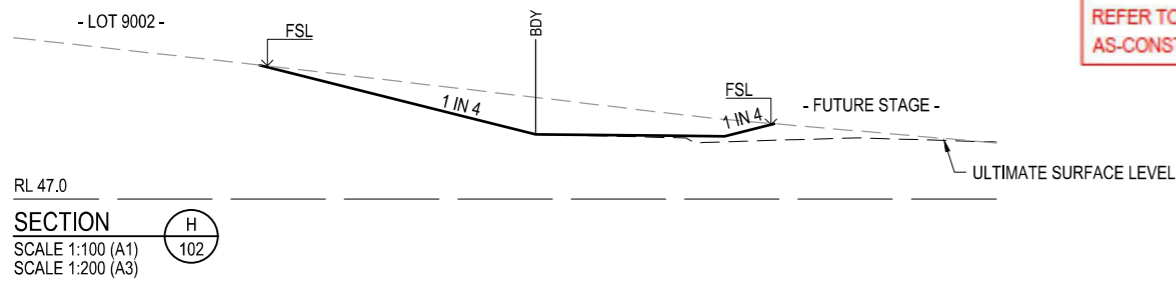

**AS CONSTRUCTED LEVELS:**  
REFER TO FORM 15 AND 16 FOR RETAINING WALL AS-CONSTRUCTED DETAILS

**AS-CONSTRUCTED CERTIFICATION**  
Signature: *Andrew Ngo* Date: 26/06/20  
ANDREW NGO RPEQ No. 12329  
For and on behalf of Peakurban PTY LTD

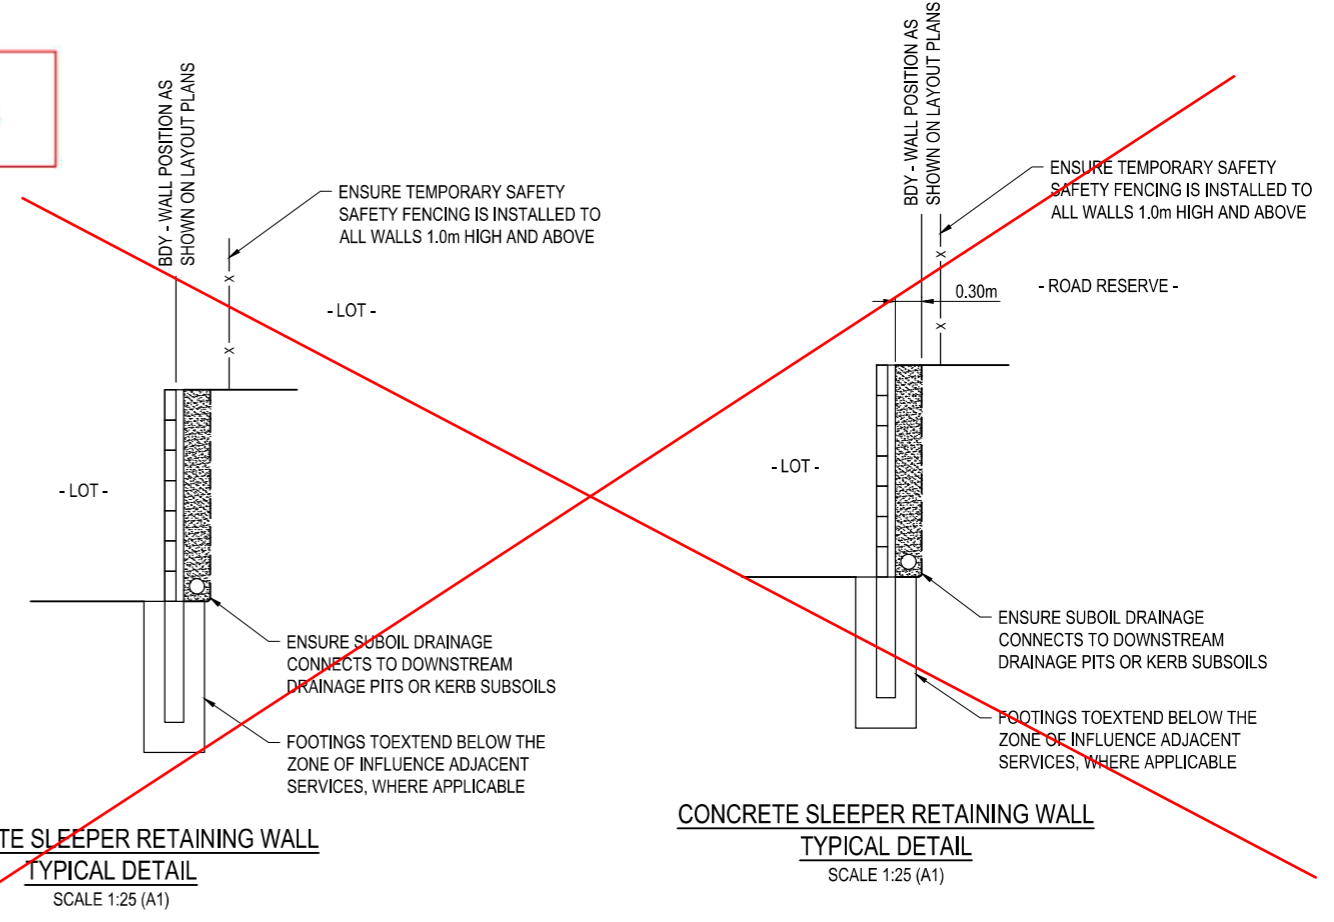

REV	DATE	DESIGN	DRAWN	REVISION DETAILS	DRAWN	STATUS	SCALE	CLIENT	PROJECT NAME	DRAWING TITLE
A	02.12.19	AC	CL	ISSUED FOR CONSTRUCTION	TD	<b>AS CONSTRUCTED</b>	1:100 1:200	CANBERRA ESTATES CONSORTIUM NO. 36 PTY LIMITED	WOODLINKS VILLAGE - STAGE 16	BULK EARTHWORKS TYPICAL SECTIONS SHEET 2 OF 2
B	03.03.20	LF	CL	SECTION F UPDATED TO SUIT LAYOUT						
C	10.03.20	AC	CL	SECTION E UPDATED						
D	22.05.20	TD	SC	AS CONSTRUCTED						
DESIGN APPROVED: ANDREW NGO RPEQ 12329 FOR AND ON BEHALF OF PEAKURBAN PTY LTD							ASSOCIATED CONSULTANT SAUNDERS HAVILL GROUP PH: 1300 123 744		COLLINGWOOD DRIVE, COLLINGWOOD PARK	
							PROJECT No. 19-0023 DRAWING No. 104 REVISION D			

**ROOFWATER CONNECTION NOTE:**

THE CONTRACTOR SHALL INSTALL A ROOFWATER CONNECTION TO EACH PROPERTY BY ONE OF THE FOLLOWING METHODS, AS SHOWN ON THE LAYOUT PLAN:

- TWO ROOFWATER KERB ADAPTOR 500mm FROM THE DOWNSTREAM BOUNDARY (UNLESS SHOWN ON A DIFFERENT ALIGNMENT), WHERE THERE IS A CONCRETE FOOTPATH, A ROOFWATER PIPE SHALL BE INSTALLED FROM THE PROPERTY BOUNDARY CONNECTED TO THE KERB ADAPTOR AT 1.25% MINIMUM GRADE, IN ACCORDANCE WITH THE LOCAL AUTHORITY STANDARDS.
- ONE 150Ø ROOFWATER PIPE CONNECTED TO PROPOSED STORMWATER GULLY PIT OR MANHOLE AT MINIMUM 1.0% GRADE WITH 1.0m COVER.
- ONE 150Ø ROOFWATER PIPE DISCHARGING TO THE FILTER SURFACE LEVEL OF PROPOSED TREE PIT AT MINIMUM 1.0% GRADE.

**WARNING! - EXISTING SERVICES**

EXTREME CARE SHOULD BE TAKEN WHEN EXCAVATING IN THIS AREA. THE FOLLOWING EXISTING SERVICES ARE LIKELY TO BE PRESENT IN THE VICINITY OF THE SITE:

- ELECTRICAL CABLES
- TELECOMMUNICATIONS CABLES
- GAS MAINS
- WATER MAINS
- SEWER MAINS


THE CONTRACTOR SHOULD CONTACT THE SERVICE PROVIDER FOR FURTHER INFORMATION AND SATISFY THEMSELVES OF ANY SPECIFIC TREATMENT OR REQUIREMENTS.

**KERB TYPES NOTE:**


REFER TO THE SURVEY SETOUT ENGINEERING DRAWING FOR KERB TYPES AND TRANSITION LOCATIONS

**AS CONSTRUCTED LEGEND**

- KERB
- CONCRETE PATH AND PRAM RAMP
- STORMWATER DRAINAGE PIPE
- KERB ADAPTOR WITH PIPE CONNECTION

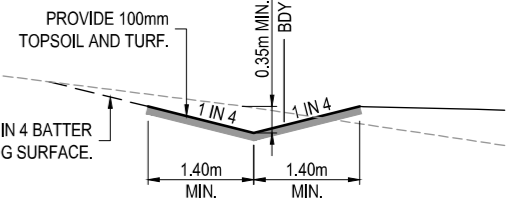

**DIVERSION SWALE (TYPICAL)**  
SCALE 1:50 (A1)  
SCALE 1:100 (A3)

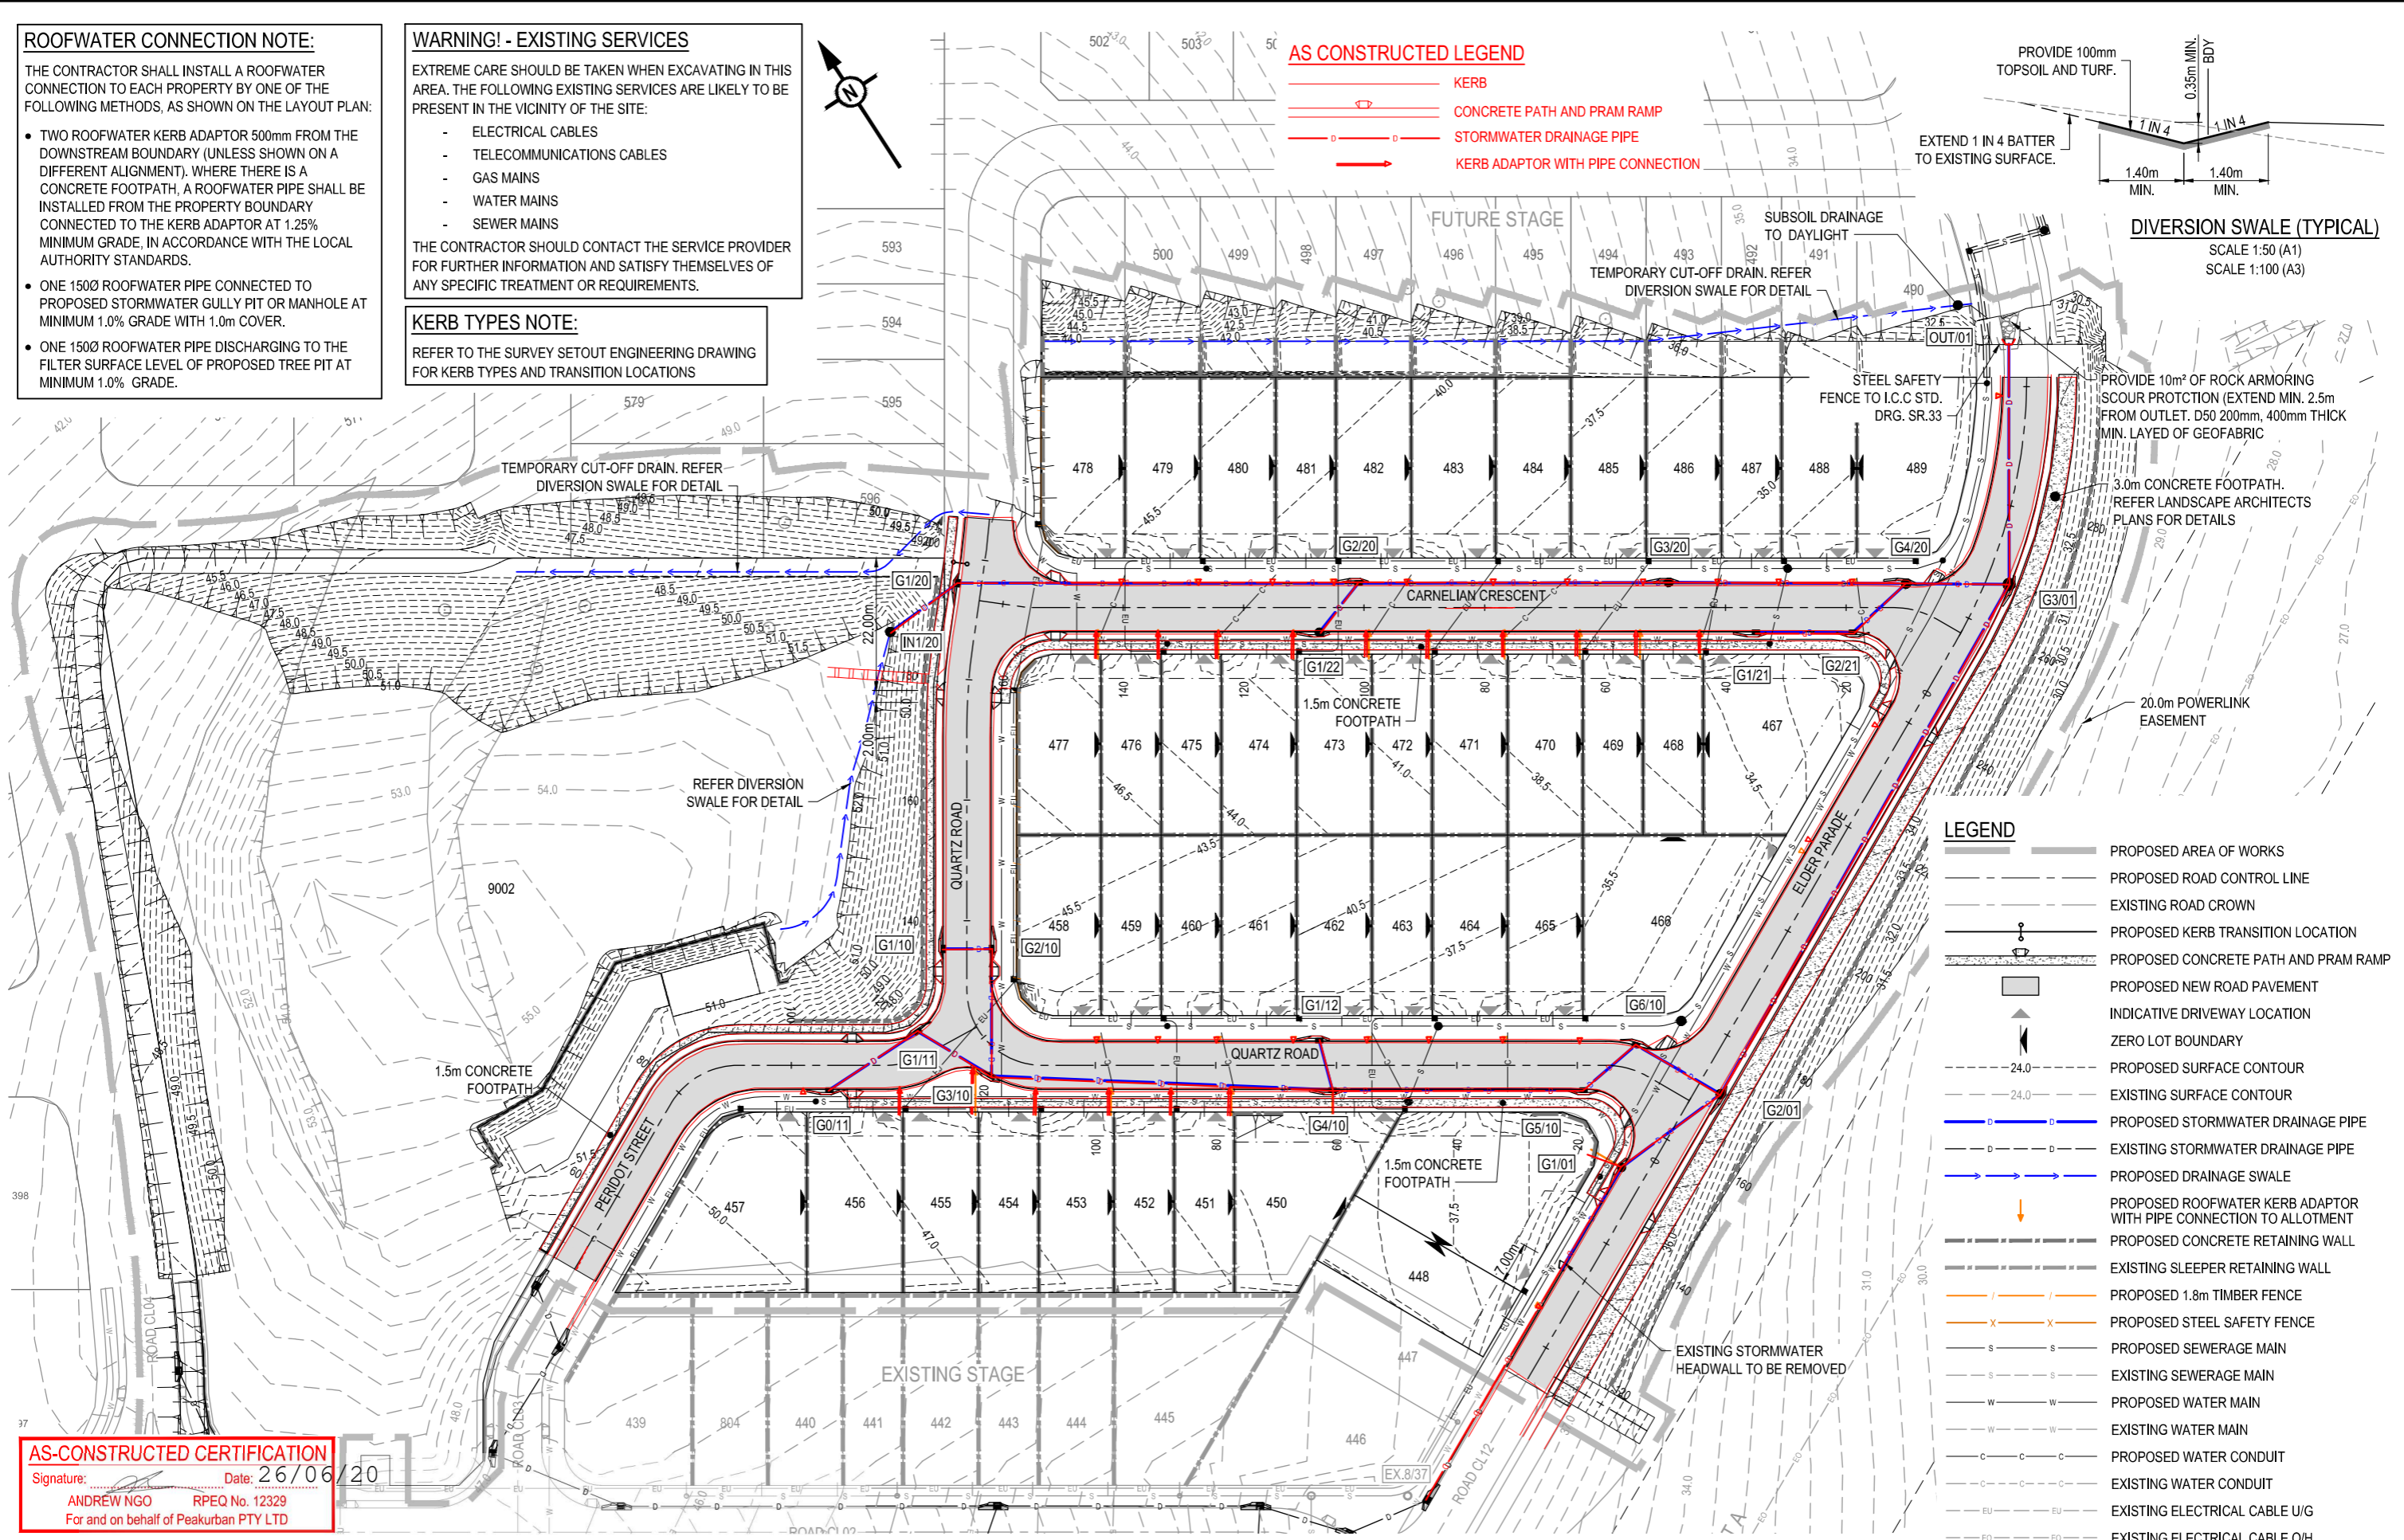

**LEGEND**

- PROPOSED AREA OF WORKS
- PROPOSED ROAD CONTROL LINE
- EXISTING ROAD CROWN
- PROPOSED KERB TRANSITION LOCATION
- PROPOSED CONCRETE PATH AND PRAM RAMP
- PROPOSED NEW ROAD PAVEMENT
- INDICATIVE DRIVEWAY LOCATION
- ZERO LOT BOUNDARY
- 24.0 — PROPOSED SURFACE CONTOUR
- 24.0 — EXISTING SURFACE CONTOUR
- PROPOSED STORMWATER DRAINAGE PIPE
- EXISTING STORMWATER DRAINAGE PIPE
- PROPOSED DRAINAGE SWALE
- PROPOSED ROOFWATER KERB ADAPTOR WITH PIPE CONNECTION TO ALLOTMENT
- PROPOSED CONCRETE RETAINING WALL
- EXISTING SLEEPER RETAINING WALL
- PROPOSED 1.8m TIMBER FENCE
- PROPOSED STEEL SAFETY FENCE
- PROPOSED SEWERAGE MAIN
- EXISTING SEWERAGE MAIN
- PROPOSED WATER MAIN
- EXISTING WATER MAIN
- PROPOSED WATER CONDUIT
- EXISTING WATER CONDUIT
- EXISTING ELECTRICAL CABLE U/G
- EXISTING ELECTRICAL CABLE O/H

**AS-CONSTRUCTED CERTIFICATION**

Signature: *Andrew Ngo* Date: 26/06/20  
ANDREW NGO RPEQ No. 12329  
For and on behalf of Peakurban PTY LTD

REV	DATE	DESIGN	DRAWN	REVISION DETAILS	DRAWN	STATUS	SCALE	CLIENT	PROJECT NAME	DRAWING TITLE
A	03.12.19	AC	CL	ISSUED FOR CONSTRUCTION	TD	<b>AS CONSTRUCTED</b>	1:500 1:1000	<b>CANBERRA ESTATES CONSORTIUM NO. 36 PTY LIMITED</b>	<b>WOODLINKS VILLAGE - STAGE 16</b>	<b>ROADWORKS AND DRAINAGE LAYOUT PLAN</b>
B	21.01.20	LF	CL	RETAINING WALL AMENDED IN LOT 449	TD					
C	03.02.20	LF	SC	RETAINING WALL ADDED	TD					
D	10.03.20	AC	CL	SANDSTONE BOULDER WALL AMENDED	TD					
E	26.05.20	TD	SC	AS CONSTRUCTED	TD					
APPROVED: ANDREW NGO RPEQ 12329 FOR AND ON BEHALF OF PEAKURBAN PTY LTD							ASSOCIATED CONSULTANT: SAUNDERS HAVILL GROUP PH: 1300 123 744		COLLINGWOOD DRIVE, COLLINGWOOD PARK PROJECT No. 19-0023 DRAWING No. 105 REVISION E	




**ASSUMED PAVEMENT DETAILS (SUBJECT TO CBR TESTING)**

ROAD	ROAD CLASSIFICATION	DESIGN ESAs	ASSUMED CBR	SURFACING	BASE	SUB BASE	LOWER SUBBASE	TOTAL DEPTH
PERIDOT STREET	ACCESS STREET	1.0 x 10 <sup>5</sup>	3	35mm	125mm	100mm	160mm	420mm

**NOTE:**  
REFER TO SURVEYORS AS-CONSTRUCTED DRAWINGS  
PREPARED BY SAUNDERS HAVILL FOR FINISHED SURFACE LEVELS

(EW) REFER TO BULK EARTHWORKS  
DRAWING FOR LOT GRADING AND  
FINISHED SURFACE LEVELS


**NOTE:** THIS PAVEMENT DESIGN IS PRELIMINARY ONLY BASED ON AN ASSUMED CBR. THE CONTRACTOR SHALL  
SUPPLY THE SUPERINTENDENT WITH SUBGRADE TEST RESULTS NECESSARY FOR FINAL PAVEMENT DESIGN

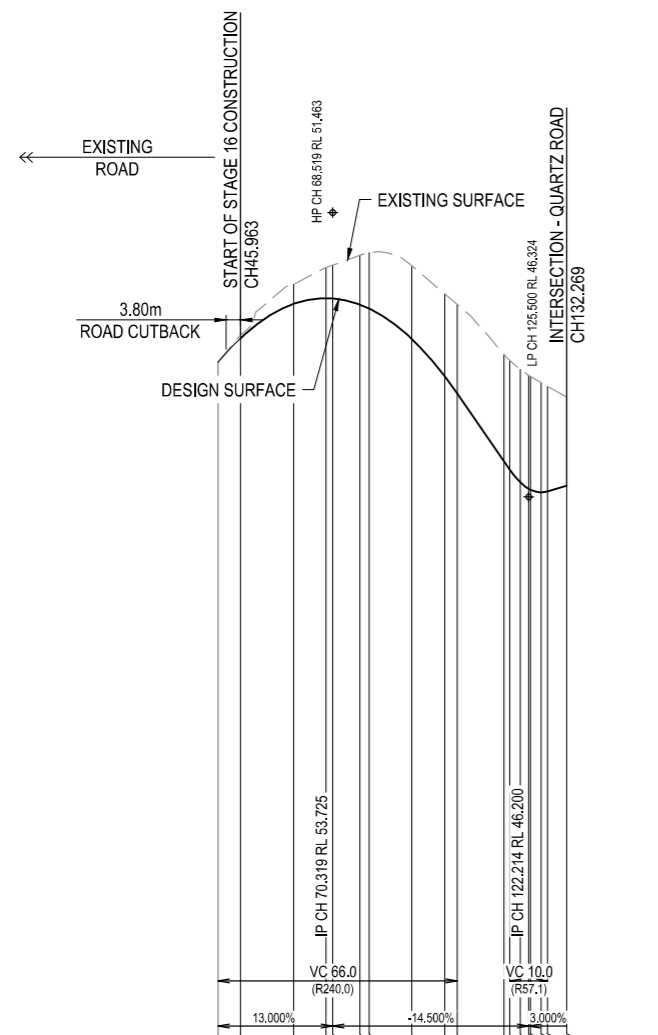

	40.000	45.963	60.000	68.519	70.319	77.562	80.000	91.254	100.000	103.319	115.670	117.214	120.000	122.214	122.682	125.500	127.214	132.269
DATUM RL 31.0																		
CUT (-) / FILL	-0.015	-0.078	-0.516	-0.810	-0.882	-1.309	-1.462	-1.936	-2.175	-2.352	-2.822	-2.890	-2.965	-3.001	-2.998	-2.903	-2.780	-2.339
LHS LIP LEVEL			51.205	51.356	51.349	51.186	51.061	50.279	49.291	48.833	46.977	46.813	46.477	46.308	46.282			
RHS LIP LEVEL			51.200	51.351	#	#	#	49.286	48.828	47.037	46.813	46.477	46.308	46.282				
DESIGN SURFACE	49.768	50.403	51.311	51.463	51.456	51.292	51.166	50.396	49.398	48.940	47.149	46.925	46.589	46.418	46.393	46.324	46.350	46.801
EXISTING SURFACE	49.763	50.480	51.827	52.273	52.338	52.601	52.670	52.322	51.573	51.291	49.971	49.814	49.574	49.419	49.391	49.227	49.130	48.840
CHAINAGES	40.000	45.963	60.000	68.519	70.319	77.562	80.000	91.254	100.000	103.319	115.670	117.214	120.000	122.214	122.682	125.500	127.214	132.269
HORIZONTAL CURVES											R13.100							


# REFER INTERSECTION DRAWINGS FOR LIP LEVELS  
**PERIDOT STREET**

**AS-CONSTRUCTED CERTIFICATION**  
Signature: \_\_\_\_\_ Date: 26/06/20  
ANDREW NGO RPEQ No. 12329  
For and on behalf of Peakurban PTY LTD

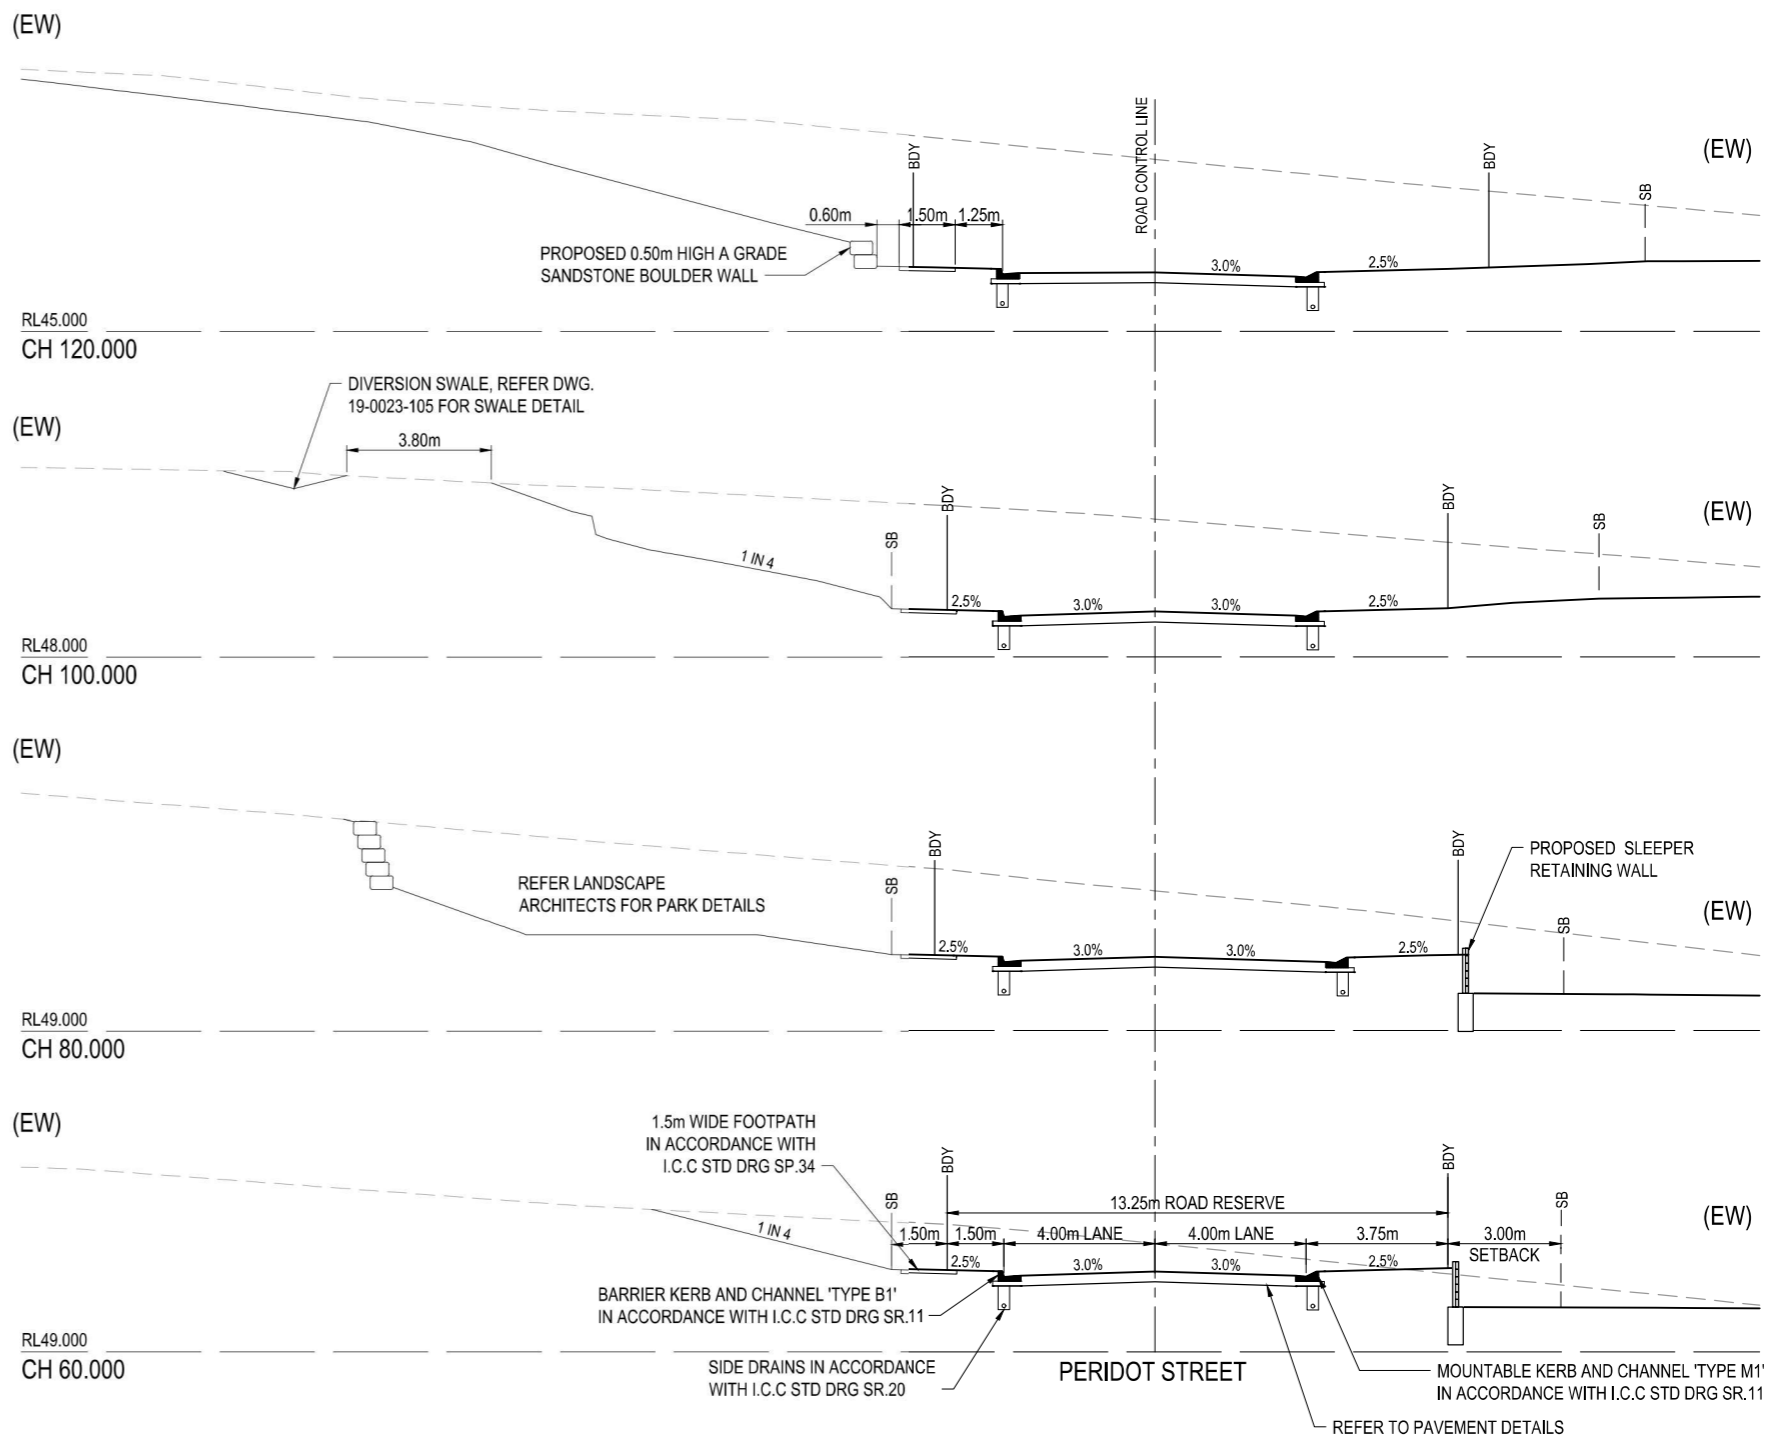

REV	DATE	DESIGN	DRAWN	REVISION DETAILS
A	02.12.19	AC	CL	ISSUED FOR CONSTRUCTION
B	22.01.20	AC	MPG	PERIDOT STREET LONGITUDINAL SECTION AMENDED
C	10.03.20	AC	CL	SANDSTONE BOULDER WALL AMENDED
D	05.06.20	TD	SC	AS CONSTRUCTED

DRAWN	STATUS
TD	<b>AS CONSTRUCTED</b>
DESIGN	APPROVED
TD	ANDREW NGO RPEQ 12329

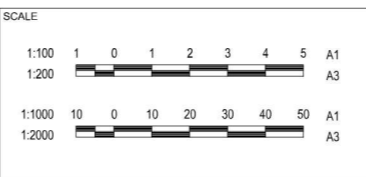

CLIENT: **CANBERRA ESTATES CONSORTIUM NO. 36 PTY LIMITED**  
ASSOCIATED CONSULTANT: SAUNDERS HAVILL GROUP  
PH: 1300 123 744

PROJECT NAME: **WOODLINKS VILLAGE - STAGE 16**  
COLLINGWOOD DRIVE, COLLINGWOOD PARK

DRAWING TITLE		
<b>PERIDOT STREET LONGITUDINAL SECTION AND CROSS SECTIONS</b>		
PROJECT No.	DRAWING No.	REVISION
19-0023	107	D



**ASSUMED PAVEMENT DETAILS (SUBJECT TO CBR TESTING)**

ROAD	ROAD CLASSIFICATION	DESIGN ESAs	ASSUMED CBR	SURFACING	BASE	SUB BASE	LOWER SUBBASE	TOTAL DEPTH
ELDER PARADE	ACCESS STREET	1.0 x 10 <sup>5</sup>	3	35mm	125mm	100mm	160mm	420mm


**NOTE:**  
REFER TO SURVEYORS AS-CONSTRUCTED DRAWINGS  
PREPARED BY SAUNDERS HAVILL FOR FINISHED SURFACE LEVELS

(EW) REFER TO BULK EARTHWORKS  
DRAWING FOR LOT GRADING AND  
FINISHED SURFACE LEVELS

**NOTE:** THIS PAVEMENT DESIGN IS PRELIMINARY ONLY BASED ON AN ASSUMED CBR. THE CONTRACTOR SHALL  
SUPPLY THE SUPERINTENDENT WITH SUBGRADE TEST RESULTS NECESSARY FOR FINAL PAVEMENT DESIGN

**AS-CONSTRUCTED CERTIFICATION**

Signature: *[Signature]* Date: 26/06/20  
ANDREW NGO RPEQ No. 12329  
For and on behalf of Peakurban PTY LTD

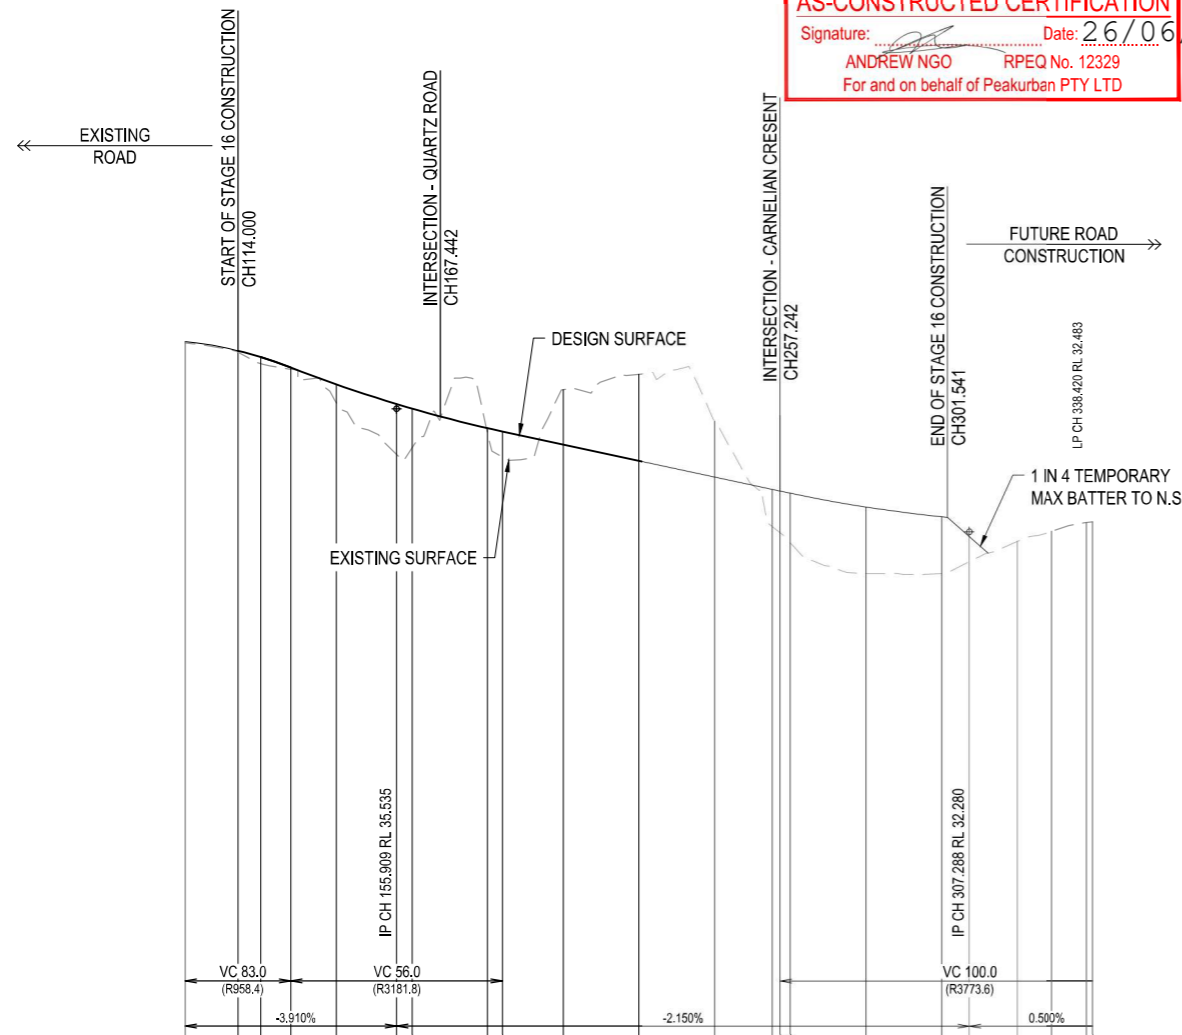


DATUM RL 18.0

CUT (-) / FILL	LHS LIP LEVEL	RHS LIP LEVEL	DESIGN SURFACE	EXISTING SURFACE	CHAINAGES	HORIZONTAL CURVES
0.036			37.314	37.278	100.000	
0.040	36.961	36.966	37.072	37.032	114.000	
0.176	36.794	36.799	36.906	36.730	120.000	
0.045	36.518	36.523	36.629	36.584	127.909	
0.488	36.049	36.054	36.180	35.692	140.000	
1.331	#	35.516	35.658	34.327	155.909	
1.038	#	35.396	35.536	34.498	160.000	
0.112	34.910	34.910	35.019	34.907	180.000	
0.674	34.821	34.826	34.933	34.259	183.908	
-1.454	34.475	34.480	34.587	36.041	200.000	
-2.292	34.045	34.050	34.157	36.449	220.000	
-1.483	33.615	33.620	33.727	35.209	240.000	
0.983	#	33.292	33.399	32.416	255.256	
1.102	#	33.248	33.355	32.253	257.288	
1.313	33.191	33.191	33.298	31.985	260.000	
1.766	32.823	32.828	32.935	31.169	280.000	
1.506	32.567	32.572	32.678	31.172	300.000	
1.124	32.611	32.611	32.611	31.487	307.288	
0.506	32.526	32.526	32.526	32.022	320.000	
0.201	48.004	48.004	32.494	32.293	329.217	
-0.040	-0.040	-0.040	32.483	32.523	338.420	
-0.058	-0.058	-0.058	32.483	32.541	340.000	

# REFER INTERSECTION DRAWINGS FOR LIP LEVELS

ELDER PARADE

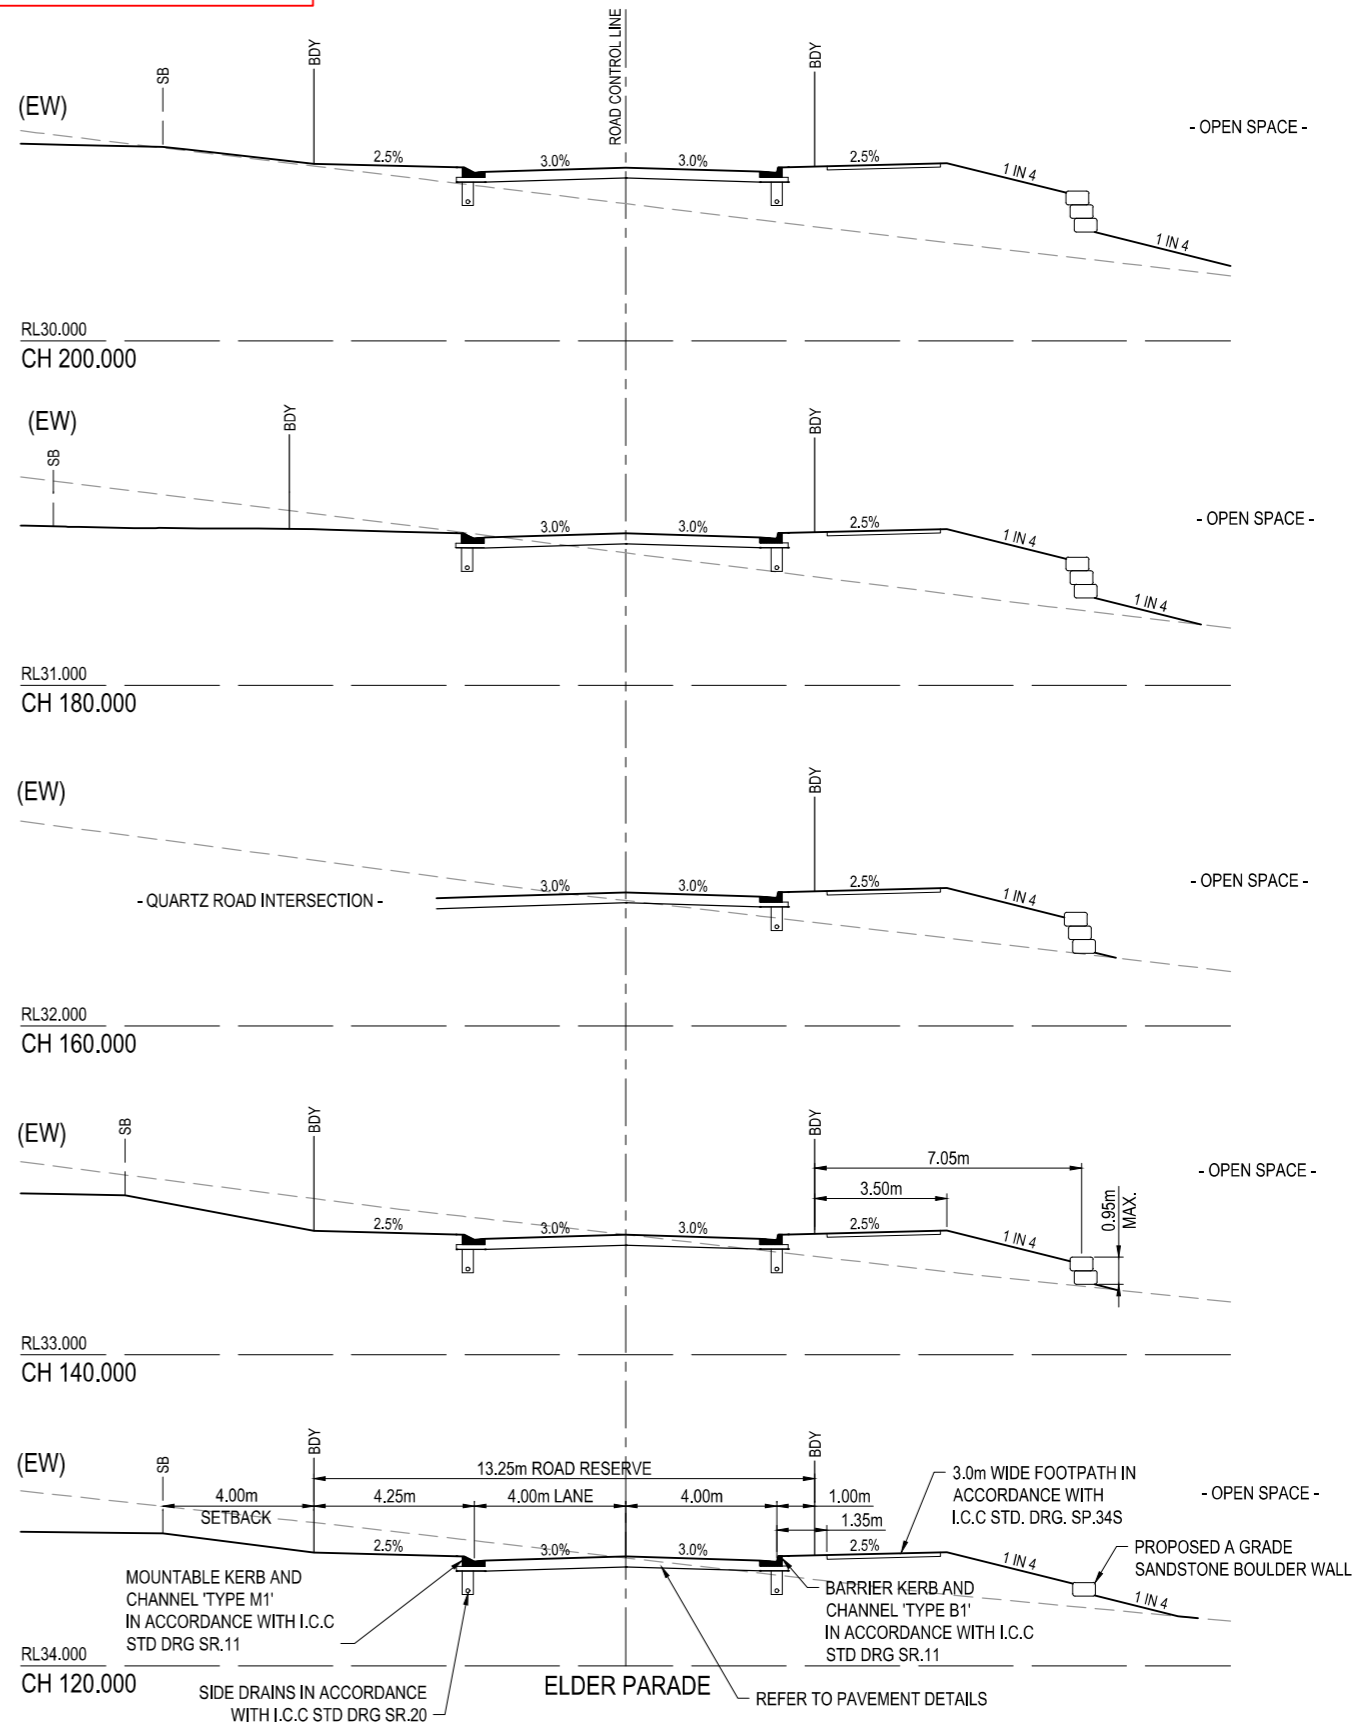

REV	DATE	DESIGN	DRAWN	REVISION DETAILS
A	02.12.19	AC	CL	ISSUED FOR CONSTRUCTION
B	22.01.20	AC	MPG	ELDER PARADE LONGITUDINAL SECTION AMENDED
C	05.06.20	TD	SC	AS CONSTRUCTED

DRAWN	STATUS
TD	<b>AS CONSTRUCTED</b>
DESIGN	APPROVED
TD	ANDREW NGO RPEQ 12329

**PEAKURBAN**  
DEVELOPMENT ENGINEERS - ADVISORS  
ENQUIR ES@PEAKURBAN.COM.AU


SCALE  
1:100 1 0 1 2 3 4 5 A1  
1:200 1 0 1 2 3 4 5 A3  
1:1000 10 0 10 20 30 40 50 A1  
1:2000 10 0 10 20 30 40 50 A3

CLIENT  
**CANBERRA ESTATES CONSORTIUM NO. 36 PTY LIMITED**  
ASSOCIATED CONSULTANT  
SAUNDERS HAVILL GROUP  
PH: 1300 123 744

PROJECT NAME  
**WOODLINKS VILLAGE - STAGE 16**  
COLLINGWOOD DRIVE,  
COLLINGWOOD PARK

DRAWING TITLE  
**ELDER PARADE LONGITUDINAL SECTION AND CROSS SECTIONS**  
PROJECT No. **19-0023**  
DRAWING No. **108**  
REVISION **C**

(EW) REFER TO BULK EARTHWORKS DRAWING FOR LOT GRADING AND FINISHED SURFACE LEVELS

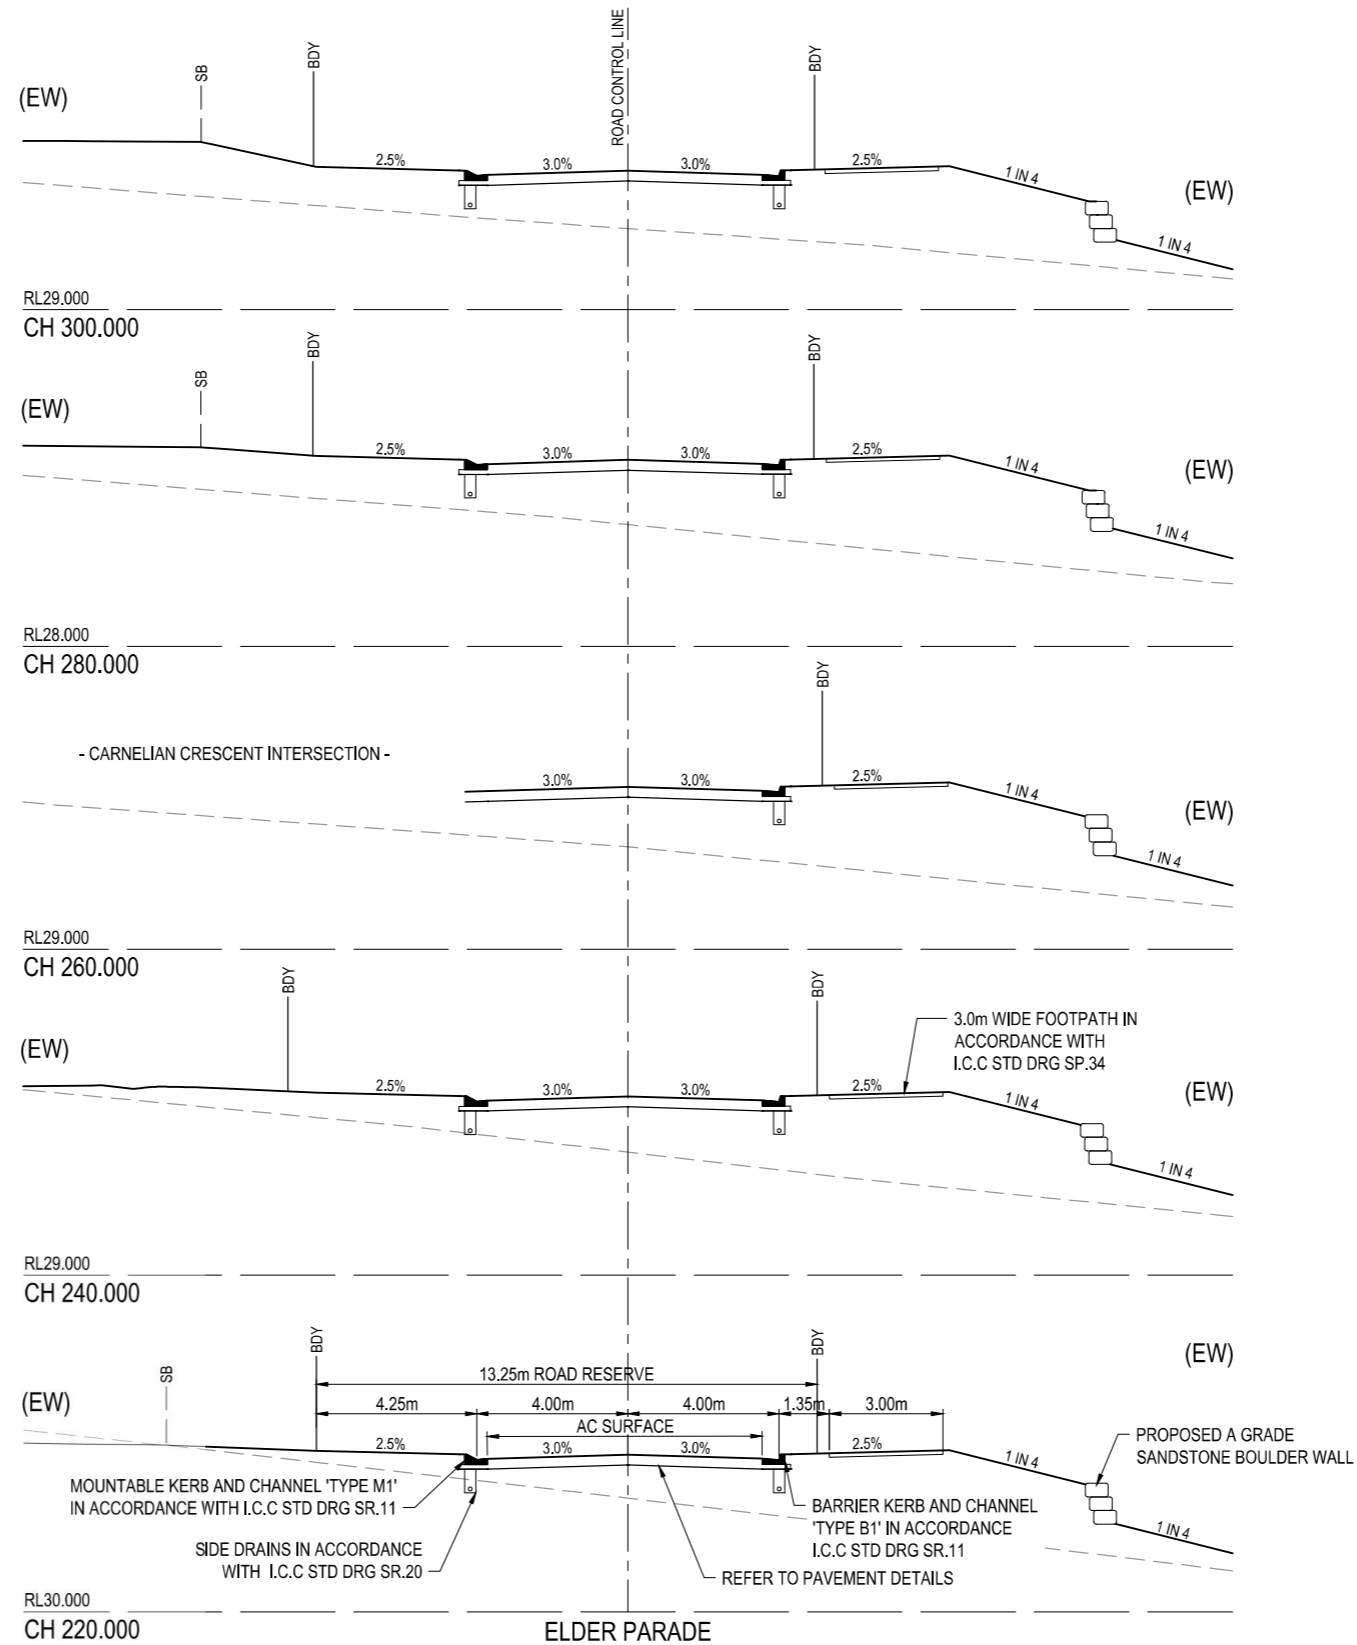

**AS-CONSTRUCTED CERTIFICATION**

Signature: *[Signature]* Date: 26/06/20  
 ANDREW NGO RPEQ No. 12329  
 For and on behalf of Peakurban PTY LTD

REV	DATE	DESIGN	DRAWN	ISSUED FOR CONSTRUCTION	REVISION DETAILS	DRAWN	STATUS	SCALE	CLIENT	PROJECT NAME	DRAWING TITLE
A	02.12.19	AC	CL	ISSUED FOR CONSTRUCTION							
B	06.05.20	TD	SC	AS CONSTRUCTED							
						TD	<b>AS CONSTRUCTED</b>	 PEAKURBAN DEVELOPMENT ENGINEERS - ADVISORS ENQUIRIES@PEAKURBAN.COM.AU	<b>CANBERRA ESTATES CONSORTIUM NO. 36 PTY LIMITED</b> ASSOCIATED CONSULTANT SAUNDERS HAVILL GROUP PH: 1300 123 744	<b>WOODLINKS VILLAGE - STAGE 16</b> COLLINGWOOD DRIVE, COLLINGWOOD PARK	<b>ELDER PARADE CROSS SECTIONS</b> PROJECT No. 19-0023 DRAWING No. 109 REVISION B
						TD	APPROVED ANDREW NGO RPEQ 12329 FOR AND ON BEHALF OF PEAKURBAN PTY LTD				

**ASSUMED PAVEMENT DETAILS (SUBJECT TO CBR TESTING)**

ROAD	ROAD CLASSIFICATION	DESIGN ESAs	ASSUMED CBR	SURFACING	BASE	SUB BASE	LOWER SUBBASE	TOTAL DEPTH
QUARTZ ROAD	ACCESS STREET	1.0 x 10 <sup>5</sup>	3	35mm	125mm	100mm	160mm	420mm


**NOTE:** THIS PAVEMENT DESIGN IS PRELIMINARY ONLY BASED ON AN ASSUMED CBR. THE CONTRACTOR SHALL SUPPLY THE SUPERINTENDENT WITH SUBGRADE TEST RESULTS NECESSARY FOR FINAL PAVEMENT DESIGN

**NOTE:**  
REFER TO SURVEYORS AS-CONSTRUCTED DRAWINGS  
PREPARED BY SAUNDERS HAVILL FOR FINISHED SURFACE LEVELS

**AS-CONSTRUCTED CERTIFICATION**

Signature: *[Signature]* Date: 26/06/20  
ANDREW NGO RPEQ No. 12329  
For and on behalf of Peakurban PTY LTD


(EW) REFER TO BULK EARTHWORKS DRAWING FOR LOT GRADING AND FINISHED SURFACE LEVELS

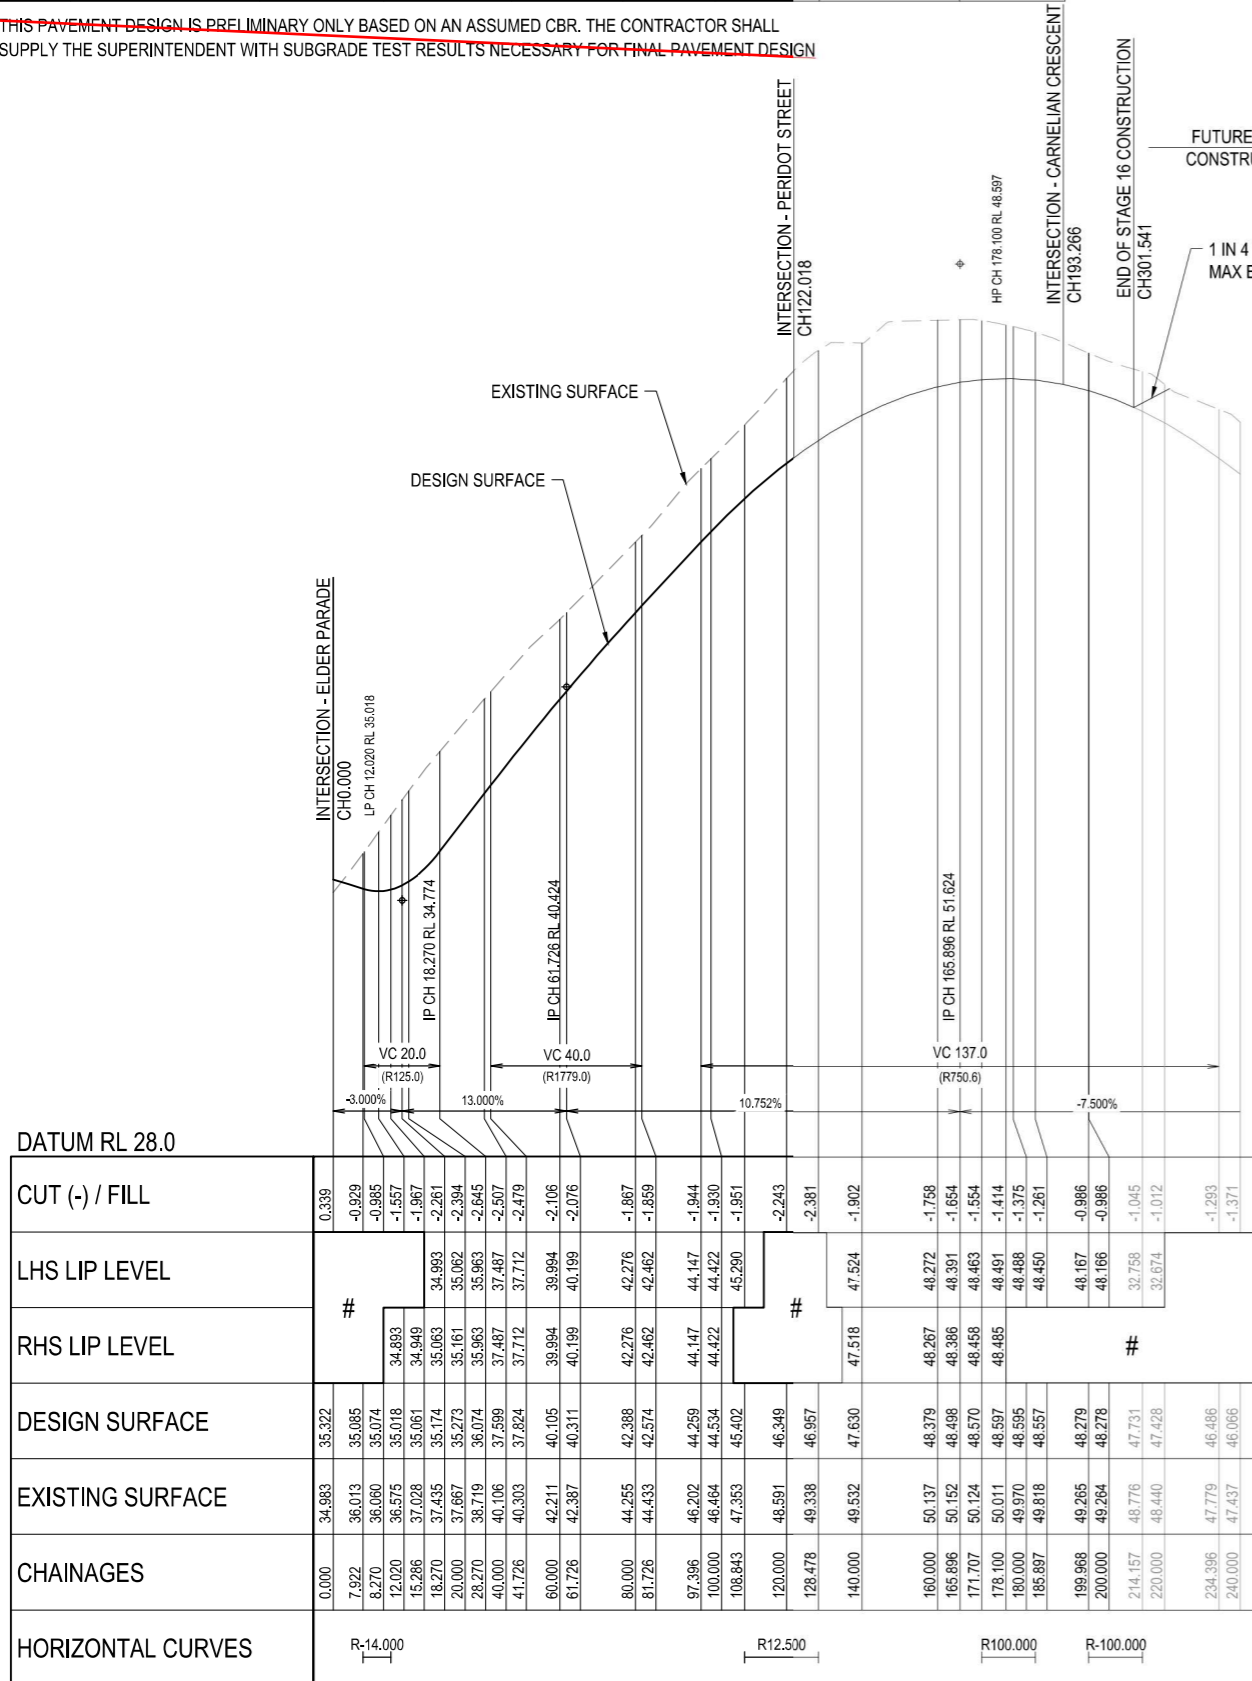

CUT (-) / FILL		0.339	-0.929	-0.985	-1.557	-1.967	-2.261	-2.394	-2.645	-2.507	-2.479	-2.106	-2.076	-1.867	-1.859	-1.944	-1.930	-1.951	-2.243	-2.381	-1.902	-1.758	-1.654	-1.554	-1.414	-1.375	-1.261	-0.986	-1.045	-1.012	-1.293	-1.371		
LHS LIP LEVEL	#																																	
RHS LIP LEVEL	#																																	
DESIGN SURFACE		34.983	35.322	35.085	35.074	34.893	34.949	35.063	35.174	35.161	35.062	34.984	40.199	42.276	42.462	44.147	44.422	45.290	46.349	46.957	47.630	48.379	48.498	48.570	48.485	48.595	48.557	48.279	48.278	47.731	47.428	46.486	46.066	
EXISTING SURFACE		34.983	36.013	36.060	36.575	35.018	34.949	35.063	35.174	35.161	35.062	34.984	40.199	42.276	42.462	44.147	44.422	45.290	46.349	46.957	47.630	48.379	48.498	48.570	48.485	48.595	48.557	48.279	48.278	47.731	47.428	46.486	46.066	
CHAINAGES		0.000	7.922	8.270	12.020	15.286	18.270	20.000	28.270	40.000	41.726	60.000	61.726	80.000	81.726	97.396	100.000	108.843	120.000	128.478	140.000	160.000	165.896	171.707	178.100	180.000	185.897	199.968	200.000	214.157	220.000	234.396	240.000	
HORIZONTAL CURVES		R-14.000		R-12.500												R-100.000		R-100.000																


# REFER INTERSECTION DRAWINGS FOR LIP LEVELS  
QUARTZ ROAD

FUTURE ROAD CONSTRUCTION  
1 IN 4 TEMPORARY MAX BATTER TO N.S.  
END OF STAGE 16 CONSTRUCTION  
INTERSECTION - PERIDOT STREET  
INTERSECTION - CARNELIAN CRESCENT

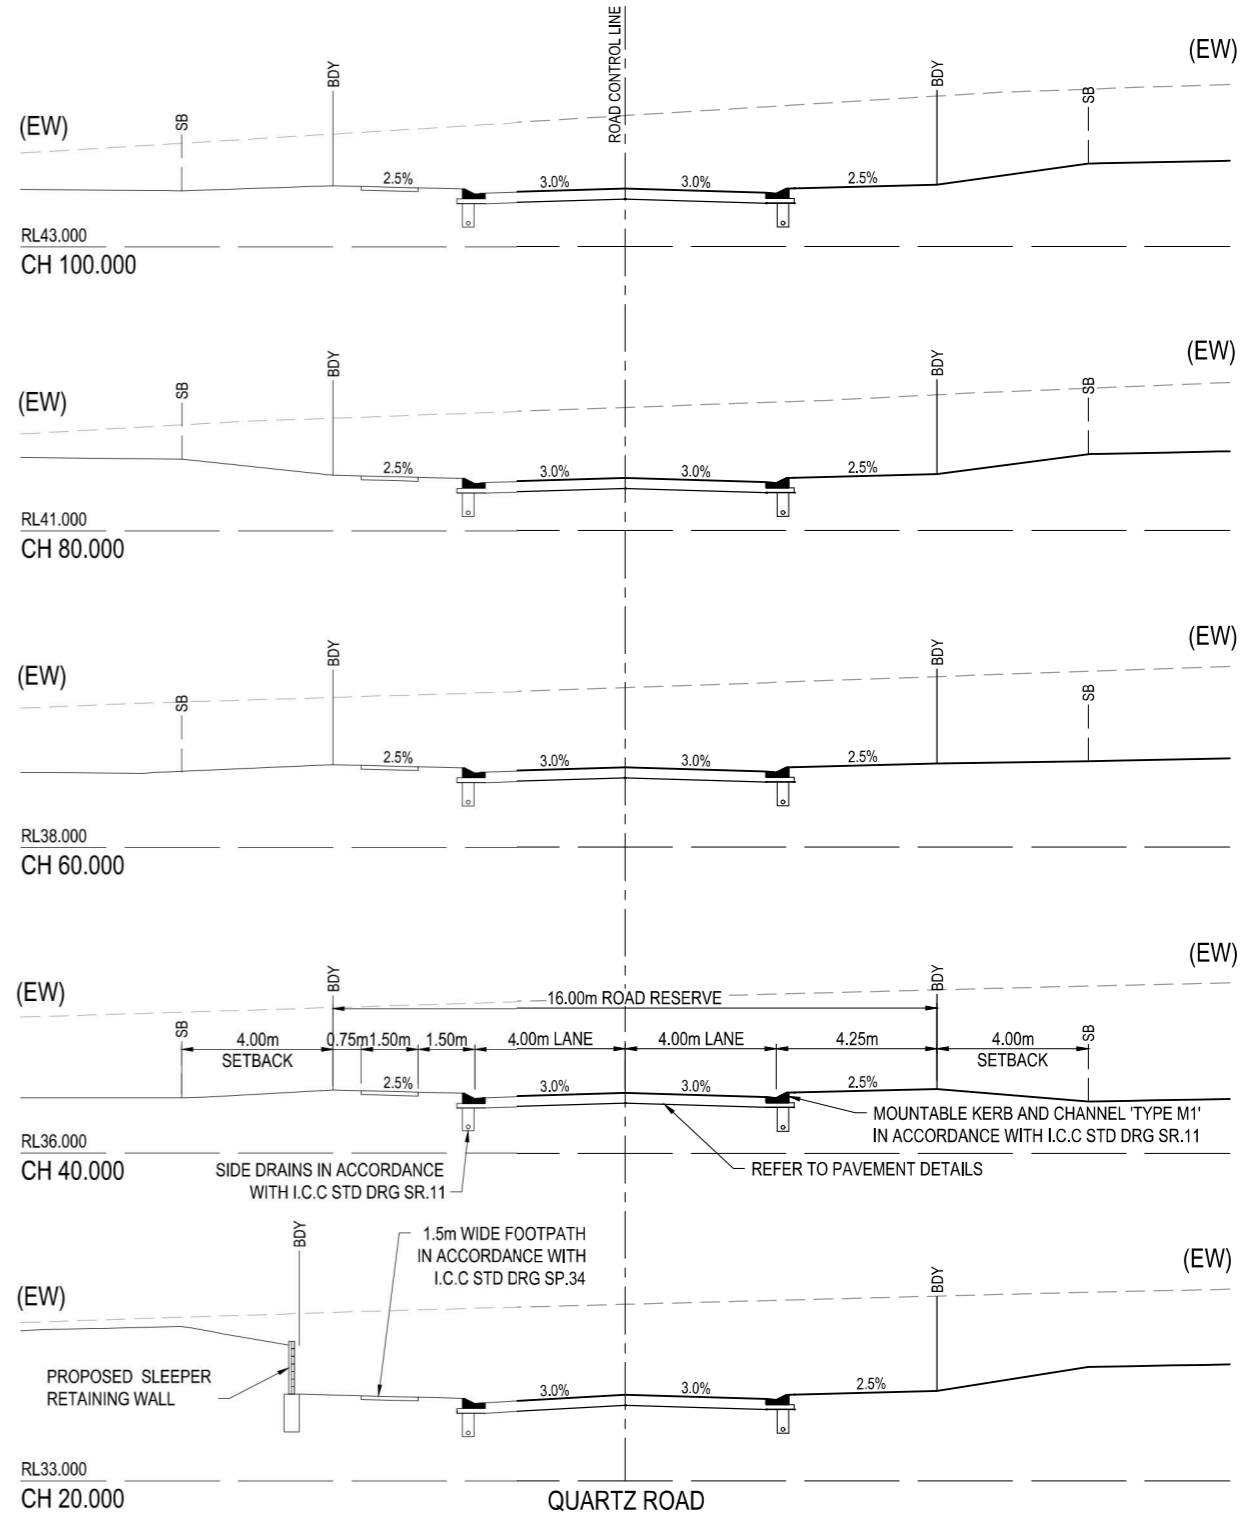

<table border="1"> <thead> <tr> <th>REV</th> <th>DATE</th> <th>DESIGN</th> <th>DRAWN</th> <th>REVISION DETAILS</th> </tr> </thead> <tbody> <tr> <td>A</td> <td>02.12.19</td> <td>AC</td> <td>CL</td> <td>ISSUED FOR CONSTRUCTION</td> </tr> <tr> <td>B</td> <td>05.08.20</td> <td>TD</td> <td>SC</td> <td>AS CONSTRUCTED</td> </tr> </tbody> </table>	REV	DATE	DESIGN	DRAWN	REVISION DETAILS	A	02.12.19	AC	CL	ISSUED FOR CONSTRUCTION	B	05.08.20	TD	SC	AS CONSTRUCTED	<table border="1"> <thead> <tr> <th>DRAWN</th> <th>STATUS</th> </tr> </thead> <tbody> <tr> <td>TD</td> <td><b>AS CONSTRUCTED</b></td> </tr> </tbody> </table>	DRAWN	STATUS	TD	<b>AS CONSTRUCTED</b>	<p>SAUNDERS HAVILL GROUP PH: 1300 123 744</p>	<table border="1"> <thead> <tr> <th>SCALE</th> </tr> </thead> <tbody> <tr> <td>1:100 1 0 1 2 3 4 5 A1</td> </tr> <tr> <td>1:200 1 0 1 2 3 4 5 A3</td> </tr> <tr> <td>1:1000 10 0 10 20 30 40 50 A1</td> </tr> <tr> <td>1:2000 10 0 10 20 30 40 50 A3</td> </tr> </tbody> </table>	SCALE	1:100 1 0 1 2 3 4 5 A1	1:200 1 0 1 2 3 4 5 A3	1:1000 10 0 10 20 30 40 50 A1	1:2000 10 0 10 20 30 40 50 A3	<table border="1"> <thead> <tr> <th>CLIENT</th> <th>PROJECT NAME</th> <th>DRAWING TITLE</th> </tr> </thead> <tbody> <tr> <td>CANBERRA ESTATES CONSORTIUM NO. 36 PTY LIMITED</td> <td>WOODLINKS VILLAGE - STAGE 16</td> <td>QUARTZ ROAD LONGITUDINAL SECTION AND CROSS SECTIONS</td> </tr> </tbody> </table>	CLIENT	PROJECT NAME	DRAWING TITLE	CANBERRA ESTATES CONSORTIUM NO. 36 PTY LIMITED	WOODLINKS VILLAGE - STAGE 16	QUARTZ ROAD LONGITUDINAL SECTION AND CROSS SECTIONS	<table border="1"> <thead> <tr> <th>PROJECT No.</th> <th>DRAWING No.</th> <th>REVISION</th> </tr> </thead> <tbody> <tr> <td>19-0023</td> <td>110</td> <td>B</td> </tr> </tbody> </table>	PROJECT No.	DRAWING No.	REVISION	19-0023	110	B
REV	DATE	DESIGN	DRAWN	REVISION DETAILS																																					
A	02.12.19	AC	CL	ISSUED FOR CONSTRUCTION																																					
B	05.08.20	TD	SC	AS CONSTRUCTED																																					
DRAWN	STATUS																																								
TD	<b>AS CONSTRUCTED</b>																																								
SCALE																																									
1:100 1 0 1 2 3 4 5 A1																																									
1:200 1 0 1 2 3 4 5 A3																																									
1:1000 10 0 10 20 30 40 50 A1																																									
1:2000 10 0 10 20 30 40 50 A3																																									
CLIENT	PROJECT NAME	DRAWING TITLE																																							
CANBERRA ESTATES CONSORTIUM NO. 36 PTY LIMITED	WOODLINKS VILLAGE - STAGE 16	QUARTZ ROAD LONGITUDINAL SECTION AND CROSS SECTIONS																																							
PROJECT No.	DRAWING No.	REVISION																																							
19-0023	110	B																																							

(EW) REFER TO BULK EARTHWORKS  
DRAWING FOR LOT GRADING AND  
FINISHED SURFACE LEVELS

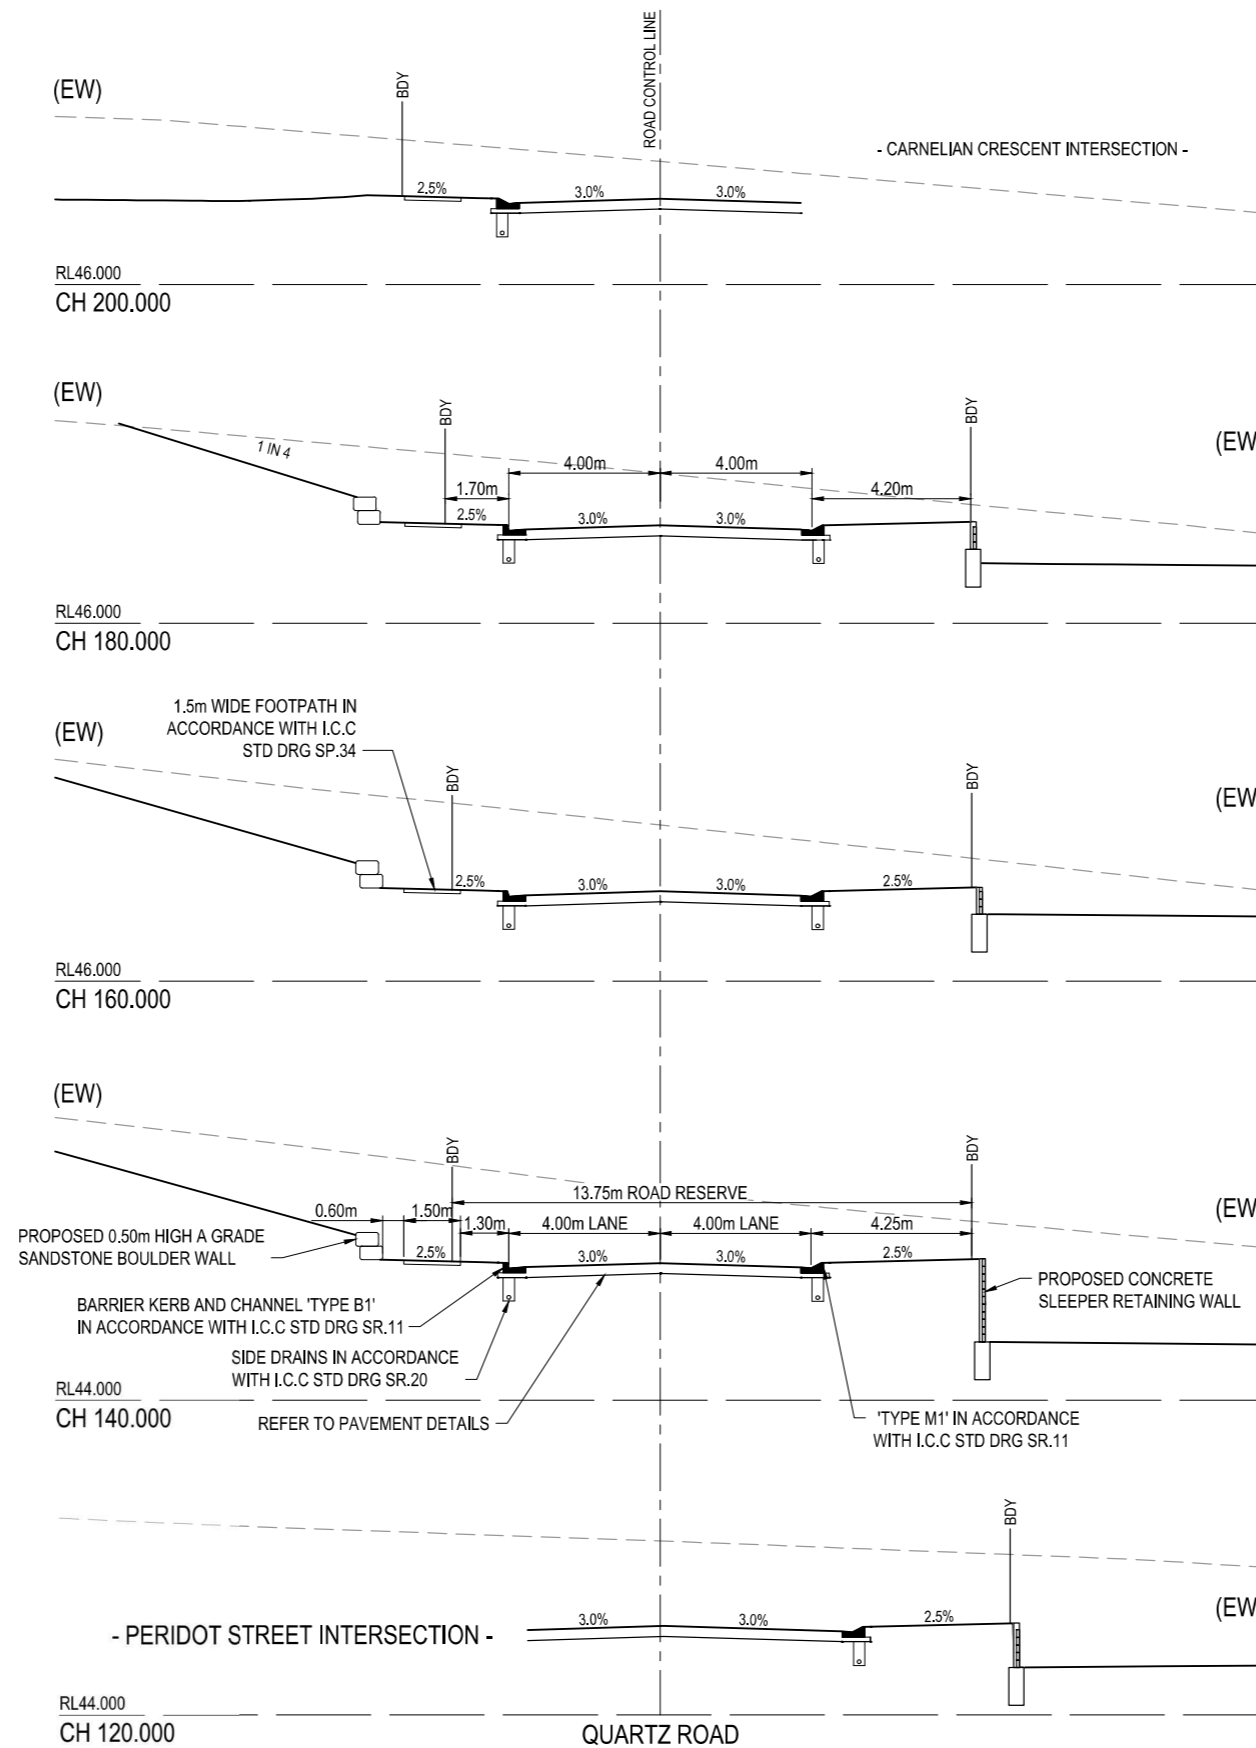

**AS-CONSTRUCTED CERTIFICATION**

Signature: *[Signature]* Date: 26/06/20  
ANDREW NGO RPEQ No. 12329  
For and on behalf of Peakurban PTY LTD

REV	DATE	DESIGN	DRAWN	ISSUED FOR CONSTRUCTION	REVISION DETAILS	DRAWN	STATUS	SCALE	CLIENT	PROJECT NAME	DRAWING TITLE
A	02.12.19	AC	CL	ISSUED FOR CONSTRUCTION							
B	10.03.20	AC	CL	SANDSTONE BOULDER WALL AMENDED							
C	05.06.20	TD	SC	AS CONSTRUCTED							
						TD	<b>AS CONSTRUCTED</b>	 DEVELOPMENT ENGINEERS - ADVISORS ENQUIRIES@PEAKURBAN.COM.AU	<b>CANBERRA ESTATES CONSORTIUM NO. 36 PTY LIMITED</b> ASSOCIATED CONSULTANT SAUNDERS HAVILL GROUP PH: 1300 123 744	<b>WOODLINKS VILLAGE - STAGE 16</b>  COLLINGWOOD DRIVE, COLLINGWOOD PARK	<b>QUARTZ ROAD CROSS SECTIONS</b>  PROJECT No. 19-0023 DRAWING No. 111 REVISION C
						TD	APPROVED ANDREW NGO RPEQ 12329  FOR AND ON BEHALF OF PEAKURBAN PTY LTD				

~~ASSUMED PAVEMENT DETAILS (SUBJECT TO CBR TESTING)~~

ROAD	ROAD CLASSIFICATION	DESIGN ESAs	ASSUMED CBR	SURFACING	BASE	SUB BASE	LOWER SUBBASE	TOTAL DEPTH
CARNELIAN CRESCENT	ACCESS STREET	1.0 x 10 <sup>5</sup>	3	35mm	125mm	100mm	160mm	420mm


NOTE: THIS PAVEMENT DESIGN IS PRELIMINARY ONLY BASED ON AN ASSUMED CBR. THE CONTRACTOR SHALL SUPPLY THE SUPERINTENDENT WITH SUBGRADE TEST RESULTS NECESSARY FOR FINAL PAVEMENT DESIGN

**NOTE:**

REFER TO SURVEYORS AS-CONSTRUCTED DRAWINGS PREPARED BY SAUNDERS HAVILL FOR FINISHED SURFACE LEVELS

**AS-CONSTRUCTED CERTIFICATION**


Signature: *[Signature]* Date: 26/06/20  
 ANDREW NGO RPEQ No. 12329  
 For and on behalf of Peakurban PTY LTD

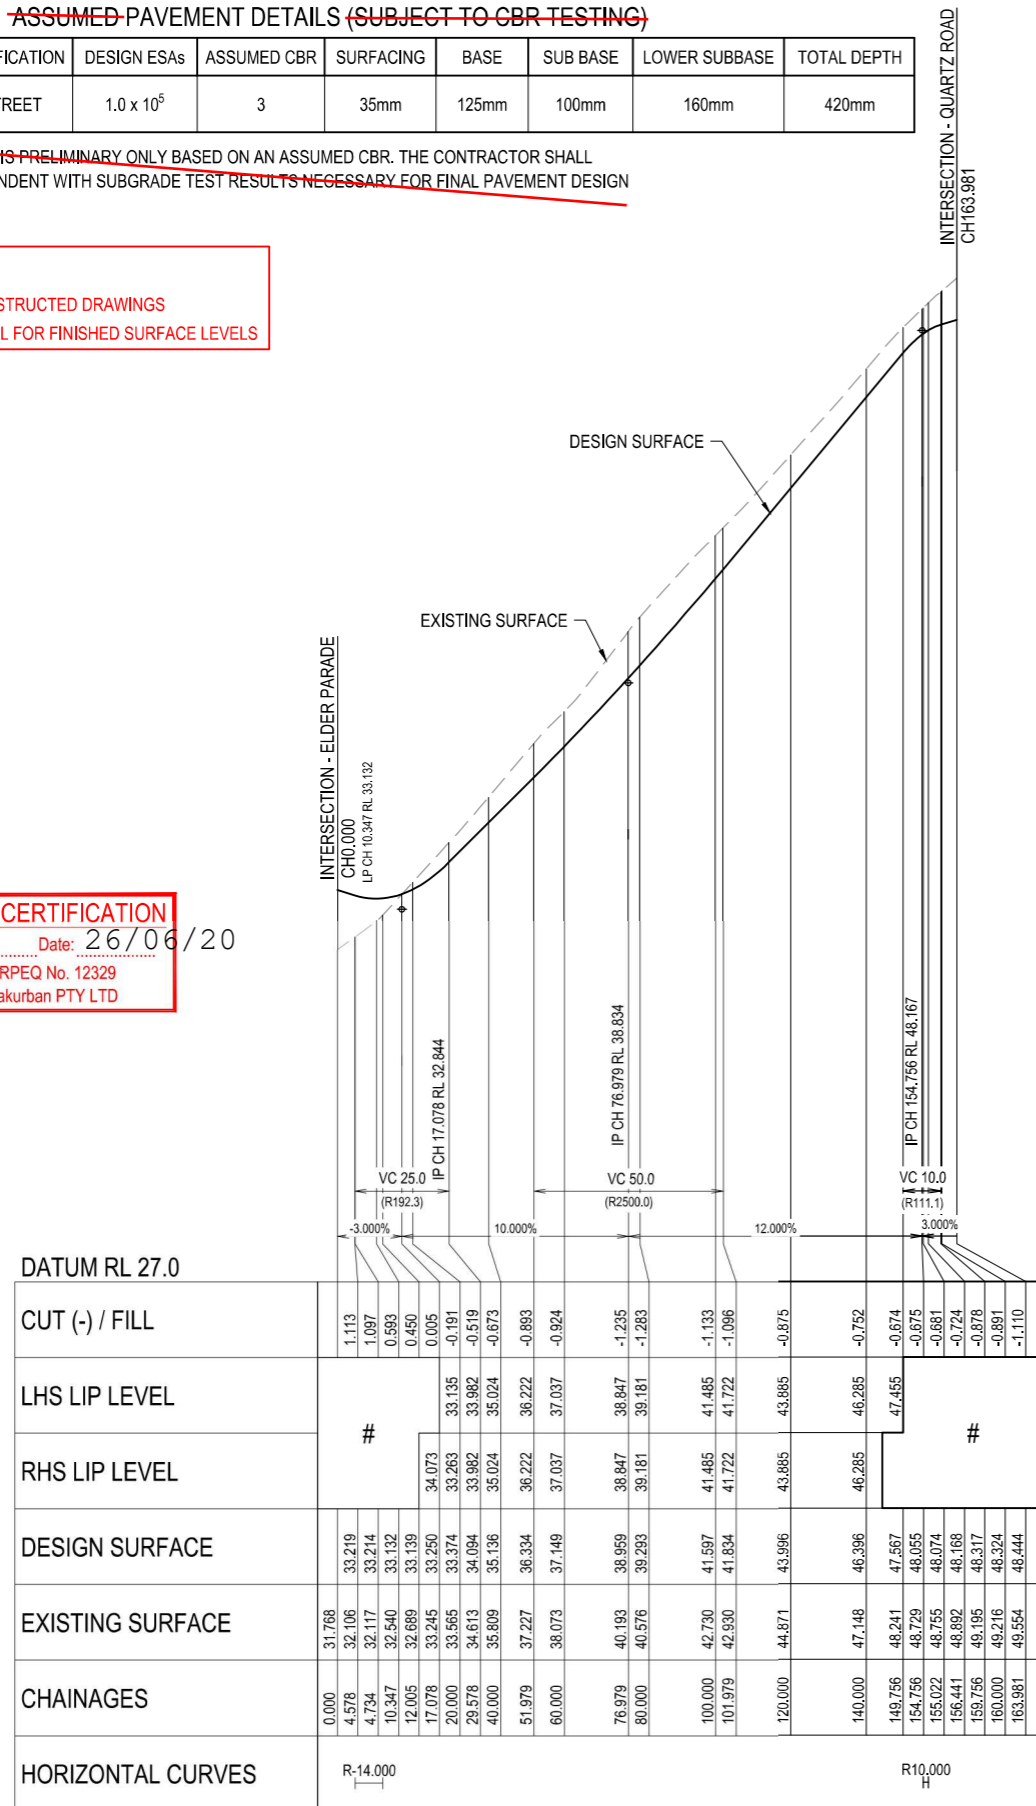



DATUM RL 27.0			
CUT (-) / FILL		1.113	
LHS LIP LEVEL			
RHS LIP LEVEL	#		#
DESIGN SURFACE		33.219	
EXISTING SURFACE		31.768	
CHAINAGES		0.000	
HORIZONTAL CURVES		R-14.000	R10.000

# REFER INTERSECTION DRAWINGS FOR LIP LEVELS CARNELIAN CRESCENT

(EW) REFER TO BULK EARTHWORKS DRAWING FOR LOT GRADING AND FINISHED SURFACE LEVELS

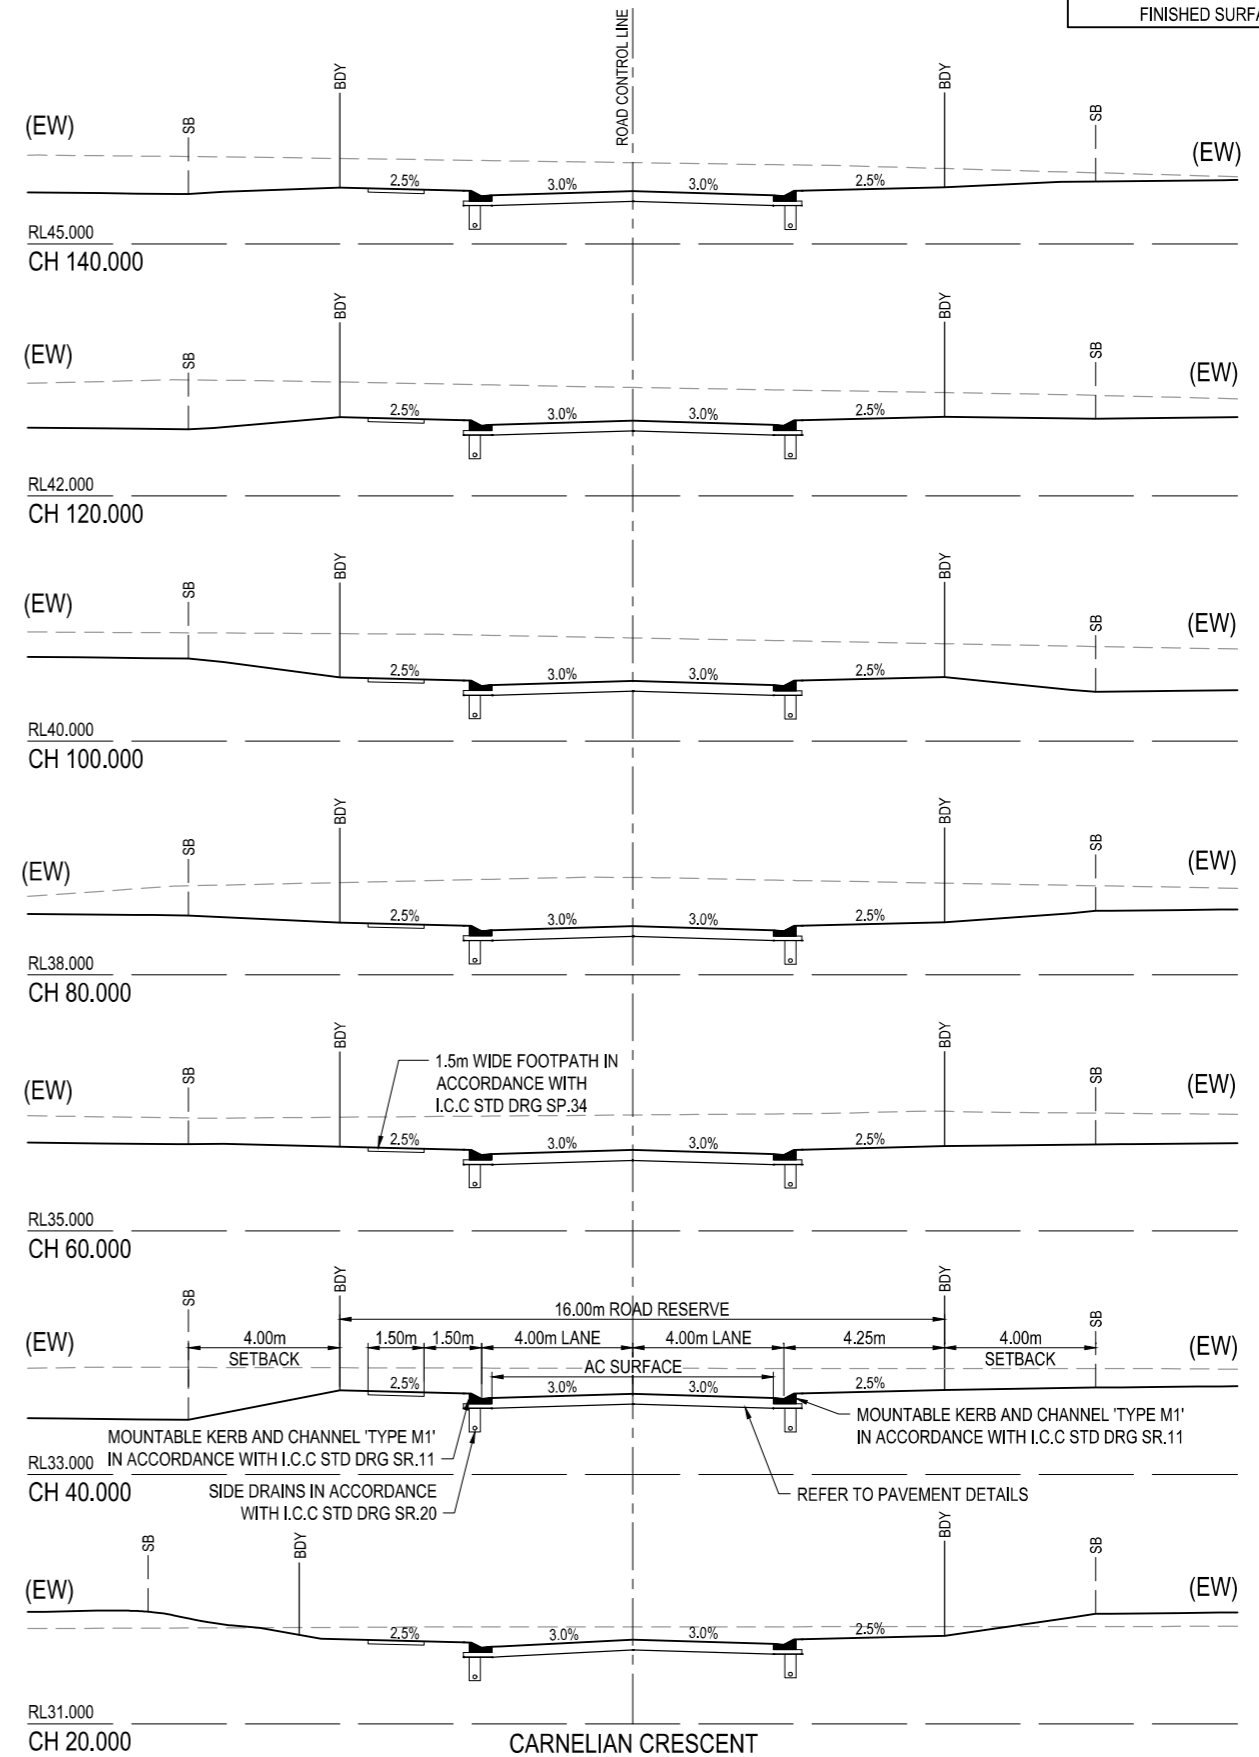


REV	DATE	DESIGN	DRAWN	REVISION DETAILS	DRAWN	STATUS	SCALE	CLIENT	PROJECT NAME	DRAWING TITLE
A	02.12.19	AC	CL	ISSUED FOR CONSTRUCTION	TD	AS CONSTRUCTED	1:100 1 0 1 2 3 4 5 A1	CANBERRA ESTATES CONSORTIUM NO. 36 PTY LIMITED	WOODLINKS VILLAGE - STAGE 16	CARNELIAN CRESCENT LONGITUDINAL SECTION AND CROSS SECTIONS
B	05.06.20	TD	SC	AS CONSTRUCTED	TD	AS CONSTRUCTED	1:200 10 0 10 20 30 40 50 A1	SAUNDERS HAVILL GROUP	COLLINGWOOD DRIVE, COLLINGWOOD PARK	

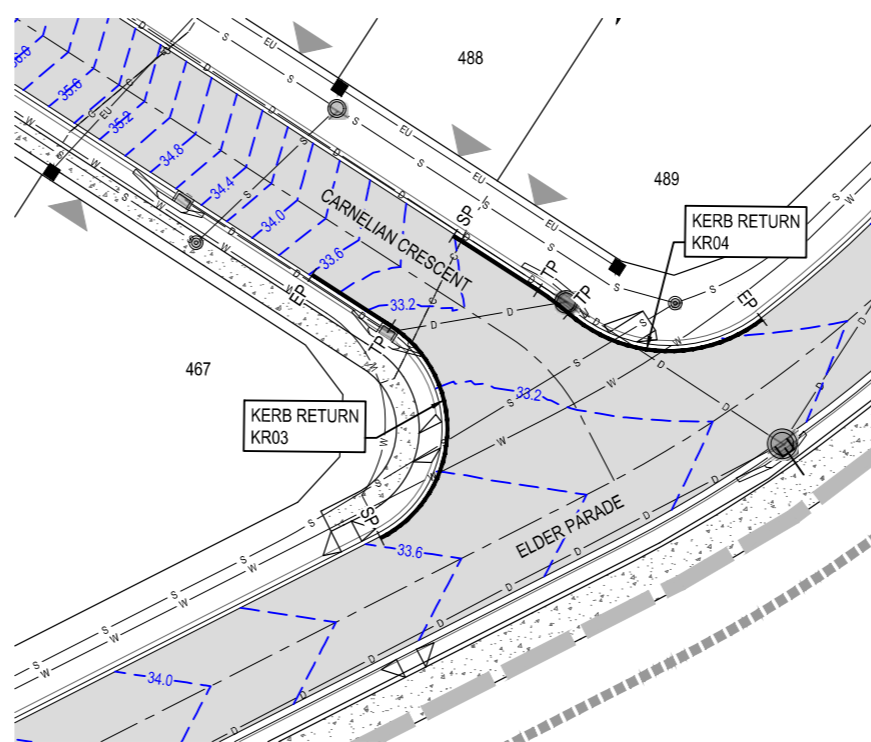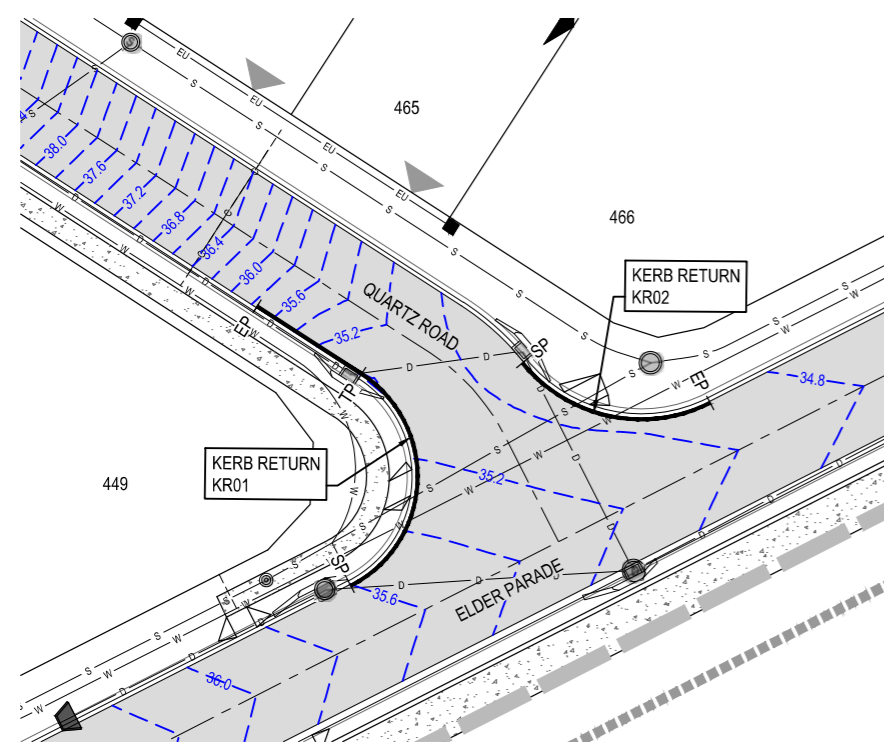


- LEGEND**
- PROPOSED ROAD CONTROL LINE
  - PROPOSED KERB INVERT LINE
  - PROPOSED CONCRETE PATH AND PRAM RAMP
  - PROPOSED NEW ROAD PAVEMENT
  - ▲ INDICATIVE DRIVEWAY LOCATION
  - - - 53.4 - - - PROPOSED PAVEMENT CONTOUR (0.2m INTERVAL)
  - D - D - D PROPOSED STORMWATER DRAINAGE PIPE
  - S - S - S PROPOSED SEWERAGE MAIN
  - W - W - W PROPOSED WATER MAIN
  - C - C - C PROPOSED WATER CONDUIT
  - PROPOSED KERB SETOUT LINE
  - SP --- PROPOSED KERB SETOUT START POINT
  - EP --- PROPOSED KERB SETOUT END POINT


**NOTE:**  
REFER TO SURVEYORS AS-CONSTRUCTED DRAWINGS  
PREPARED BY SAUNDERS HAVILL FOR FINISHED SURFACE LEVELS

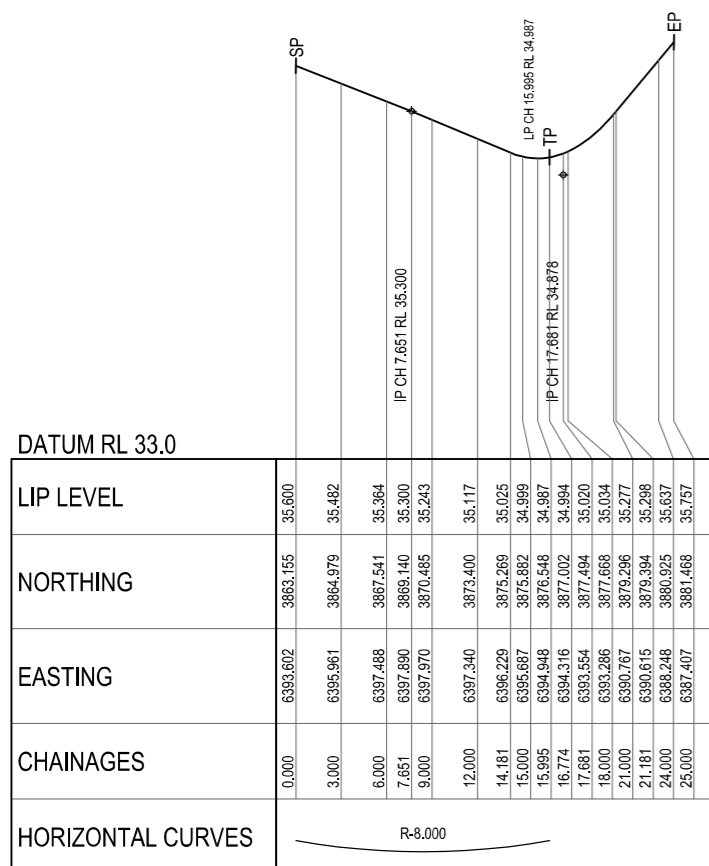


KR 01

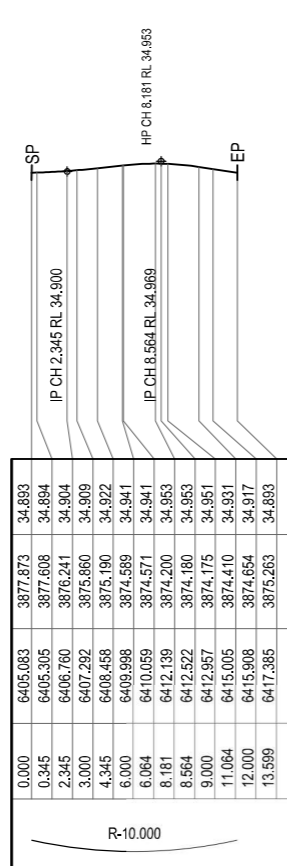

KR 02

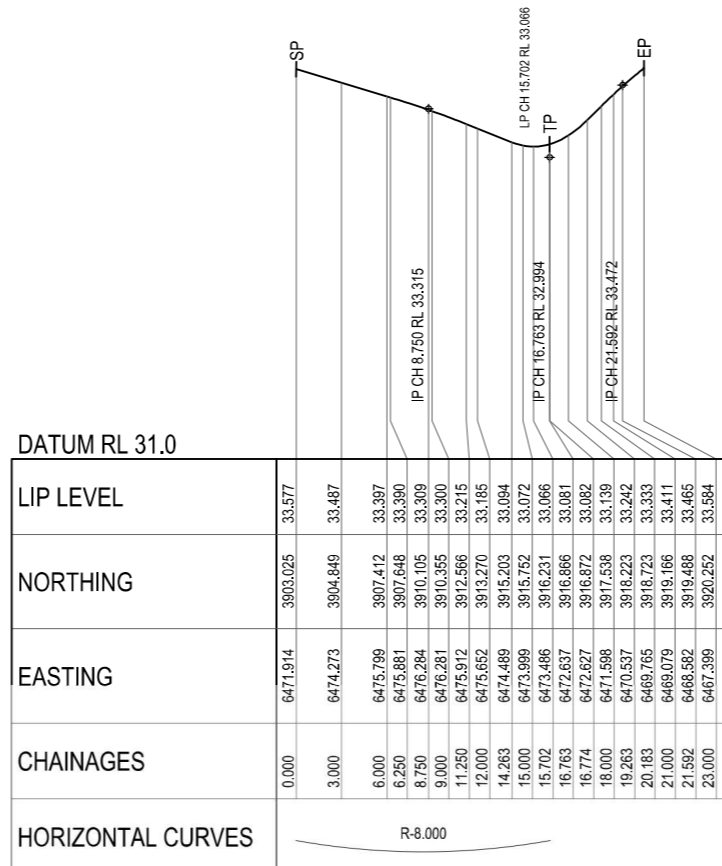

KR 03

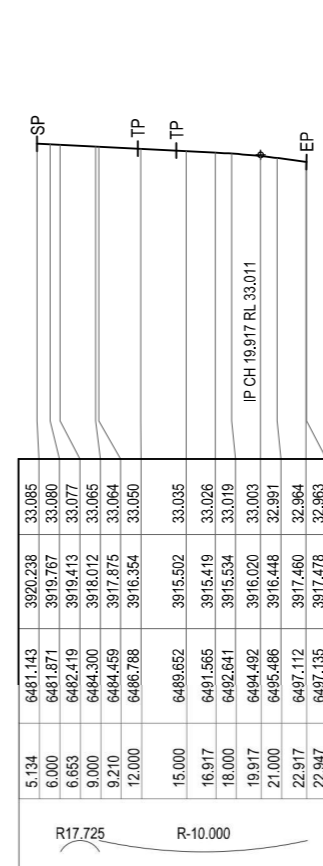


KR 04

**AS-CONSTRUCTED CERTIFICATION**  
Signature: \_\_\_\_\_ Date: 26/06/20  
ANDREW NGO RPEQ No. 12329  
For and on behalf of Peakurban PTY LTD

REV	DATE	DESIGN	DRAWN	REVISION DETAILS
A	02.12.19	AC	CL	ISSUED FOR CONSTRUCTION
B	05.08.20	TD	SC	AS CONSTRUCTED

DRAWN	STATUS
TD	<b>AS CONSTRUCTED</b>
DESIGN	APPROVED
TD	ANDREW NGO RPEQ 12329

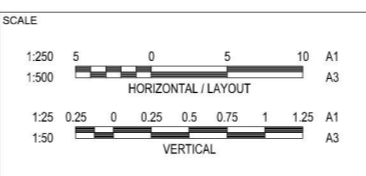




CLIENT  
**CANBERRA ESTATES CONSORTIUM NO. 36 PTY LIMITED**

ASSOCIATED CONSULTANT  
SAUNDERS HAVILL GROUP  
PH: 1300 123 744

PROJECT NAME  
**WOODLINKS VILLAGE - STAGE 16**

COLLINGWOOD DRIVE,  
COLLINGWOOD PARK

DRAWING TITLE		
<b>INTERSECTION DETAILS LAYOUT PLAN SHEET 1 OF 2</b>		
PROJECT No.	DRAWING No.	REVISION
19-0023	113	B

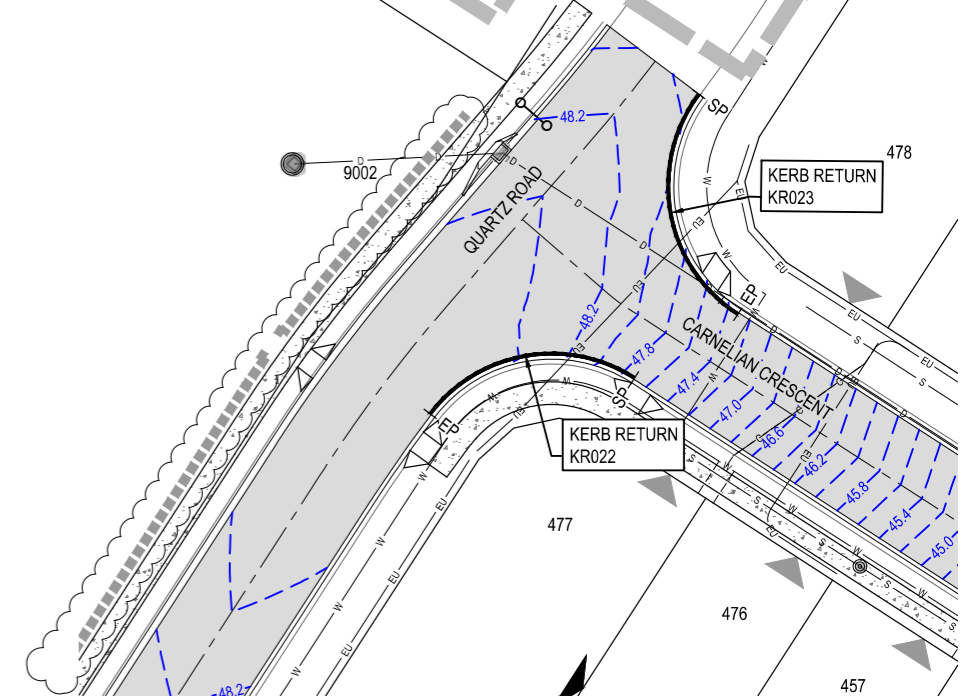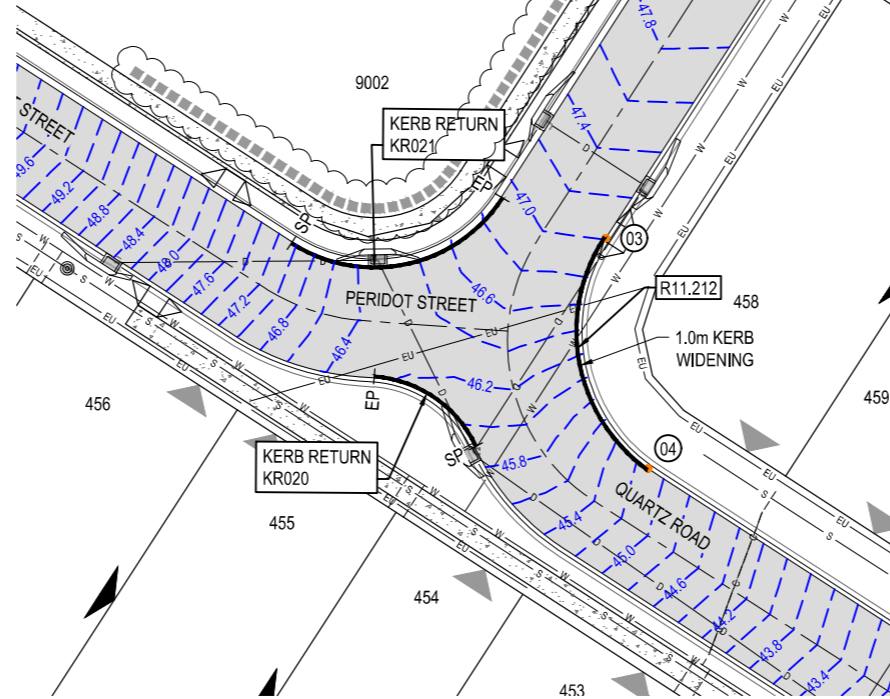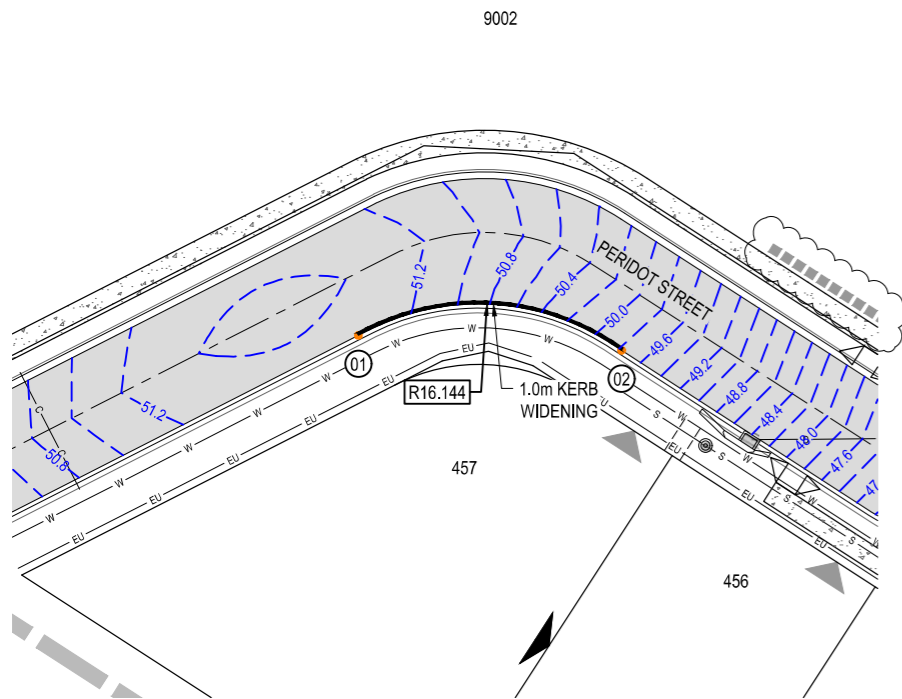

**WARNING! - EXISTING SERVICES**

EXTREME CARE SHOULD BE TAKEN WHEN EXCAVATING IN THIS AREA. THE FOLLOWING EXISTING SERVICES ARE LIKELY TO BE PRESENT IN THE VICINITY OF THE SITE:

- ELECTRICAL CABLES
- TELECOMMUNICATIONS CABLES
- GAS MAINS
- WATER MAINS
- SEWER MAINS





THE CONTRACTOR SHOULD CONTACT THE SERVICE PROVIDER FOR FURTHER INFORMATION AND SATISFY THEMSELVES OF ANY SPECIFIC TREATMENT OR REQUIREMENTS.



**NOTE:**  
REFER TO SURVEYORS AS-CONSTRUCTED DRAWINGS  
PREPARED BY SAUNDERS HAVILL FOR FINISHED SURFACE LEVELS

**KERB WIDENING SETOUT**

NUMBER	EASTING	NORTHING
01	6262.583	3951.909
02	6279.980	3950.923
03	6321.142	3946.635
04	6323.933	3931.396

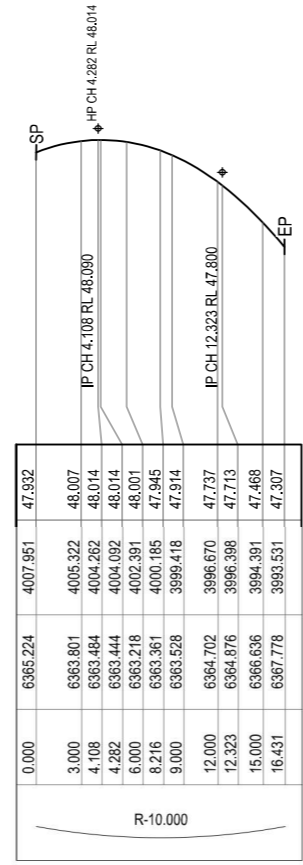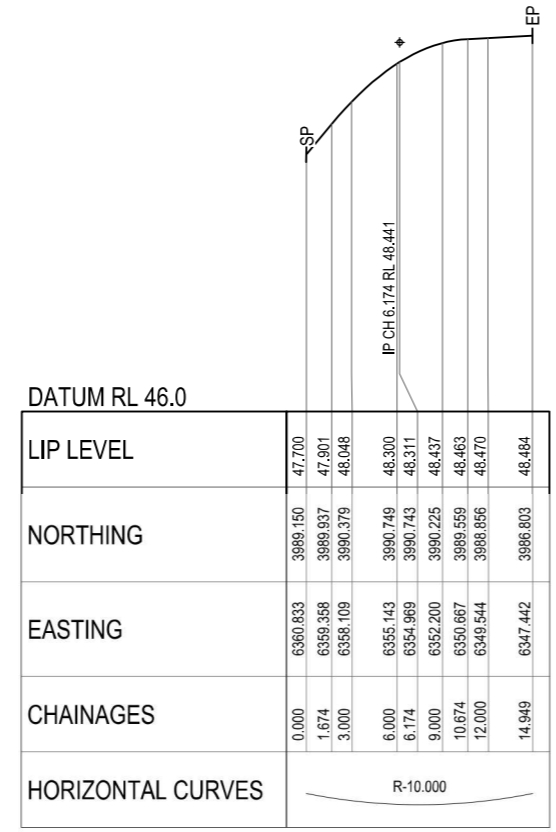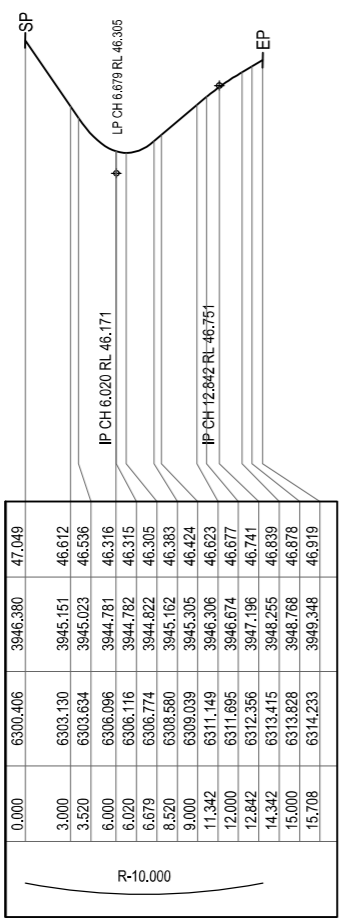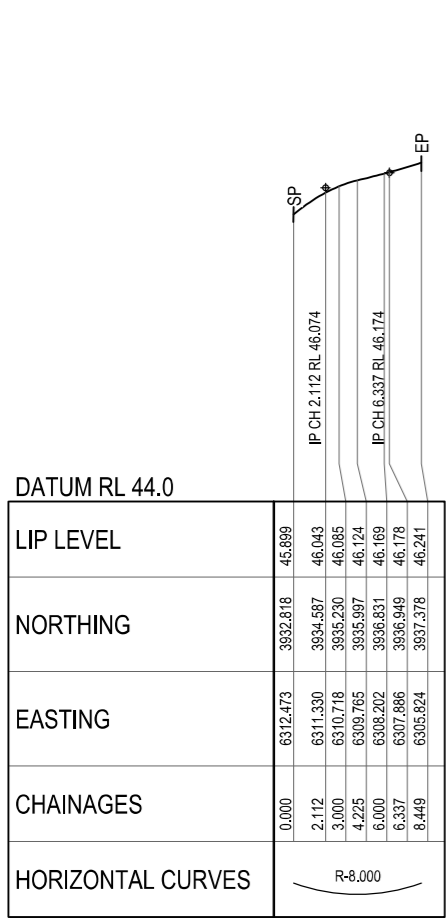

**AS-CONSTRUCTED CERTIFICATION**  
Signature: [Signature] Date: 26/06/20  
ANDREW NGO RPEQ No. 12329  
For and on behalf of Peakurban PTY LTD



REV	DATE	DESIGN	DRAWN	REVISION DETAILS	DRAWN	STATUS
A	02.12.19	AC	CL	ISSUED FOR CONSTRUCTION	TD	<b>AS CONSTRUCTED</b>
B	22.01.20	AC	MPG	PERIDOT STREET PAVEMENT CONTOURS AND KERB RETURNS AMENDED		
C	10.03.20	AC	CL	SANDSTONE BOULDER WALL AMENDED		
					DESIGN	APPROVED
					TD	ANDREW NGO RPEQ 12329

CLIENT	CANBERRA ESTATES CONSORTIUM NO. 36 PTY LIMITED
ASSOCIATED CONSULTANT	SAUNDERS HAVILL GROUP PH: 1300 123 744
PROJECT NAME	WOODLINKS VILLAGE - STAGE 16
COLLINGWOOD DRIVE, COLLINGWOOD PARK	
DRAWING TITLE	INTERSECTION DETAILS LAYOUT PLAN SHEET 2 OF 2
PROJECT No.	19-0023
DRAWING No.	114
REVISION	C

**NOTES:**

1. ALL SIGNS AND LINEMARKING SHALL BE IN ACCORDANCE WITH THE MANUAL OF UNIFORM TRAFFIC CONTROL DEVICES AND I.C.C. STANDARDS.
2. TRAFFIC SIGN POSTS SHALL BE IN ACCORDANCE WITH I.C.C. STD. DRG. SR.25.
3. STREET NAME SIGN SHALL BE IN ACCORDANCE WITH I.C.C. STD. DRG. SR.26
4. CONTRACTOR TO ENSURE SIGN LOCATIONS ARE CLEAR OF FUTURE DRIVEWAY LOCATIONS - LOCATE ON PB OR MID BLOCK.

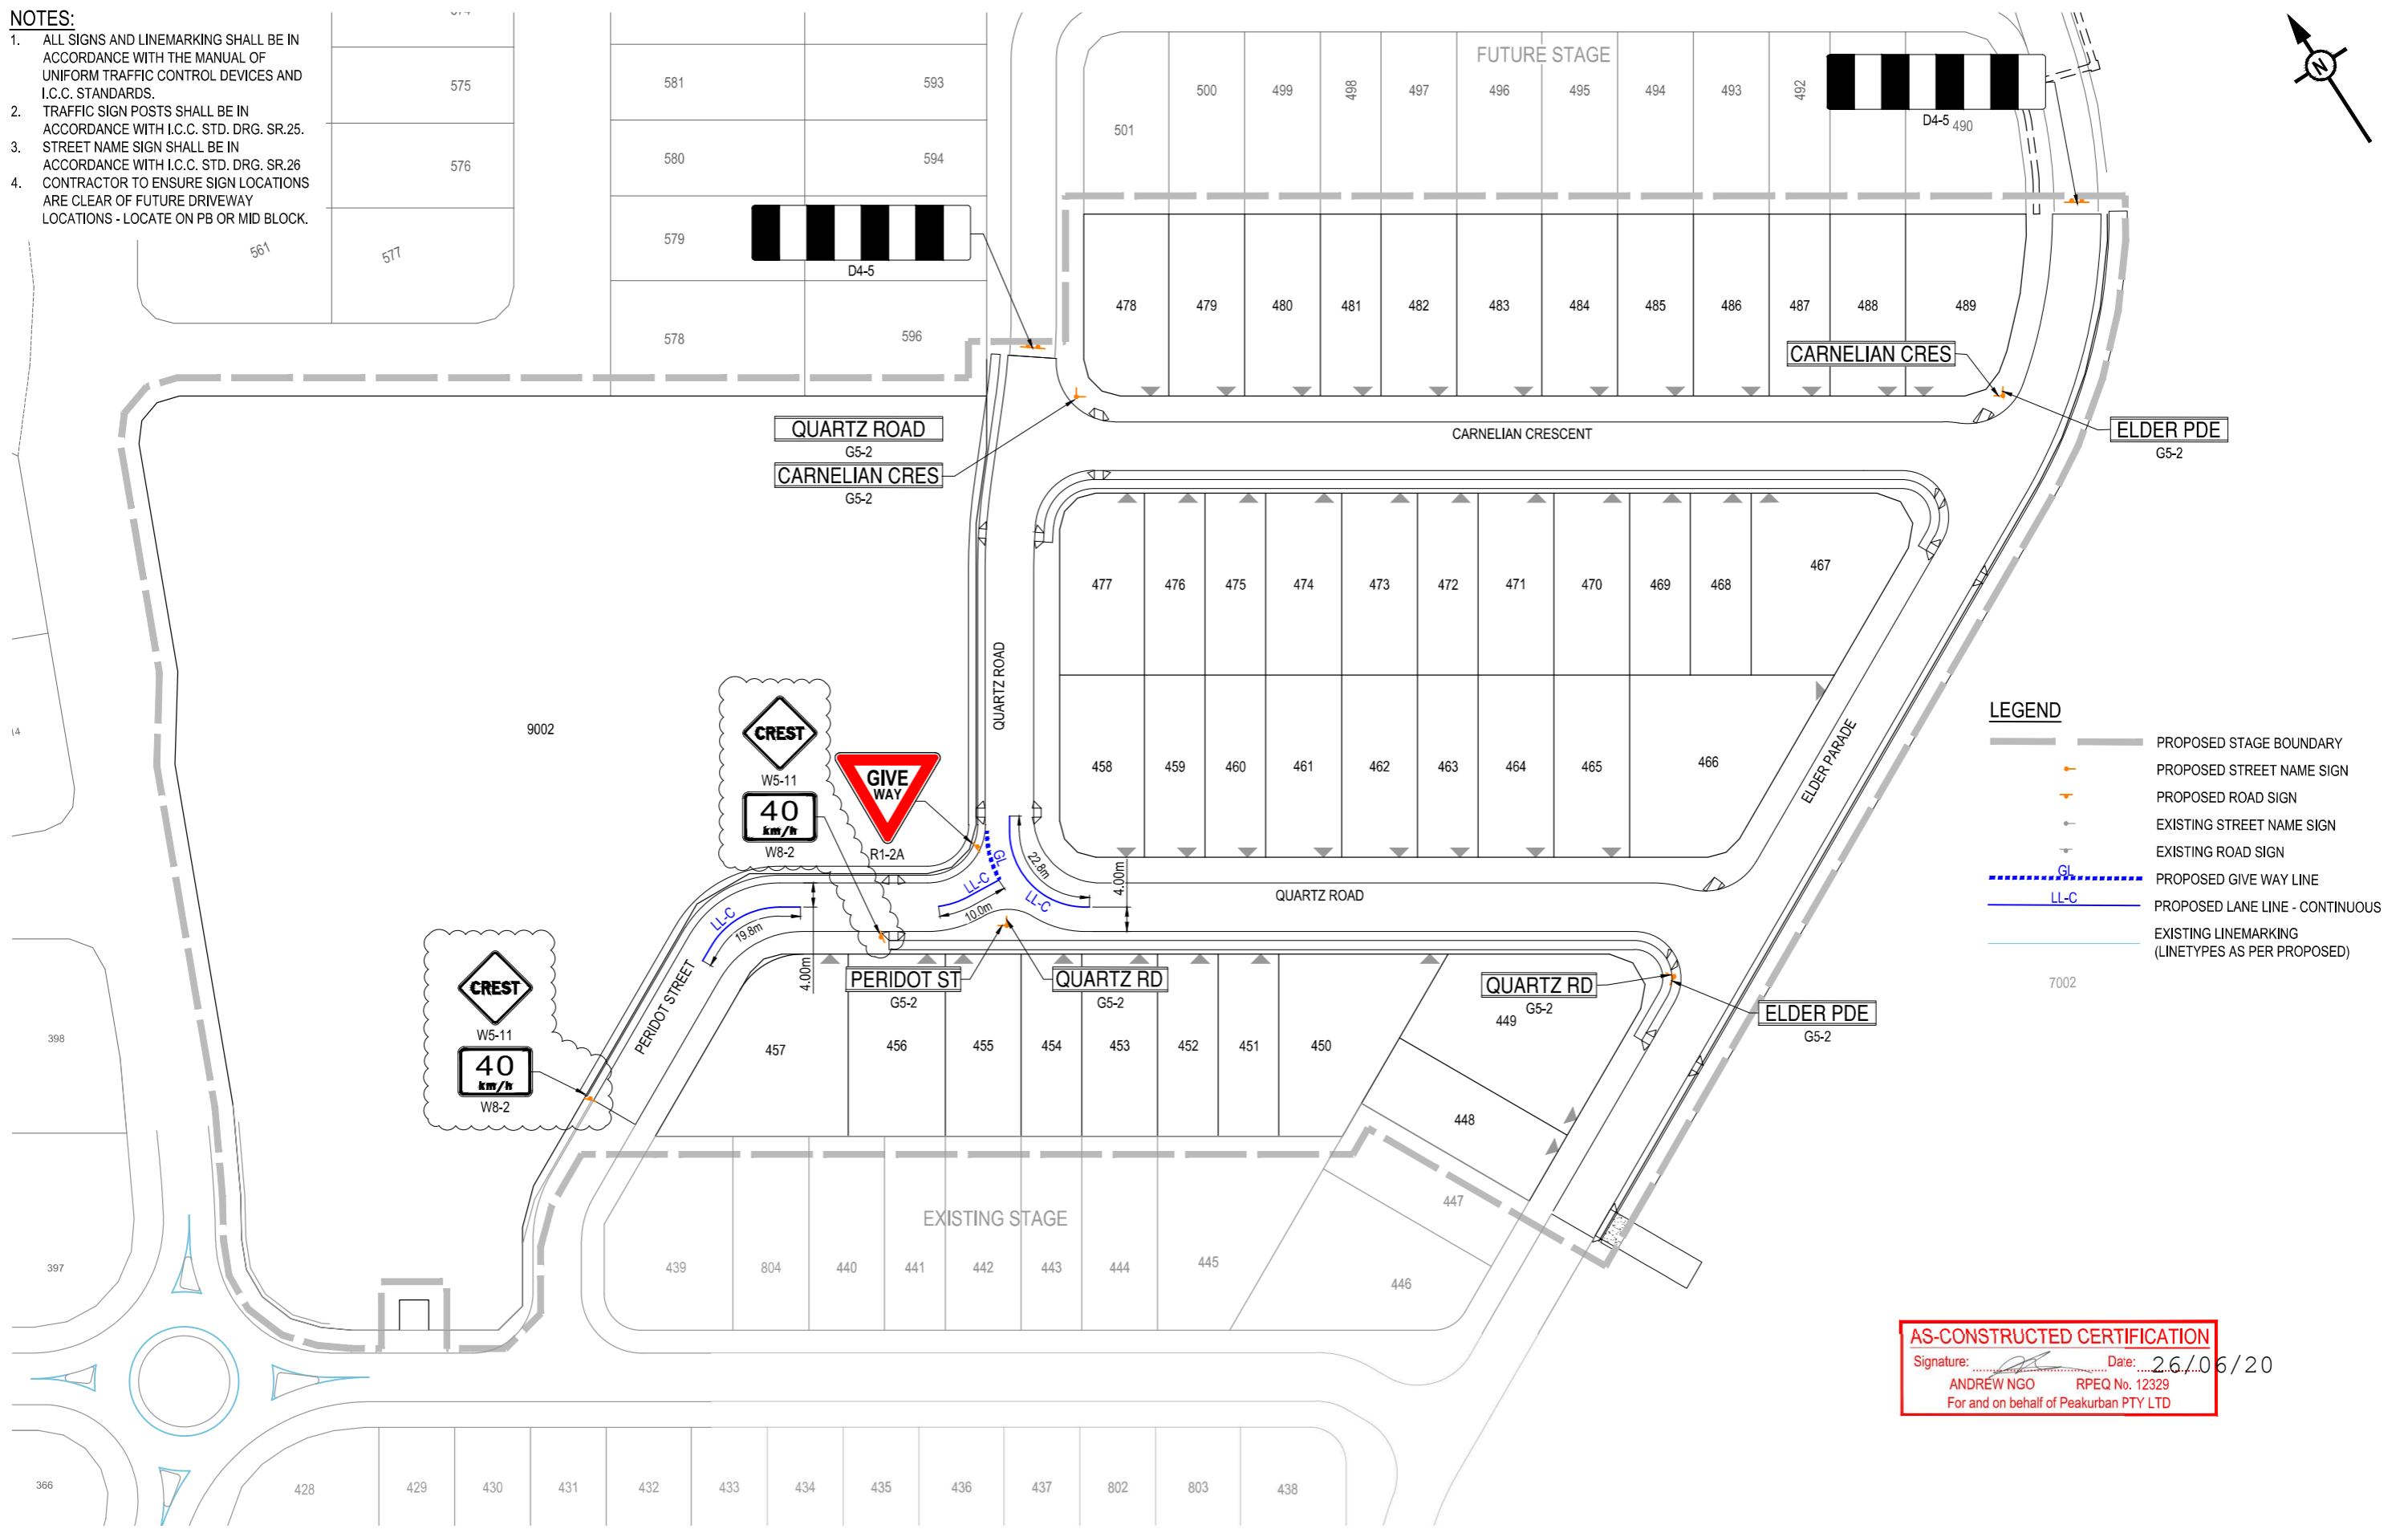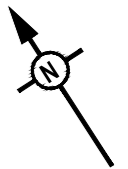


**LEGEND**

	PROPOSED STAGE BOUNDARY
	PROPOSED STREET NAME SIGN
	PROPOSED ROAD SIGN
	EXISTING STREET NAME SIGN
	EXISTING ROAD SIGN
	PROPOSED GIVE WAY LINE
	PROPOSED LANE LINE - CONTINUOUS
	EXISTING LINEMARKING (LINETYPES AS PER PROPOSED)

**AS-CONSTRUCTED CERTIFICATION**  
 Signature: *Andrew Ngo* Date: 2.6/2020  
 ANDREW NGO RPEQ No. 12329  
 For and on behalf of Peakurban PTY LTD

REV	DATE	DESIGN	DRAWN	REVISION DETAILS
A	02.12.19	AC	CL	ISSUED FOR CONSTRUCTION
B	22.01.20	AC	CL	W5-11, W8-2 SIGNS ADDED TO PERIDOT STREET
C	05.08.20	TD	SC	AS CONSTRUCTED

DRAWN	STATUS
TD	<b>AS CONSTRUCTED</b>
DESIGN	APPROVED
TD	ANDREW NGO RPEQ 12329

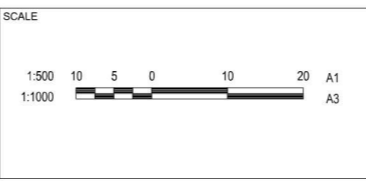

CLIENT  
**CANBERRA ESTATES CONSORTIUM NO. 36 PTY LIMITED**  
 ASSOCIATED CONSULTANT  
 SAUNDERS HAVILL GROUP  
 PH: 1300 123 744

PROJECT NAME  
**WOODLINKS VILLAGE - STAGE 16**  
 COLLINGWOOD DRIVE,  
 COLLINGWOOD PARK

DRAWING TITLE		
<b>SIGNS &amp; LINEMARKING LAYOUT PLAN</b>		
PROJECT No.	DRAWING No.	REVISION
19-0023	115	C








STRUCTURE NAME
STRUCTURE DESCRIPTION

**STORMWATER STRUCTURE NOTE:**  
 STANDARD ROUND MANHOLES LESS THAN 3.0m DEEP:  
 CONSTRUCT IN ACCORDANCE WITH THE LOCAL AUTHORITY STANDARDS.  
 STANDARD ROUND MANHOLES 3.0m > 5.3m DEEP:  
 CONSTRUCT IN ACCORDANCE WITH TMR STD DRAWINGS 1307 AND 1308.  
 STANDARD ROUND MANHOLES GREATER THAN 5.3m DEEP:  
 SHALL BE STRUCTURALLY DESIGNED (CERTIFIED) AND CONSTRUCTED BY CONTRACTOR ON A CASE BY CASE BASIS.  
 ROUND EXTENDED (900mm MAX) MANHOLES:  
 CONSTRUCT IN ACCORDANCE WITH PEAK URBAN STD DRAWINGS S-101 & S-102.  
 RECTANGULAR STRUCTURE (SPECIAL):  
 SHALL BE STRUCTURALLY DESIGNED (CERTIFIED) AND CONSTRUCTED BY CONTRACTOR ON A CASE BY CASE BASIS.

PIPE SIZE (mm Class)

PIPE GRADE %  
 PIPE SLOPE 1 in X  
 FULL PIPE FLOW VELOCITY (m/s)  
 PART FULL FLOW VELOCITY (m/s)


WATER LEVEL IN STRUCTURE
HYDRAULIC GRADE LEVEL
PIPE FLOW (Cumecs)
DEPTH TO INVERT
INVERT LEVEL OF DRAIN
DESIGN SURFACE LEVEL
SETOUT
RUNNING CHAINAGE

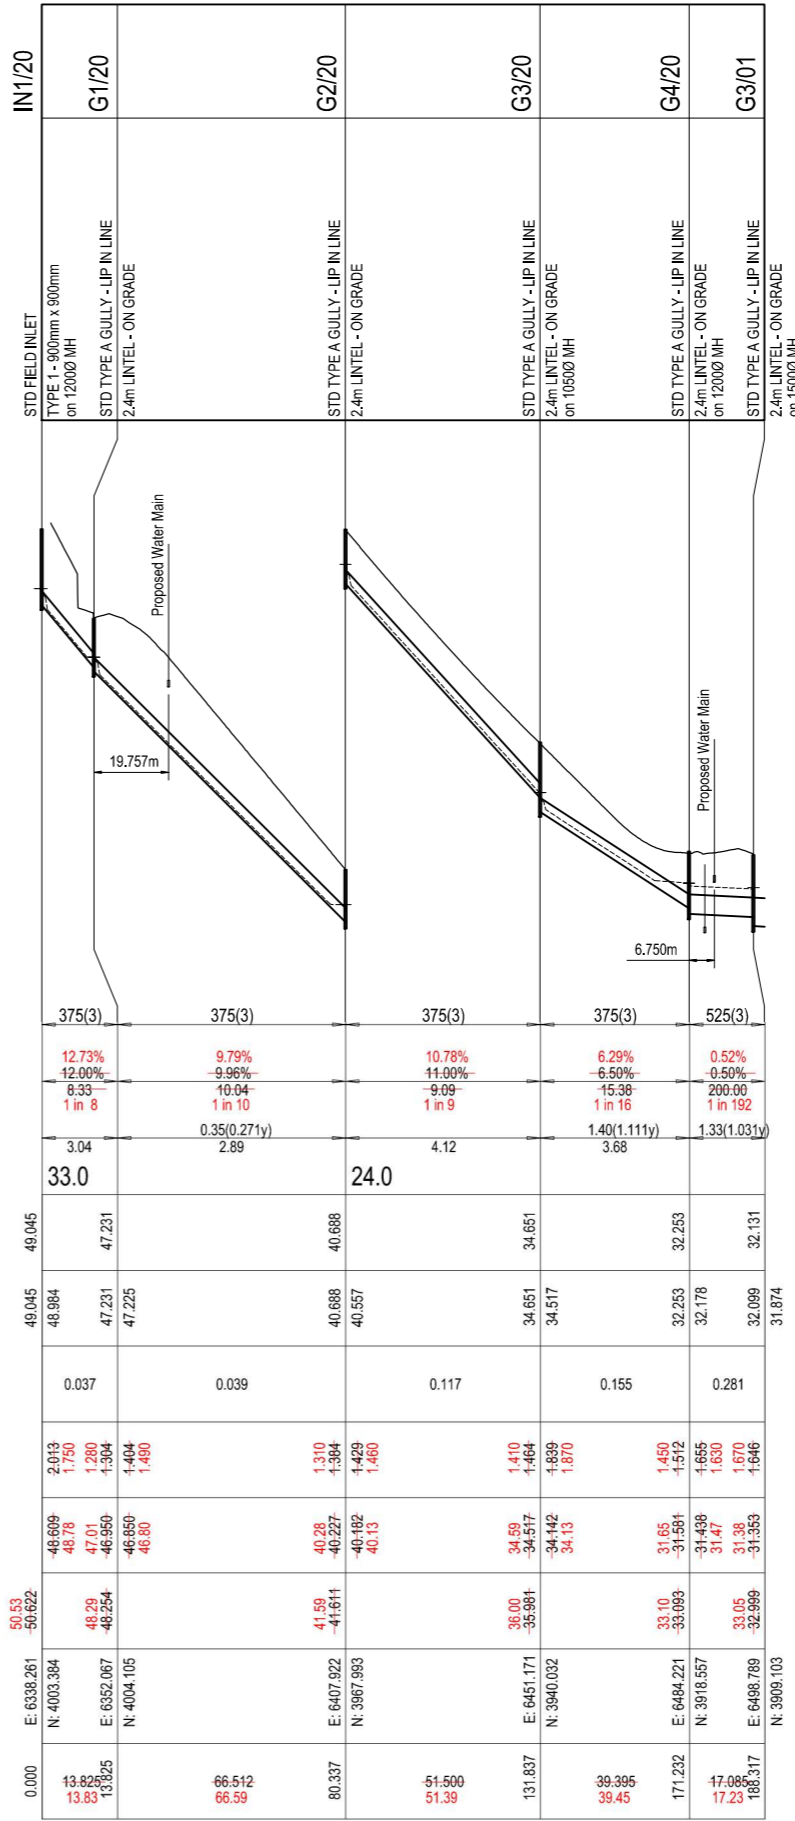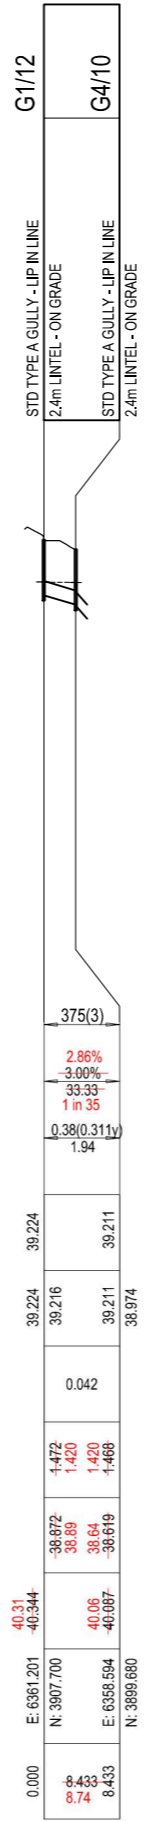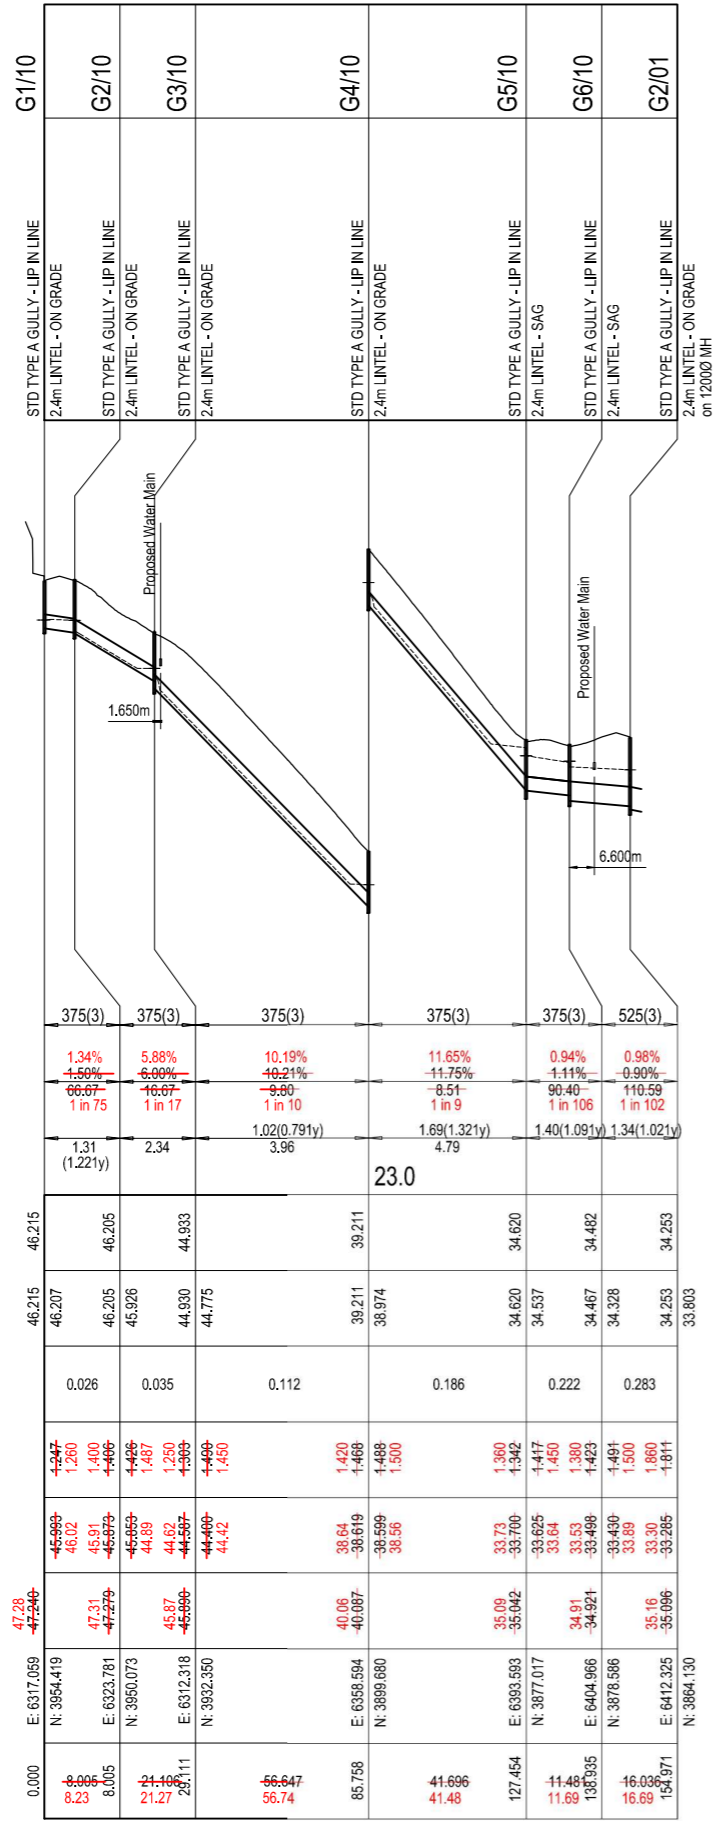

**AS-CONSTRUCTED CERTIFICATION**  
 Signature: \_\_\_\_\_ Date: 2.6/06/20  
 ANDREW NGO RPEQ No. 12329  
 For and on behalf of Peakurban PTY LTD

REV	DATE	DESIGN	DRAWN	REVISION DETAILS
A	02.12.19	AC	CL	ISSUED FOR CONSTRUCTION
B	22.01.20	AC	MPG	AMENDED G3/11 LEVELS
C	06.02.20	LF	SC	AMENDED PIPE SIZE
D	26.05.20	TD	SC	AS CONSTRUCTED

DRAWN	STATUS
TD	<b>AS CONSTRUCTED</b>
DESIGN	APPROVED
TD	ANDREW NGO RPEQ 12329

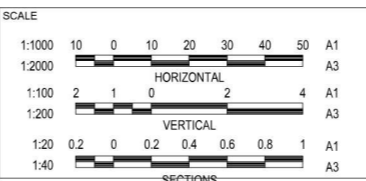

CLIENT  
**CANBERRA ESTATES CONSORTIUM NO. 36 PTY LIMITED**  
 ASSOCIATED CONSULTANT  
 SAUNDERS HAVILL GROUP  
 PH: 1300 123 744

PROJECT NAME  
**WOODLINKS VILLAGE - STAGE 16**  
 COLLINGWOOD DRIVE,  
 COLLINGWOOD PARK


DRAWING TITLE <b>STORMWATER DRAINAGE LONGITUDINAL SECTIONS SHEET 1 OF 2</b>		
PROJECT No.	DRAWING No.	REVISION
19-0023	117	D

STRUCTURE NAME
STRUCTURE DESCRIPTION

**STORMWATER STRUCTURE NOTE:**  
 STANDARD ROUND MANHOLES LESS THAN 3.0m DEEP:  
 CONSTRUCT IN ACCORDANCE WITH THE LOCAL AUTHORITY STANDARDS.  
 STANDARD ROUND MANHOLES 3.0m > 5.3m DEEP:  
 CONSTRUCT IN ACCORDANCE WITH TMR STD DRAWINGS 1307 AND 1308.  
 STANDARD ROUND MANHOLES GREATER THAN 5.3m DEEP:  
 SHALL BE STRUCTURALLY DESIGNED (CERTIFIED) AND CONSTRUCTED BY CONTRACTOR ON A CASE BY CASE BASIS.  
 RECTANGULAR STRUCTURE (SPECIAL):  
 SHALL BE STRUCTURALLY DESIGNED (CERTIFIED) AND CONSTRUCTED BY CONTRACTOR ON A CASE BY CASE BASIS.

PIPE SIZEmm (Class)	450(2)	450(2)	525(3)	600(3)	750(3)
PIPE GRADE %	0.89%	0.89%	4.24%	1.95%	0.58%
PIPE SLOPE 1 in X	1 in 112	1 in 112	1 in 24	1 in 51	1 in 173
FULL PIPE FLOW VELOCITY (m/s)	1.65(1.651v)	1.65(1.651v)	1.41(1.381v)	2.06(1.791v)	1.98(1.651v)
PART FULL FLOW VELOCITY (m/s)			3.77	3.28	
DATUM RL 22.0					
WATER LEVEL IN STRUCTURE	36.000	35.002	34.790	32.131	31.632
HYDRAULIC GRADE LEVEL	36.000	34.986	34.790	32.099	31.632
PIPE FLOW (Cumecs)	0.262	0.262	0.297	0.582	0.887
DEPTH TO INVERT	2.966	2.966	1.390	1.750	1.140
INVERT LEVEL OF DRAIN	34.034	34.034	33.400	30.349	30.492
DESIGN SURFACE LEVEL	37.22	36.469	35.67	33.05	32.06
SETOUT	E: 6334.889 N: 3833.888	E: 6374.337 N: 3853.980	E: 6391.466 N: 3882.700	E: 6498.789 N: 3909.103	E: 6520.133 N: 3942.692
RUNNING CHAINAGE	0.000	44.265	63.786	181.702	221.371

LINE 01 22 21

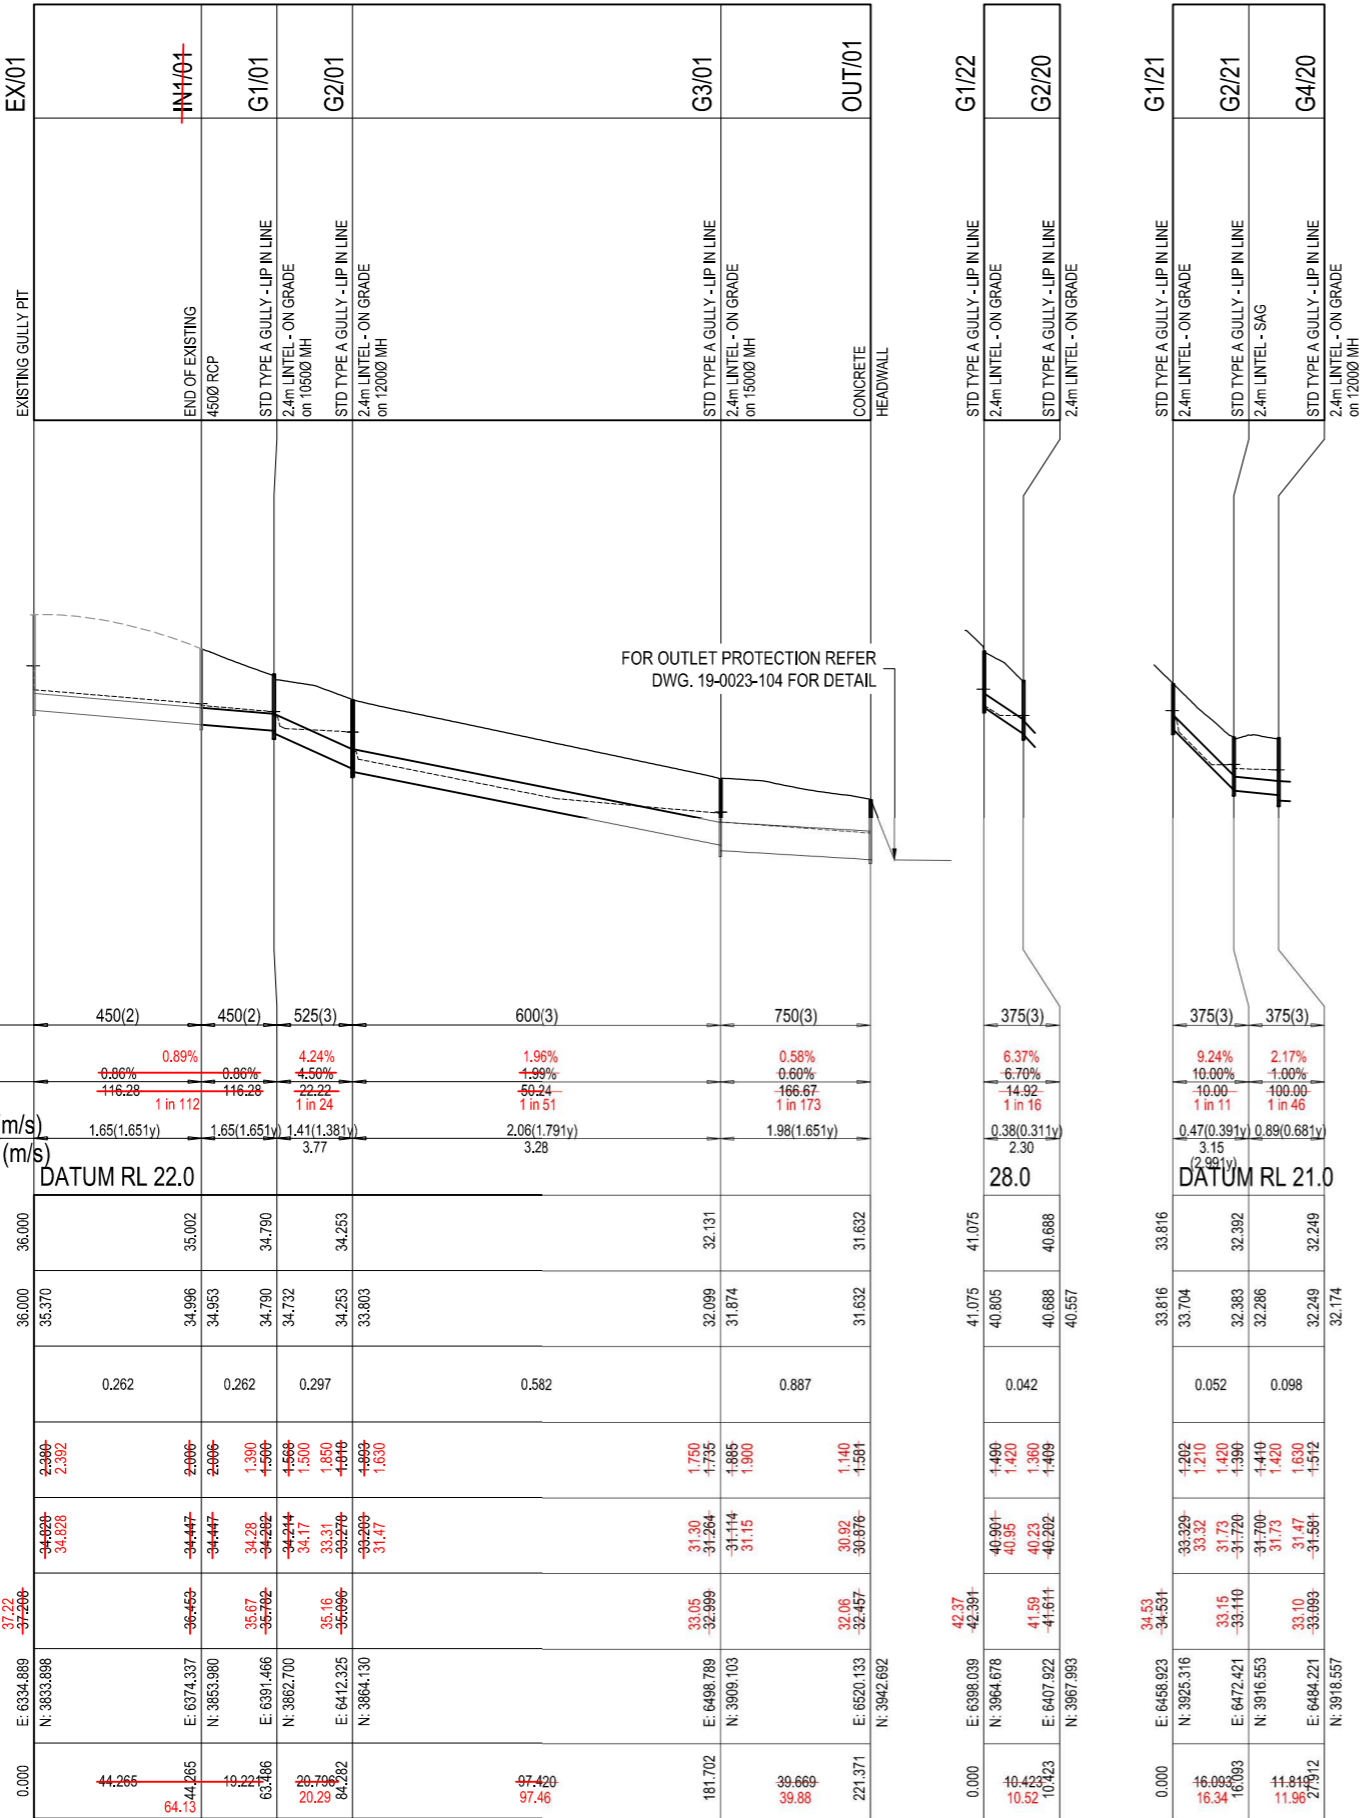

**AS-CONSTRUCTED CERTIFICATION**  
 Signature: \_\_\_\_\_ Date: 26/06/20  
 ANDREW NGO RPEQ No. 12329  
 For and on behalf of Peakurban PTY LTD

REV	DATE	DESIGN	DRAWN	REVISION DETAILS
A	02.12.19	AC	CL	ISSUED FOR CONSTRUCTION
B	23.01.20	AC	MPG	AMENDED G1/22 LEVELS
C	26.05.20	TD	SC	AS CONSTRUCTED

DRAWN	STATUS
TD	AS CONSTRUCTED
DESIGN	APPROVED
TD	ANDREW NGO RPEQ 12329

**PEAKURBAN**  
 DEVELOPMENT ENGINEERS - ADVISORS  
 ENQUIRIES@PEAKURBAN.COM.AU



CLIENT  
**CANBERRA ESTATES CONSORTIUM NO. 36 PTY LIMITED**

PROJECT NAME  
**WOODLINKS VILLAGE - STAGE 16**

DRAWING TITLE  
**STORMWATER DRAINAGE LONGITUDINAL SECTIONS SHEET 2 OF 2**

PROJECT No.	DRAWING No.	REVISION
19-0023	118	C

DESIGN ARI	LOCATION				TIME		SUB-CATCHMENT RUNOFF						INLET DESIGN						DRAIN DESIGN										HEADLOSSES										PART		DESIGN LEVELS					
	STRUCTURE No.	DRAIN SECTION	SUB-CATCHMENTS CONTRIBUTING	LAND USE	SOPE OF CATCHMENT	min	mm/h	C10	C	A	CxA	+CA	Q	Qg	Qb	Qf	Qm	Qs	Qp	L	S	V	T	STRUCTURE RATIO FOR 'K' VALUE CALCULATIONS	VELOCITY HEAD	U/S HEADLOSS COEFFICIENT	U/S PIPE STRUCT. HEADLOSS	LAT. HEADLOSS CO-EFFICIENT	LAT. PIPE STRUCT. HEADLOSS	W.S.E CO-EFFICIENT	CHANGE IN W.S.E	PIPE FRICTION SLOPE	PIPE FRICTION HEADLOSS (L x Sf)	DEPTH	VELOCITY	OBVERT LEVELS	DRAIN SECTION H.G.L	UPSTREAM H.G.L	LAT. H.G.L	W.S.E	SURFACE OR K&C INVERT LEVEL	STRUCTURE No.				
2 100	G0/11	G0/11 to G1/11	G0/11		10.00	112	0.75	0.095	0.071	0.071	22	22	13.50	502	1	22	22	17.588	10.60	375(3)	200(16%) (5.16)	0.29	0.022	0.022	0.375	0.002	100	0.318		100	0.318	0.02	0.003	0.051 (0.0451y)	2.50 (2.311y)	47.131	46.807	47.125	47.125	48.243	G0/11					
2 100	G1/11	G1/11 to G3/10	G0/11,G1/11		10.00	112	0.75	0.147	0.110	0.110	34	34	4.46	147	1350.08F0.8	34	34	14.257	2.00	375(3)	510(44%) (2.24)	0.24	0.034	0.056	0.375	0.013	100	0.167		100	0.167	0.10	0.014	0.121 (0.1051y)	1.81 (1.681y)	45.247	44.993	45.160	45.160	46.279	G1/11					
2 100	G1/10	G1/10 to G2/10	G1/10		8.00	123	1.00	0.076	0.076	0.076	26	26	5.68	326	1	26	26	8.005	150	375(3)	240(19%) (1.94)	0.13	0.026	0.026	0.375	0.003	100	0.008		100	0.008	0.02	0.002	0.088 (0.0781y)	1.31 (1.221y)	46.368	46.205	46.215	46.215	47.240	G1/10					
2 100	G2/10	G2/10 to G3/10	G1/10,G2/10		5.00	146	0.75	0.036	0.027	0.027	11	11	5.69	326	1	11	11	21.106	6.00	375(3)	320(26%) (3.89)	0.35	0.009	0.035	0.375	0.005	100	0.279		100	0.279	0.04	0.008	0.073 (0.0641y)	2.34 (2.181y)	46.228	45.926	46.205	46.205	47.279	G2/10					
2 100	G3/10	G3/10 to G4/10	G0/11,G1/11,G1/10,G2/10,G3/10		10.00	112	0.75	0.111	0.083	0.083	26	26	4.27	283	1	26	26	56.647	10.21	375(3)	020(16%) (5.07)	0.93	0.025	0.012	0.375	0.053	292	0.155		297	0.158	0.41	0.232	0.114 (0.1001y)	3.96 (3.671y)	44.775	44.775	44.930	44.933	45.890	G3/10					
<p><b>AS-CONSTRUCTED CERTIFICATION</b></p> <p>Signature: _____ Date: 26/06/20</p> <p><b>ANDREW NGO</b> RPEQ No. 12329</p> <p>For and on behalf of Peakurban PTY LTD</p>																																														
2 100	G1/12	G1/12 to G4/10	G1/12		10.00	112	0.75	0.191	0.143	0.143	44	44	11.94	472	1	42	2	8.433	3.00	375(3)	0.380(31%) (2.75)	0.14	0.042	0.042	0.375	0.007	100	0.008		100	0.008	0.06	0.005	0.095 (0.0851y)	1.94 (1.821y)	39.247	39.216	39.224	39.224	40.344	G1/12					
2 100	G4/10	G4/10 to G5/10	G0/11,G1/11,G1/10,G2/10,G3/10,G1/12,G4/10		10.00	112	0.75	0.172	0.129	0.129	40	40	11.91	472	1	40	0	4.1696	11.75	375(3)	69(1.32%) (5.44)	0.41	0.038	0.186	0.375	0.146	163	0.237		163	0.237	1.13	0.471	0.143 (0.1261y)	4.79 (4.481y)	38.974	38.974	39.211	39.211	40.087	G4/10					
2 100	G5/10	G5/10 to G6/10	G0/11,G1/11,G1/10,G2/10,G3/10,G1/12,G4/10,G5/10		10.00	112	0.75	0.183	0.137	0.137	43	43	0.00	147	1350.08F0.8	43	0	11.481	1.11	450(3)	44(1.09%) (1.88)	0.14	0.040	0.222	0.450	0.100	0.83	0.083		0.83	0.083	0.61	0.070			34.975	34.537	34.620	34.620	35.042	G5/10					
2 100	G6/10	G6/10 to G1/01	G0/11,G1/11,G1/10,G2/10,G3/10,G1/12,G4/10,G5/10,G6/10		10.00	112	0.75	0.272	0.203	0.203	63	65	0.00	147	1350.08F0.8	65	0	16.036	0.90	525(3)	34(1.02%) (1.87)	0.20	0.061	0.037	0.525	0.092	152	0.139		169	0.154	0.47	0.075			33.948	34.328	34.467	34.467	34.921	G6/10					
2 100	IN1/20	IN1/20 to G1/20	IN1/20		10.00	112	0.75	0.159	0.119	0.119	37	37	0.00	174	3050.15	37	0	13.825	12.00	375(3)	34(0.26%) (5.49)	0.23	0.037	0.037	0.375	0.006	10.40	0.061		10.40	0.061	0.04	0.006	0.063 (0.0561y)	3.04 (2.821y)	48.984	48.984	49.045	49.045	50.622	IN1/20					
2 100	G1/20	G1/20 to G2/20	IN1/20,G1/20		10.00	112	0.75	0.010	0.007	0.007	2	2	2.34	209	1	2	0	66.512	9.96	375(3)	35(0.27%) (5.01)	1.11	0.002	0.039	0.375	0.006	0.91	0.006		0.91	0.006	0.05	0.033	0.067 (0.0591y)	2.89 (2.671y)	47.225	47.225	47.231	47.231	48.254	G1/20					
2 100	EX/01	EX/01 to IN1/01	EX/01		10.79	107	0.75	0.380	0.380	0.380	262	262	0.00					44.265	0.86	450(2)	65(1.65%) (1.66)	0.45	0.262	0.450	0.139	4.54	0.630		4.54	0.630	0.85	0.374			35.278	35.370	36.000	36.000	37.208	EX/01						
2 100	IN1/01	IN1/01 to G1/01	IN1/01		11.24	107	0.75	0.380	0.380	0.380	258	258	0.00					19.221	0.86	450(2)	65(1.65%) (1.66)	0.19	0.262	0.450	0.139	0.31	0.043		0.36	0.049	0.85	0.163			34.897	34.953	34.996	35.002	36.453	IN1/01						
2 100	G1/01	G1/01 to G2/01	G1/01		10.00	112	0.75	0.169	0.126	0.126	39	39	3.18	244	1	39	0	20.796	4.50	525(3)	41(1.38%) (4.17)	0.25	0.037	0.037	0.525	0.101	0.57	0.058		0.57	0.058	0.51	0.106	0.207 (0.2051y)	3.77 (3.741y)	34.732	34.732	34.790	34.790	35.782	G1/01					

CALCULATIONS TABLE


REV	DATE	DESIGN	DRAWN	ISSUED FOR CONSTRUCTION	REVISION DETAILS	DRAWN	STATUS	SCALE	CLIENT	PROJECT NAME	DRAWING TITLE
A	02.12.19	AC	CL	ISSUED FOR CONSTRUCTION		TD	AS CONSTRUCTED		CANBERRA ESTATES CONSORTIUM NO. 36 PTY LIMITED	WOODLINKS VILLAGE - STAGE 16	STORMWATER DRAINAGE CALCULATIONS TABLE SHEET 1 OF 2
B	26.03.20	TD	SC	AS CONSTRUCTED		TD			ASSOCIATED CONSULTANT SAUNDERS HAVILL GROUP PH: 1300 123 744	COLLINGWOOD DRIVE, COLLINGWOOD PARK	PROJECT No. 19-0023 DRAWING No. 119 REVISION B




FOR AND ON BEHALF OF PEAKURBAN PTY LTD

ENQUIRIES@PEAKURBAN.COM.AU




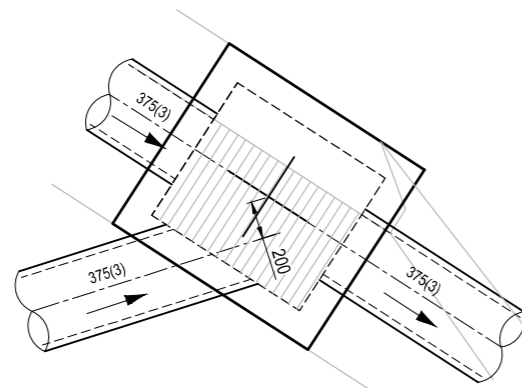


**G2/20 - 835mm x 930mm  
STANDARD TYPE A GULLY**  
1:20 (A1)  
1:40 (A3)

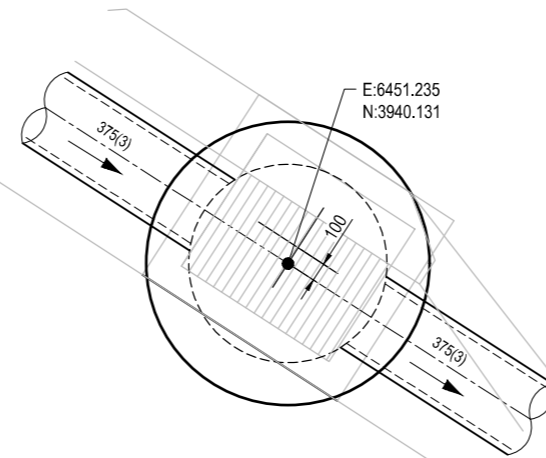


**G3/20 - 835mm x 930mm  
STANDARD TYPE A GULLY on 1050Ø MANHOLE**  
1:20 (A1)  
1:40 (A3)

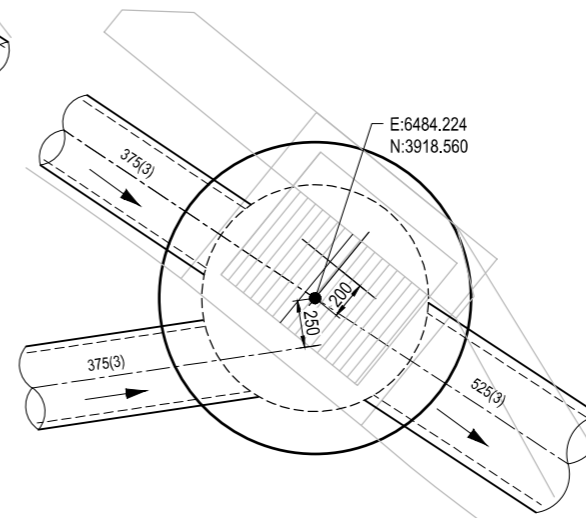


**G4/20 - 835mm x 930mm  
STANDARD TYPE A GULLY on 1200Ø MANHOLE**  
1:20 (A1)  
1:40 (A3)

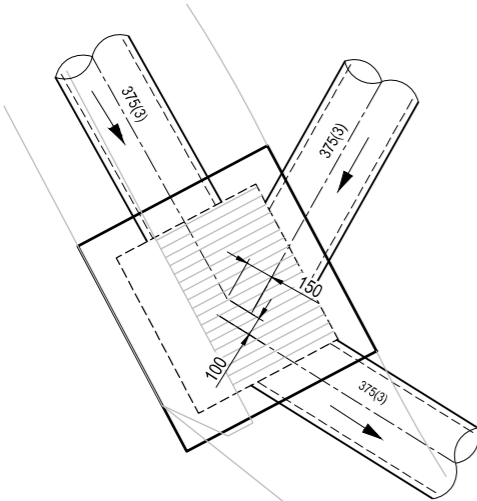


**G3/10 - 835mm x 930mm  
STANDARD TYPE A GULLY**  
1:20 (A1)  
1:40 (A3)

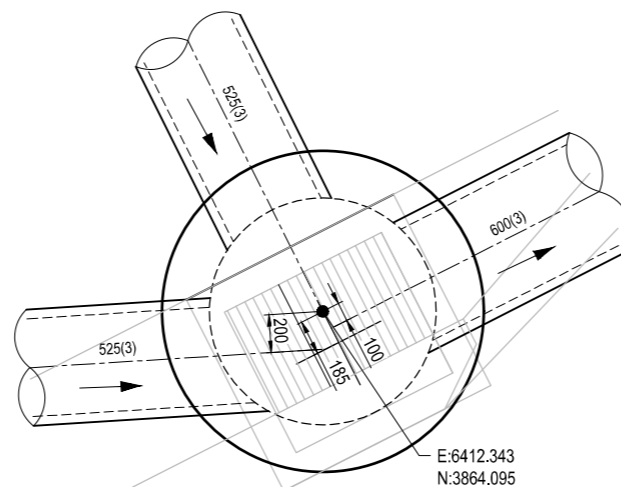

**G2/01 - 835mm x 930mm  
STANDARD TYPE A GULLY on 1200Ø MANHOLE**  
1:20 (A1)  
1:40 (A3)

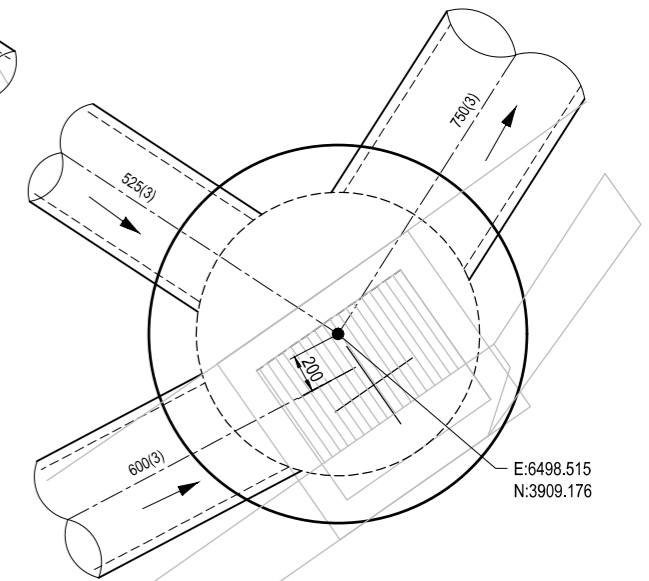

**G3/01 - 835mm x 930mm  
STANDARD TYPE A GULLY on 1500Ø MANHOLE**  
1:20 (A1)  
1:40 (A3)

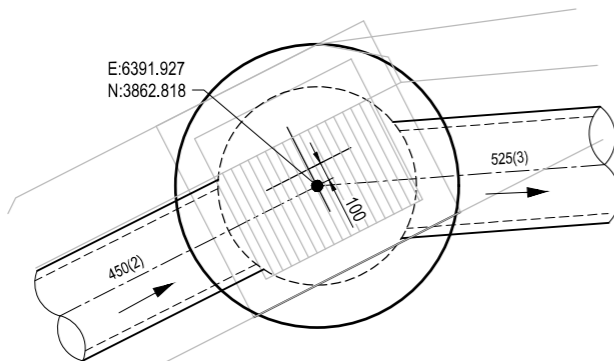



**G1/01 - 835mm x 930mm  
STANDARD TYPE A GULLY on 1050Ø MANHOLE**  
1:20 (A1)  
1:40 (A3)

**AS-CONSTRUCTED CERTIFICATION**

Signature: \_\_\_\_\_ Date: 2.6/1.06/20  
ANDREW NGO RPEQ No. 12329  
For and on behalf of Peakurban PTY LTD

REV	DATE	DESIGN	DRAWN	ISSUED FOR CONSTRUCTION	REVISION DETAILS	DRAWN	STATUS	SCALE	CLIENT	PROJECT NAME	DRAWING TITLE
A	02.12.19	AC	CL	ISSUED FOR CONSTRUCTION				1:20 (A1) 1:40 (A3)	CANBERRA ESTATES CONSORTIUM NO. 36 PTY LIMITED	WOODLINKS VILLAGE - STAGE 16	STORMWATER DRAINAGE STRUCTURE DETAILS
B	26.05.20	TD	SC	AS CONSTRUCTED		TD	<b>AS CONSTRUCTED</b>		ASSOCIATED CONSULTANT SAUNDERS HAVILL GROUP PH: 1300 123 744	COLLINGWOOD DRIVE, COLLINGWOOD PARK	PROJECT No. <b>19-0023</b>
						TD	APPROVED ANDREW NGO RPEQ 12329 FOR AND ON BEHALF OF PEAKURBAN PTY LTD				DRAWING No. <b>121</b>
											REVISION <b>B</b>

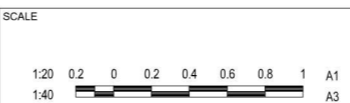

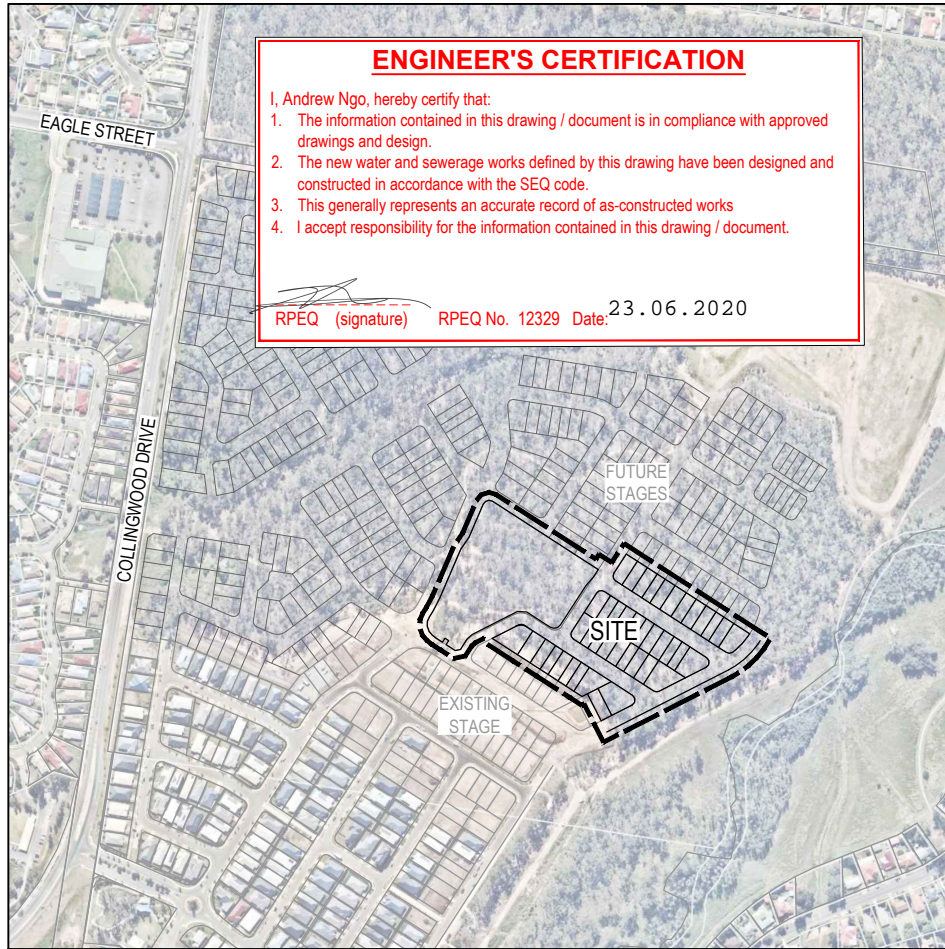


**ENGINEER'S CERTIFICATION**

I, Andrew Ngo, hereby certify that:

- The information contained in this drawing / document is in compliance with approved drawings and design.
- The new water and sewerage works defined by this drawing have been designed and constructed in accordance with the SEQ code.
- This generally represents an accurate record of as-constructed works
- I accept responsibility for the information contained in this drawing / document.

RPEQ (signature) RPEQ No. 12329 Date: 23.06.2020

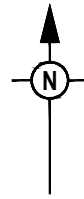

NAME OF ESTATE	WOODLINKS STAGE 16
SUBDIVIDER	CANBERRA ESTATES
Q.U.U. APPLICATION No.	19-PNT-40253
Q.U.U. DELEGATE APPROVAL DATE	23.08.2019
DRAWING/PLAN No.	19-0023-300-302
No. OF ALLOTMENTS	42
AREA	4.8ha
LENGTH OF SEWERS	DN110 PE100 <del>105m</del> 115m
	DN160 PE100 <del>1213m</del> 1175m

**ENVIRONMENTAL CONDITIONS**

**VEGETATION PROTECTION**

- TREES LOCATED ALONG THE FOOTPATH SHALL BE, TRANSPLANTED PRIOR TO CONSTRUCTION, OR REPLACED IF DESTROYED.
- WHEN WORKING WITHIN 4m OF TREES, RUBBER OR HARDWOOD GIRDLES SHALL BE CONSTRUCTED WITH 1.8m BATTENS CLOSELY SPACED AND ARRANGED VERTICALLY FROM GROUND LEVEL. GIRDLES SHALL BE STRAPPED TO TREES PRIOR TO CONSTRUCTION AND REMAIN UNTIL COMPLETION.
- TREE ROOTS SHALL BE TUNNELED UNDER, RATHER THAN SEVERED. IF ROOTS ARE SEVERED THE DAMAGED AREA SHALL BE TREATED WITH A SUITABLE FUNGICIDE. CONTACT RELEVANT COUNCIL ARBORIST FOR FURTHER ADVICE.
- ANY TREE LOPPING REQUIRED SHOULD BE UNDERTAKEN BY AN APPROVED ARBORIST.

**SOIL**

- TOPSOIL AND SUBSOIL SHALL BE STOCKPILED SEPARATELY.
- CARE SHALL BE TAKEN TO PREVENT SEDIMENT FROM ENTERING THE STORMWATER SYSTEM. THIS MAY INVOLVE PLACING APPROPRIATE SEDIMENT CONTROLS AROUND STOCKPILES.

**CREEK CROSSINGS**

- SILTATION CONTROL MEASURES SHALL BE PLACED DOWNSTREAM OF ANY EXCAVATION WORK.
- APPROPRIATE SEDIMENT CONTROLS SHALL BE USED TO PREVENT SEDIMENT FROM ENTERING THE CREEK.
- NO SOIL SHALL BE STOCKPILED WITHIN 5m OF THE CREEK.

**REHABILITATION**

- PREDISTURBANCE SOIL PROFILES AND COMPACTION LEVELS SHALL BE REINSTATED.
- PREDISTURBANCE VEGETATION PATTERNS SHALL BE RESTORED.

**LOCALITY PLAN**

1:4000 (A1)  
1:8000 (A3)

**LIVE SEWER WORKS**

No.	DESCRIPTION	DIA. SEWER	EXISTING ASSET ID AT CONNECTION	MH/MS TYPE	COVER TYPE	LOT & PLAN No.	F.S.L.	E.S.L.	CONNECTION I.L.	CONNECTION DEPTH TO INVERT	ALTERATION TO EXISTING MH BENCHING REQUIRED (Y/N)
1 (A)	CONSTRUCTOR TO CONSTRUCT NEW MAINTENANCE HOLE 1/1 OVER EXISTING DN300 SEWER AND BENCH AND RENDER UP TO PIPE BUT NOT REMOVE CROWN OF PIPE.	DN160	1/1	X	D(BD)	PLAN 302	<del>23.91</del> 23.92	23.76	<del>20.037</del> 20.82	<del>3.073</del> 3.100	N
1 (B)	CONSTRUCTOR TO LAY LINE 1.	DN160	1/1	X	D(BD)	PLAN 302	<del>23.91</del> 23.92	23.76	<del>22.108</del> 21.93	<del>1.802</del> 1.990	
1 (C)	CONSTRUCTOR, UNDER Q.U.U. SUPERVISION, TO REMOVE CROWN OF PIPE AND COMPLETE BENCHING AFTER SUCCESSFUL 'ON MAINTENANCE' INSPECTION OF LINE 1	DN160				PLAN 302	<del>23.91</del> 23.92	23.76	<del>20.037</del> 20.82	<del>3.073</del> 3.100	

**LIVE WORKS NOTES:**

- ALL WORK ON EXISTING SEWERS TO BE CARRIED OUT BY THE CONTRACTOR (IN ACCORDANCE WITH AN APPROVED NETWORKS ACCESS PERMIT) UNDER Q.U.U. SUPERVISION, AT THE DEVELOPERS EXPENSE.
- LIVE WORKS CANNOT COMMENCE UNTIL ALL RELEVANT TEST CERTIFICATES HAVE BEEN PROVIDED AND ACCEPTED BY Q.U.U.

**DETAILS OF PROPOSED SEQ CODE VARIATIONS**

No.	SEQ CODE CLAUSE	DETAILS FOR PROPOSED VARIATION	REASONS OF PROPOSED VARIATION
1	6.5.2	PROPERTY CONNECTIONS AT LOT 450 PROVIDED AT 8.0m OFFSET FROM LOW SIDE, SIDE BOUNDARY	DRIVEWAY LOCATIONS KNOWN, CONNECTIONS LOCATED TO BE CLEAR OF DRIVEWAYS
2	5.3.2	DUAL SEWERAGE ALIGNMENT	IPSWICH CITY COUNCIL HAVE CONFIRMED THEY HAVE NO OBJECTIONS TO THE DUAL SIDED SEWER PROPOSAL AS DETAILED IN THE CORRESPONDENCE PROVIDED TO QUU ON 15 AUGUST 2019.

**GENERAL NOTES:**

- THE CONTRACTOR SHALL SUPPLY ALL LABOR, MATERIALS, PLANT AND EQUIPMENT TO CONSTRUCT THE WORKS AS DOCUMENTED AND STRICTLY IN ACCORDANCE WITH THE RELEVANT AUTHORITY STANDARDS, SPECIFICATIONS AND REQUIREMENTS.
- THE EXISTING SERVICES THAT ARE SHOWN ON THE DRAWINGS ARE PROVIDED FOR INFORMATION PURPOSES ONLY. NO RESPONSIBILITY IS TAKEN BY THE SUPERINTENDENT OR THE PRINCIPAL FOR INFORMATION THAT HAS BEEN SUPPLIED BY OTHERS, OR ANY EXISTING SERVICES THAT MAY BE PRESENT NOT SHOWN ON THE DRAWINGS. THE CONTRACTOR SHALL VERIFY THE POSITION OF ANY UNDERGROUND SERVICES WITHIN THE AREAS OF WORKS AND SHALL BE RESPONSIBLE FOR MAKING GOOD ANY DAMAGE THERETO. ANY ALTERATION WORKS TO SERVICES WILL BE CARRIED OUT ONLY BY THE SERVICE OWNER AUTHORITY UNLESS APPROVED OTHERWISE.
- ALL DESIGN AND CONSTRUCTION ACTIVITIES UNDERTAKEN SHALL COMPLY WITH CURRENT WORKPLACE HEALTH AND SAFETY REQUIREMENTS AND LEGISLATION.
- PRIOR TO COMMENCING WORK, THE CONTRACTOR IS RESPONSIBLE FOR OBTAINING ALL RELEVANT LOCAL AUTHORITY PERMITS. THE CONTRACTOR SHALL NOT COMMENCE THE DEMOLITION OF ANY EXISTING BUILDINGS AND/OR STRUCTURES WITHOUT APPROVAL FROM THE SUPERINTENDENT.
- THE CONTRACTOR SHALL APPLY INDUSTRY BEST PRACTICE SO WORKS SHALL NOT DISTURB OR AFFECT NEARBY RESIDENTS EITHER BY DUST, NOISE, FLOODING OR DISCONNECTION OF SERVICES. CONTRACTOR TO ENSURE THAT ACCESS AND SERVICES TO EXISTING PROPERTIES ARE AVAILABLE AT ALL TIMES.
- THE CONTRACTOR SHALL VERIFY LEVELS OF EXISTING SERVICE CROSSINGS AND CONNECTION POINTS PRIOR TO COMMENCEMENT OF WORKS AND NOTIFY SUPERINTENDENT OF ANY DISCREPANCIES BETWEEN ACTUAL AND PROPOSED DESIGN LEVELS.
- THESE ENGINEERING DRAWINGS ARE TO BE READ IN CONJUNCTION WITH THE APPROVED VEGETATION MANAGEMENT PLAN, WHERE APPLICABLE. WHEN IN DOUBT, ALL EXISTING TREES ARE TO REMAIN UNLESS DIRECTED OTHERWISE.
- HOLD POINT:** ONCE THE BASE OF MANHOLES HAVE BEEN POURED, CONSTRUCTION SHALL ONLY RE-COMMENCE ONCE THE SUPERINTENDENT AND/OR ENGINEER HAVE INSPECTED THE WORKS.
- THE CONTRACTOR SHALL NOTE DURING THE COURSE OF THE WORKS WHEN JOINT INSPECTIONS WITH THE AUTHORITY AND THE SUPERINTENDENT ARE REQUIRED. THESE INCLUDE PRE-STARTS, SUBGRADES, PRE-SEALS, CLEARING, AND OTHER SUCH INSPECTIONS AS NOMINATED DURING THE PRE-START, IN THE APPROVAL AND THE SPECIFICATIONS. THE CONTRACTOR SHALL ENSURE NO WORKS PROCEED PAST THE INSPECTION POINT UNTIL THE JOINT INSPECTION HAS BEEN SUCCESSFULLY COMPLETED.

**SEWERAGE NOTES**

- ALL WORK AND MATERIALS SHALL BE IN ACCORDANCE WITH THE CURRENT WSAA GRAVITY SEWERAGE CODE OF AUSTRALIA SPECIFICATIONS AND STANDARD - SOUTH EAST QUEENSLAND SERVICE PROVIDERS EDITION.
- UNLESS SPECIFIED OTHERWISE ALL MATERIALS AND WORK SHALL COMPLY WITH THE RELEVANT AUSTRALIAN STANDARDS.
- THE CONSTRUCTION OF THE SEWERAGE WORK SHOWN ON THIS DRAWING SHALL BE SUPERVISED BY AN ENGINEER WHO HAS RPEQ REGISTRATION. SEWERAGE WORKS NOT COMPLYING WITH THIS REQUIREMENT WILL NOT BE PERMITTED TO CONNECT INTO THE Q.U.U. SEWERAGE SYSTEM.
- ALL WORK ASSOCIATED WITH LIVE SEWERS OR MAINTENANCE HOLES SHALL BE SUPERVISED BY Q.U.U. AT THE DEVELOPER'S COST.
- ALL PIPES AND MATERIALS SHALL COMPLY WITH THE REQUIREMENTS OF THE "ACCEPTED PRODUCTS AND MATERIALS" LIST.
- EACH ALLOTMENT SHALL BE SERVED BY A DN110 PE PROPERTY CONNECTION. FOR ALLOTMENTS OTHER THAN SINGLE RESIDENTIAL, A DN160 PE PROPERTY CONNECTION SHALL BE PROVIDED.
- PROPERTY CONNECTIONS SHALL BE LOCATED WITHIN THE PROPERTY AS SHOWN IN THE DRAWINGS.
- PROPERTY CONNECTION BRANCHES SHALL EXTEND INTO THE PROPERTY A MINIMUM OF 300mm AND A MAXIMUM OF 750mm.
- WHERE PIPES ARE LAID IN FILL, THE FILLING SHALL BE CARRIED OUT IN LAYERS NOT EXCEEDING 300mm (LOOSE) IN DEPTH AND SHALL BE COMPACTED UNTIL THE COMPACTION IS NOT LESS THAN 95% OF THE MATERIALS MAXIMUM COMPACTION WHEN TESTED IN ACCORDANCE WITH A.S.1289 (MODIFIED COMPACTION). TESTING SHALL BE CARRIED OUT AFTER EACH ALTERNATE LAYER. IN ALL SUCH CASES APPROVAL OF CONSTRUCTED SEWERS WILL NOT BE ISSUED BY Q.U.U. UNLESS CERTIFICATES ARE PRODUCED CERTIFYING THAT THE REQUIRED COMPACTION HAS BEEN ACHIEVED.
- WHERE SEWERS HAVE A GRADE OF 1 IN 20 OR STEEPER, TRENCH STOPS AND BULKHEADS SHALL BE CONSTRUCTED IN ACCORDANCE WITH TABLE 9.1 OF THE SEQ SEWER CODE AND DRGS SEQ-SEW-1206-1 AND 1207-1.
- THE CONTRACTOR SHALL VERIFY THE LOCATION AND DEPTH OF EXISTING SERVICES WITH RELEVANT AUTHORITIES BEFORE COMMENCING WORKS.
- SEWERS SHALL BE DISUSED/ABANDONED IN ACCORDANCE WITH PROCEDURE SET OUT IN THE GRAVITY SEWER CODE.
- BENCH MARK AND LEVELS TO AHD.
- THE DESIGN HAS BEEN UNDERTAKEN TO COMPLY WITH CURRENT Q.U.U. STANDARDS AND THE WSAA GRAVITY SEWERAGE CODE OF AUSTRALIA SPECIFICATIONS AND STANDARD - SOUTH EAST QUEENSLAND SERVICE PROVIDERS EDITION
- CONSTRUCT EMBEDMENT AND TRENCHFILL TO SEQ-SEW-1200-2, 1201-1 TO 1205-1 (TYPE 4 SUPPORT UNLESS GEOTECHNICAL INVESTIGATIONS DEMONSTRATE THAT TYPE 3 SUPPORT IS ADEQUATE. TYPE 4 SUPPORT TO BE USED WHERE MIGRATORY NATIVE SOILS (OR SAND OR FINE CLAY MATERIAL) ARE ENCOUNTERED ADJACENT TO THE EMBEDMENT ZONE AND SINGLE SIZE AGGREGATE IS USED) AND COUNCIL STANDARD FOR ROADWAYS, WHICHEVER IS MORE ONEROUS.
- CONSTRUCT BULKHEADS AND TRENCH STOPS TO SEQ-SEW-1206-1 AND TRENCH DRAINS TO SEQ-SEW-1207-1.
- CONSTRUCT MH'S TO SEQ-SEW-1301-1 TO 1301-7 (TYPE G), 1301-8 TO 1301-13 (TYPE F), 1301-14 TO 1301-25 (TYPE X), 1304-1, 1305-1, 1307-4 (STUB CUT IN), 1313-1 (CONNECTION) AND 1502-1 (INSERTION MH AND REPAIR SYSTEM), 1301-27 (LADDERS).
- CONSTRUCT MAINTENANCE SHAFTS AND TERMINAL ENTRY POINTS TO SEQ-SEW 1315-1, 1316-1 AND 1502-1 (INSERT MS).
- INSTALL MH/MS TYPE B COVERS TO SEQ-SEW-1308-2 TO 1308-7.
- INSTALL MH/MS TYPE D COVERS TO SEQ-SEW-1308-8 TO 1308-11.
- INSTALL DETECTABLE MARKER TAPE ON ALL SEWER MAINS AND PROPERTY CONNECTIONS.


PROPERTY CONNECTIONS HAVE BEEN DESIGNED TO CONTROL THE REQUIRED SERVICE AREA OF EACH LOT AT A GRADE OF 1:60 AND A MAXIMUM DEPTH OF PROPERTY CONNECTION AT 1.5m UNLESS OTHERWISE STATED. FOR JUNCTION DETAILS REFER SEQ-SEW-1106-1 TO SEQ-SEW-1106-6.

ALL ENVIRONMENTAL PROTECTION MEASURES SHALL BE IMPLEMENTED PRIOR TO ANY CONSTRUCTION WORK COMMENCING, INCLUDING CLEARING

ALL WATER AND SEWERAGE CONSTRUCTION SHALL COMPLY WITH ALL QUEENSLAND LEGISLATION

REV	DATE	DESIGN	DRAWN	REVISION DETAILS	DRAWN	STATUS	SCALE	CLIENT	PROJECT NAME	DRAWING TITLE
A	05.12.19	AC	SC	ISSUED FOR CONSTRUCTION	SC	AS CONSTRUCTED	AS SHOWN	CANBERRA ESTATES CONSORTIUM NO. 36 PTY LIMITED	WOODLINKS VILLAGE - STAGE 16	SEWERAGE COVER PLAN
B	12.12.19	RD	RD	LIVE WORKS TABLE AMENDED						
C	23.08.20	TD	SC	AS CONSTRUCTED						
					TD	APPROVED ANDREW NGO	RPEQ 12329	ASSOCIATED CONSULTANT SAUNDERS HAVILL GROUP PH: 1300 123 744	COLLINGWOOD DRIVE, COLLINGWOOD PARK	PROJECT No. <b>19-0023</b>
						FOR AND ON BEHALF OF PEAKURBAN PTY LTD	ENQUIRIES@PEAKURBAN.COM.AU			DRAWING No. <b>300</b>
										REVISION <b>C</b>

KEYPLAN  
SCALE 1:5000  
SCALE 1:10000

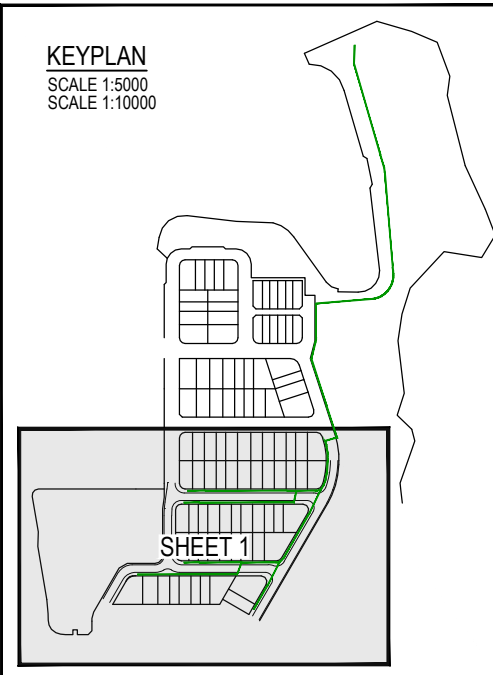

**WARNING! - EXISTING SERVICES**

EXTREME CARE SHOULD BE TAKEN WHEN EXCAVATING IN THIS AREA. THE FOLLOWING EXISTING SERVICES ARE LIKELY TO BE PRESENT IN THE VICINITY OF THE SITE:

- ELECTRICAL CABLES
- TELECOMMUNICATIONS CABLES
- GAS MAINS
- WATER MAINS
- SEWER MAINS

THE CONTRACTOR SHOULD CONTACT THE SERVICE PROVIDER FOR FURTHER INFORMATION AND SATISFY THEMSELVES OF ANY SPECIFIC TREATMENT OR REQUIREMENTS.

**ENGINEER'S CERTIFICATION**

- I, Andrew Ngo, hereby certify that:
1. The information contained in this drawing / document is in compliance with approved drawings and design.
  2. The new water and sewerage works defined by this drawing have been designed and constructed in accordance with the SEQ code.
  3. This generally represents an accurate record of as-constructed works
  4. I accept responsibility for the information contained in this drawing / document.

RPEQ (signature) RPEQ No. 12329 Date: 23.06.2020

**AS CONSTRUCTED LEGEND**

- SEWERAGE MAIN
- SEWERAGE MANHOLE
- SEWERAGE EASEMENT

**LEGEND**

- PROPOSED AREA OF WORKS
- PROPOSED SEWERAGE MAIN
- EXISTING SEWERAGE MAIN
- PROPOSED SEWER EASEMENT
- Q100 STORMWATER FLOOD LEVEL
- SEWER LOT CONTROL SURFACE LEVEL
- INDICATIVE DRIVEWAY LOCATION
- ZERO LOT BOUNDARY
- PROPOSED SURFACE CONTOUR
- EXISTING SURFACE CONTOUR
- PROPOSED STORMWATER DRAINAGE PIPE
- EXISTING STORMWATER DRAINAGE PIPE
- PROPOSED WATER MAIN
- EXISTING WATER MAIN
- PROPOSED RETAINING WALL
- EXISTING RETAINING WALL
- EXISTING ELECTRICAL CABLE U/G
- EXISTING ELECTRICAL CABLE O/H

**RP DESCRIPTION**

LOT 5507 ON SP2266999

**DATUM LEVEL AND LOCATION:**

P.M. 110122 RL 40.320 AHD

REV	DATE	DESIGN	DRAWN	ISSUED FOR CONSTRUCTION	REVISION DETAILS
A	05.12.19	AC	SC	ISSUED FOR CONSTRUCTION	
B	10.03.20	AC	CL	SANDSTONE BOULDER WALL AMENDED, RETAINING WALL ADDED TO LOT 501	
C	05.06.20	TD	SC	AS CONSTRUCTED	

DRAWN	STATUS	AS CONSTRUCTED
DESIGN	APPROVED	ANDREW NGO RPEQ 12329
TD		

**PEAKURBAN**  
DEVELOPMENT ENGINEERS • ADVISORS  
ENQUIRIES@PEAKURBAN.COM.AU



SCALE  
1:500 10 5 0 10 20 A1  
1:1000

CLIENT  
**CANBERRA ESTATES CONSORTIUM NO. 36 PTY LIMITED**  
ASSOCIATED CONSULTANT  
SAUNDERS HAVILL GROUP  
PH: 1300 123 744

PROJECT NAME  
**WOODLINKS VILLAGE - STAGE 16**  
COLLINGWOOD DRIVE,  
COLLINGWOOD PARK

DRAWING TITLE <b>SEWERAGE LAYOUT SHEET 1 OF 2</b>		
PROJECT No. <b>19-0023</b>	DRAWING No. <b>301</b>	REVISION <b>C</b>



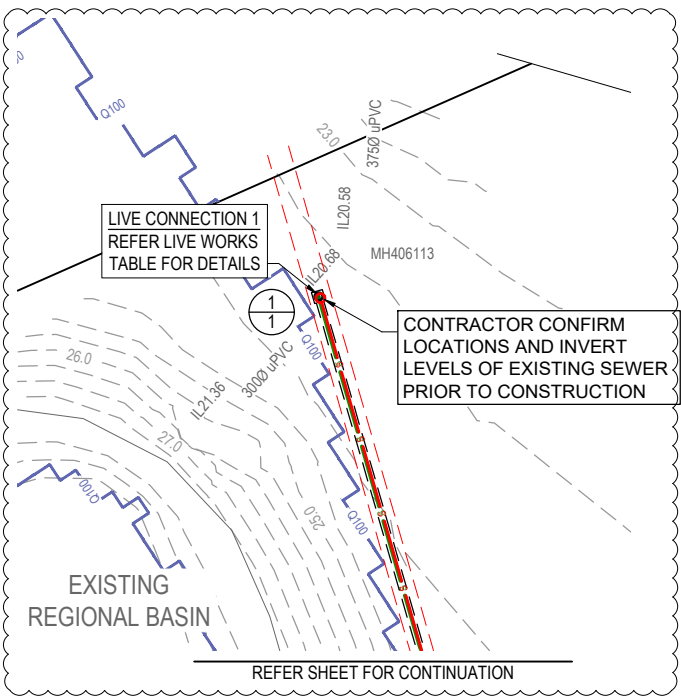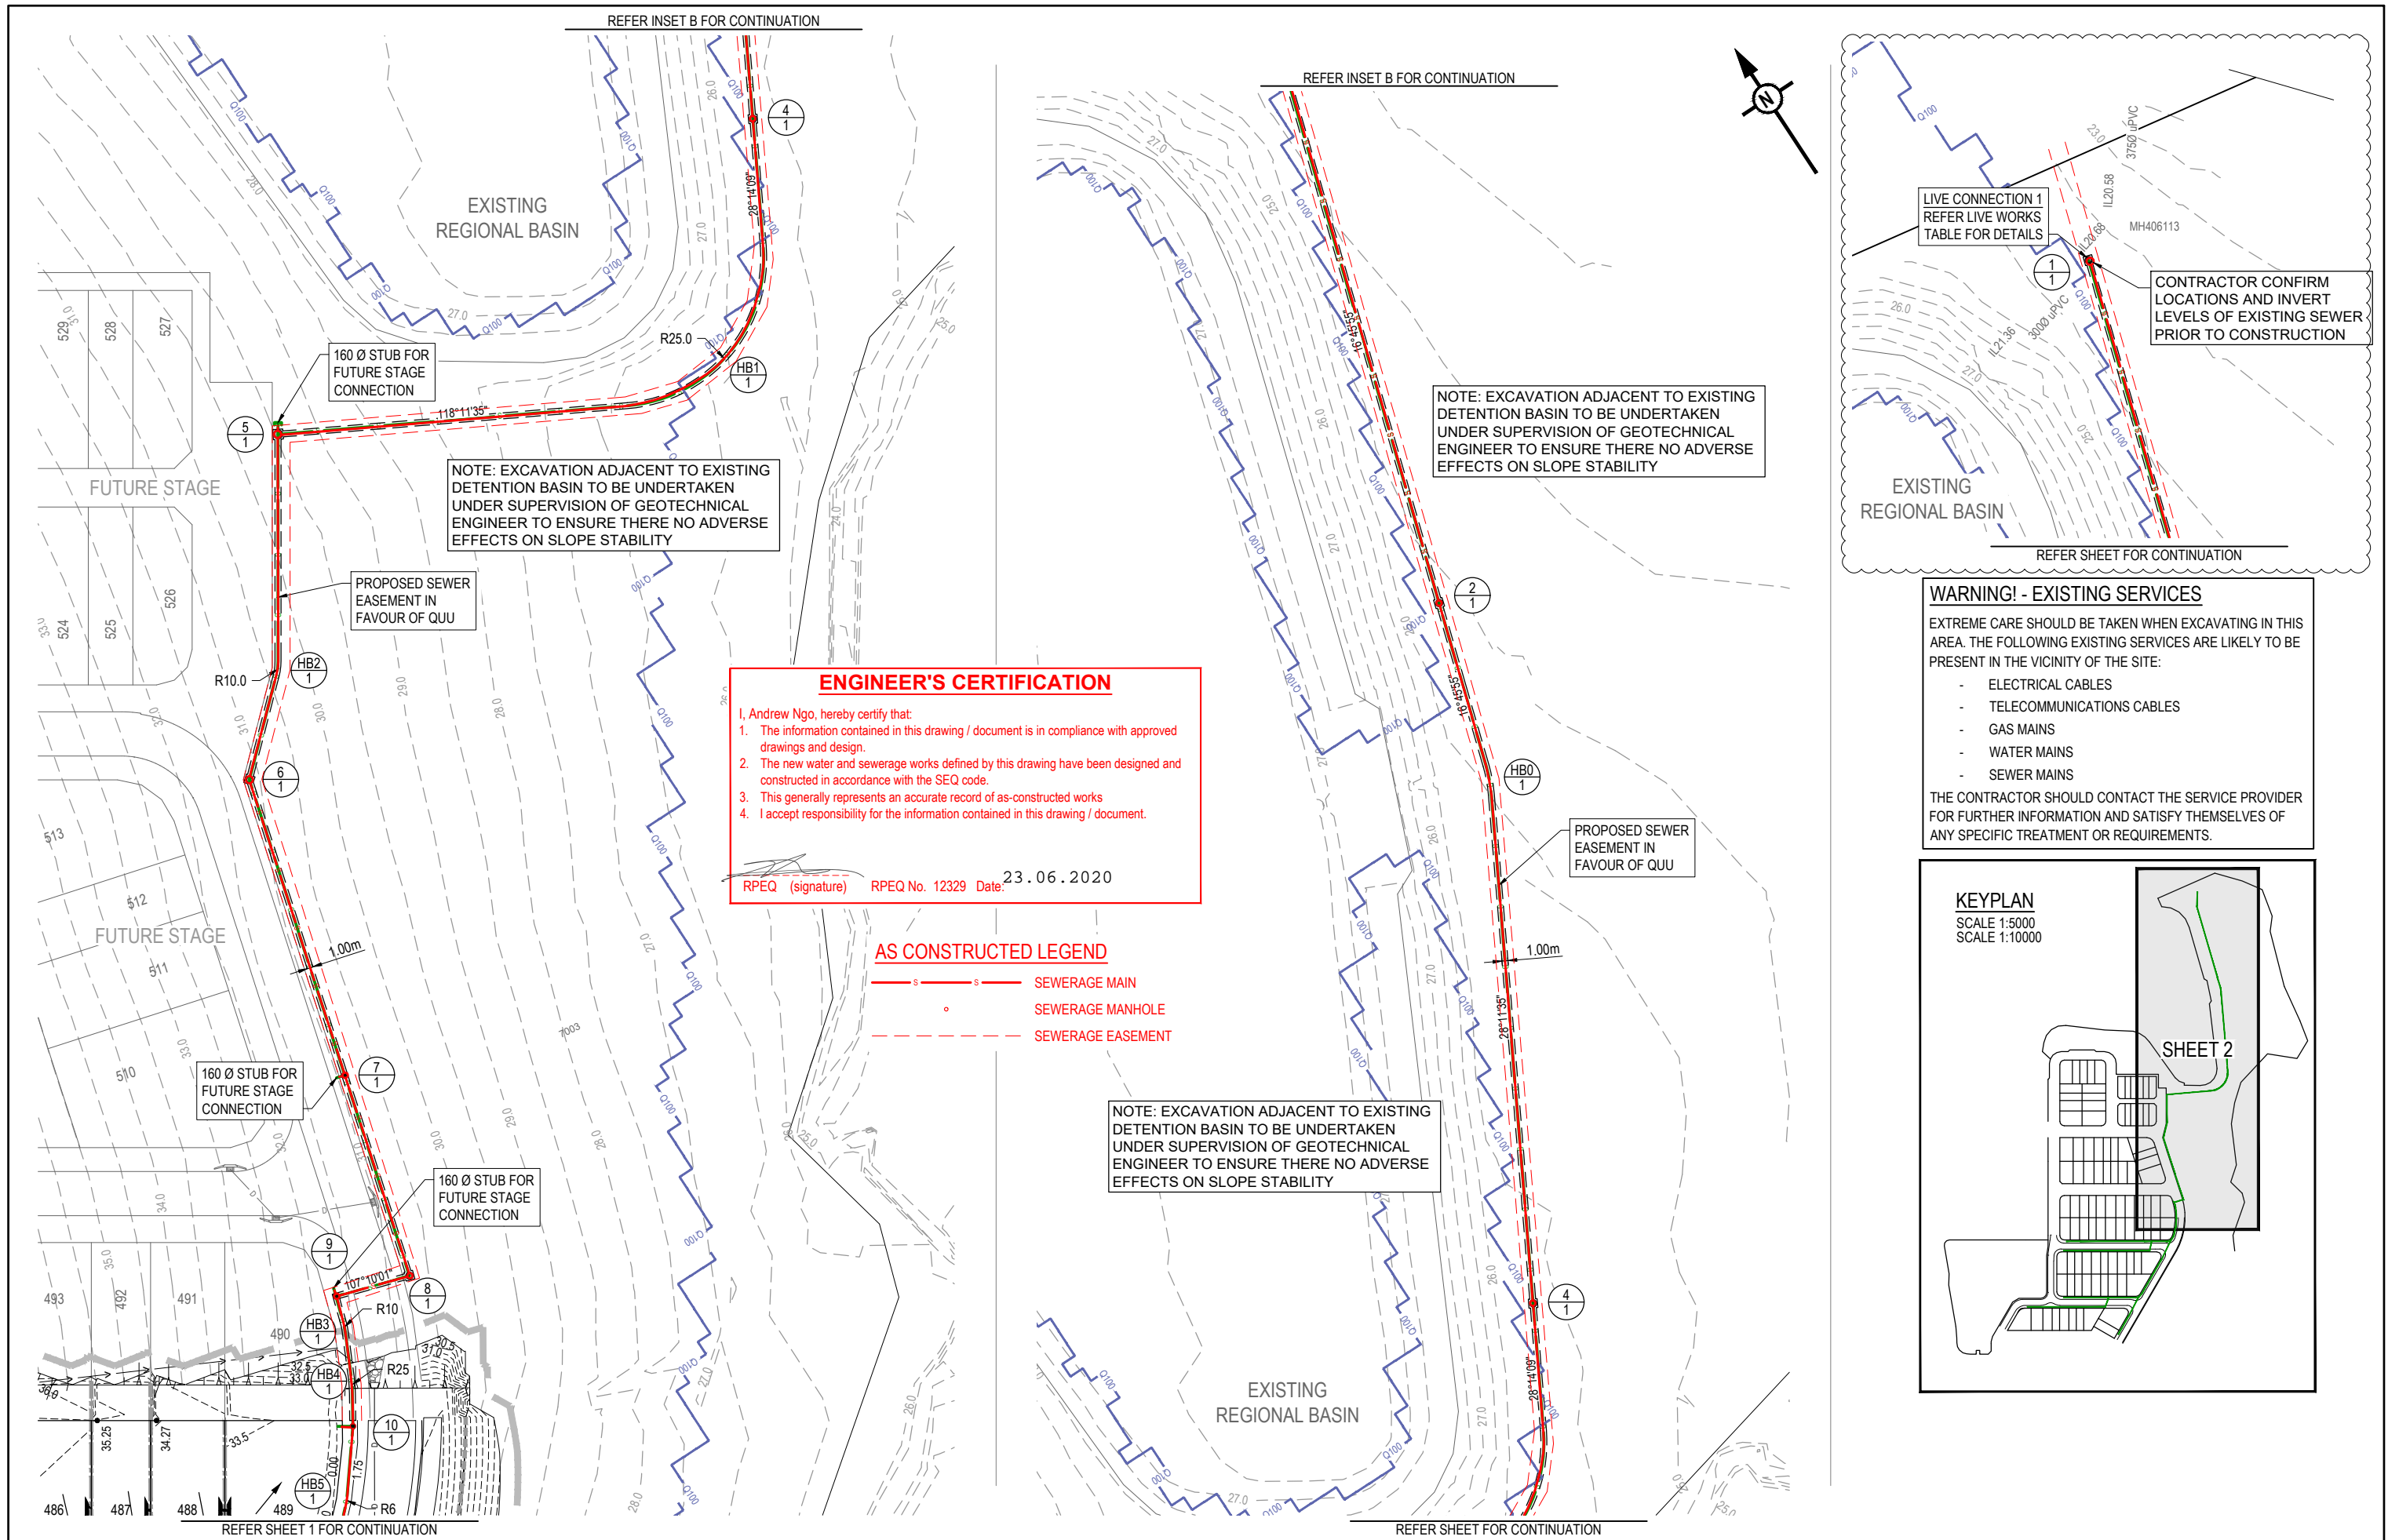

**ENGINEER'S CERTIFICATION**

I, Andrew Ngo, hereby certify that:

1. The information contained in this drawing / document is in compliance with approved drawings and design.
2. The new water and sewerage works defined by this drawing have been designed and constructed in accordance with the SEQ code.
3. This generally represents an accurate record of as-constructed works
4. I accept responsibility for the information contained in this drawing / document.

RPEQ (signature) RPEQ No. 12329 Date: 23.06.2020

**AS CONSTRUCTED LEGEND**


— s — s — SEWERAGE MAIN  
 • SEWERAGE MANHOLE  
 - - - - - SEWERAGE EASEMENT

**WARNING! - EXISTING SERVICES**

EXTREME CARE SHOULD BE TAKEN WHEN EXCAVATING IN THIS AREA. THE FOLLOWING EXISTING SERVICES ARE LIKELY TO BE PRESENT IN THE VICINITY OF THE SITE:

- ELECTRICAL CABLES
- TELECOMMUNICATIONS CABLES
- GAS MAINS
- WATER MAINS
- SEWER MAINS

THE CONTRACTOR SHOULD CONTACT THE SERVICE PROVIDER FOR FURTHER INFORMATION AND SATISFY THEMSELVES OF ANY SPECIFIC TREATMENT OR REQUIREMENTS.

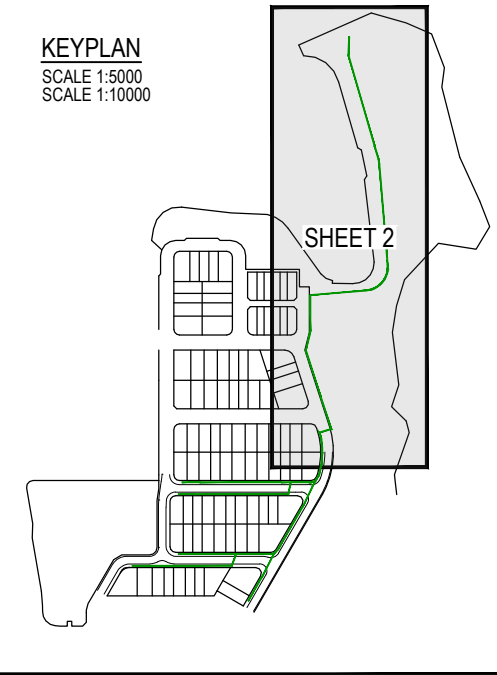

REV	DATE	DESIGN	DRAWN	REVISION DETAILS
A	05.12.19	AC	SC	ISSUED FOR CONSTRUCTION
B	12.12.19	RD	RD	LINE 1 OUTLET
C	05.08.20	TD	SC	AS CONSTRUCTED

DRAWN	STATUS
SC	<b>AS CONSTRUCTED</b>
DESIGN	APPROVED
TD	ANDREW NGO RPEQ 12329
	FOR AND ON BEHALF OF PEAKURBAN PTY LTD

**PEAKURBAN**  
 DEVELOPMENT ENGINEERS • ADVISORS

ENQUIRIES@PEAKURBAN.COM.AU

SCALE

1:500 10 5 0 10 20 A1  
 1:1000

CLIENT

**CANBERRA ESTATES  
 CONSORTIUM NO. 36 PTY LIMITED**

ASSOCIATED CONSULTANT  
 SAUNDERS HAVILL GROUP  
 PH: 1300 123 744

PROJECT NAME

**WOODLINKS VILLAGE - STAGE 16**

COLLINGWOOD DRIVE,  
 COLLINGWOOD PARK

DRAWING TITLE		
<b>SEWERAGE LAYOUT SHEET 2 OF 2</b>		
PROJECT No.	DRAWING No.	REVISION
19-0023	302	C

STRUCTURE / BEND / END NAME
STRUCTURE TYPE
STRUCTURE LID TYPE
STRUCTURE DROP TYPE
JUNCTION LINE
DEPTH TO HC
HC INVERT LEVEL
HC TYPE
HC LOT No
CH. FROM D/S STRUC / BEND


STRUCTURE TYPES  
 G = CONCRETE 0.9000  
 F = CONCRETE 1.2000  
 X = CONCRETE 1.2000  
 MS = PE 0.6000  
 MH DROP TYPES:  
 AS PER SEQ STD DRG SEQ-SEW-1303-1  
 MS DROP TYPES:  
 MS-A = 20mm DROP THROUGH BULB  
 MS-B = >750mm DROP INTO RISER  
 LID TYPES  
 B = NON-TRAFFICABLE  
 D = TRAFFICABLE  
 D(BD) = TRAFFICABLE WITH BOLT DOWN

NOTE: PE LINING OF MANHOLES:  
 MAINTENANCE HOLES ≥ 1500mm IN DIA OR ≥ 4.0m IN DEPTH,  
 REQUIRE PE LINED PROTECTIVE COATING

# EMBEDMENT NOTE:  
 EMBEDMENT TYPE IS PRELIMINARY ONLY AND IS TO BE  
 CONFIRMED AFTER GEOTECHNICAL INVESTIGATION AND  
 ADJUSTED IF NECESSARY IN ACCORDANCE WITH SEQ  
 STD DRGS SEQ-SEW-1201-1 TO 1205-1

\* STORMWATER BRIDGING NOTE:  
 WHERE A STORMWATER PIPE ≥ 600mm DIA CROSSES  
 OVER A SEWER, THE STORMWATER PIPE SHALL BE  
 SUPPORTED BY A BRIDGE STRUCTURE THAT SPANS THE  
 SEWER TRENCH. REFER DETAIL ON PEAK URBAN STD  
 DRG S-100.

LAND USE
DIAMETER
GRADE
EMBEDMENT
JUNCTION INVERT LEVEL
DEPTH TO INVERT
SEWER INVERT LEVEL
DESIGN SURFACE LEVEL
SETOUT
RUNNING CHAINAGE

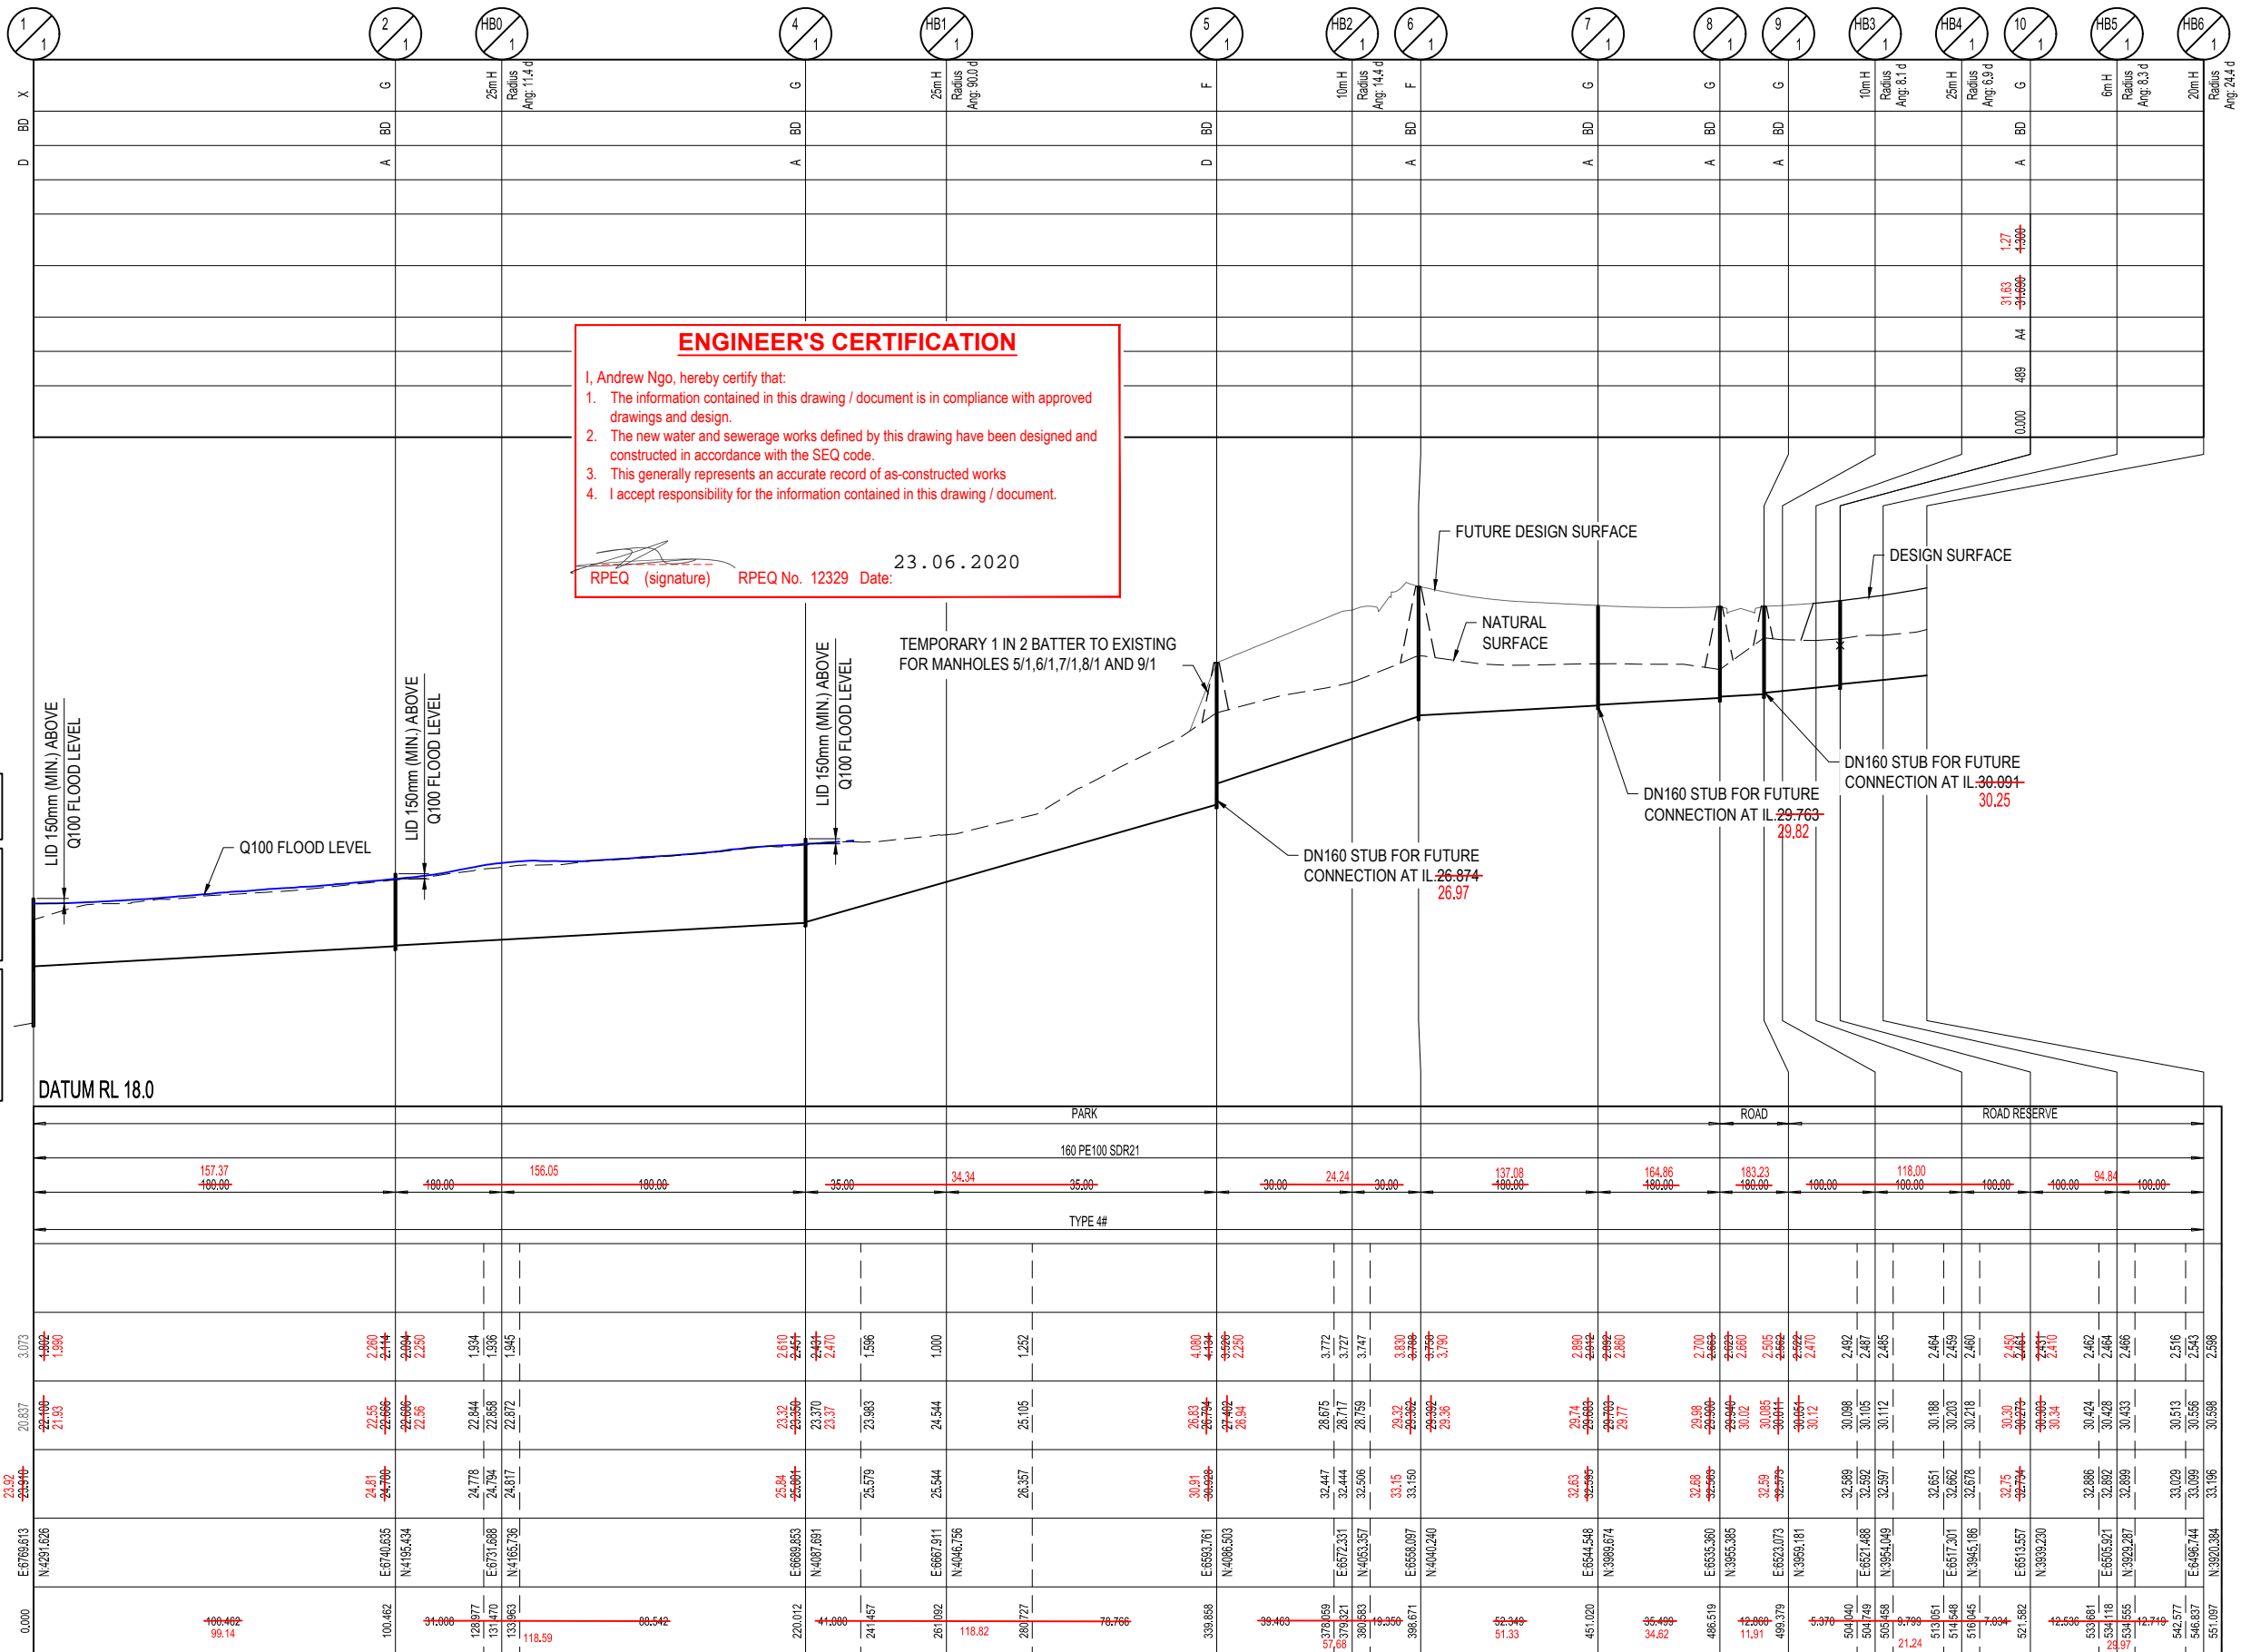

LINE

REV	DATE	DESIGN	DRAWN	ISSUED FOR CONSTRUCTION	REVISION DETAILS	DRAWN	STATUS	 DEVELOPMENT ENGINEERS - ADVISORS ENQUIRIES@PEAKURBAN.COM.AU	SCALE	CLIENT <b>CANBERRA ESTATES CONSORTIUM NO. 36 PTY LIMITED</b> ASSOCIATED CONSULTANT SAUNDERS HAVILL GROUP PH: 1300 123 744	PROJECT NAME <b>WOODLINKS VILLAGE - STAGE 16</b> COLLINGWOOD DRIVE, COLLINGWOOD PARK	DRAWING TITLE <b>SEWER LONGITUDINAL SECTION SHEET 1 OF 3</b> PROJECT No. <b>19-0023</b> DRAWING No. <b>303</b> REVISION <b>C</b>
A	05.12.19	AC	SC	LONGSECTION AMENDED	SC	<b>AS CONSTRUCTED</b>	1:1000 10 0 10 20 30 40 50 A1					
B	12.12.19	RD	RD	AS CONSTRUCTED	TD	ANDREW NGO RPEQ 12329	1:2000 HORIZONTAL A3					
C	05.06.20	TD	SC					1:100 2 1 0 2 4 A1				
								1:200 VERTICAL A3				



STRUCTURE / BEND / END NAME
STRUCTURE TYPE
STRUCTURE LID TYPE
STRUCTURE DROP TYPE
JUNCTION LINE
DEPTH TO HC
HC INVERT LEVEL
HC TYPE
HC LOT No
CH. FROM D/S STRUC / BEND


STRUCTURE TYPES  
G = CONCRETE 0.900Ø  
F = CONCRETE 1.200Ø  
X = CONCRETE 1.200Ø  
MS = PE 0.600Ø  
MH DROP TYPES:  
AS PER SEQ STD DRG SEQ-SEW-1303-1  
MS DROP TYPES:  
MS-A = 20mm DROP THROUGH BULB  
MS-B = >750mm DROP INTO RISER  
LID TYPES  
B = NON-TRAFFICABLE  
D = TRAFFICABLE  
D(BD) = TRAFFICABLE WITH BOLT DOWN

NOTE: PE LINING OF MANHOLES:  
MAINTENANCE HOLES ≥ 1500Ø IN DIA OR ≥ 4.0m IN DEPTH,  
REQUIRE PE LINED PROTECTIVE COATING

# EMBEDMENT NOTE:  
EMBEDMENT TYPE IS PRELIMINARY ONLY AND IS TO BE  
CONFIRMED AFTER GEOTECHNICAL INVESTIGATION AND  
ADJUSTED IF NECESSARY IN ACCORDANCE WITH SEQ  
STD DRGS SEQ-SEW-1201-1 TO 1205-1

\* STORMWATER BRIDGING NOTE:  
WHERE A STORMWATER PIPE ≥ 600mm DIA CROSSES  
OVER A SEWER, THE STORMWATER PIPE SHALL BE  
SUPPORTED BY A BRIDGE STRUCTURE THAT SPANS THE  
SEWER TRENCH. REFER DETAIL ON PEAK URBAN STD  
DRG S-100.

LAND USE
DIAMETER
GRADE
EMBEDMENT
JUNCTION INVERT LEVEL
DEPTH TO INVERT
SEWER INVERT LEVEL
DESIGN SURFACE LEVEL
SETOUT
RUNNING CHAINAGE

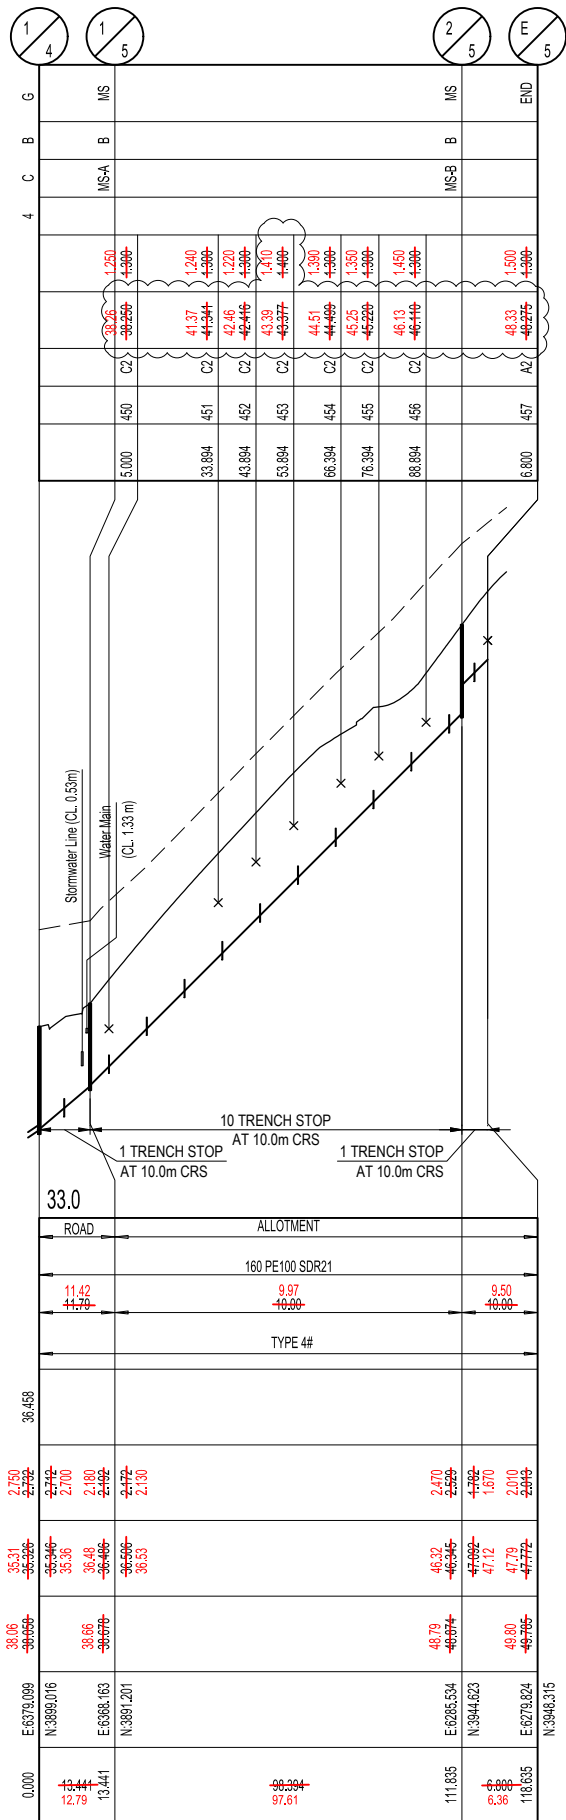

**ENGINEER'S CERTIFICATION**

I, Andrew Ngo, hereby certify that:

- The information contained in this drawing / document is in compliance with approved drawings and design.
- The new water and sewerage works defined by this drawing have been designed and constructed in accordance with the SEQ code.
- This generally represents an accurate record of as-constructed works
- I accept responsibility for the information contained in this drawing / document.

RPEQ (signature) RPEQ No. 12329 Date: 23.06.2020

REV	DATE	DESIGN	DRAWN	REVISION DETAILS	DRAWN	STATUS	SCALE	CLIENT	PROJECT NAME	DRAWING TITLE
A	05.12.19	AC	SC	ISSUED FOR CONSTRUCTION	SC	AS CONSTRUCTED	1:1000 1:2000 HORIZONTAL	CANBERRA ESTATES CONSORTIUM NO. 36 PTY LIMITED	WOODLINKS VILLAGE - STAGE 16	SEWER LONGITUDINAL SECTION SHEET 3 OF 3
B	22.01.20	AC	CL	2/5 E/S SURFACE LEVEL UPDATED, LOT 457 HC UPDATED	TD	APPROVED ANDREW NGO RPEQ 12329	1:100 1:200 VERTICAL	ASSOCIATED CONSULTANT SAUNDERS HAVILL GROUP PH: 1300 123 744	COLLINGWOOD DRIVE, COLLINGWOOD PARK	PROJECT No. 19-0023
C	21.02.20	AC	CL	HC INVERT LEVELS AMENDED - LOT 450-457						DRAWING No. 305
D	05.06.20	TD	SC	AS CONSTRUCTED						REVISION D





**NOTES**

1. INSTALL PIT AND PIPE INFRASTRUCTURE TO NBN Co SPECIFICATION AND STANDARDS. NBN Co PIT AND CONDUIT INFRASTRUCTURE GUIDE LINES FOR DEVELOPERS CAN BE FOUND ONLINE AT <http://www.nbnco.com.au/industry/new-developments.html>
2. PIT AND PIPE INFRASTRUCTURE TO BE INSPECTED BY NBN Co AFTER INSTALLATION.
3. INSTALL P23 LEAD-IN PIPES FROM PIT TO PROPERTY ENTRY POINT AND PLUG.
4. ALL CONDUITS TO BE INSTALLED IN JOINT USE TRENCH UNLESS DETAILED OTHERWISE.
5. ALL MATERIALS SHALL BE TO NBN Co SPECIFICATION. ALTERNATIVES WILL ONLY BE ACCEPTED IF AGREED TO IN WRITING BY NBN Co.
6. THE LOCATION OF PIT AND PIPE INFRASTRUCTURE SHALL ALSO COMPLY WITH THE REQUIREMENTS OF ENERGEX.
7. CONSTRUCTOR TO CONFIRM FINAL LOCATION OF PROPOSED DRIVEWAYS AND SERVICES PRIOR TO CONSTRUCTION. NBN Co PITS TO BE INSTALLED CLEAR OF DRIVEWAYS & OTHER SERVICES INCLUDING ALL PROPOSED.

**DO NOT CONSTRUCT ANY CONCRETE DRIVEWAYS OR CROSSOVERS UNTIL ELECTRICAL & COMMUNICATIONS WORKS ARE COMPLETED**



Told to install at 2% and that the retaining wall was getting lifted

6 pit due to not enough depth on power and next to solid rock

**LEGEND**


- EXISTING TELSTRA UG CABLE
- EXISTING AERIAL CABLE
- TELSTRA PLANT IN SHARED UTILITY TRENCH
- PROPOSED NBN UNDERGROUND CONDUIT IN SHARED UTILITY TRENCH
- PIT-ID (650mmx280mmx565mm) Service Drop Access Pit
- PIT-ID (700mmx450mmx650mm) Network Boundary/Local Network PR (Single Lid)
- PIT-ID (1360mmx555mmx860mm) Distribution/Local Network Connection Pit
- PIT-ID (2000mmx555mmx900mm) Fibre Distribution Hub (FDH) Pit
- Existing Telstra manhole
- Existing Telstra PR (2,3,4,5,6,7,8,9)
- Telstra exchange
- Example of Telstra Major Conduit Layout with Proposed duct marked to be used by NBN
- Premise Connection Device (PCD)
- Fan Access Node site (FAN)
- Multi Dwelling Unit (MDU)

**SDU Development Information**

Development Name: 246 Collingwood Dr, Collingwood Park QLD 4301  
 Developer Company: Cambera Estates Consortium No. 36  
 Development Address: 246 Collingwood Dr, Collingwood Park QLD 4301  
 Authorised Rep: Ampflo Pty Ltd  
 Phone: 0733729280  
 E-Mail: [comms@ampflo.com.au](mailto:comms@ampflo.com.au)

nbn Reference Number: STG  
 Stage Number: 16  
 Design Revision: C

**PILLARS / PITS ON ZERO LOT BOUNDARIES**

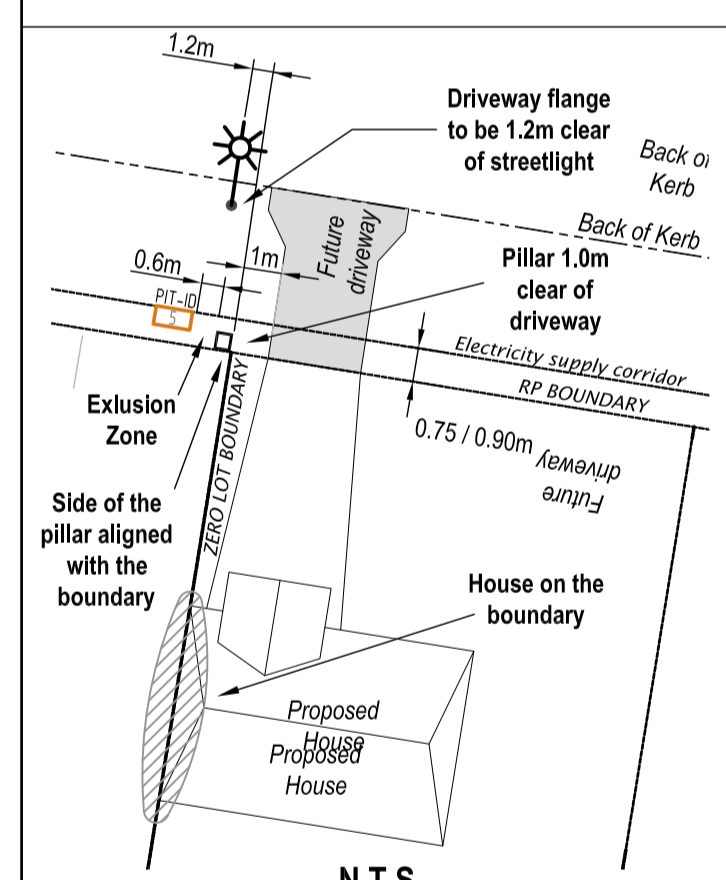

**REQUIREMENTS FOR ELECTRICAL, GAS & COMMUNICATIONS**

The proposed pillar shall be offset at the zero lot boundary with the side of the pillar being aligned with the lot boundary in order to provide a 1.0m minimum clearance from the future driveway.

A proposed streetlight shall be offset 1.2m from the flange of the future driveway.

**COMMUNICATIONS PITS** are to remain outside 600mm pillar exclusion zone shall not clash with future driveways

**GAS SERVICE TEE-OFFS** are to remain outside 600mm pillar exclusion zone where a pillar is offset to align on one side with the boundary peg

**STAGE 16**



**PREFERRED GARAGE LOCATION** (Green triangle icon)

**ALTERNATIVE GARAGE LOCATION** (White triangle icon)

- GENERAL NOTES**
1. PATHWAYS TO BE NBN FIBRE READY.
  2. PITS AND CONDUITS INDICATIVE LOCATIONS.
  3. CIVIL CONTRACTOR TO ARRANGE INSTALLATION OF JOINT USE TRENCH CONDUITS FOR ROAD CROSSINGS.
  4. ELECTRICAL CONTRACTOR TO ARRANGE INSTALLATION OF JOINT USE TRENCH CONDUITS, PITS AND LEAD-INS.
  5. PITS ARE NOT TO BE INSTALLED IN VEHICULAR DRIVEWAYS.

**BILL OF MATERIAL**

NO OF LOTS: 46

PITS		DUCTS		
SIZE	QTY	SIZE	QTY	MTRS
2	0	P100	16	450.4
5	22 ✓	P50	9	257.1
6	1 ✗	P20	46	461.3
8	1 ✗			
9	0			

TOTAL NUMBER OF PITS: 24 ✓  
 TOTAL NUMBER OF MANHOLES: 0  
 TOTAL NUMBER OF CONDUITS: 71  
 TOTAL LENGTH OF CONDUITS: 1168.8

Total rod & rope - 746.5

**AS CON**  
8 Apr 2020

Sullivan Underground Services

**Aiden Harte**

*Aiden Harte*



**REVISIONS**

REV	DATE	DRAFTER	DESCRIPTION	APPROVED
C	14.11.19	JB	Additional duplex added	CR
B	22.10.19	JB	Revised design due to changes in electrical plan affecting road crossings	CR
A	30.08.19	MS	Initial Design	CR

**STRICTLY CONFIDENTIAL**

NBNCO APPROVAL RECORD:


SIGNATURE	DATE
<input type="checkbox"/> DD	
<input type="checkbox"/> WD	
<input type="checkbox"/> AB	

QUALITY RECORD:

NBNCO DISCLAIMER: THIS DOCUMENT HAS BEEN PREPARED SOLELY FOR THE USE OF NBNCO LIMITED (ABN 86 136 533 741) FOR USE IN MAINTAINING NBNCO FACILITIES. IT HAS NOT BEEN CREATED FOR ANY OTHER USE. IT SHOULD NOT BE SCALED TO LOCATE NBNCO ASSETS. NO WARRANTY IS GIVEN THAT THE INFORMATION IS ACCURATE OR COMPLETE.

**nbn** Australia's broadband network

**ampflo** ABN 28 111 423 842  
 Electrical and Telecommunications Consultants  
 07 3372 9280 · [projects@ampflo.com.au](mailto:projects@ampflo.com.au)  
[ampflo.com.au](http://ampflo.com.au)

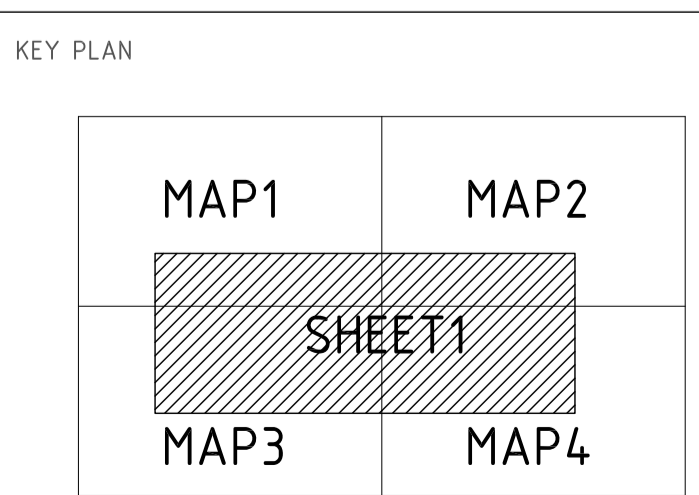

DRAWING TITLE: NATIONAL BROADBAND NETWORK  
 246 Collingwood Dr  
 Collingwood Park  
 QLD 4301

ENABLED:

STATE: REGION:

FS: SAM: ADA:

PROJECT No: 191623  
 CADREF No: T191623

SCALE: 1:400 SHEET No: 1 OF 1 REV: C

LEGEND

- EXISTING OVERHEAD CABLE
PROPOSED OVERHEAD CABLE
EXISTING UNDERGROUND CABLE
PROPOSED UNDERGROUND CABLE
PROPOSED ELECTRICAL SERVICE CONDUIT
ELECTRICAL & COMMUNICATION SERVICE CONDUITS
POLE TRANSFORMER
PADMOUNT TRANSFORMER
HV POLE
HV / LV POLE
LV POLE
HV UNDERGROUND POLE TERMINATION
LV UNDERGROUND POLE TERMINATION
AERIAL STAY
GROUND STAY
EARTH
EXISTING PILLAR
PROPOSED PILLAR
COMMERCIAL PILLAR
LINK PILLAR
16LV CONDUIT / CABLE CROSS-SECTION
EXISTING L17 STREET LIGHT
PROPOSED L17 STREET LIGHT
ISOLUX LINE


PROPOSED COMMISSIONING PLAN RATE 3 STREETLIGHTING

(subject to site conditions, amendment by switching co-ordinator and approval by LV outage co-ordinator)

- 1. Confirm & record all required documentation is present & has been completed prior to commissioning
2. Confirm & record insulation & continuity results from new installation
3. Connect LV cable to pillar
4. Install fuses at pillar U2192807, energise W2192831 & W2192832
5. Install fuse at pillar U2192810, energise W2192833
6. Install fuse at pillar U2192811, energise W2192834
7. Install fuse at pillar U2192812, energise W2192835
8. Install fuse at pillar U2192813, energise W2192836
9. Install fuse at pillar U2192817, energise W2192837
10. Install fuse at pillar LP2192818, energise W2192838
11. Install fuse at pillar U2192819, energise W2192839
12. Install fuse at pillar U2192821, energise W2192840
13. Install fuse at pillar U2192823, energise W2192841
14. Install fuse at pillar U2192824, energise W2192842
15. Confirm & record polarity results
Update worksplan including streetlight energisation date



RATE 3 STREETLIGHT CONNECTION SINGLE POLE WIRING DIAGRAM ICC STANDARD DRAWING SL.03

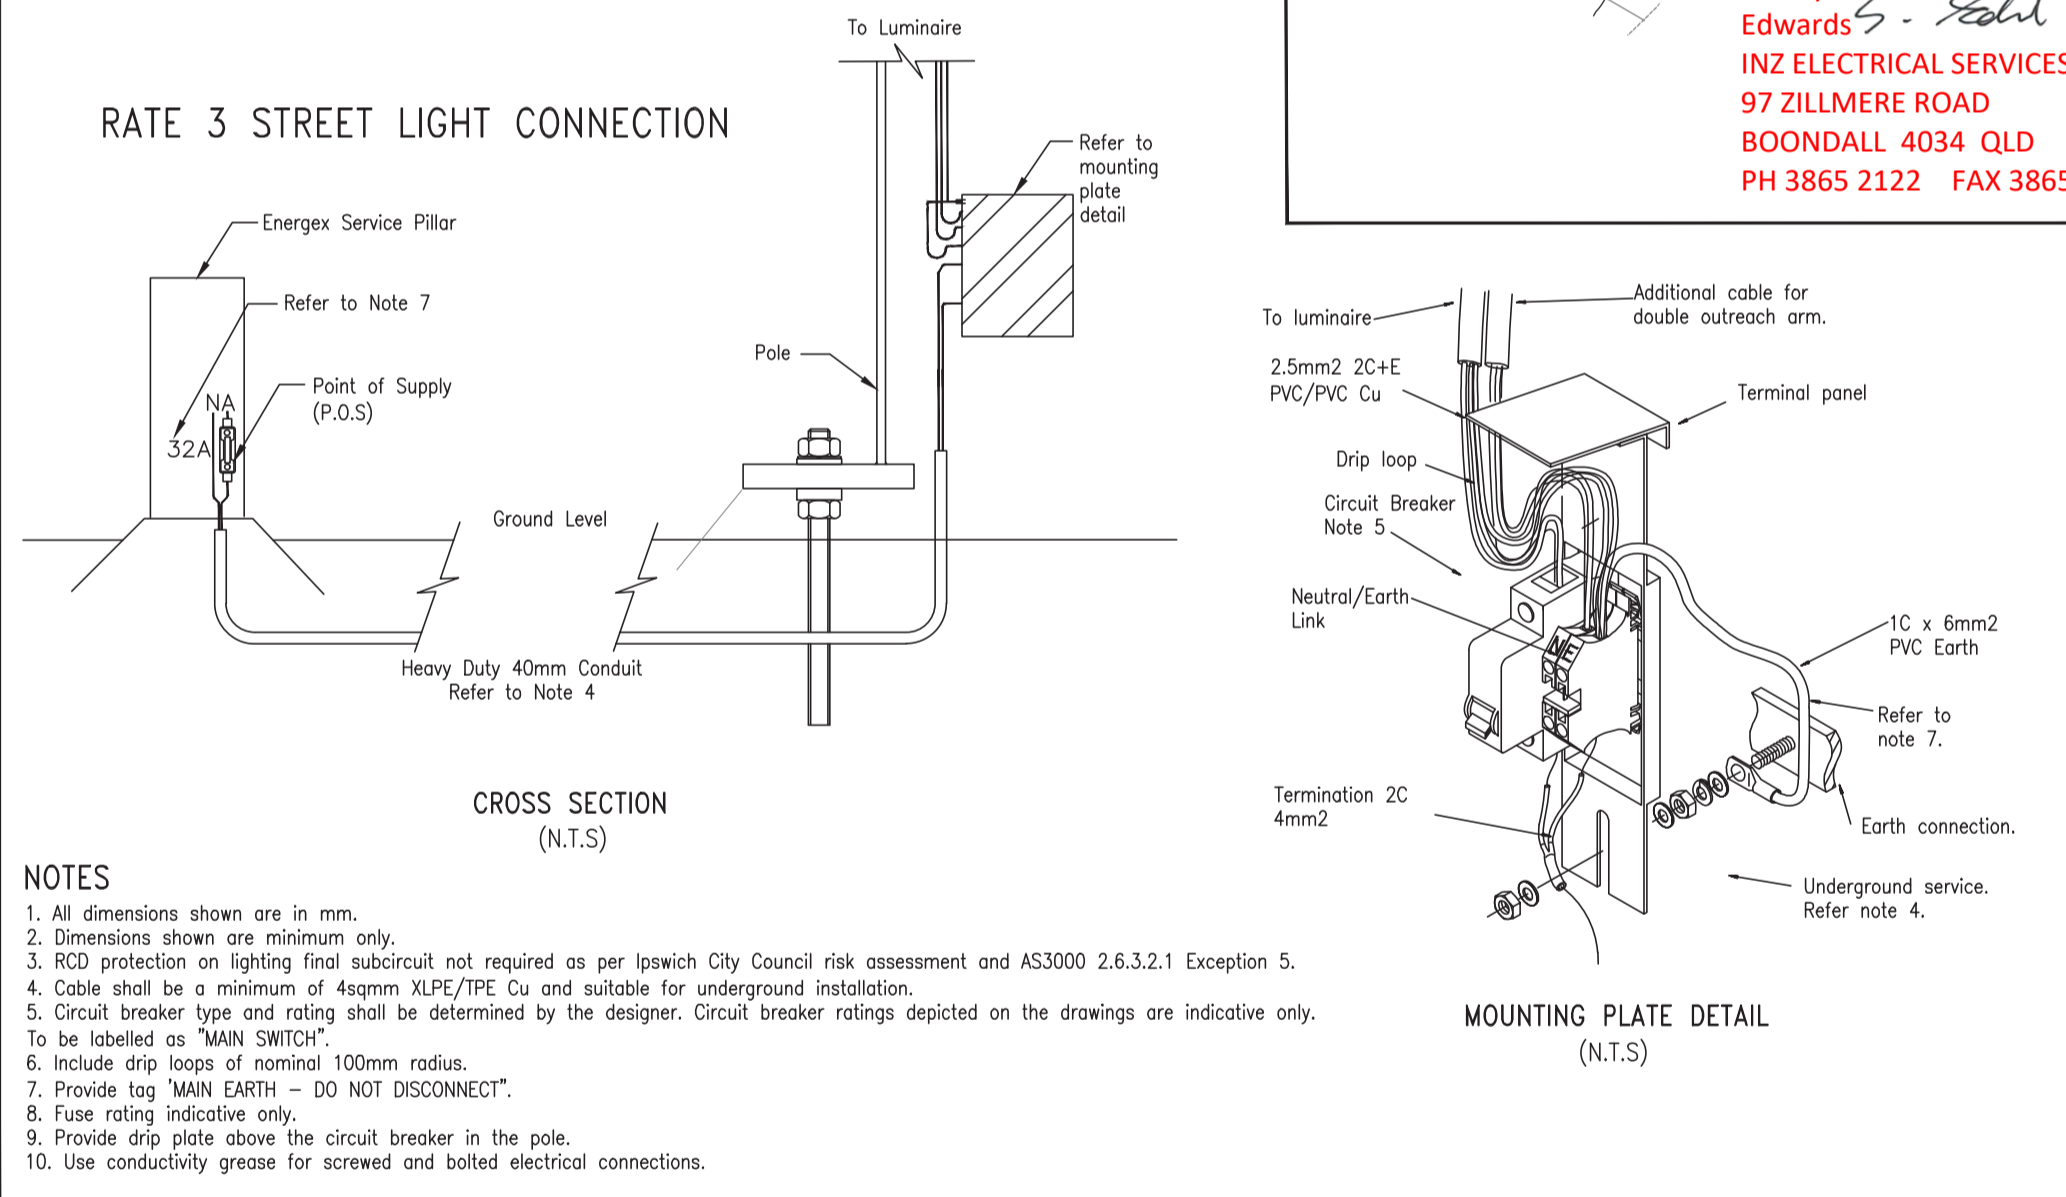


AS CONSTRUCTED
Garry Edwards
INZ ELECTRICAL SERVICES PTY LTD
97 ZILLMERE ROAD
BOONDALL 4034 QLD
PH 3865 2122 FAX 3865 4475


NOTES

- 1. All dimensions shown are in mm.
2. Dimensions shown are minimum only.
3. RCD protection on lighting final subcircuit not required as per Ipswich City Council risk assessment and AS3000 2.6.3.2.1 Exception 5.
4. Cable shall be a minimum of 4sqmm XLPE/TPE Cu and suitable for underground installation.
5. Circuit breaker type and rating shall be determined by the designer. Circuit breaker ratings depicted on the drawings are indicative only. To be labelled as 'MAIN SWITCH'.
6. Include drip loops of nominal 100mm radius.
7. Provide tag 'MAIN EARTH - DO NOT DISCONNECT'.
8. Fuse rating indicative only.
9. Provide drip plate above the circuit breaker in the pole.
10. Use conductivity grease for screwed and bolted electrical connections.

PILLARS / PITS ON ZERO LOT BOUNDARIES

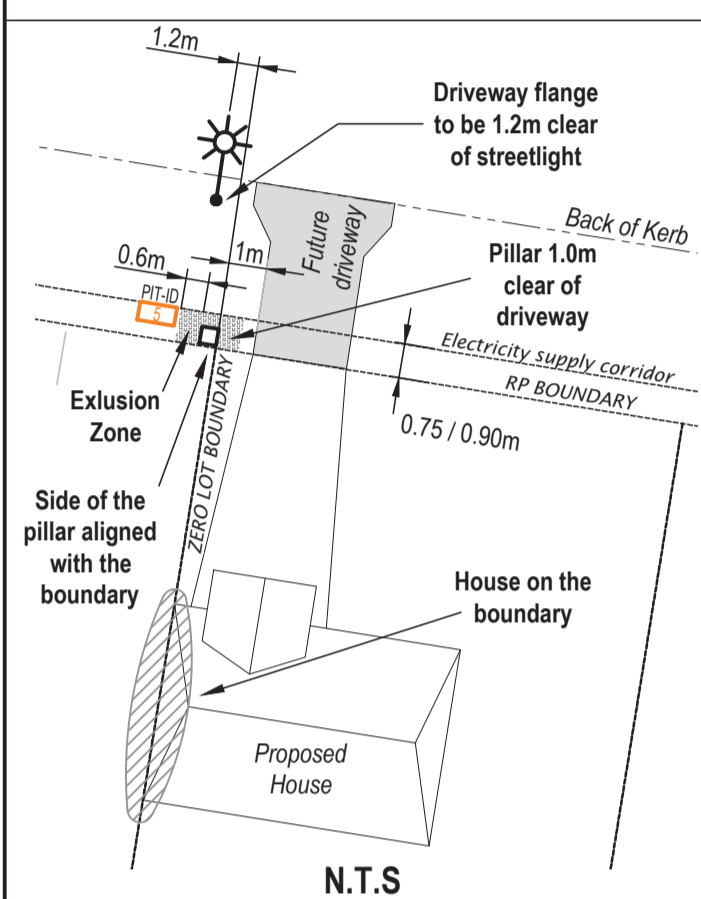

REQUIREMENTS FOR ELECTRICAL, GAS & COMMUNICATIONS
The proposed pillar shall be offset at the zero lot boundary with the side of the pillar being aligned with the lot boundary in order to provide a 1.0m minimum clearance from the future driveway.
A proposed streetlight shall be offset 1.2m from the flange of the future driveway.
COMMUNICATIONS PITS are to remain outside 600mm pillar exclusion zone where a pillar is offset to align on one side with the boundary peg
GAS SERVICE TEE-OFFS are to remain outside 600mm pillar exclusion zone where a pillar is offset to align on one side with the boundary peg

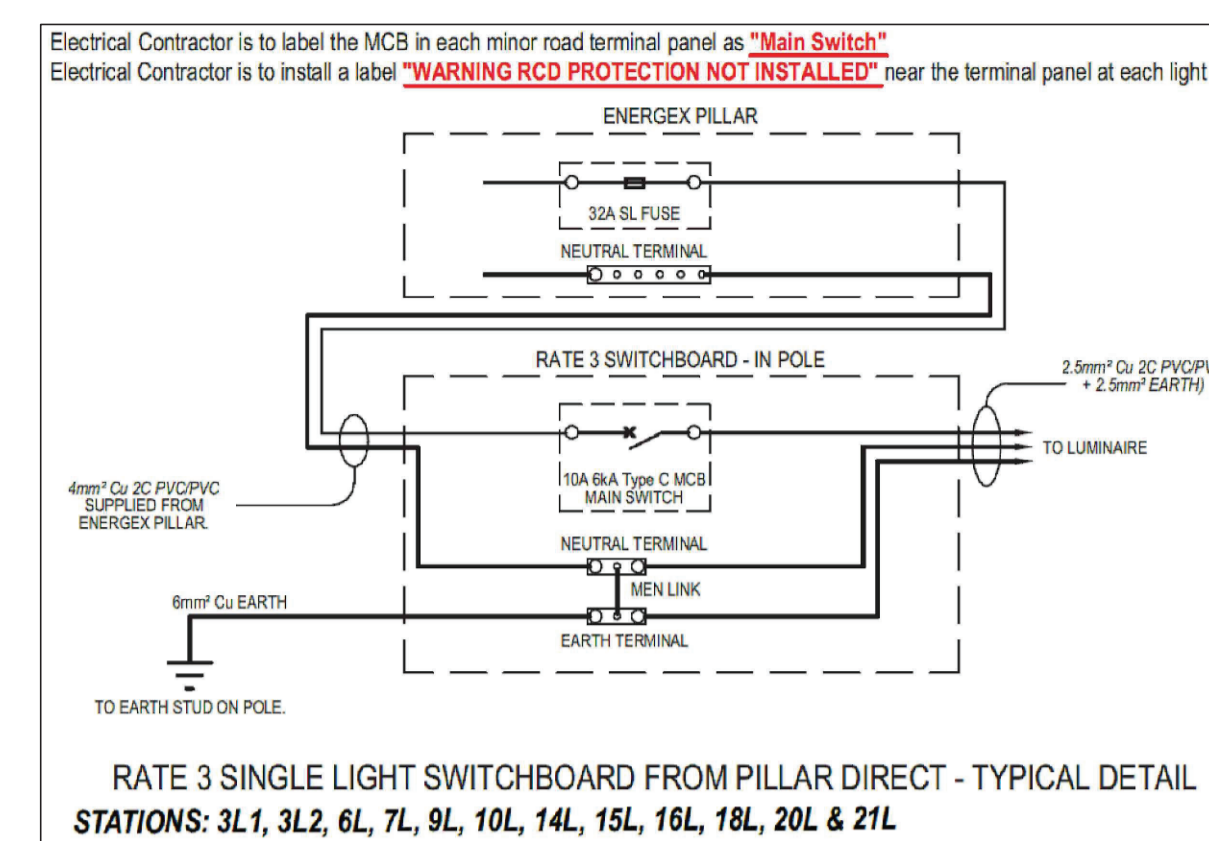


STREET LIGHTING CERTIFICATION PERIOD ST, QUARTZ RD, ELDER PDE & CARNELIAN CRES - P4

- 1. THE ILLUMINANCE LIGHT TECHNICAL PARAMETERS COMPLY WITH THE RECOMMENDATIONS OF AS/NZS 1158.3.1 CAT P4 ROADWAYS & PATHWAYS
2. THE LIGHT LOSS FACTOR OF 0.75 FOR MINOR ROADWAY LUMINAIRES IS BASED ON THE CLIENTS CURRENT PRACTICE & IS IN ACCORDANCE WITH AS/NZS 1158
3. PHOTOMETRIC DATA WAS PROVIDED BY MANUFACTURER. SOFTWARE USED FOR CALCULATIONS IS PERFECT LITE
4. CALCULATIONS ARE SUBJECT TO ACCURACIES AND TOLERANCES NOMINATED IN AUSTRALIAN AND NEW ZEALAND STANDARDS AS/NZS 3827.1:1998 AND AS/NZS 3827.2:1998.

Cornel Radu
RPEQ 17404
2019.10.24 15:02:20 +10'00'
RPEQ

APPROVED FOR CONSTRUCTION


ICC STANDARD DRAWING SL.07

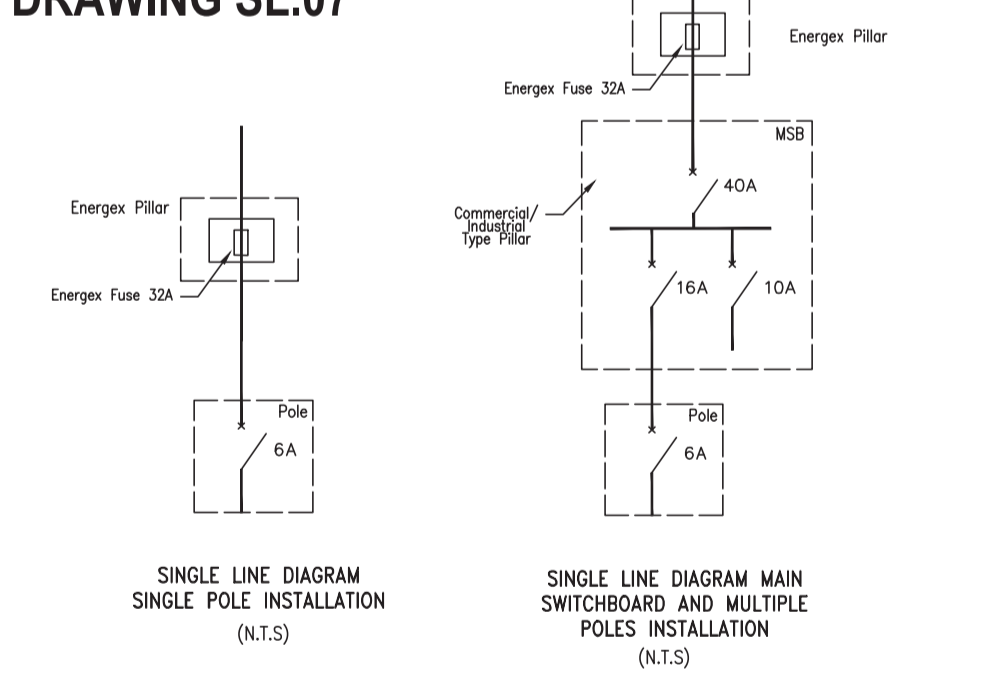

BILL OF MATERIALS RATE 3 LIGHTING

Table with columns: DESCRIPTION, QTY, MTRS, REMARKS. Includes items like 40mm HD electrical conduit (1/210), 4mm² twin + earth (N/A/296), and AVENUE + L17 LUMINAIRE (12 N/A BLACK).

ICC STANDARD DRAWING SL.08

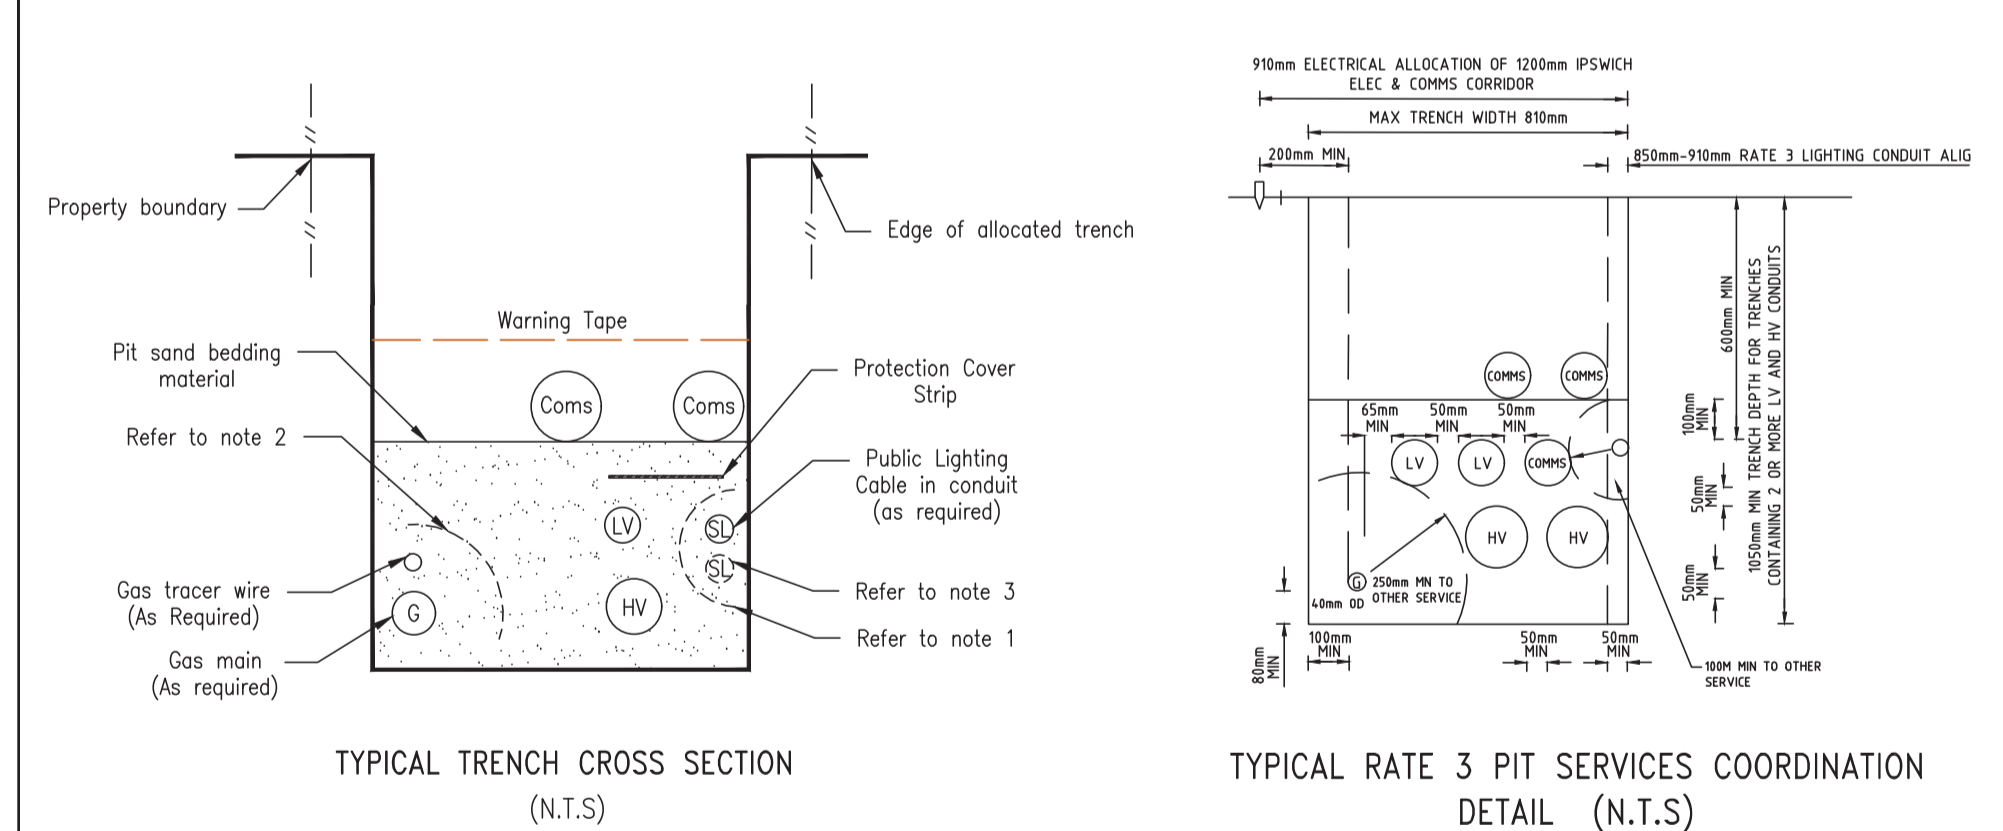

- NOTES
1. Minimum of 100mm separation to be maintained between street light conduits and other services.
2. Minimum of 250mm separation to be maintained between Gas Pipes and other services.
3. Additional 100mm street light conduit to be installed where required.
4. Circuit breaker type and rating shall be determined by the designer. Circuit breaker ratings depicted on the drawings are indicative only.
5. Number of circuits as required for project plus 50% spare for each switchboard
6. Fuse rating indicative only.

DRAWING INDEX

Table with columns: Drawing ID, Description. Lists drawings for site plan, schedules, schematics, and notes.

STREET LIGHT SCHEDULE - RATE 3

Table with columns: LOCATION, STN NO., POLE I.D., COMP I.D., EXIST, REC, ERECT, STOCK CODE, ALIGN, DATE DE-ENERG, LUMINAIRE, DATE ENERGISED, STOCK CODE, EXIST (M), REC (M), ERECT (M), MOUNT HEIGHT (M), REMARKS. Lists details for 21 streetlights across various locations.

REVISION table with columns: ISSUE, REVISION, BY, DATE. Shows three revisions from Initial Design to Amendments as per ICC.

NOTES
This Works Plan is to be constructed in compliance with Energex documents:
• Overhead Construction Manual
• Underground Distribution Construction Manual
• Public Lighting Construction Manual
• Network Labelling and Signage Manual
The Construction Contractor is to manage this project and submit As Constructed drawings and the Certificate of Completion to Energex.

EARTHING
Earthing is to be carried out in accordance with Energex requirements.
TELECOMMUNICATIONS INSTALLATION
Telecommunication conduits to be laid in shared trenches with electricity conduits. The Civil Electrical Construction Contractor is to notify the Telstra Contractor one week prior to installation of cross road conduits and two days prior to installation of footpath conduits for Telstra Pit and Pipe designs.
FIRE ARMS
The Construction Contractor is to confirm if this work site is within a Fire Ant Restricted Area. For work sites within a Fire Ant Restricted Area the Contractor must comply with a DPI Approved Risk Management Plan.

UNDERGROUND SERVICES IDENTIFICATION
WORK CREWS TO CONFIRM LOCATION OF ALL EXISTING SERVICES PRIOR TO EXCAVATION - ANY SERVICES SHOWN ARE INDICATIVE ONLY

ALIGNMENTS
ENERGEX OH EXISTING
ENERGEX UG 0 - 0.9m
STREET LIGHTS 0.85 & 0.95 IOK
DESIGNED A. Vinnal
CHECKED C. Radu
DATE August 2019

APPROVED ON BEHALF OF AMPFLO PTY LTD
Cornel Radu
RPEQ 17404
2019.10.24 15:01:49 +10'00'
SCALE 1:750 (A1)
Do not scale from this drawing - use only the dimensions provided

COUNCIL REFERENCE
IPSWICH CITY COUNCIL: 4208/2015/CA
CIVIL ENGINEER
Peak Urban
Ph. 5413 5300
SURVEYOR
SAUNDERS HAVILL GROUP
1300 123 744



PROJECT
WOODLINKS VILLAGE - STAGE 16
246 COLLINGWOOD DR, COLLINGWOOD PARK 4301
Lots 448 - 489 (42 lots) & 5007
Cancelling Lot 5007 on SP307776
CLIENT
Canberra Estates Consortium No 36 Pty Ltd

URD CIVIL WORKS SCHEDULE - ROADWAYS (BY CIVIL CONTRACTOR)

Table with columns: LOCATION, STATIONS FROM-TO, NUMBER OF CONDUITS x CONDUIT LENGTH (m), PVC CABLE PROTECTION (m), X-SECTION (m), KERB MARK, REMARKS. Lists 14 roadway items with a total of 99 conduits, 100 m trench, and 14 kerb marks.

URD CIVIL WORKS SCHEDULE - FOOTPATHS (BY ELECTRICAL CONTRACTOR)

Table with columns: LOCATION, STATIONS FROM-TO, NUMBER OF CONDUITS x CONDUIT LENGTH (m), PVC CABLE PROTECTION (m), X-SECTION (m), KERB MARK, REMARKS. Lists 14 footpath items with a total of 140 conduits, 15 m trench, and 140 kerb marks.

UNDERGROUND CABLE SCHEDULE

Table with columns: LOCATION, STATIONS FROM-TO, EXIST, REC, INSTALL, STREET LIGHT 16mm² TWIN + EARTH, STREET LIGHT 4mm² TWIN + EARTH, REMARKS. Lists 21 items with a total of 296 cable runs.

ampflo

RATE 3 STREETLIGHTING

ENERGEX NO

S2601534

DRAWING NO

1 OF 2

R191623



**LEGEND**

- EXISTING OVERHEAD CABLE
- PROPOSED OVERHEAD CABLE
- EXISTING UNDERGROUND CABLE
- PROPOSED UNDERGROUND CABLE
- E PROPOSED ELECTRICAL SERVICE CONDUIT
- E T PROPOSED ELECTRICAL & COMMUNICATION SERVICE CONDUITS
- POLE TRANSFORMER
- PADMOUNT TRANSFORMER
- HV POLE
- HV / LV POLE
- LV POLE
- HV UNDERGROUND POLE TERMINATION
- LV UNDERGROUND POLE TERMINATION
- AERIAL STAY
- GROUND STAY
- EARTH
- EXISTING PILLAR
- PROPOSED PILLAR
- COMMERCIAL PILLAR
- LINK PILLAR
- 16LV CONDUIT / CABLE CROSS-SECTION
- EXISTING L17 STREET LIGHT
- PROPOSED L17 STREET LIGHT
- ISOLUX LINE

**LIST OF STANDARD DRAWINGS**

- SL.01 List of Standard Drawings and Equipment Requirements
- SL.02 Electrical, Project Documentation & Design Requirements
- SL.03 Single Pole Wiring Diagram
- SL.04 Two Pole Wiring Diagram -- DELETED
- SL.05 Multiple Pole Installation with Unmetered 3 Phase Supply
- SL.06 Multiple Pole Installation with Metered 3 Phase Supply -- DELETED
- SL.07 Single Line Diagram & Conduit Installation Details
- SL.08 Streetlight Reticulation Details

**ABBREVIATIONS**

- NTS - not to scale
- POS - point of supply
- MCB - miniature circuit breaker

**EQUIPMENT REQUIREMENTS**

All streetlight and associated works are to be carried out in accordance with all legislative requirements and Australian Standards. The standards that will apply shall include but not be limited to:

- AS/NZS 1158
- AS/NZS 2053
- AS/NZS 3000
- AS/NZS 3008
- QLD Electrical Safety Act

The details contained within the standard drawings are to be read in conjunction with the Ipswich City Council (ICC) policy documents; Planning Scheme Policy 3 - General Works, and Planning Scheme Policy 2. Where there is a conflict of requirements then the Planning Scheme Policy documents shall take precedence over the drawings. All equipment shall be selected from ENERGEX or Department of Transport and Main Roads (DTMR) standard equipment.

Warranty for rate 3 streetlight equipment shall be vested with Ipswich City Council at the start of Off Maintenance period.

Ipswich City Council has mandated the use of the Light Emitting Diode (LED) luminaires. The LED luminaire type and associated street light equipment shall be installed as an Energex unmetered rate 3 type. Any luminaire approved for use must be fitted with a NEMA 7 pin socket and associated wiring. Terminal numbers 1 to 5 inclusive of the NEMA 7 pin socket are to have their respective connections made prior to installation. Terminals 6 and 7 of the NEMA 7 pin socket are to have fly leads connected prior to installation. The fly leads are to be 150 mm in length, matching existing wire type, different external colour and terminated with insulated end caps. All luminaires must be operated using a photoelectric (P.E.) cell installed on the luminaire. The external NEMA 7 pin socket must be installed to allow the matching P.E. cell plug connection. Where the NEMA 7 pin socket is not used for a P.E. connection it must be capped with a shorting cap to prevent material ingress.

**AS CONSTRUCTED**

Garry Edwards *G. Edwards* Date: 27/05/20  
 INZ ELECTRICAL SERVICES PTY LTD  
 97 ZILLMERE ROAD  
 BOONDALL 4034 QLD  
 PH 3865 2122 FAX 3865 4475

**ELECTRICAL REQUIREMENTS**

Any calculations shall use the nominal voltage value of 230/400 volts. All street light connections shall be balanced across the phases of the supply network.

The value of current draw to be used for cable size calculations and selection of circuit protection devices is to be based on the total rated load of each luminaire installed, including electronic losses, power factor, harmonics and inrush current.

Minimum cable sizes and insulation types are indicated in the drawings SL03 and SL05.

Provide larger separate earth cables where the integral earth conductor is not sufficient size to meet earth fault loop impedance requirements.

Preferred types and values of protection equipment are shown on associated standard drawings. cable sizes shall be checked for each proposed project for the following criteria:

1. Continuous current rating as per section 3 of AS 3008.
2. Limitation of voltage drop as per section 4 of AS 3008.
3. Short circuit performance as per section 5 of AS 3008.
4. Earth loop impedance as per appendix B of AS 3000.

Residual current devices (RCDs) shall not be installed for streetlight final subcircuits, in accordance with AS3000 2.6.3.2.1 exception 5 and Ipswich City Council risk assessment.

Select overcurrent/short circuit protective devices in accordance with as3000 to suit electrical load, prospective short circuit current and earth fault loop impedance.

Any changes in direction of conduit shall use a sweeping bend.

Provide pits for reticulation of electrical services as necessary. Pits shall be provided adjacent to poles to provide cable tee-off joints and at junctions and where conduit reticulation change direction. Generally, space the pits at maximum 50m intervals in local roads. This spacing may be greater in outer urban or rural subdivisions. Provide pit drainage to stormwater system or where not practicable to rubble pits.

**ELECTRICAL ENERGISATION REQUIREMENTS**

The Ipswich City Council as of July 2017 uses the Stanwell Corporation as the electricity retailer. Queries regarding connection of street light should be directed to the following email address:

Rate3StreetLights@ipswich.qld.gov.au

**PROJECT DESIGN REQUIREMENTS**

4.5m outreach arms size shall not be used for minor road installation. 4.5m outreach arms shall be permitted for major road lighting installation.

Where a project is to be constructed in more than one stage then the same style of equipment must be installed across all stages of the same project.

Where a project has been constructed then the same style of equipment must be installed across all subsequent stages of the same constructed project.

In urban developments, each street light shall be supplied directly from the nearest energex point of supply (i.e. LV pillar) unless approved by ICC. Multiple street lights fed from one supply will only be considered where there are no LV pillars. The number of street lights connected to a point of supply shall be determined by the designer based on the unique installation conditions that may be present.

ICC preference for developments with large frontages and significant distance between service pillar & streetlight locations is to supply multiple street lights from a main switchboard. Where an ICC MSB is utilized, a No.4 cable pit (with junction box, unfused) shall be located within 3mtrs of the base of each streetlight. Pits shall be aligned 125mm from property alignment (to ensure footpaths are not impacted).

HD conduits to be aligned at 870mm from property alignment. A maximum of 3 x 90 degree large radius sweep bends shall be used.

Provide durable and clearly visible permanently fixed weather proof Energex label to all rate 3 streetlights. Label shall be green back with white lettering "ICC3" to indicate a rate 3 Ipswich City Council site. Label shall be affixed on the light pole above the Energex site ID label. Refer Energex Public Lighting Manual for ID location.

Provide durable trafficolyte label inside pole access hatch with words to the effect of: "WARNING RCD PROTECTION NOT INSTALLED".

Provide durable Energex type weather resistant permanently fixed 50mm high label to all ICC MSBs. Label shall be green back with white lettering with the MSB asset number, e.g. "ICC MSB XXXXXXXX" where XXXXXXXX is the service pillar supplying the MSB. Confirm asset numbering with ICC prior to installation.

Lighting supplied directly from the overhead network shall remain Rate 2.

**PROJECT DOCUMENTATION REQUIREMENTS**

Update all project documentation to be accurate and up to date for the as built installation.

All street light project documentation shall be provided in an agreed electronic format. The agreed electronic format shall allow the electronic transfer of all geospatial and all database information to the Ipswich City Council.

The unmetered rate 3 street light information shall also be made available to the distribution network service provider.

Provide full tabulated equipment schedules for streetlights, cables and equipment for the project.

All project documentation shall reference the following:

- ICC Public Lighting Standard Drawings (SL series)
- ICC Planning Scheme Policy
- Energex Public Lighting: Standard Conditions for Public Lighting Services
- Qld Public Lighting Design Manual (RED00767)
- Qld Public Lighting Construction Manual (RED00796)
- AS/NZS3000 Wiring Rules
- AS/NZS1158 Lighting for Roads & Public Spaces
- Manufacturer's installation requirements

Completion of the construction certificate for streetlights is required for the Ipswich City Council.

**ENERGEX NOTES**

1. Green "3" and "W" Site Identification Numbers (stickers), as per Energex drawings 1-3-6.1 and 1-3-62.2 for the Rate 3 Streetlight Poles, will be allocated upon written request to Energex. Please contact the Energex Subdivision and Street Lighting Department to arrange for collection of the stickers. Please email a request to [subdivision@energex.com.au](mailto:subdivision@energex.com.au)
2. An EWR is required for each Rate 3 supply point to advise Energex that the project is ready for connection to supply or alteration to a Point of Supply. The Rate 3 lighting shall not be connected to supply by the electrical contractor.
3. The Electrical contractor shall forward a full set of "As Constructed" drawings (signed & dated by the Electrical Contractor) to Energex's Subdivision & Streetlight Department when construction of the Rate 3 installation is completed. A copy of these "As Constructed" drawings is required to be located onsite in each switchboard for collection by Energex or the Rate 3 Installation will not be connected to supply.
4. Energex will commence billing for all the Rate 3 lights, shown on the works plan as connected to the switchboard, from the date that the switchboard is connected to supply.

**APPROVED FOR CONSTRUCTION**

DRAWING INDEX	
A191623-1	ELECTRICAL RETICULATION SITE PLAN
A191623-2	SCHEDULES
A191623-3	ELECTRICAL SCHEMATICS & LABELS
R191623-1	RATE 3 STREETLIGHTING - SITE PLAN
R191623-2	RATE 3 STREETLIGHTING - NOTES
T191623-1	TELECOMMUNICATION CABLE PROVISIONING SHEET 1



This document is the property of Ampflo Pty Ltd and may only be used for the purpose for which it was commissioned. Unauthorised use is prohibited.

ISSUE	REVISION	BY	DATE	NOTES
A	Initial Design	av	18.12.18	This Works Plan is to be constructed in compliance with Energex documents:
B	Streetlights relocated due to new civls	av	08.11.19	• Overhead Construction Manual
C	Amendments as per ICC	av	21.01.20	• Underground Distribution Construction Manual
				• Public Lighting Construction Manual
				• Network Labelling and Signage Manual
				The Construction Contractor is to manage this project and submit 'As Constructed' drawings and the Certificate of Completion to Energex.
				<b>CROSS ROAD CONDUITS</b>
				Unless specified the Civil Contractor will install all cross road conduits.

**EARTHING**  
 Earthing is to be carried out in accordance with Energex requirements.

**TELECOMMUNICATION INSTALLATION**  
 Telecommunication conduits to be laid in shared trenches with electricity conduits. The Civil Electrical Construction Contractor is to notify the Telstra Contractor one week prior to installation of cross road conduits and two days prior to installation of footpath conduits for Telstra Pit and Pipe designs.

**FIRE ANTS**  
 The Construction Contractor is to confirm if this work site is within a Fire Ant Restricted Area. For work sites within a Fire Ant Restricted area the Contractor must comply with a DPI Approved Risk Management Plan.

**UNDERGROUND SERVICES IDENTIFICATION**

WORK CREWS TO CONFIRM LOCATION OF ALL EXISTING SERVICES PRIOR TO EXCAVATION - ANY SERVICES SHOWN ARE INDICATIVE ONLY

ALIGNMENTS	
ENERGEX OH	N/A
ENERGEX UG	0 - 0.9m
STREET LIGHTS	0.85 & 0.95 OK
DESIGNED	A. Vihnal
CHECKED	C. Radu
DATE	December 2018

APPROVED ON BEHALF OF AMPFLO PTY LTD

*[Signature]*  
 Cornel Radu  
 RPEQ 17404  
 2019.10.24 15:01:49 +10'00'

SCALE  
 1 : 750 (A1)

Do not scale from this drawing - use only the dimensions provided

COUNCIL REFERENCE	
IPSWICH CITY COUNCIL:	4280/2015/ICA
CIVIL ENGINEER	Peak Urban Ph. 5413 5300
SURVEYOR	SAUNDERS HAVILL GROUP 1300 123 744

**ampflo**  
 ABN 28 111 423 842  
 Electrical and Telecommunications Consultants  
 07 3372 9280 · projects@ampflo.com.au  
 ampflo.com.au

PROJECT  
**WOODLINKS VILLAGE - STAGE 16**  
 246 COLLINGWOOD DR, COLLINGWOOD PARK 4301  
 Lots 448 - 489 ( 42 lots) & 5007  
 Cancelling Lot 5007 on SP307776

CLIENT  
**Canberra Estates Consortium No 36 Pty Ltd**