

WOODLINKS VILLAGE - STAGE 9A

COLLINGWOOD DRIVE, COLLINGWOOD PARK

FOR 'CANBERRA ESTATES CONSORTIUM NO.36 PTY LIMITED'

DRAWING LIST


18-0175-100 COVER PLAN

EARTHWORKS, ROADWORKS AND DRAINAGE

- 18-0175-101 GENERAL NOTES
- 18-0175-102 BULK EARTHWORKS LAYOUT PLAN SHEET 1 OF 2
- 18-0175-103 BULK EARTHWORKS LAYOUT PLAN SHEET 2 OF 2
- 18-0175-104 BULK EARTHWORKS SECTIONS SHEET 1 OF 2
- 18-0175-105 BULK EARTHWORKS SECTIONS SHEET 2 OF 2
- 18-0175-106 ROADWORKS AND DRAINAGE LAYOUT PLAN
- 18-0175-107 SURVEY SETOUT AND KERB TYPES LAYOUT PLAN
- 18-0175-108 ROAD 06 LONGITUDINAL AND CROSS SECTIONS
- 18-0175-109 ROAD 11 LONGITUDINAL AND CROSS SECTIONS
- 18-0175-110 ROAD 11 CROSS SECTIONS
- 18-0175-111 ROAD 12 LONGITUDINAL AND CROSS SECTIONS
- 18-0175-112 INTERSECTION DETAILS LAYOUT PLAN
- 18-0175-113 SIGNS AND LINEMARKING LAYOUT PLAN
- 18-0175-114 STORMWATER DRAINAGE CATCHMENT LAYOUT PLAN
- 18-0175-115 STORMWATER DRAINAGE LONGITUDINAL SECTIONS SHEET 1 OF 2
- 18-0175-116 STORMWATER DRAINAGE LONGITUDINAL SECTIONS SHEET 2 OF 2
- 18-0175-117 STORMWATER DRAINAGE CALCULATIONS TABLE SHEET 1 OF 2
- 18-0175-118 STORMWATER DRAINAGE CALCULATIONS TABLE SHEET 2 OF 2
- 18-0175-119 CULVERT DETAILS LAYOUT PLAN

SEWERAGE AND WATER RETICULATION

- 18-0175-300 SEWERAGE COVER PLAN
- 18-0175-301 SEWERAGE LAYOUT PLAN
- 18-0175-302 SEWERAGE LONGITUDINAL SECTIONS SHEET 1 OF 2
- 18-0175-303 SEWERAGE LONGITUDINAL SECTIONS SHEET 2 OF 2
- 18-0175-304 WATER RETICULATION COVER PLAN
- 18-0175-305 WATER RETICULATION LAYOUT PLAN

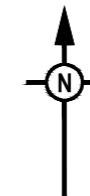

PROJECT INFORMATION SUMMARY:	
No. OF LOTS =	19
AREA OF SITE =	2.75 ha
RP DESCRIPTION	LOT 1 ON SP 266990
DATUM LEVEL AND LOCATION	P.M. 110122 RL 40.320 AHD
LOCAL AUTHORITY:	IPSWICH CITY COUNCIL
COUNCIL REFERENCE NUMBER:	2558/2014/MAMC/C

NOTE:
THESE DRAWINGS ARE TO BE READ IN CONJUNCTION WITH:
- VEGETATION MANAGEMENT PLAN
- LANDSCAPE ARCHITECT'S PLANS
- ELECTRICAL, COMMUNICATIONS AND GAS CONSULTANT'S PLANS
- SEDIMENT AND EROSION HAZARD ASSESSMENT
- SAFETY IN DESIGN REPORT

AS-CONSTRUCTED CERTIFICATION
 Signature: *S. Thomas* Date: 04.01.21
 SCOTT THOMAS RPEQ No. 04618
 For and on behalf of Peakurban PTY LTD

LOCALITY PLAN
 SCALE 1:2500 (A1)
 SCALE 1:5000 (A3)

REV	DATE	DESIGN	DRAWN	REVISION DETAILS	DRAWN	STATUS	SCALE	CLIENT	PROJECT NAME	DRAWING TITLE							
A	29.07.20	AC	JW	ISSUED FOR CONSTRUCTION		AS CONSTRUCTED	1:2500 50 0 50 100 A1 1:5000	CANBERRA ESTATES CONSORTIUM NO.36 PTY LIMITED <small>ASSOCIATED CONSULTANT SAUNDERS HAVILL GROUP 1300 123 744</small>	WOODLINKS STAGE 9A <small>COLLINGWOOD DRIVE, COLLINGWOOD PARK</small>	COVER PLAN							
B	29.09.20	AC	SC	ROAD 8 CUTBACK, DRAINAGE LINE UPDATED & STAGE NAME CHANGED	DESIGN						APPROVED						
C	04.01.21	TD	JW	AS CONSTRUCTED	APPROVED						SCOTT THOMAS RPEQ 04618						
FOR AND ON BEHALF OF PEAKURBAN PTY LTD							ENQUIRIES@PEAKURBAN.COM.AU		<table border="1" style="width: 100%; border-collapse: collapse;"> <tr> <td>PROJECT No.</td> <td>DRAWING No.</td> <td>REVISION</td> </tr> <tr> <td style="text-align: center;">18-0175</td> <td style="text-align: center;">100</td> <td style="text-align: center;">C</td> </tr> </table>			PROJECT No.	DRAWING No.	REVISION	18-0175	100	C
PROJECT No.	DRAWING No.	REVISION															
18-0175	100	C															

GENERAL NOTES:

1. THE CONTRACTOR SHALL SUPPLY ALL LABOR, MATERIALS, PLANT AND EQUIPMENT TO CONSTRUCT THE WORKS AS DOCUMENTED AND STRICTLY IN ACCORDANCE WITH THE RELEVANT AUTHORITY STANDARDS, SPECIFICATIONS AND REQUIREMENTS.
2. THE EXISTING SERVICES THAT ARE SHOWN ON THE DRAWINGS ARE PROVIDED FOR INFORMATION PURPOSES ONLY. NO RESPONSIBILITY IS TAKEN BY THE SUPERINTENDENT OR THE PRINCIPAL FOR INFORMATION THAT HAS BEEN SUPPLIED BY OTHERS, OR ANY EXISTING SERVICES THAT MAY BE PRESENT NOT SHOWN ON THE DRAWINGS. THE CONTRACTOR SHALL VERIFY THE POSITION OF ANY UNDERGROUND SERVICES WITHIN THE AREAS OF WORKS AND SHALL BE RESPONSIBLE FOR MAKING GOOD ANY DAMAGE THERETO. ANY ALTERATION WORKS TO SERVICES WILL BE CARRIED OUT ONLY BY THE SERVICE OWNER AUTHORITY UNLESS APPROVED OTHERWISE.
3. ALL CONSTRUCTION ACTIVITIES UNDERTAKEN SHALL COMPLY WITH CURRENT WORKPLACE HEALTH AND SAFETY REQUIREMENTS AND LEGISLATION.
4. PRIOR TO COMMENCING WORK, THE CONTRACTOR IS RESPONSIBLE FOR OBTAINING ALL RELEVANT LOCAL AUTHORITY PERMITS.
5. THE CONTRACTOR SHALL NOT COMMENCE THE DEMOLITION OF ANY EXISTING BUILDINGS AND/OR STRUCTURES WITHOUT APPROVAL FROM THE SUPERINTENDENT.
6. THE CONTRACTOR SHALL APPLY INDUSTRY BEST PRACTICE SO WORKS SHALL NOT DISTURB OR AFFECT NEARBY RESIDENTS EITHER BY DUST, NOISE, FLOODING OR DISCONNECTION OF SERVICES. CONTRACTOR TO ENSURE THAT ACCESS AND SERVICES TO EXISTING PROPERTIES ARE AVAILABLE AT ALL TIMES.
7. THE CONTRACTOR SHALL VERIFY LEVELS OF EXISTING SERVICE CROSSINGS AND CONNECTION POINTS PRIOR TO COMMENCEMENT OF WORKS AND NOTIFY SUPERINTENDENT OF ANY DISCREPANCIES BETWEEN ACTUAL AND PROPOSED DESIGN LEVELS.
8. THESE ENGINEERING DRAWINGS ARE TO BE READ IN CONJUNCTION WITH THE APPROVED VEGETATION MANAGEMENT PLAN, WHERE APPLICABLE. WHEN IN DOUBT, ALL EXISTING TREES ARE TO REMAIN UNLESS DIRECTED OTHERWISE.
9. **HOLD POINT:** ONCE THE BASE OF MANHOLES, INSPECTION PITS, GULLIES AND FIELD INLETS FOR STORMWATER DRAINAGE AND SEWER RETICULATION HAVE BEEN POURED, CONSTRUCTION SHALL ONLY RE-COMMENCE ONCE THE SUPERINTENDENT AND/OR ENGINEER HAVE INSPECTED THE WORKS.
10. THE CONTRACTOR SHALL NOTE DURING THE COURSE OF THE WORKS WHEN JOINT INSPECTIONS WITH THE AUTHORITY AND THE SUPERINTENDENT ARE REQUIRED. THESE INCLUDE PRE-STARTS, SUBGRADES, PRE-SEALS, CLEARING, AND OTHER SUCH INSPECTIONS AS NOMINATED IN THE APPROVAL AND THE SPECIFICATIONS. THE CONTRACTOR SHALL ENSURE NO WORKS PROCEED PAST THE INSPECTION POINT UNTIL THE JOINT INSPECTION HAS BEEN SUCCESSFULLY COMPLETED.
11. THE CONTRACTOR SHALL BE RESPONSIBLE FOR PROVIDING A SAFE MOVEMENT OF TRAFFIC AND THE PROTECTION OF PERSON AND PROPERTY THROUGH AND AROUND THE SITE. THE CONTRACTOR IS RESPONSIBLE FOR ALL TRAFFIC MANAGEMENT INCLUDING THE DESIGN, CONSTRUCTION, MAINTENANCE AND REMOVAL OF TEMPORARY ROADWAYS, DETOURS, SIGNS, LIGHTS AND BARRIER AS REQUIRED STRICTLY IN ACCORDANCE WITH THE RELEVANT AUTHORITY REQUIREMENTS.

BULK EARTHWORKS NOTES

1. NOTWITHSTANDING THE EXTENTS OF CUTTING AND FILLING SHOWN ON DRAWINGS, THE SUPERINTENDENT RESERVES THE RIGHT TO ADJUST THE FINISHED SURFACE LEVELS AND EARTHWORKS EXTENTS THROUGH WRITTEN DIRECTION.
2. THE CONTRACTOR SHALL UNDERTAKE ALL CLEARING USING INDUSTRY BEST PRACTICE INCLUDING CONSIDERATION OF FAUNA RELOCATION.
3. THE CONTRACTOR SHALL UNDERTAKE ALL EARTHWORKS IN ACCORDANCE WITH AS3798-2007 AND LOCAL AUTHORITY REQUIREMENTS. LEVEL 1 SUPERVISION IS REQUIRED.
4. THE CONTRACTOR SHALL CONSIDER LOADS GENERATED BY THE EARTHWORKS OPERATIONS SO AS TO AVOID DAMAGE TO ALL PIPES, SERVICES AND STRUCTURES.
5. THE EARTHWORKS DRAWINGS ARE TO BE READ IN CONJUNCTION WITH THE PROJECT'S SEDIMENT AND EROSION CONTROL PLAN, WHERE APPLICABLE.
6. THE CONTRACTOR SHALL BE RESPONSIBLE FOR THE PLANNING, DESIGN, CERTIFICATION, IMPLEMENTATION AND MAINTENANCE OF AN EROSION AND SEDIMENT CONTROL PLAN THAT IS COMPLIANT WITH THE INTERNATIONAL EROSION CONTROL ASSOCIATION (IECA) GUIDELINE 'BEST PRACTICE EROSION AND SEDIMENT CONTROL' AND RELEVANT COUNCIL POLICIES.

ROADWORKS AND DRAINAGE NOTES

1. ALL WORKS SHALL BE IN ACCORDANCE WITH THE RELEVANT AUTHORITY'S STANDARD DRAWINGS, METHODS AND SPECIFICATIONS.
2. NOTWITHSTANDING THE EXTENTS OF CUTTING AND FILLING SHOWN ON DRAWINGS, THE SUPERINTENDENT RESERVES THE RIGHT TO ADJUST THE FINISHED SURFACE LEVELS AND EARTHWORKS EXTENTS THROUGH WRITTEN DIRECTION.
3. NEW CONSTRUCTION SHALL BE NEATLY JOINED TO EXISTING FORMATION. WHERE REQUIRED, THE EXISTING FORMATION SHALL BE SAW CUT IN ACCORDANCE WITH IPWEAQ STD DRG RS-170. LEVELS AND GRADIENTS AT CONNECTIONS WITH EXISTING WORKS MAY BE VARIED AS REQUIRED TO ACHIEVE A SMOOTH CONNECTION.
4. THE CONTRACTOR SHALL UNDERTAKE ALL EARTHWORKS IN ACCORDANCE WITH AS3798-2007 AND LOCAL AUTHORITY REQUIREMENTS. LEVEL 1 SUPERVISION IS REQUIRED.
5. THE CONTRACTOR SHALL SUPPLY THE SUPERINTENDENT WITH THE SUBGRADE TEST RESULTS NECESSARY FOR ALL PAVEMENT DESIGN.
6. THE CONTRACTOR SHALL ENSURE A MINIMUM OF 75mm TOPSOIL TO ALL VERGE AND BATTER AREAS (AND STABILISATION AS ORDERED)
7. THE CONTRACTOR SHALL INSTALL ALL FOOTPATH AND PRAM RAMPS IN COMPLIANCE WITH THE AUTHORITY'S STANDARD DRAWINGS. PRAM RAMPS ARE TO BE LOCATED CLEAR OF DRAINAGE GULLY PITS AND FUTURE DRIVEWAY POSITIONS INDICATED ON THE LAYOUT PLANS.
8. THE CONTRACTOR SHALL INSTALL SUBSOIL DRAINS UNDER ALL KERBS AS REQUIRED BY THE LOCAL AUTHORITY'S STANDARDS.
9. THE CONTRACTOR SHALL ENSURE THAT ALL RETAINING WALL SUBSOIL DRAINS ARE TO CONNECT TO EITHER KERB ADAPTORS, KERB SUBSOIL DRAINS OR STORMWATER DRAINAGE STRUCTURES. CONTRACTOR TO DEMONSTRATE TO SUPERINTENDENT THAT SUITABLE CONNECTIONS HAVE BEEN PROVIDED FOR ALL WALLS.
10. ALL STORMWATER DRAINAGE MATERIALS, BEDDING, JOINTING AND STEP IRON REQUIREMENTS SHALL BE IN ACCORDANCE WITH THE RELEVANT AUTHORITY'S STANDARD DRAWINGS, METHODS AND SPECIFICATIONS.
11. THE STORMWATER PIPE CLASSES HAVE BEEN DESIGNED FOR SERVICE LOADS ONLY. THE CONTRACTOR SHALL ASSESS THE SUITABILITY OF MACHINERY USED ON SITE AND THE ANTICIPATED CONSTRUCTION LOADS, AND UPGRADE THE PIPE CLASSES IF NECESSARY IN ACCORDANCE WITH AS3725-2007.
12. THE TERM D₅₀ DOCUMENTED ON THE DRAWINGS, IN RELATION TO ROCK ARMORING, CORRESPONDS TO THE REQUIRED MEDIAN DIAMETER OF THE PLACED ROCKS. THE ROCKS USED SHALL NOT VARY IN SIZE BY +/- 30% OF THE PROPOSED D₅₀ SIZE.

ROOFWATER NOTES

1. THE GEOMETRIC CENTRE SHALL BE TAKEN AS THE SETOUT POINT FOR ALL STRUCTURES, UNLESS DETAILED OTHERWISE.
2. ROOFWATER ALIGNMENT, COVER, MATERIALS, BEDDING, JOINTING AND STEP IRON REQUIREMENTS SHALL BE IN ACCORDANCE WITH THE RELEVANT AUTHORITY'S STANDARD DRAWINGS, METHODS AND SPECIFICATIONS.
3. ALL PVC PIPES ARE TO BE MINIMUM CLASS SN8.
4. END CAPS SHALL BE INSTALLED ON ENDS OF ALL PIPES AND STUBS.
5. WHERE ROOFWATER PIPES ARE ALIGNED BEHIND PROPOSED RETAINING WALLS, THE CONTRACTOR IS TO REFER TO THE SPECIFIC PROJECT DESIGN DETAILS AND CONFIRM CLEARANCES WITH THE SUPERINTENDENT PRIOR TO LAYING OF THE PIPES.
6. PROPERTY CONNECTIONS SHALL BE 1500 DESIGNER TO SPECIFY UNLESS SHOWN OTHERWISE. THE CONTRACTOR SHALL EXTEND CONNECTIONS A MINIMUM OF 1.0m BEYOND ADJACENT SEWER LINES, WHERE APPLICABLE.
7. IN INSTANCES WHERE REAR ALLOTMENT DRAINAGE IS NOT PROVIDED, THE CONTRACTOR SHALL INSTALL A ROOFWATER CONNECTION TO EACH PROPERTY BY ONE OF THE FOLLOWING METHODS, AS SHOWN ON THE LAYOUT PLAN:
 - TWO ROOFWATER KERB ADAPTOR 500mm FROM THE DOWNSTREAM BOUNDARY (UNLESS SHOWN ON A DIFFERENT ALIGNMENT). WHERE THERE IS A CONCRETE FOOTPATH, A ROOFWATER PIPE SHALL BE INSTALLED FROM THE PROPERTY BOUNDARY CONNECTED TO THE KERB ADAPTOR AT 1.25% MINIMUM GRADE IN ACCORDANCE WITH COUNCIL'S STANDARDS.
 - ONE 1500 ROOFWATER PIPE CONNECTED TO PROPOSED STORMWATER GULLY PIT OR MANHOLE AT MINIMUM 1.0% GRADE WITH 1.0m COVER.

AS-CONSTRUCTED CERTIFICATION
 Signature: *Scott Thomas* Date: 04.01.21
 SCOTT THOMAS RPEQ No. 04618
 For and on behalf of Peakurban PTY LTD

REV	DATE	DESIGN	DRAWN	REVISION DETAILS	DRAWN	STATUS	SCALE	CLIENT	PROJECT NAME	DRAWING TITLE		
A	29.07.20	AC	JW	ISSUED FOR CONSTRUCTION				CANBERRA ESTATES CONSORTIUM NO.36 PTY LIMITED	WOODLINKS STAGE 9A	GENERAL NOTES		
B	29.09.20	AC	SC	ROAD 9 CUTBACK, DRAINAGE LINE UPDATED & STAGE NAME CHANGED								
C	04.01.21	TD	JW	AS CONSTRUCTED								
								ASSOCIATED CONSULTANT SAUNDERS HAVILL GROUP 1300 123 744	COLLINGWOOD DRIVE, COLLINGWOOD PARK	PROJECT No. 18-0175		
					DESIGN APPROVED SCOTT THOMAS	RPEQ 04618				DRAWING No. 101		
						FOR AND ON BEHALF OF PEAKURBAN PTY LTD	ENQUIRIES@PEAKURBAN.COM.AU			REVISION C		

NOTE:
CONTRACTOR TO INSTALL FENCE BRACKETS TO ALL SLEEPER RETAINING WALLS OTHER THAN THE LAST 3 POSTS ON SIDE BOUNDARIES TO LOTS 75 - 85.


NOTE:
REFER TO SURVEYORS AS CONSTRUCTED DRAWINGS PREPARED BY SAUNDERS HAVILL FOR EARTHWORKS LEVELS

WARNING! - EXISTING SERVICES
EXTREME CARE SHOULD BE TAKEN WHEN EXCAVATING IN THIS AREA. THE FOLLOWING EXISTING SERVICES ARE LIKELY TO BE PRESENT IN THE VICINITY OF THE SITE:

- ELECTRICAL CABLES
- TELECOMMUNICATIONS CABLES
- GAS MAINS
- WATER MAINS
- SEWER MAINS


THE CONTRACTOR SHOULD CONTACT THE SERVICE PROVIDER FOR FURTHER INFORMATION AND SATISFY THEMSELVES OF ANY SPECIFIC TREATMENT OR REQUIREMENTS.

AS-CONSTRUCTED CERTIFICATION
Signature: *S. Thomas* Date: 04.01.21
SCOTT THOMAS RPEQ No. 04618
For and on behalf of Peakurban PTY LTD

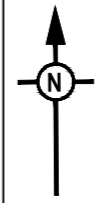

- LEGEND**
- PROPOSED AREA OF WORKS/STAGE BOUNDARY
 - PROPOSED SURFACE CONTOUR
 - EXISTING SURFACE CONTOUR
 - PROPOSED EARTHWORKS PAD SETBACK LINE
 - PROPOSED SLEEPER RETAINING WALL
 - FUTURE SLEEPER RETAINING WALL
 - EXISTING SLEEPER RETAINING WALL
 - PROPOSED FINISHED SURFACE LEVEL (FSL) (INCLUDES TOPSOIL PLACEMENT)
 - EXISTING SURFACE LEVEL
 - PROPOSED AREA OF CUT
 - PROPOSED AREA OF FILL
 - INDICATIVE DRIVEWAY LOCATIONS
 - ZERO LOT BOUNDARY
 - EXISTING STORMWATER DRAINAGE PIPE
 - EXISTING SEWERAGE MAIN
 - EXISTING WATER MAIN
 - EXISTING WATER CONDUIT
 - EXISTING ELECTRICAL CABLE U/G
 - EXISTING ELECTRICAL CABLE O/H
 - EXISTING GAS MAIN
 - EXISTING DRAIN
 - EXISTING TREE TO BE RETAINED - REFER VMP
 - EXISTING TREE TO BE REMOVED - REFER VMP

- AS CONSTRUCTED LEGEND**
- 80.00 FINISHED SURFACE LEVEL
 - CONCRETE SLEEPER RETAINING WALL

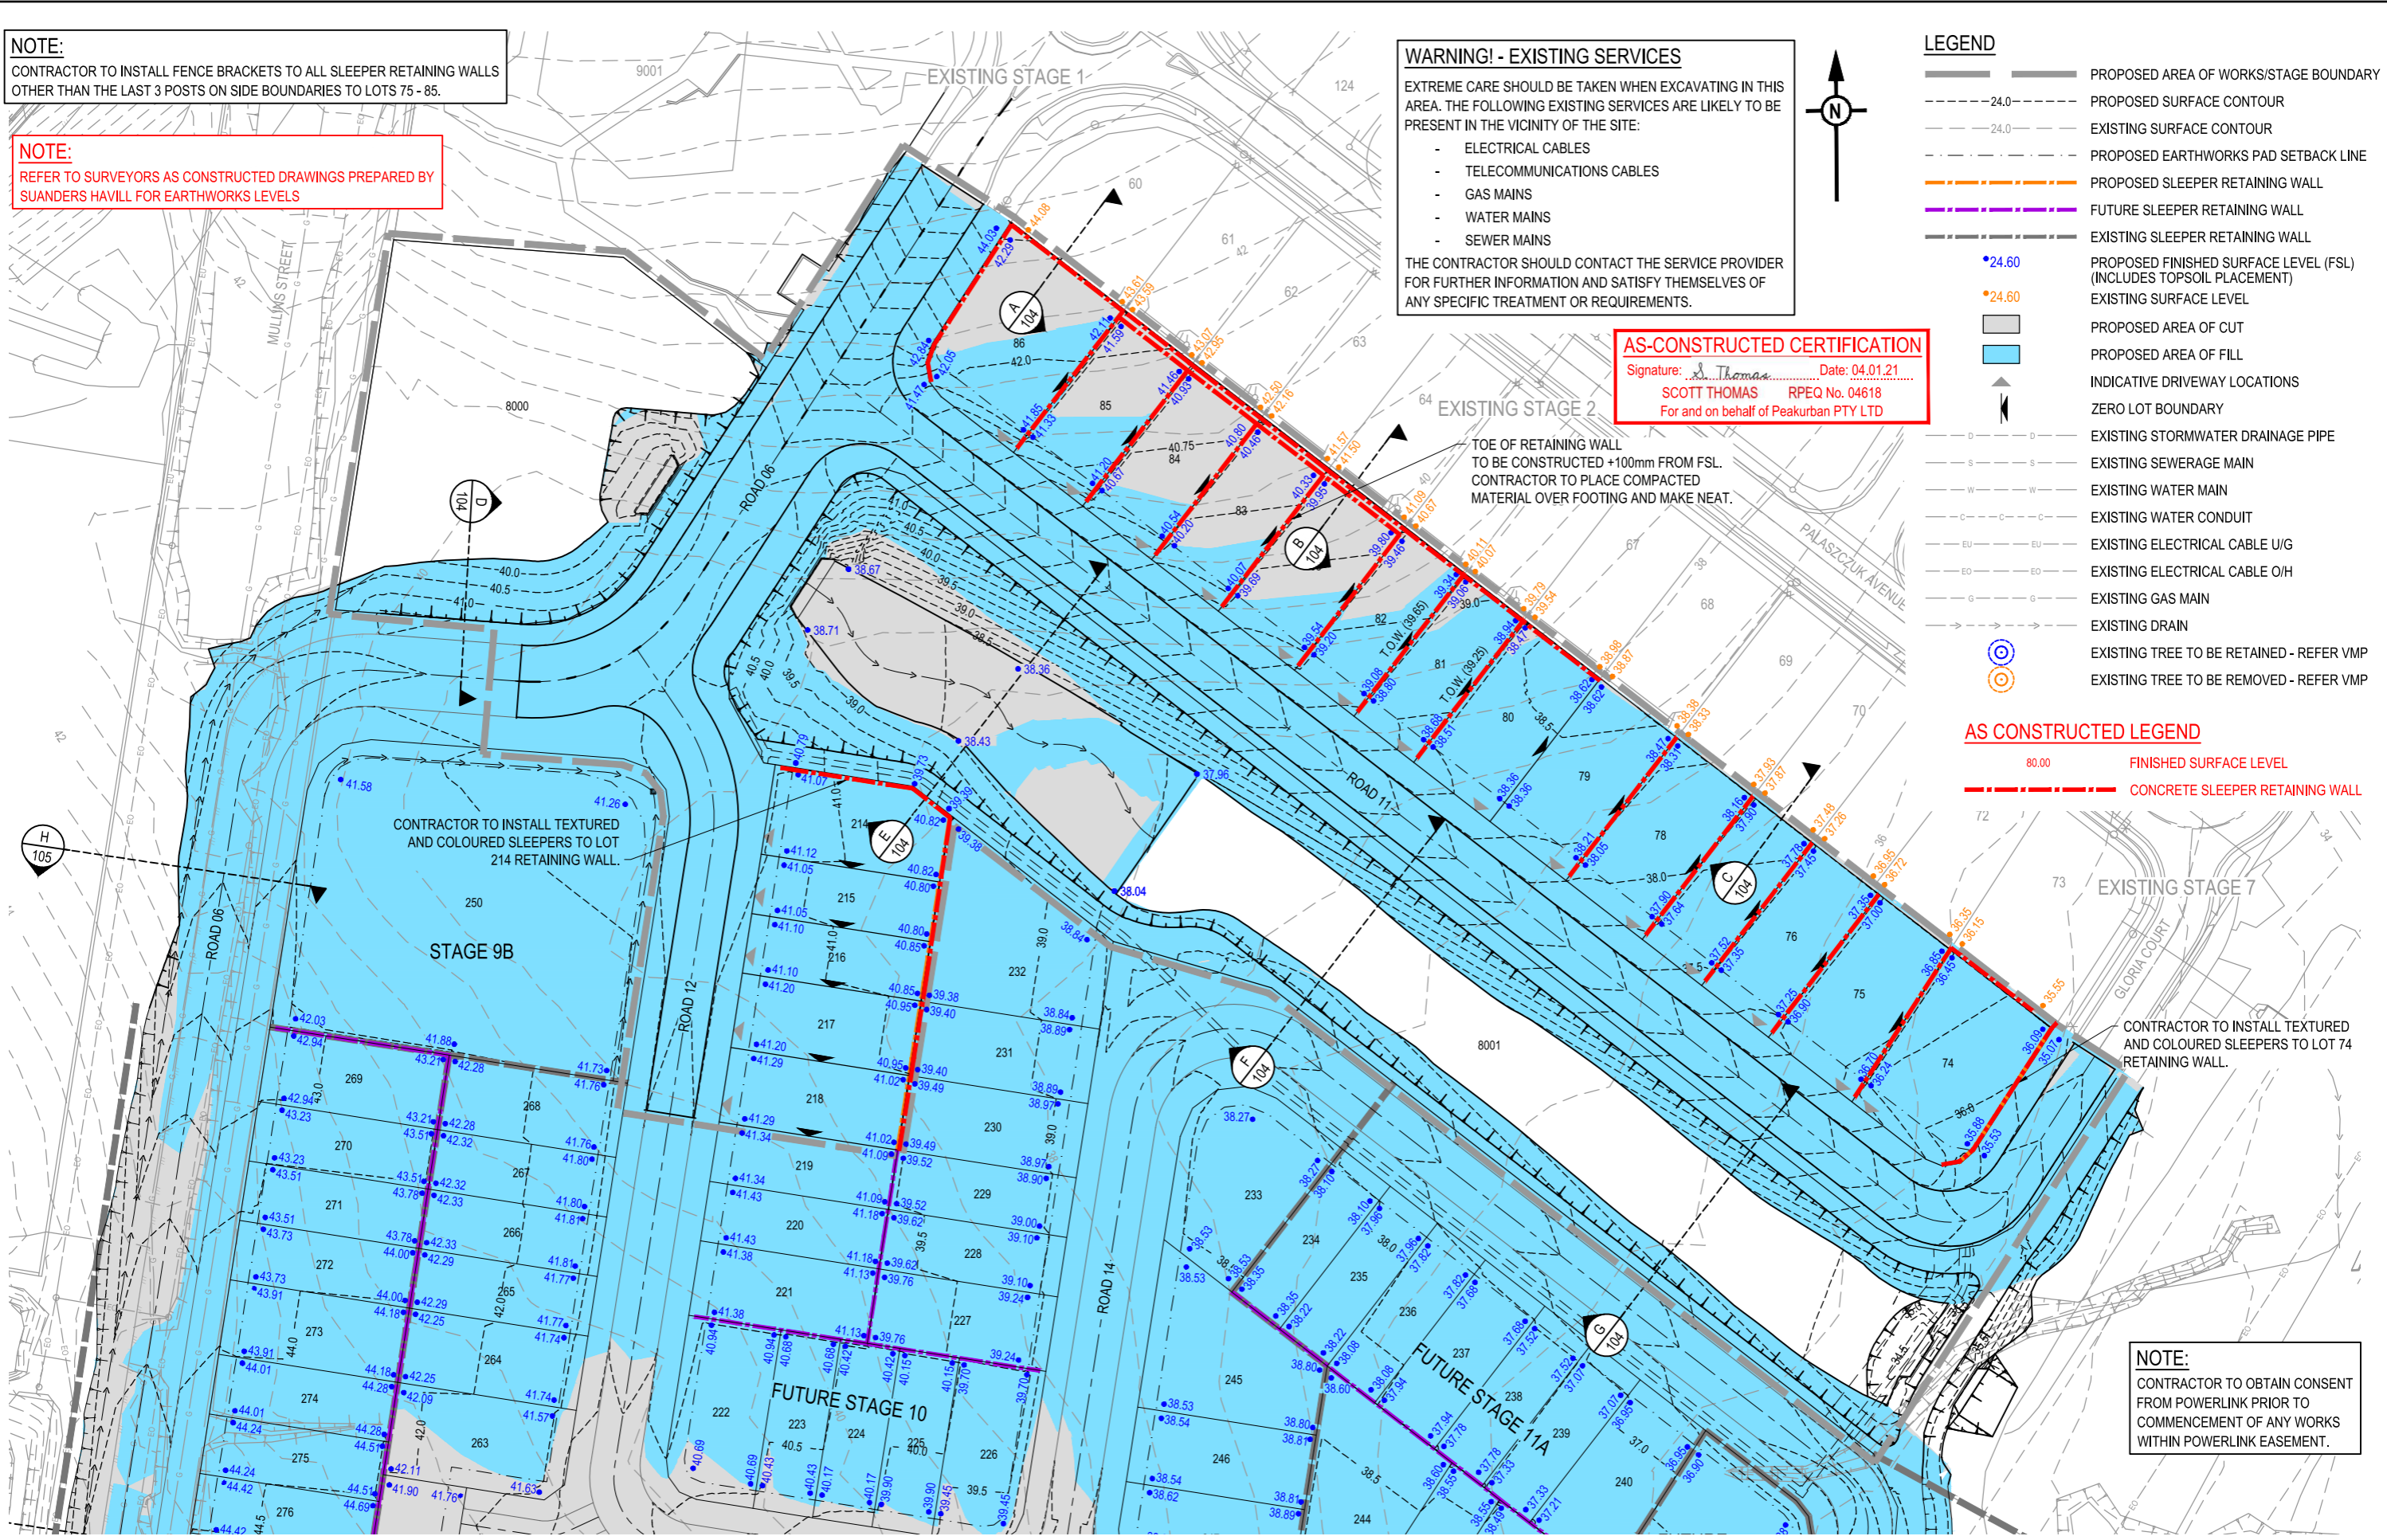

TOE OF RETAINING WALL TO BE CONSTRUCTED +100mm FROM FSL. CONTRACTOR TO PLACE COMPACTED MATERIAL OVER FOOTING AND MAKE NEAT.


CONTRACTOR TO INSTALL TEXTURED AND COLOURED SLEEPERS TO LOT 214 RETAINING WALL.

CONTRACTOR TO INSTALL TEXTURED AND COLOURED SLEEPERS TO LOT 74 RETAINING WALL.

NOTE:
CONTRACTOR TO OBTAIN CONSENT FROM POWERLINK PRIOR TO COMMENCEMENT OF ANY WORKS WITHIN POWERLINK EASEMENT.

REFER SHEET 2 FOR CONTINUATION

REV	DATE	DESIGN	DRAWN	ISSUED FOR CONSTRUCTION	REVISION DETAILS	DRAWN	STATUS	SCALE	CLIENT	PROJECT NAME	DRAWING TITLE	
A	29.07.20	AC	JW	ISSUED FOR CONSTRUCTION				1:500	CANBERRA ESTATES CONSORTIUM NO.36 PTY LIMITED	WOODLINKS STAGE 9A	BULK EARTHWORKS LAYOUT PLAN SHEET 1 OF 2	
B	04.09.20	MG	MG	T.O.W. LEVELS ADDED TO INTERALLOTMENT SIDE WALLS AND PAD LEVELS AMENDED				1:1000				
C	23.09.20	AC	SC	ROAD 6 CUTBACK, DRAINAGE LINE UPDATED & STAGE NAME CHANGED								
D	04.01.21	TD	JW	AS CONSTRUCTED								
				DESIGN	APPROVED	SCOTT THOMAS	RPEQ 04618	ASSOCIATED CONSULTANT SAUNDERS HAVILL GROUP 1300 123 744		COLLINGWOOD DRIVE, COLLINGWOOD PARK		
				FOR AND ON BEHALF OF PEAKURBAN PTY LTD				ENQUIRIES@PEAKURBAN.COM.AU		PROJECT No. 18-0175	DRAWING No. 102	REVISION D

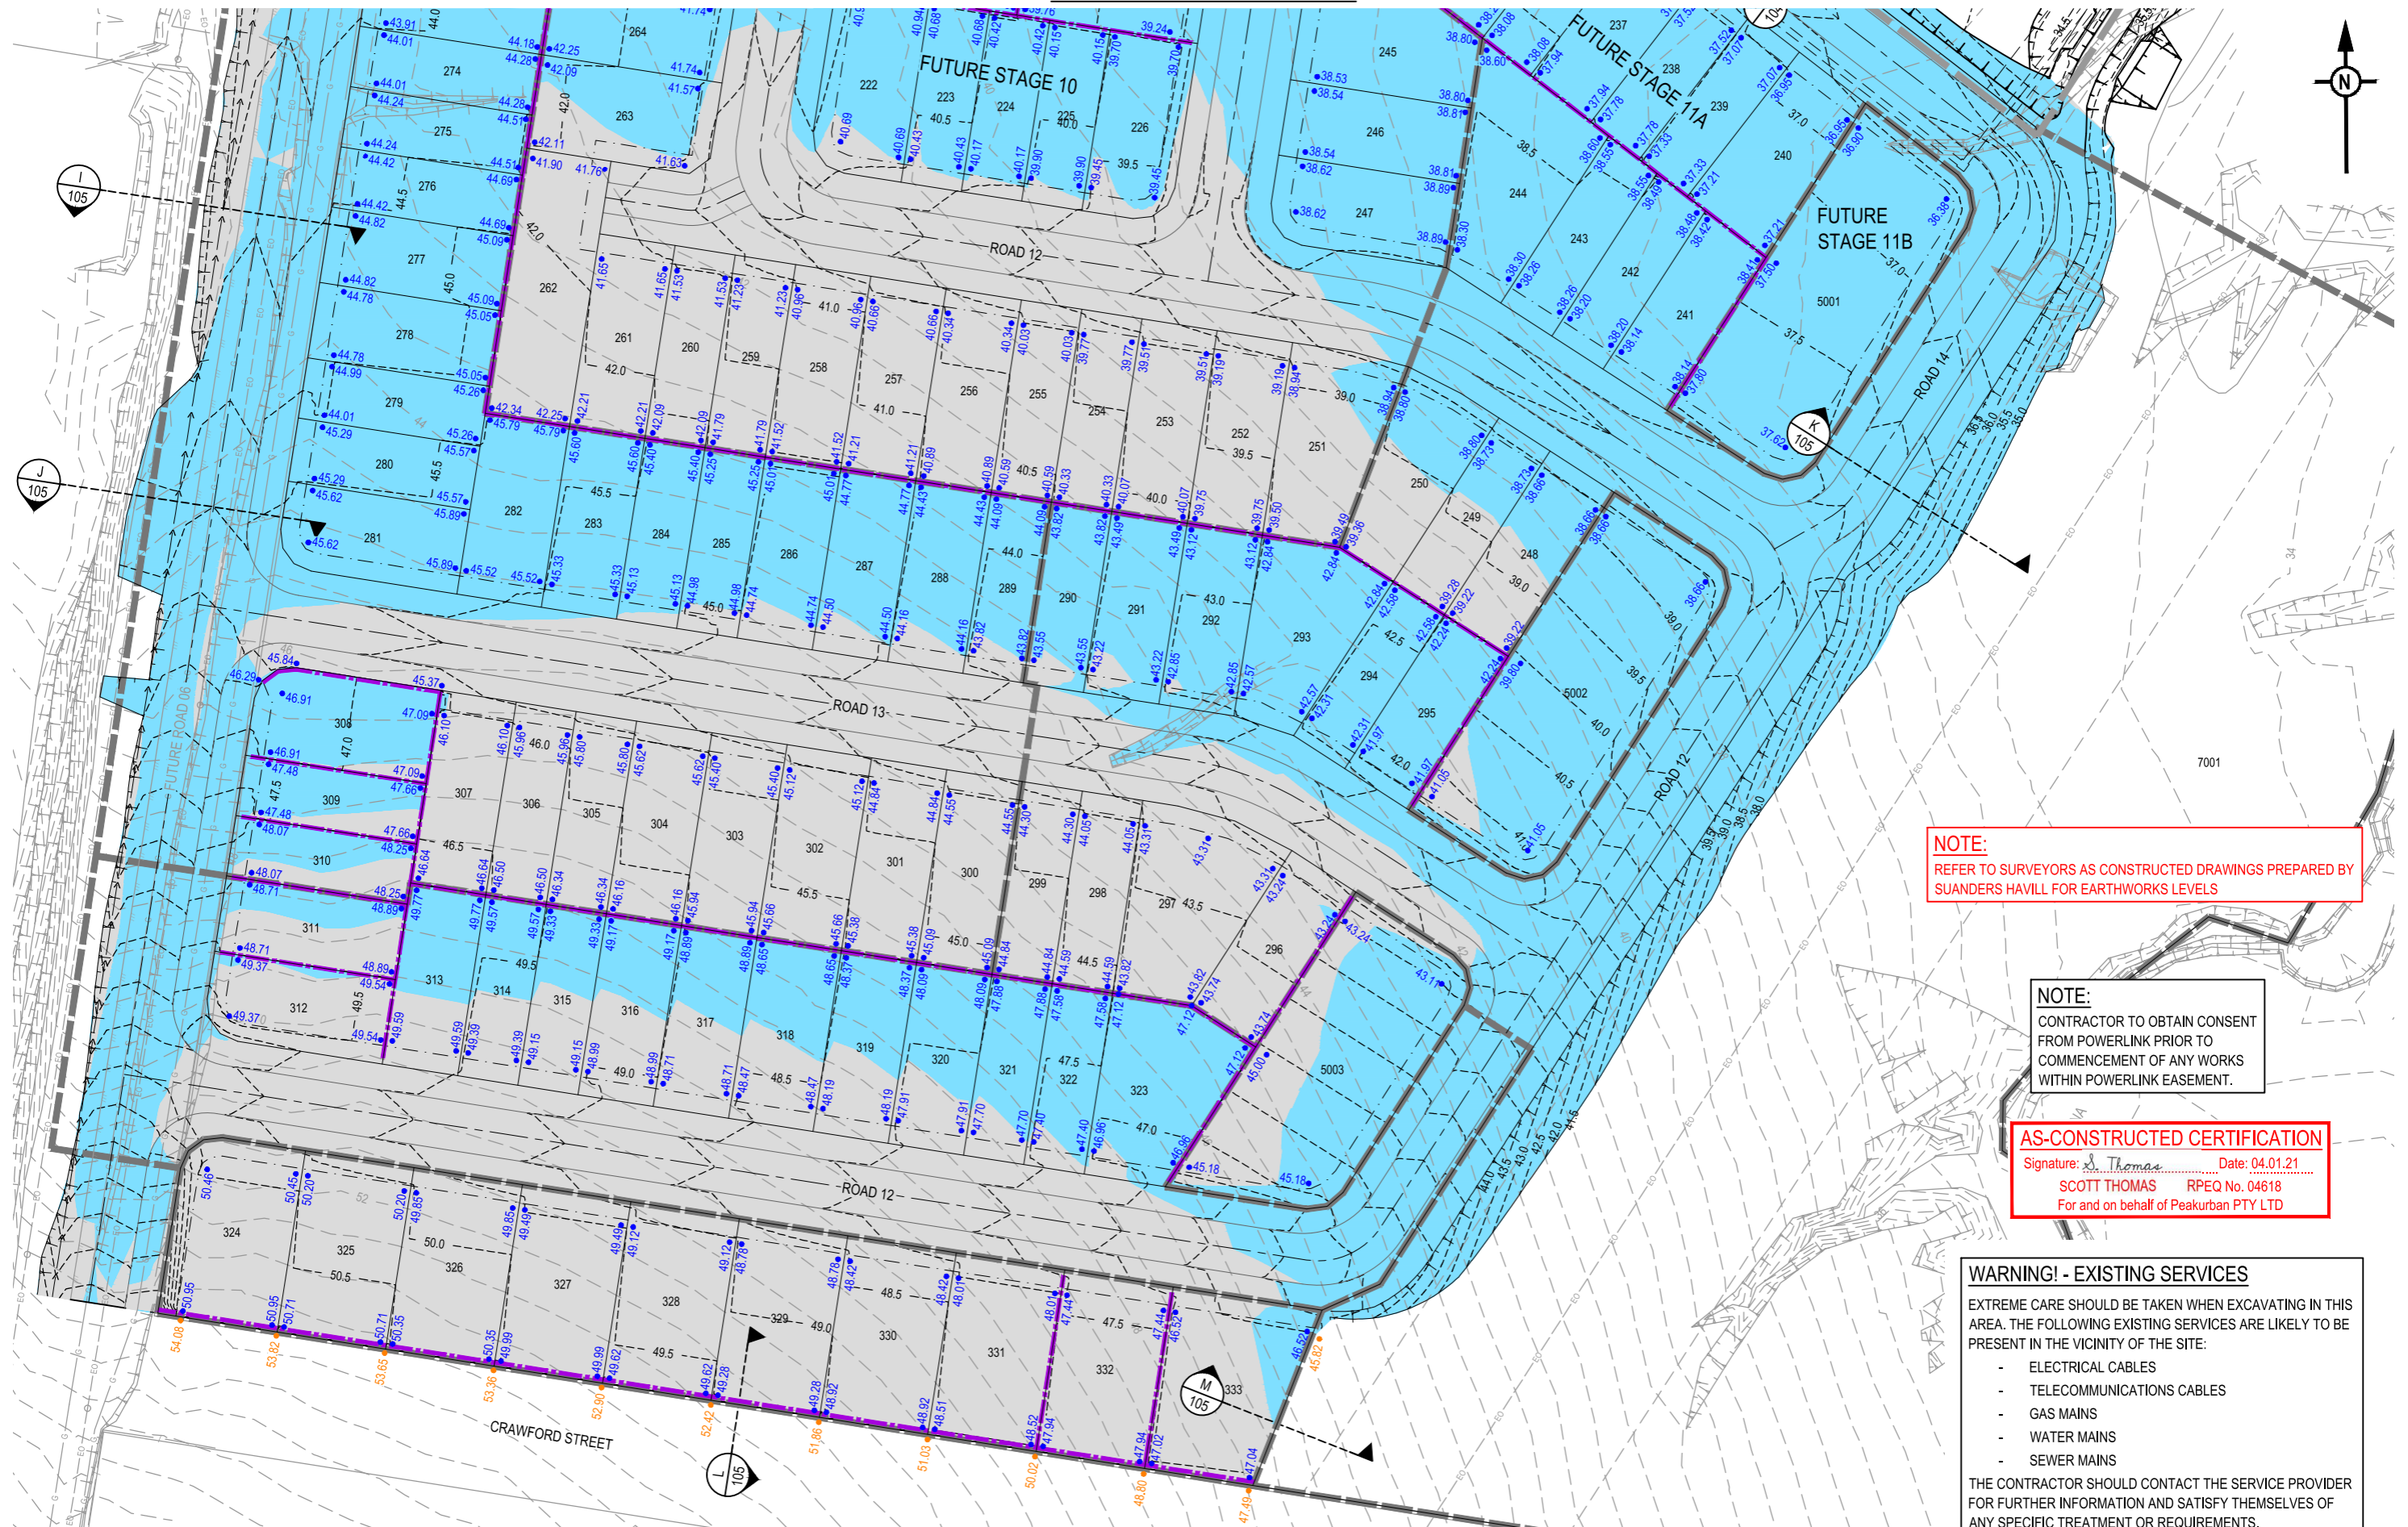

NOTE:
REFER TO SURVEYORS AS CONSTRUCTED DRAWINGS PREPARED BY SAUNDERS HAVILL FOR EARTHWORKS LEVELS

NOTE:
CONTRACTOR TO OBTAIN CONSENT FROM POWERLINK PRIOR TO COMMENCEMENT OF ANY WORKS WITHIN POWERLINK EASEMENT.

AS-CONSTRUCTED CERTIFICATION
Signature: *S. Thomas* Date: 04.01.21
SCOTT THOMAS RPEQ No. 04618
For and on behalf of Peakurban PTY LTD

WARNING! - EXISTING SERVICES
EXTREME CARE SHOULD BE TAKEN WHEN EXCAVATING IN THIS AREA. THE FOLLOWING EXISTING SERVICES ARE LIKELY TO BE PRESENT IN THE VICINITY OF THE SITE:

- ELECTRICAL CABLES
- TELECOMMUNICATIONS CABLES
- GAS MAINS
- WATER MAINS
- SEWER MAINS


THE CONTRACTOR SHOULD CONTACT THE SERVICE PROVIDER FOR FURTHER INFORMATION AND SATISFY THEMSELVES OF ANY SPECIFIC TREATMENT OR REQUIREMENTS.

REV	DATE	DESIGN	DRAWN	REVISION DETAILS
A	29.07.20	AC	JW	ISSUED FOR CONSTRUCTION
B	29.09.20	AC	SC	ROAD 6 CUTBACK, DRAINAGE LINE UPDATED & STAGE NAME CHANGED
C	04.01.21	TD	JW	AS CONSTRUCTED

AS CONSTRUCTED

DESIGN APPROVED
SCOTT THOMAS RPEQ 04618

FOR AND ON BEHALF OF PEAKURBAN PTY LTD

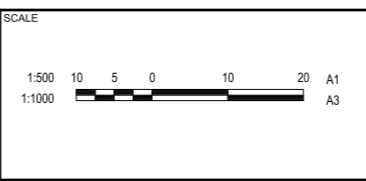


CLIENT
CANBERRA ESTATES CONSORTIUM NO.36 PTY LIMITED

ASSOCIATED CONSULTANT
SAUNDERS HAVILL GROUP
1300 123 744


PROJECT NAME
WOODLINKS STAGE 9A

COLLINGWOOD DRIVE,
COLLINGWOOD PARK


DRAWING TITLE		
BULK EARTHWORKS LAYOUT PLAN SHEET 2 OF 2		
PROJECT No.	DRAWING No.	REVISION
18-0175	103	C

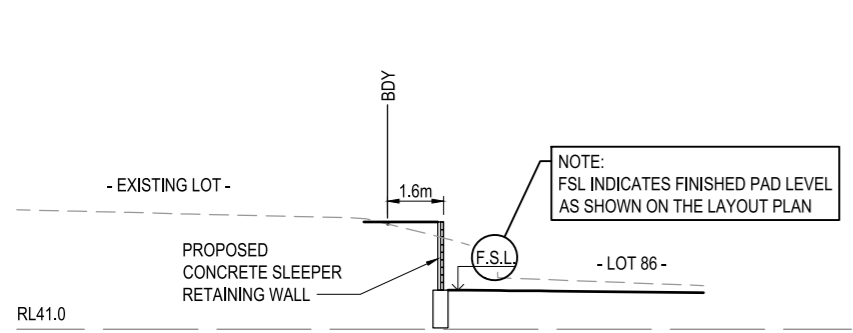


SECTION A
SCALE 1:100 (A1)
SCALE 1:200 (A3)

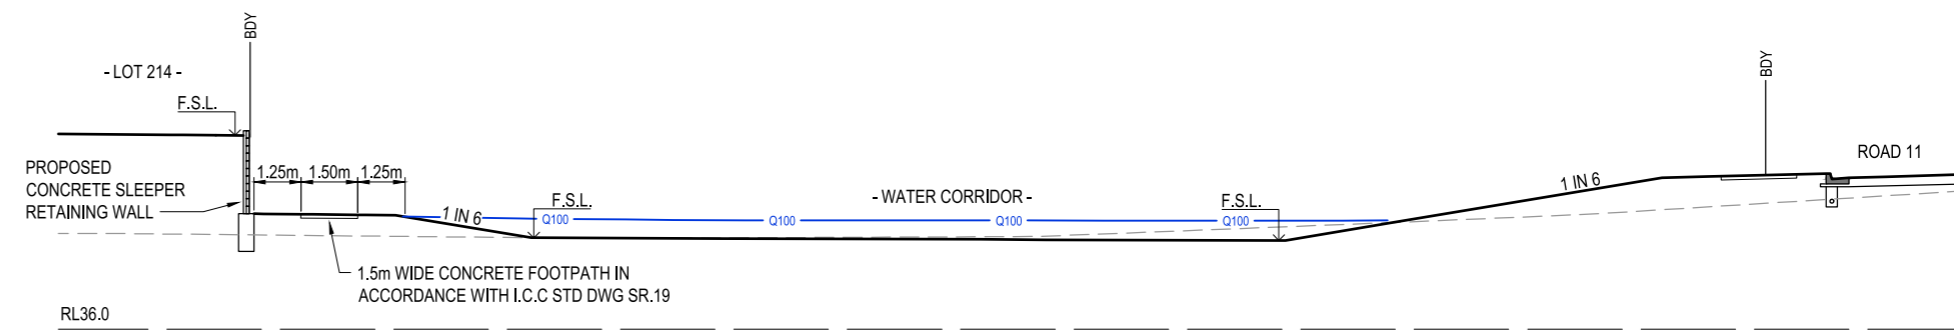


SECTION E
SCALE 1:100 (A1)
SCALE 1:200 (A3)

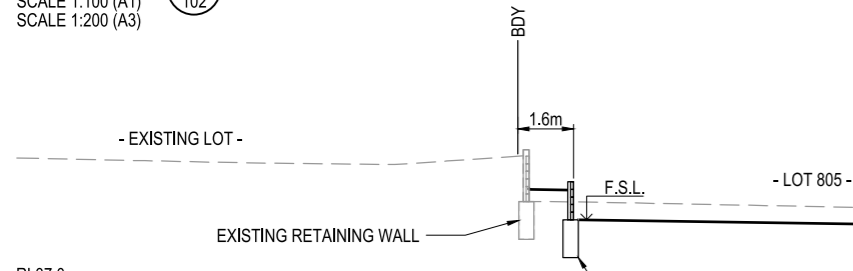


SECTION B
SCALE 1:100 (A1)
SCALE 1:200 (A3)

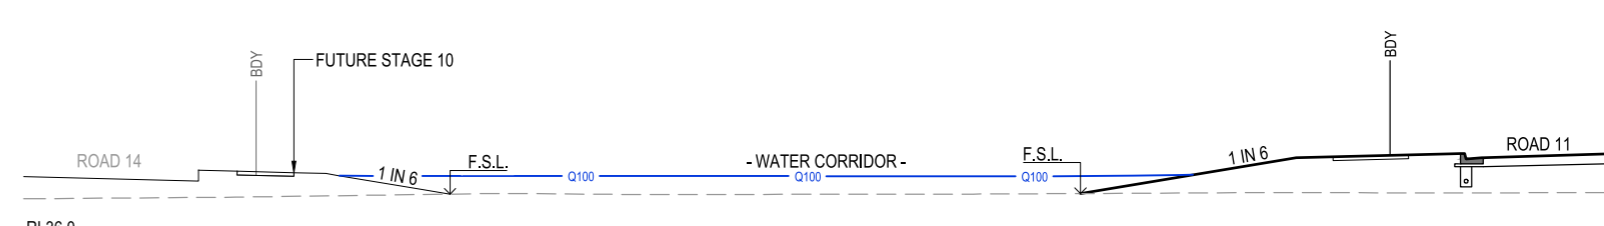

SECTION F
SCALE 1:100 (A1)
SCALE 1:200 (A3)

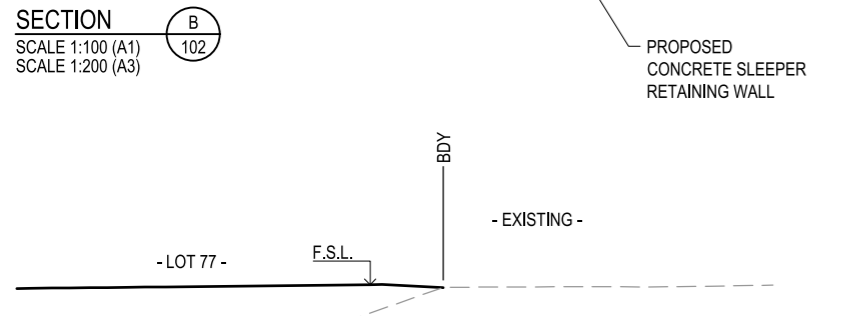


SECTION C
SCALE 1:100 (A1)
SCALE 1:200 (A3)

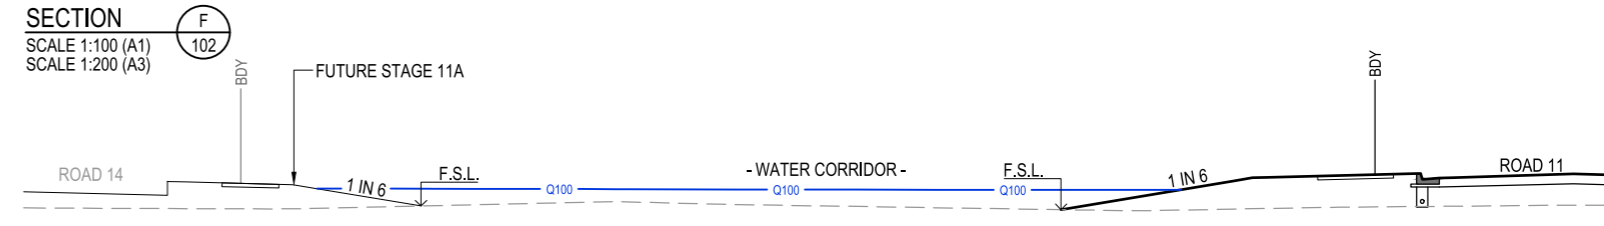


SECTION G
SCALE 1:100 (A1)
SCALE 1:200 (A3)


- RETAINING WALL NOTES:**
1. ALL RETAINING WALLS ARE TO BE STRUCTURALLY DESIGNED AND CERTIFIED. FORMS 15 AND 16 ARE TO BE PROVIDED.
 2. DESIGN OF WALLS TO CONSIDER ALL LOADS (FENCES, DWELLINGS ETC) AND ASSOCIATED IMPACTS FROM ANY ADJACENT SERVICES- FOOTING DEPTHS TO BE EXTENDED AS REQUIRED.
 3. GEOTECHNICAL CONDITIONS ARE TO BE CONFIRMED AND APPROPRIATELY CONSIDERED FOR ALL WALLS.
 3. REFER LANDSCAPE DRAWINGS FOR FURTHER INFORMATION ON RETAINING WALLS, PARTICULARLY RELATING TO FINISHES.
 4. TEMPORARY SAFETY FENCING TO BE INSTALLED BEHIND ALL WALLS 1.0m HIGH AND GREATER.
 5. WALLS TO BE DESIGNED TO ACCOMMODATE A SURCHARGE SUITABLE FOR A RESIDENTIAL HOUSE IMMEDIATELY BEHIND THE WALL. REFER TYPICAL DETAIL.
 6. STRUCTURAL CERTIFICATION TO BE PROVIDED FOR ALL RETAINING WALLS PRIOR TO CONSTRUCTION

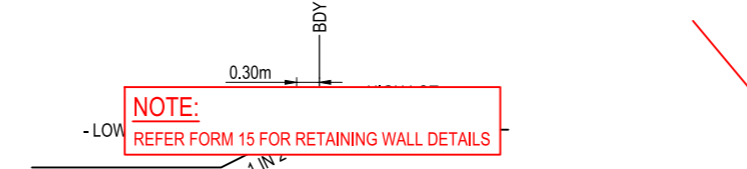


TYPICAL STEP BETWEEN LOTS DETAIL
SCALE 1:50 (A1)
SCALE 1:100 (A3)

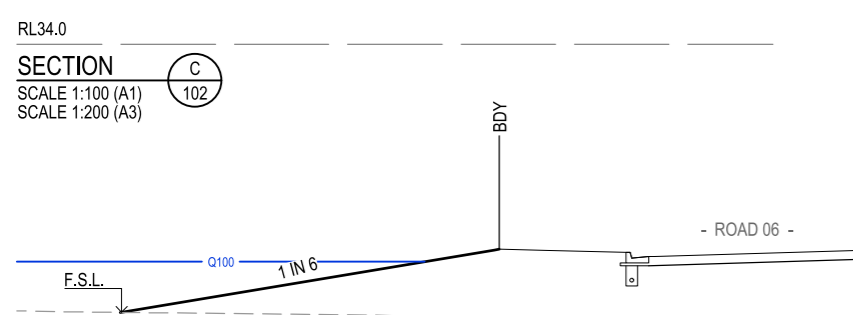


SECTION D
SCALE 1:100 (A1)
SCALE 1:200 (A3)

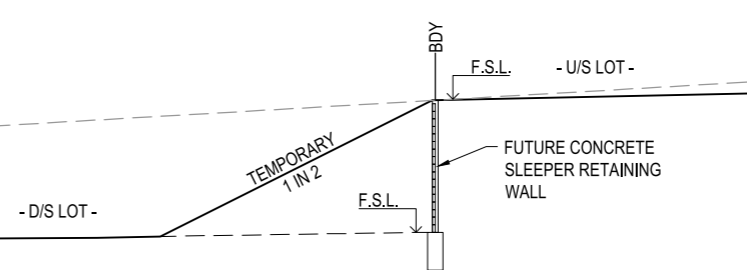

INTERIM EARTHWORKS BATTER
SCALE 1:50 (A1)
SCALE 1:100 (A3)

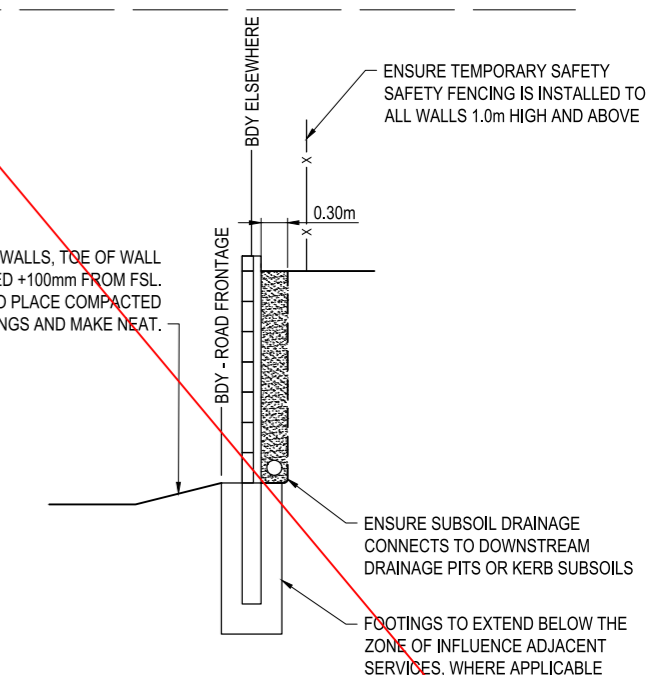

CONCRETE SLEEPER RETAINING WALL
TYPICAL DETAIL
SCALE 1:25 (A1)

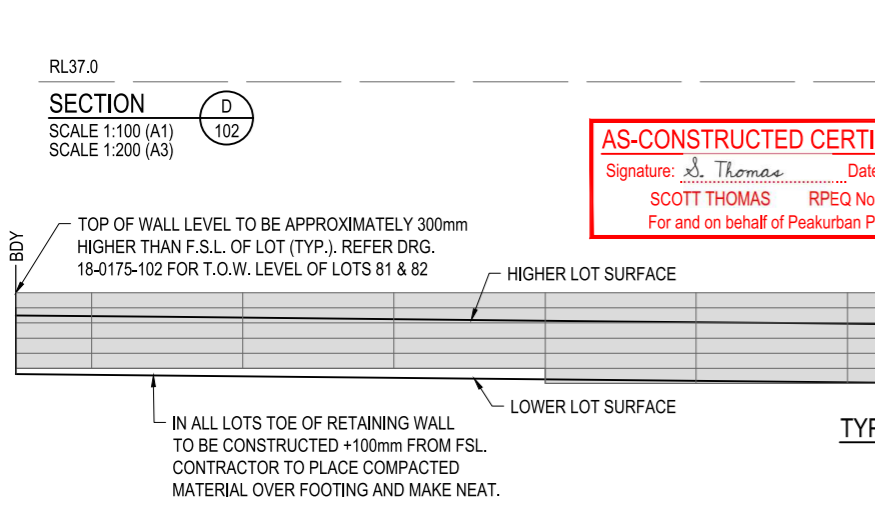

TYPICAL INTER-ALLOTMENT WALL HEIGHT DETAIL OF LOT 81 & 82
SCALE 1:50 (A1)
SCALE 1:100 (A3)


AS-CONSTRUCTED CERTIFICATION
Signature: *S. Thomas* Date: 04.01.21
SCOTT THOMAS RPEQ No. 04618
For and on behalf of Peakurban PTY LTD

REV	DATE	DESIGN	DRAWN	REVISION DETAILS
A	29.07.20	AC	JW	ISSUED FOR CONSTRUCTION
B	04.09.20	MG	MG	TYPICAL INTER-ALLOTMENT WALL HEIGHT DETAIL ADDED
C	23.09.20	AC	SC	ROAD 6 CUTBACK, DRAINAGE LINE UPDATED & STAGE NAME CHANGED
D	04.01.21	TD	JW	AS CONSTRUCTED

AS CONSTRUCTED

DESIGN APPROVED
SCOTT THOMAS RPEQ 04618

FOR AND ON BEHALF OF PEAKURBAN PTY LTD

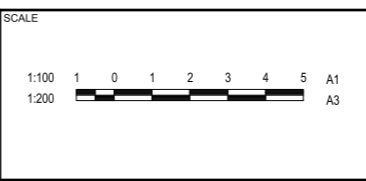

CLIENT
CANBERRA ESTATES CONSORTIUM NO.36 PTY LIMITED

ASSOCIATED CONSULTANT
SAUNDERS HAVILL GROUP
1300 123 744


PROJECT NAME
WOODLINKS STAGE 9A

COLLINGWOOD DRIVE,
COLLINGWOOD PARK

DRAWING TITLE
BULK EARTHWORKS SECTION PLAN SHEET 1 OF 2


PROJECT No. **18-0175**
DRAWING No. **104**
REVISION **D**

NOTE:
SB INDICATES SETBACK
FOR EARTHWORKS PAD

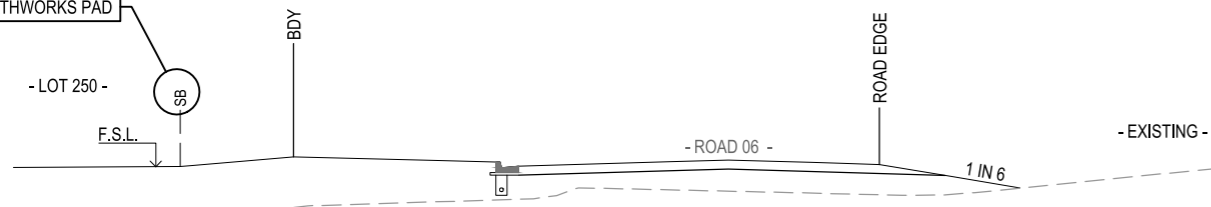

RL39.0

SECTION **H**
SCALE 1:100 (A1)
SCALE 1:200 (A3)

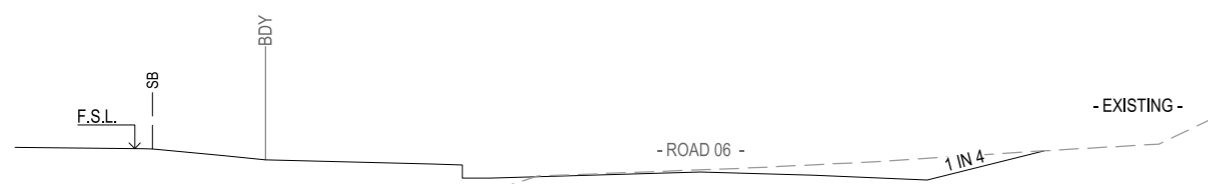


RL42.0

SECTION **I**
SCALE 1:100 (A1)
SCALE 1:200 (A3)




RL43.0

SECTION **J**
SCALE 1:100 (A1)
SCALE 1:200 (A3)

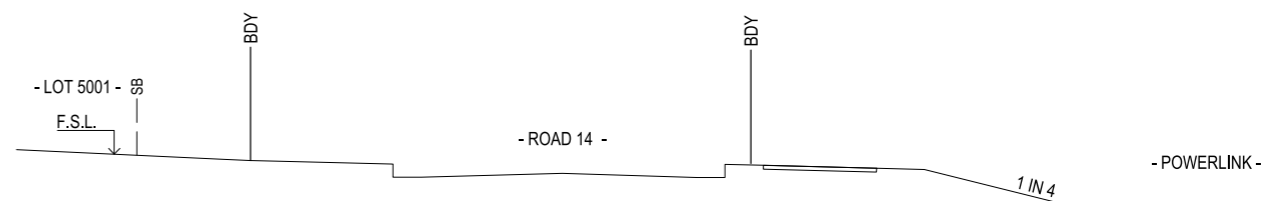


RL33.0

SECTION **K**
SCALE 1:100 (A1)
SCALE 1:200 (A3)

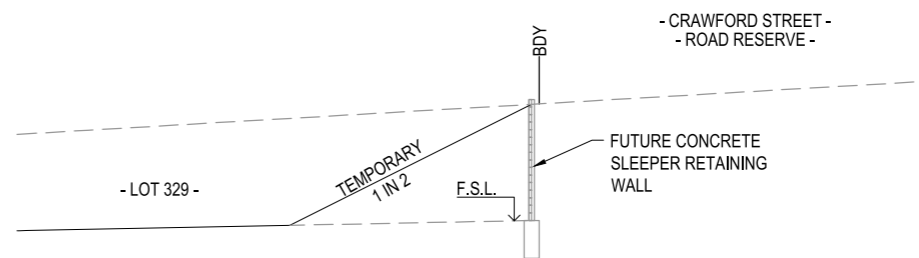

RL47.0

SECTION **L**
SCALE 1:100 (A1)
SCALE 1:200 (A3)

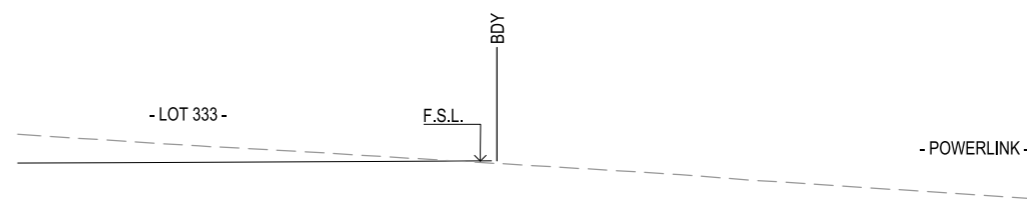

RL44.0


SECTION **M**
SCALE 1:100 (A1)
SCALE 1:200 (A3)

AS-CONSTRUCTED CERTIFICATION
Signature: *S. Thomas* Date: 04.01.21
SCOTT THOMAS RPEQ No. 04618
For and on behalf of Peakurban PTY LTD

REV	DATE	DESIGN	DRAWN	REVISION DETAILS
A	29.07.20	AC	JW	ISSUED FOR CONSTRUCTION
B	29.09.20	AC	SC	ROAD 6 CUTBACK, DRAINAGE LINE UPDATED & STAGE NAME CHANGED
C	04.01.21	TD	JW	AS CONSTRUCTED

DRAWN	STATUS
	AS CONSTRUCTED
DESIGN	APPROVED
	SCOTT THOMAS RPEQ 04618


PEAKURBAN
DEVELOPMENT ENGINEERS • ADVISORS
ENQUIRIES@PEAKURBAN.COM.AU

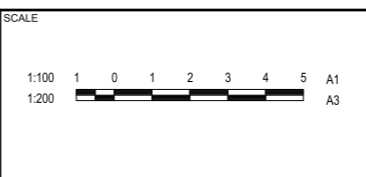

CLIENT
CANBERRA ESTATES CONSORTIUM NO.36 PTY LIMITED
ASSOCIATED CONSULTANT
SAUNDERS HAVILL GROUP
1300 123 744

PROJECT NAME
WOODLINKS STAGE 9A
COLLINGWOOD DRIVE,
COLLINGWOOD PARK

DRAWING TITLE		
BULK EARTHWORKS SECTION PLAN SHEET 2 OF 2		
PROJECT No.	DRAWING No.	REVISION
18-0175	105	C

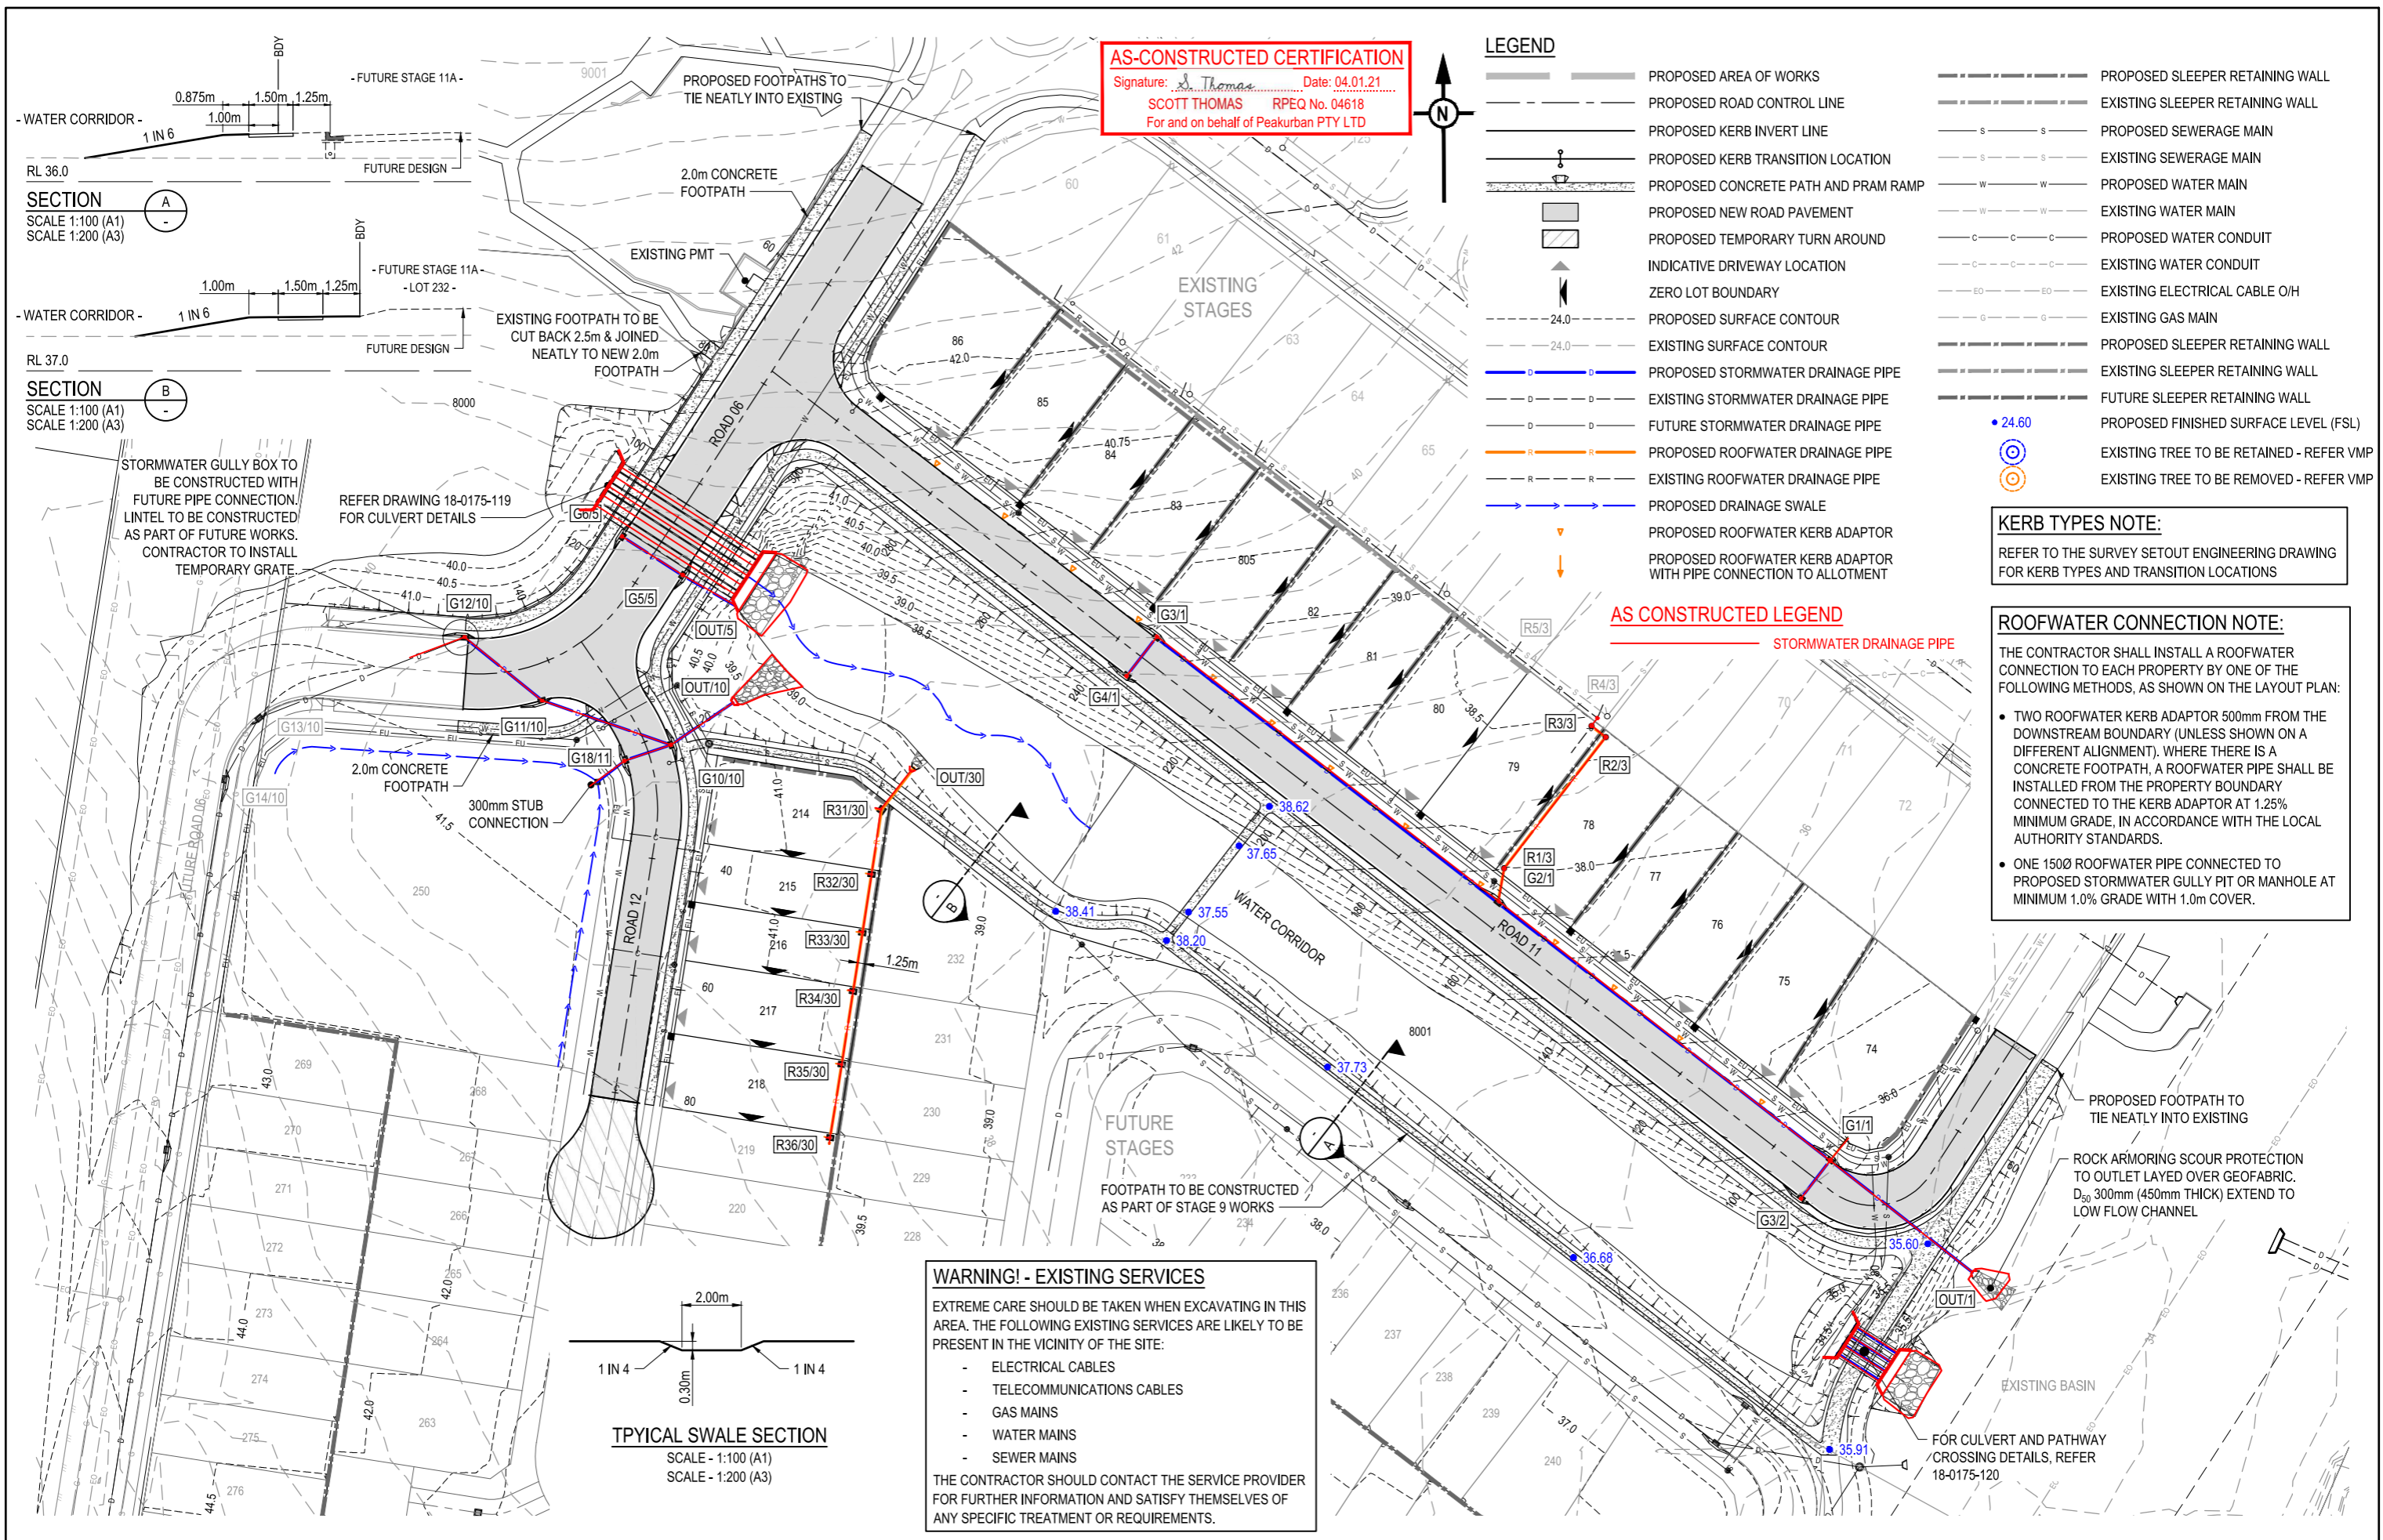

AS-CONSTRUCTED CERTIFICATION
 Signature: *S. Thomas* Date: 04.01.21
 SCOTT THOMAS RPEQ No. 04618
 For and on behalf of Peakurban PTY LTD

LEGEND

- PROPOSED AREA OF WORKS
- PROPOSED ROAD CONTROL LINE
- PROPOSED KERB INVERT LINE
- PROPOSED KERB TRANSITION LOCATION
- PROPOSED CONCRETE PATH AND PRAM RAMP
- PROPOSED NEW ROAD PAVEMENT
- PROPOSED TEMPORARY TURN AROUND
- INDICATIVE DRIVEWAY LOCATION
- ZERO LOT BOUNDARY
- 24.0 — PROPOSED SURFACE CONTOUR
- 24.0 — EXISTING SURFACE CONTOUR
- D — D — PROPOSED STORMWATER DRAINAGE PIPE
- D — D — EXISTING STORMWATER DRAINAGE PIPE
- D — D — FUTURE STORMWATER DRAINAGE PIPE
- R — R — PROPOSED ROOFWATER DRAINAGE PIPE
- R — R — EXISTING ROOFWATER DRAINAGE PIPE
- PROPOSED DRAINAGE SWALE
- PROPOSED ROOFWATER KERB ADAPTOR
- PROPOSED ROOFWATER KERB ADAPTOR WITH PIPE CONNECTION TO ALLOTMENT
- PROPOSED SLEEPER RETAINING WALL
- EXISTING SLEEPER RETAINING WALL
- S — S — PROPOSED SEWERAGE MAIN
- S — S — EXISTING SEWERAGE MAIN
- W — W — PROPOSED WATER MAIN
- W — W — EXISTING WATER MAIN
- C — C — PROPOSED WATER CONDUIT
- C — C — EXISTING WATER CONDUIT
- EO — EO — EXISTING ELECTRICAL CABLE O/H
- G — G — EXISTING GAS MAIN
- PROPOSED SLEEPER RETAINING WALL
- EXISTING SLEEPER RETAINING WALL
- FUTURE SLEEPER RETAINING WALL
- 24.60 PROPOSED FINISHED SURFACE LEVEL (FSL)
- ◉ EXISTING TREE TO BE RETAINED - REFER VMP
- ◉ EXISTING TREE TO BE REMOVED - REFER VMP

AS CONSTRUCTED LEGEND

— STORMWATER DRAINAGE PIPE

KERB TYPES NOTE:
 REFER TO THE SURVEY SETOUT ENGINEERING DRAWING FOR KERB TYPES AND TRANSITION LOCATIONS

ROOFWATER CONNECTION NOTE:
 THE CONTRACTOR SHALL INSTALL A ROOFWATER CONNECTION TO EACH PROPERTY BY ONE OF THE FOLLOWING METHODS, AS SHOWN ON THE LAYOUT PLAN:

- TWO ROOFWATER KERB ADAPTOR 500mm FROM THE DOWNSTREAM BOUNDARY (UNLESS SHOWN ON A DIFFERENT ALIGNMENT). WHERE THERE IS A CONCRETE FOOTPATH, A ROOFWATER PIPE SHALL BE INSTALLED FROM THE PROPERTY BOUNDARY CONNECTED TO THE KERB ADAPTOR AT 1.25% MINIMUM GRADE, IN ACCORDANCE WITH THE LOCAL AUTHORITY STANDARDS.
- ONE 150Ø ROOFWATER PIPE CONNECTED TO PROPOSED STORMWATER GULLY PIT OR MANHOLE AT MINIMUM 1.0% GRADE WITH 1.0m COVER.

SECTION A
 SCALE 1:100 (A1)
 SCALE 1:200 (A3)

SECTION B
 SCALE 1:100 (A1)
 SCALE 1:200 (A3)

TPYICAL SWALE SECTION
 SCALE - 1:100 (A1)
 SCALE - 1:200 (A3)

WARNING! - EXISTING SERVICES
 EXTREME CARE SHOULD BE TAKEN WHEN EXCAVATING IN THIS AREA. THE FOLLOWING EXISTING SERVICES ARE LIKELY TO BE PRESENT IN THE VICINITY OF THE SITE:

- ELECTRICAL CABLES
- TELECOMMUNICATIONS CABLES
- GAS MAINS
- WATER MAINS
- SEWER MAINS


THE CONTRACTOR SHOULD CONTACT THE SERVICE PROVIDER FOR FURTHER INFORMATION AND SATISFY THEMSELVES OF ANY SPECIFIC TREATMENT OR REQUIREMENTS.

REV	DATE	DESIGN	DRAWN	REVISION DETAILS
A	29.07.20	AC	JW	ISSUED FOR CONSTRUCTION
B	04.09.20	MG	MG	REAR LOT ROOFWATER LINE 30 ADDED
C	23.09.20	AC	SC	ROAD 6 CUTBACK, DRAINAGE LINE UPDATED & STAGE NAME CHANGED
D	04.01.21	TD	JW	AS CONSTRUCTED

AS CONSTRUCTED

DESIGN APPROVED
 SCOTT THOMAS RPEQ 04618

FOR AND ON BEHALF OF PEAKURBAN PTY LTD

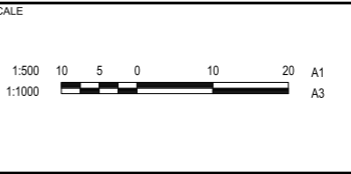

CLIENT
CANBERRA ESTATES CONSORTIUM NO.36 PTY LIMITED


ASSOCIATED CONSULTANT
 SAUNDERS HAVILL GROUP
 1300 123 744

PROJECT NAME
WOODLINKS STAGE 9A

COLLINGWOOD DRIVE,
 COLLINGWOOD PARK

DRAWING TITLE		
ROADWORKS AND DRAINAGE LAYOUT PLAN		
PROJECT No.	DRAWING No.	REVISION
18-0175	106	D

AS-CONSTRUCTED CERTIFICATION
 Signature: *S. Thomas* Date: 04.01.21
SCOTT THOMAS RPEQ No. 04618
 For and on behalf of Peakurban PTY LTD

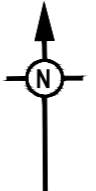

CONTROL LINE SETOUT - ROAD 12

PT	CHAINAGE	EASTING	NORTHING	BEARING	RAD/SPIRAL	A.LENGTH	DEFL.ANGLE
IP 1	0.000	5847.724	3545.944	145°52'18.05"			
TC	13.700	5855.410	3534.603	145°52'18.05"			
IP 2	24.969	5862.048	3524.810		R = 30.000	22.538	43°02'41.95"
CT	36.239	5860.214	3513.122	188°55'00.00"			
TC	140.390	5844.071	3410.230	188°55'00.00"			

CONTROL LINE SETOUT - ROAD 11

PT	CHAINAGE	EASTING	NORTHING	BEARING	RAD/SPIRAL	A.LENGTH	DEFL.ANGLE
CT	17.974	6102.892	3498.664	212°52'59.98"			
TC	68.661	6075.372	3456.099	212°52'59.98"			
IP 3	78.181	6068.575	3445.584		R = 11.500	19.041	94°51'54.60"
CT	87.701	6058.675	3453.249	307°44'54.57"			
IP 4	313.791	5879.904	3591.661	307°44'54.57"			

CONTROL LINE SETOUT - ROAD 6


PT	CHAINAGE	EASTING	NORTHING	BEARING	RAD/SPIRAL	A.LENGTH	DEFL.ANGLE
IP 1	0.000	5921.939	3656.677	212°53'00.95"			
TC	122.000	5855.701	3554.225	212°53'00.95"			
IP 2	138.095	5846.015	3539.242		R = 30.000	32.191	61°28'50.24"
CT	154.191	5828.225	3540.600	274°21'51.19"			
TC	177.958	5804.527	3542.408	274°21'51.19"			
IP 3	193.988	5784.733	3543.919		R = -21.500	32.059	85°26'02.05"
CT	210.017	5781.651	3524.308	188°55'49.14"			
IP 4	518.366	5733.785	3219.698	188°55'49.14"			

LEGEND

- PROPOSED AREA OF WORKS/STAGE BOUNDARY
- PROPOSED NEW ROAD PAVEMENT
- PROPOSED TEMPORARY TURN AROUND
- PROPOSED ROAD CONTROL LINE
- PROPOSED MOUNTABLE KERB AND CHANNEL 'TYPE M1'
- PROPOSED BARRIER KERB AND CHANNEL 'TYPE B1'
- PROPOSED KERB TRANSITION LOCATION
- PROPOSED CONCRETE PATH AND PRAM RAMP
- INDICATIVE DRIVEWAY LOCATION
- ZERO LOT BOUNDARY

AS CONSTRUCTED LEGEND

- FOOTPATH
- KERB LIP LINE
- BACK OF KERB LINE

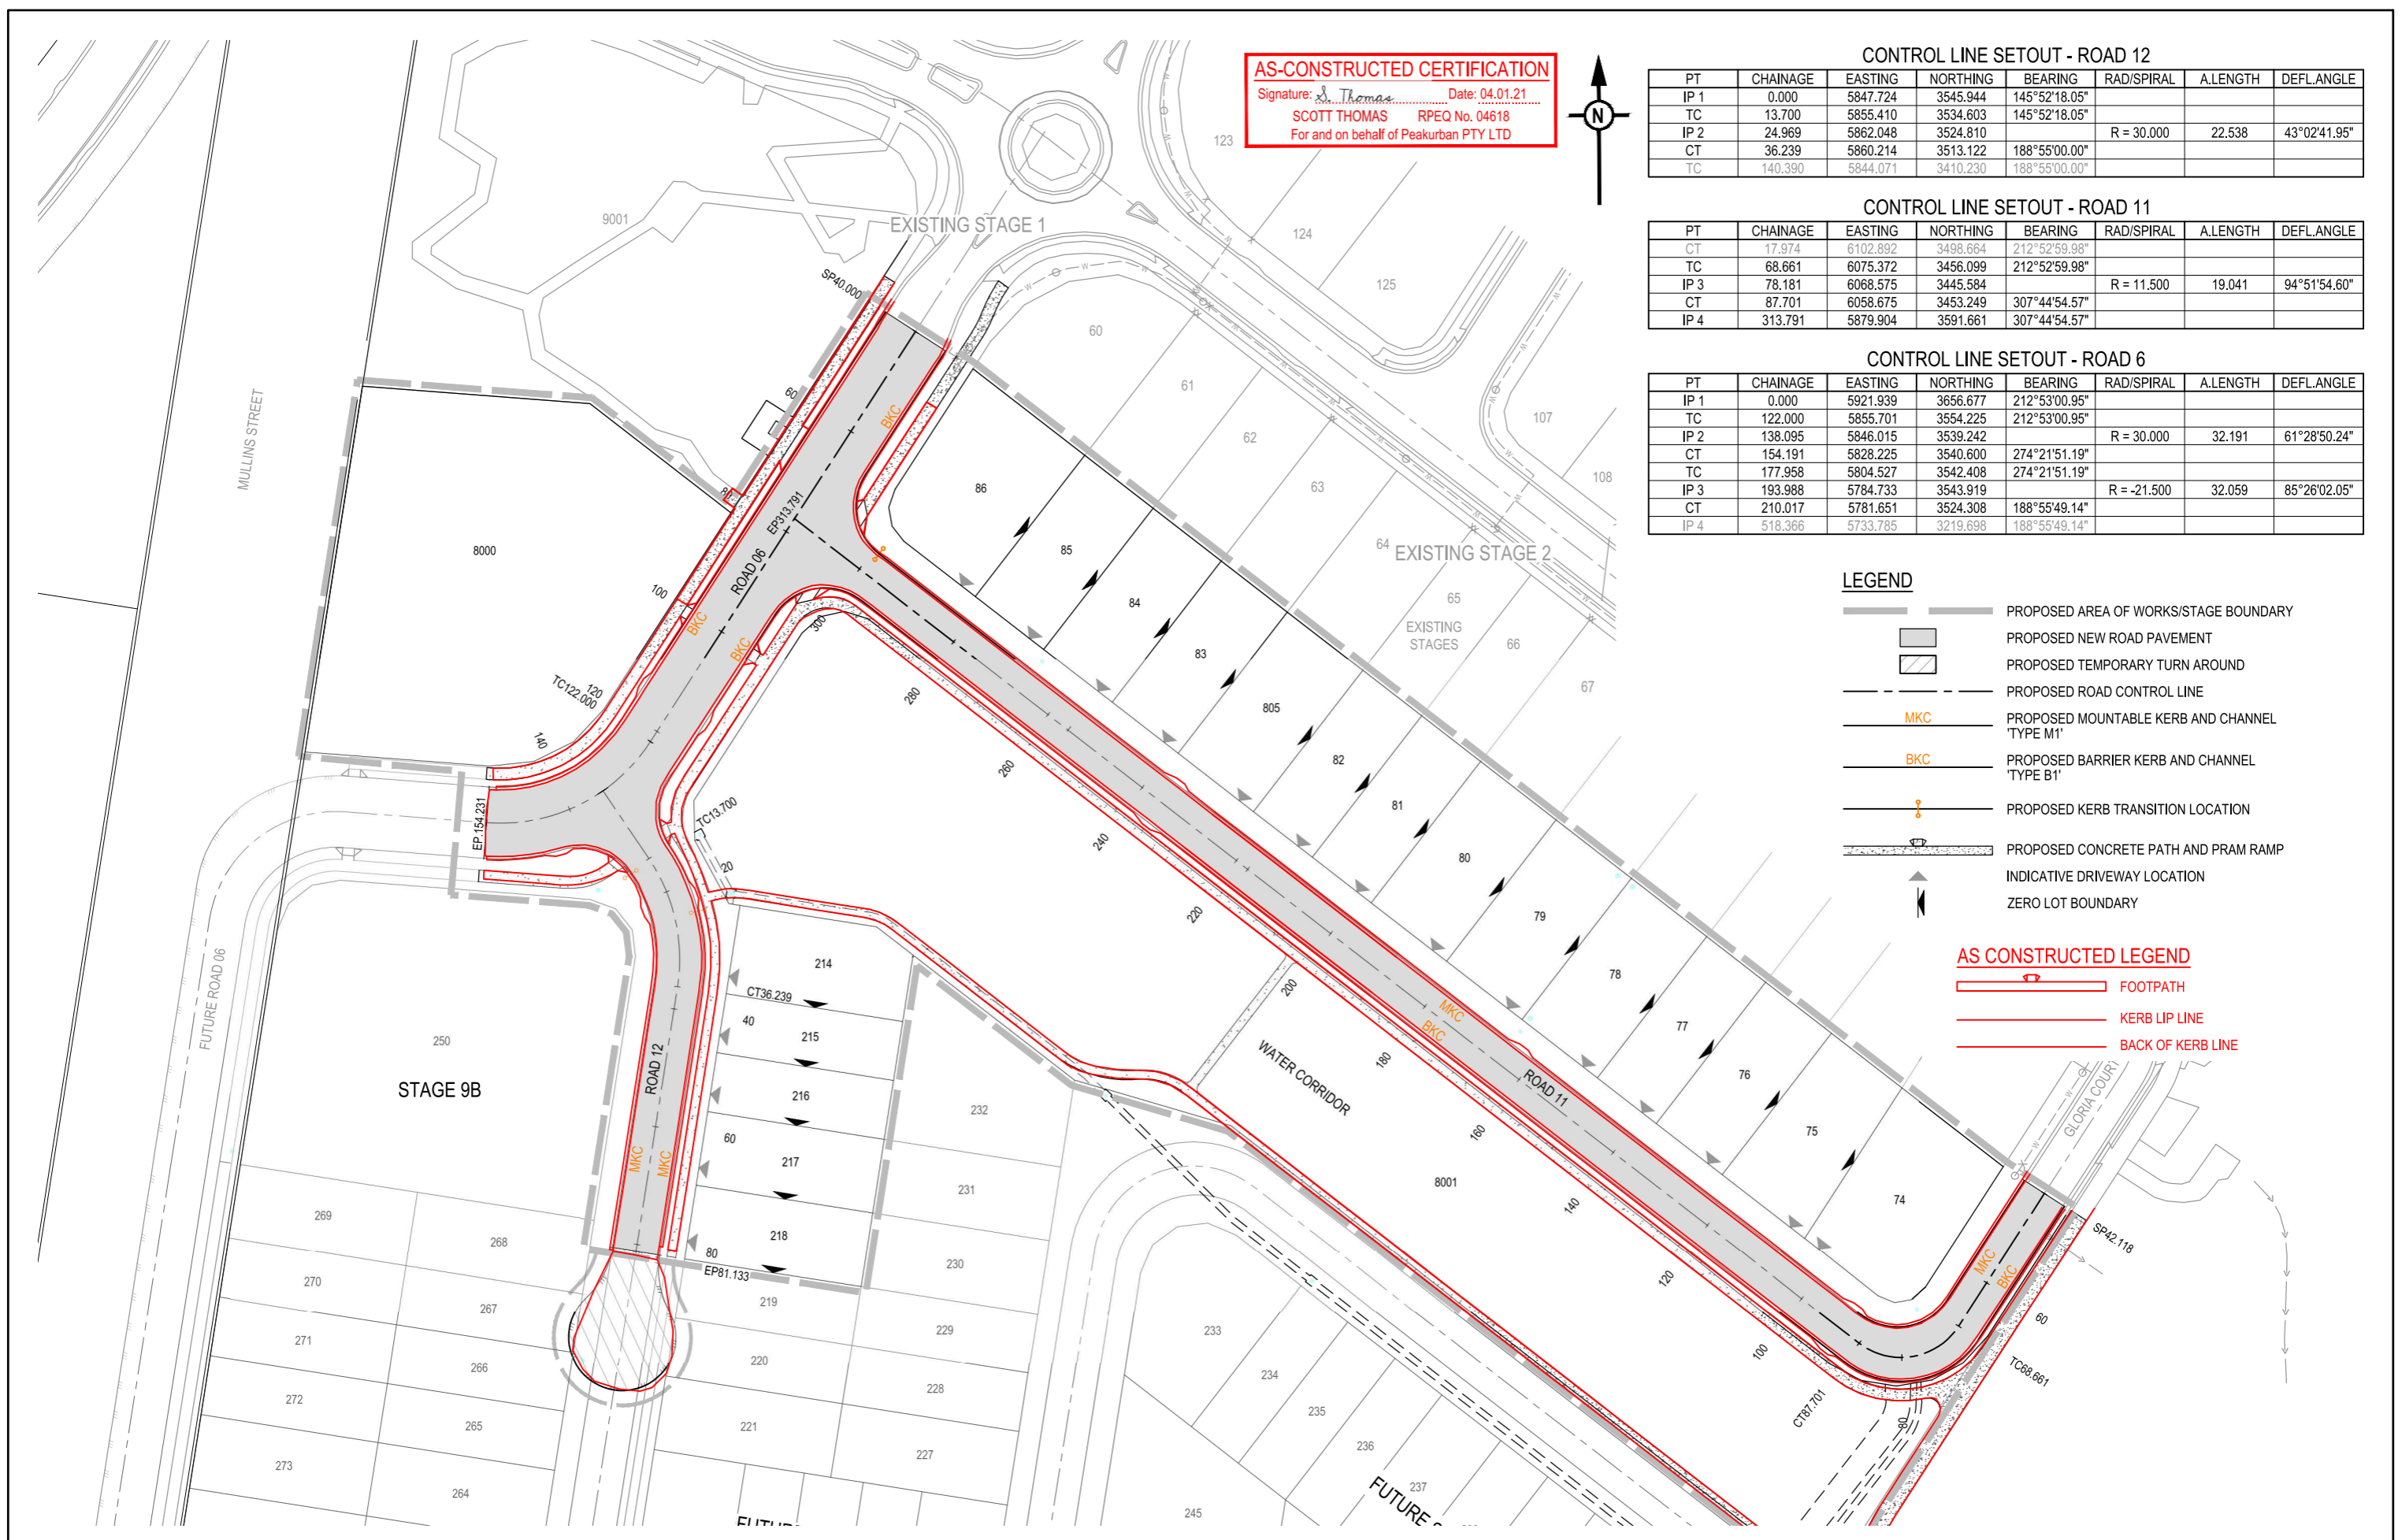

REV	DATE	DESIGN	DRAWN	REVISION DETAILS
A	29.07.20	AC	JW	ISSUED FOR CONSTRUCTION
B	29.09.20	AC	SC	ROAD 6 CUTBACK, DRAINAGE LINE UPDATED & STAGE NAME CHANGED
C	04.01.21	TD	JW	AS CONSTRUCTED

AS CONSTRUCTED

DESIGN APPROVED
SCOTT THOMAS RPEQ 04618

FOR AND ON BEHALF OF PEAKURBAN PTY LTD



SCALE

1:500 10 5 0 10 20 A1
 1:1000

CLIENT
CANBERRA ESTATES CONSORTIUM NO.36 PTY LIMITED

ASSOCIATED CONSULTANT
 SAUNDERS HAVILL GROUP
 1300 123 744

PROJECT NAME
WOODLINKS STAGE 9A

COLLINGWOOD DRIVE,
 COLLINGWOOD PARK

DRAWING TITLE
SURVEY SETOUT AND KERB TYPES LAYOUT PLAN

PROJECT No. **18-0175** DRAWING No. **107** REVISION **C**

ASSUMED PAVEMENT DETAILS (SUBJECT TO CBR TESTING)


ROAD	ROAD CLASSIFICATION	DESIGN ESAS	DESIGNED CBR	SUBGRADE	BASE	SUB BASE	LOWER SUB BASE	TOTAL DEPTH
ROAD 06	MAJOR COLLECTOR STREET	1x10 ⁶	3	50mm	125mm	100mm	250mm	525mm

NOTE: THIS PAVEMENT DESIGN IS PRELIMINARY ONLY BASED ON AN ASSUMED CBR. THE CONTRACTOR SHALL SUPPLY THE SUPERINTENDENT WITH SUBGRADE TEST RESULTS NECESSARY FOR FINAL PAVEMENT DESIGN

AS-CONSTRUCTED PAVEMENT DETAILS								
ROAD	ROAD CLASSIFICATION	ROAD CLASS	DESIGN CBR	AC	BASE	UPPER SUB BASE	START CHAINAGE	END CHAINAGE
MULLINS STREET	MAJOR COLLECTOR STREET	CLASS C	10	50mm	125mm	135mm	42m	314m

(EW) REFER TO BULK EARTHWORKS DRAWING FOR LOT GRADING AND FINISHED SURFACE LEVELS

NOTE: REFER TO SURVEYORS AS-CONSTRUCTED DRAWINGS FOR FINISHED SURFACE LEVELS

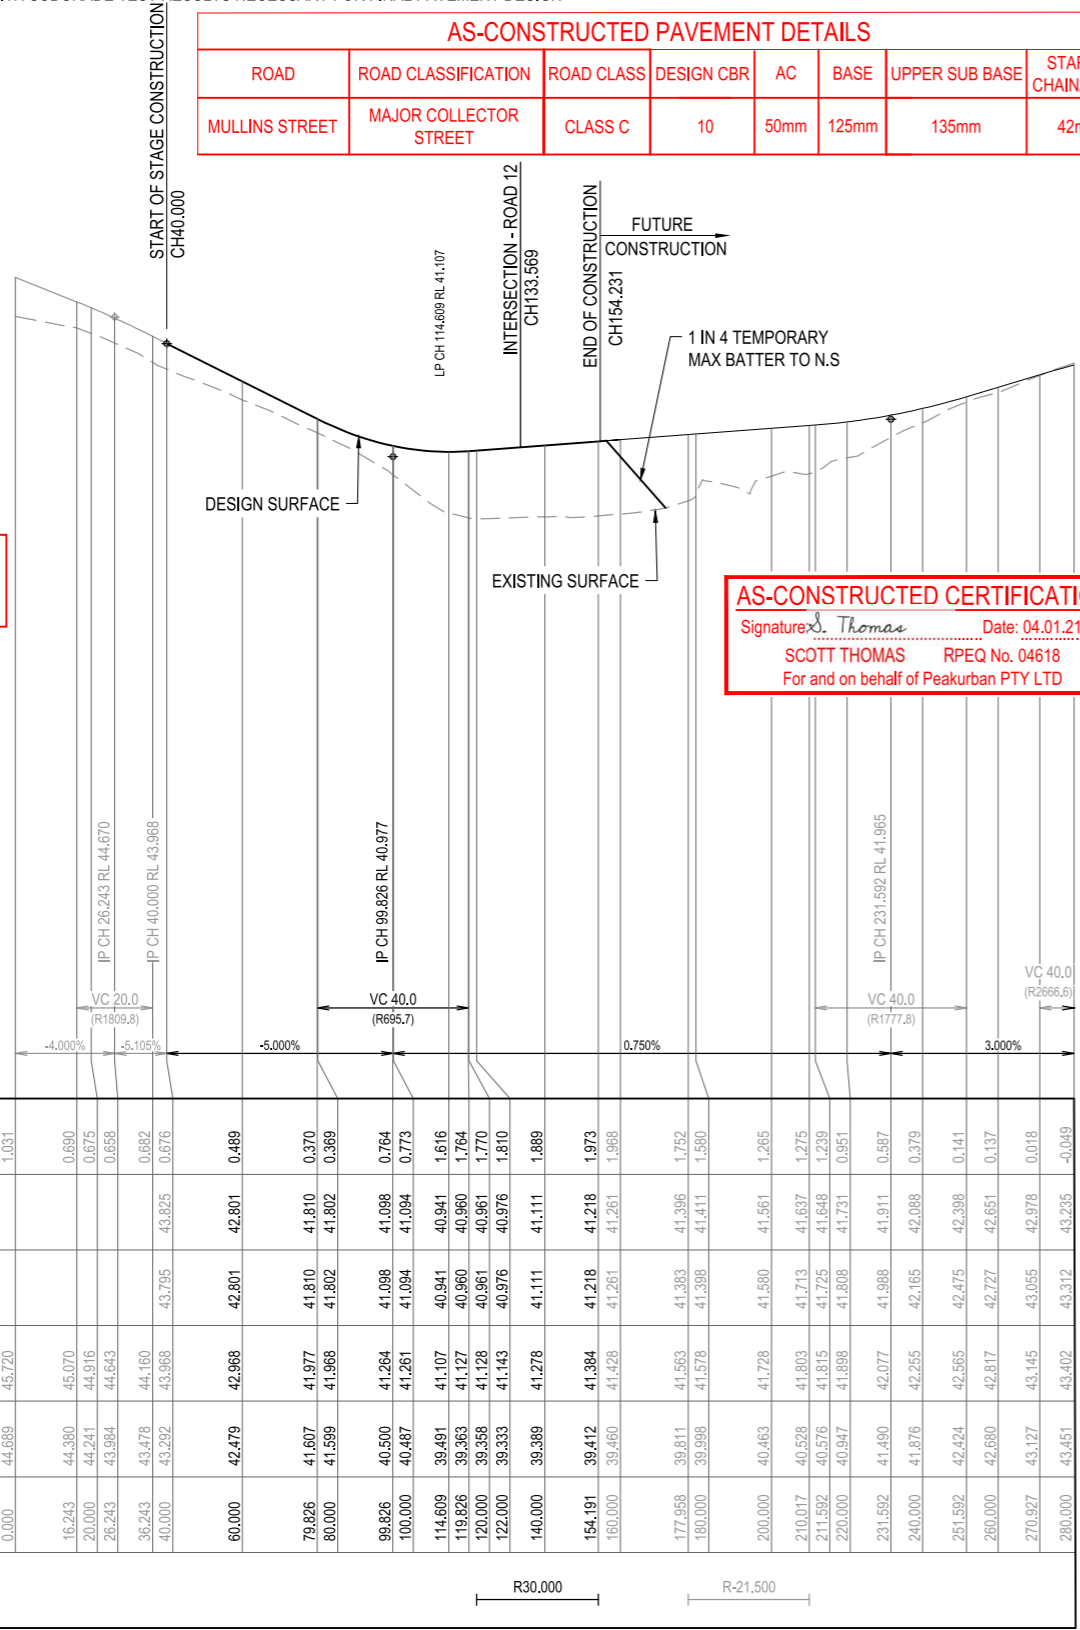


AS-CONSTRUCTED CERTIFICATION
 Signature: *S. Thomas* Date: 04.01.21
 SCOTT THOMAS RPEQ No. 04618
 For and on behalf of Peakurban PTY LTD

DATUM RL 24.0


	0.000	16.243	20.000	26.243	36.243	40.000	60.000	79.826	80.000	99.826	100.000	114.609	118.826	120.000	122.000	140.000	154.191	160.000	177.958	180.000	200.000	210.017	211.592	220.000	231.592	240.000	251.592	260.000	270.927	280.000
CUT (-) / FILL	1.031	0.690	0.675	0.658	0.682	0.676	0.489	0.370	0.389	0.764	0.773	1.616	1.764	1.770	1.810	1.889	1.973	1.988	1.752	1.580	1.265	1.275	1.239	0.951	0.587	0.379	0.141	0.137	0.018	-0.049
LHS LIP LEVEL		44.380	44.916	44.643	44.160	43.968	42.801	41.810	41.802	41.098	41.094	40.941	40.960	40.961	40.976	41.111	41.218	41.261	41.396	41.411	41.561	41.637	41.646	41.731	41.911	42.088	42.398	42.651	42.978	43.238
RHS LIP LEVEL		44.380	44.916	44.643	44.160	43.968	42.801	41.810	41.802	41.098	41.094	40.941	40.960	40.961	40.976	41.111	41.218	41.261	41.396	41.411	41.561	41.637	41.646	41.731	41.911	42.088	42.398	42.651	42.978	43.238
DESIGN SURFACE	45.720	45.070	44.916	44.643	44.160	43.968	42.968	41.977	41.968	41.264	41.261	41.107	40.980	40.961	40.976	41.111	41.384	41.428	41.563	41.578	41.728	41.803	41.815	41.898	42.077	42.255	42.565	42.817	43.145	43.402
EXISTING SURFACE	44.689	44.380	44.916	44.643	44.160	43.968	42.479	41.607	41.599	40.500	40.487	39.491	39.363	39.358	39.333	39.389	39.412	39.460	39.811	39.998	40.463	40.528	40.516	40.947	41.490	41.876	42.424	42.680	43.127	43.451
CHAINAGES	0.000	16.243	20.000	26.243	36.243	40.000	60.000	79.826	80.000	99.826	100.000	114.609	118.826	120.000	122.000	140.000	154.191	160.000	177.958	180.000	200.000	210.017	211.592	220.000	231.592	240.000	251.592	260.000	270.927	280.000
HORIZONTAL CURVES												R30.000									R-21.500									

ROAD 06

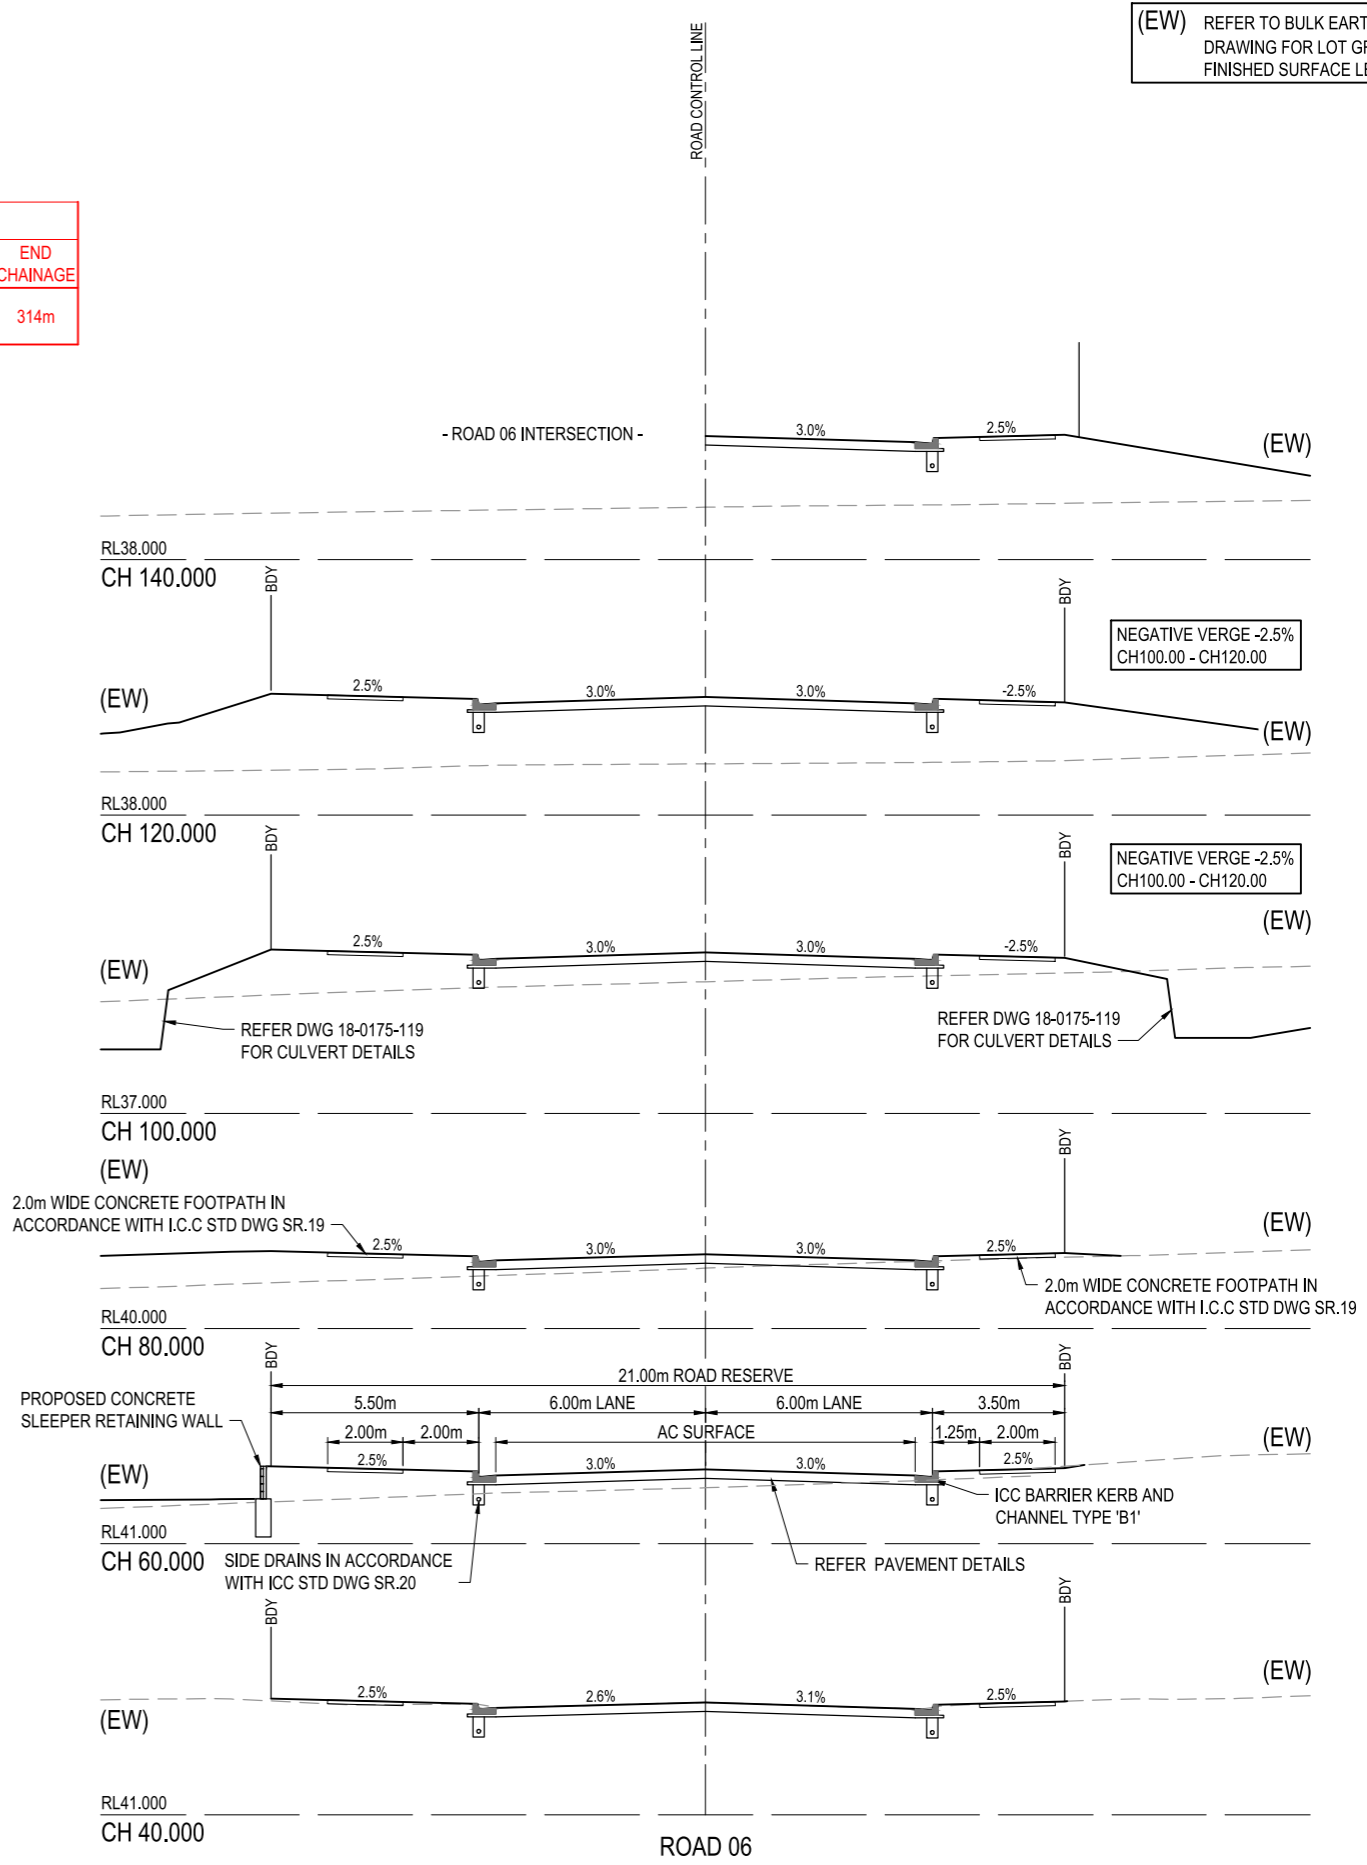

REV	DATE	DESIGN	DRAWN	REVISION DETAILS
A	29.07.20	AC	JW	ISSUED FOR CONSTRUCTION
B	29.09.20	AC	SC	ROAD 6 CUTBACK, DRAINAGE LINE UPDATED & STAGE NAME CHANGED
C	04.01.21	TD	JW	AS CONSTRUCTED

AS CONSTRUCTED
 APPROVED
 SCOTT THOMAS RPEQ 04618
 FOR AND ON BEHALF OF PEAKURBAN PTY LTD

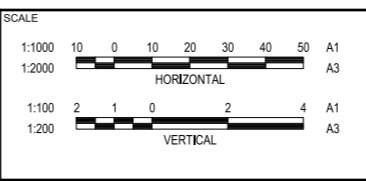

CLIENT: CANBERRA ESTATES CONSORTIUM NO.36 PTY LIMITED
 ASSOCIATED CONSULTANT: SAUNDERS HAVILL GROUP 1300 123 744

PROJECT NAME: WOODLINKS STAGE 9A
 COLLINGWOOD DRIVE, COLLINGWOOD PARK


DRAWING TITLE		
ROAD 06 LONGITUDINAL AND CROSS SECTIONS		
PROJECT No.	DRAWING No.	REVISION
18-0175	108	C

~~ASSUMED PAVEMENT DETAILS (SUBJECT TO CBR TESTING)~~

ROAD	ROAD CLASSIFICATION	DESIGN ESAS	ASSUMED CBR	SUPERFACER	BASE	SUB BASE	LOWER SUB BASE	TOTAL DEPTH
ROAD 11	ACCESS STREET	1.0 x 10 ⁵	3	35mm	125mm	100mm	160mm	420mm

NOTE: THIS PAVEMENT DESIGN IS PRELIMINARY ONLY BASED ON AN ASSUMED CBR. THE CONTRACTOR SHALL SUPPLY THE SUPERINTENDENT WITH SUBGRADE TEST RESULTS NECESSARY FOR FINAL PAVEMENT DESIGN

AS-CONSTRUCTED PAVEMENT DETAILS								
ROAD	ROAD CLASSIFICATION	ROAD CLASS	DESIGN CBR	AC	BASE	UPPER SUB BASE	START CHAINAGE	END CHAINAGE
GLORIA STREET	ACCESS STREET	CLASS A1	10	35mm	125mm	100mm	40m	180m

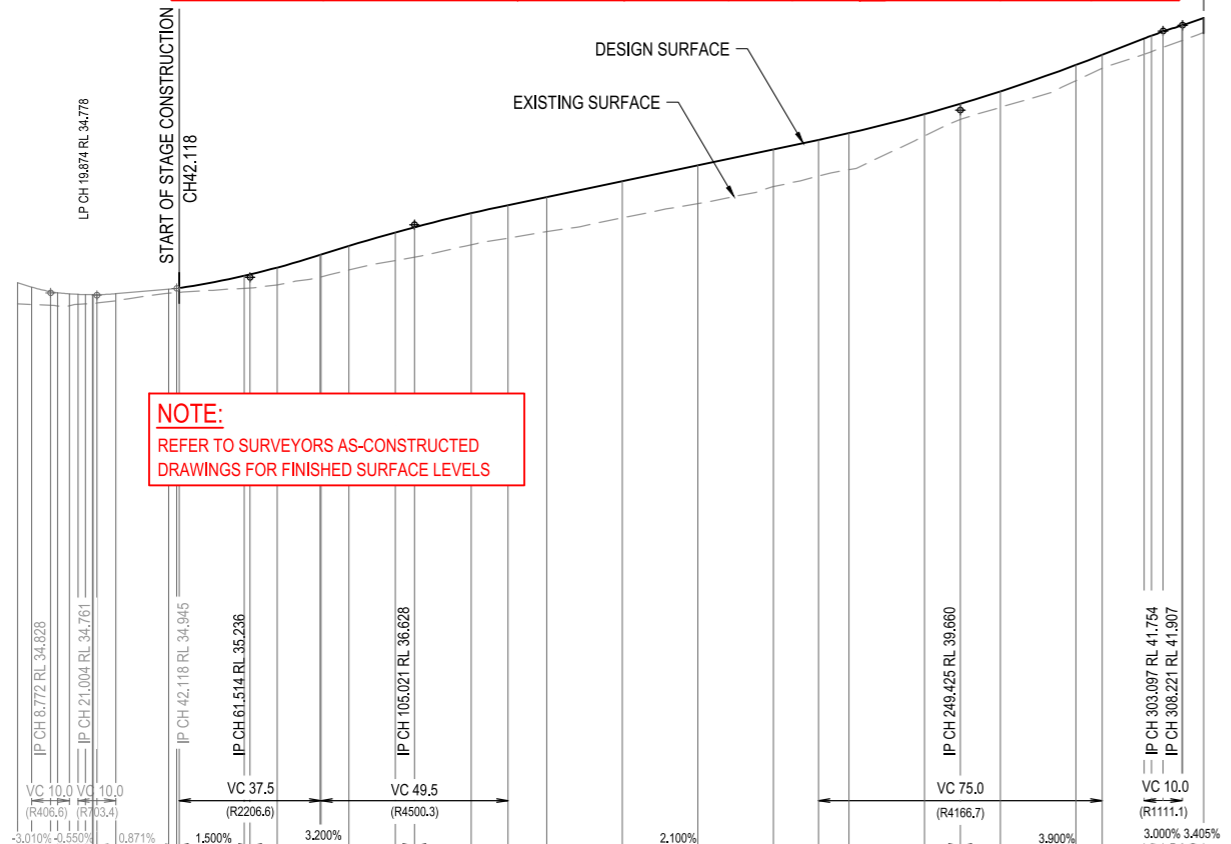


NOTE: REFER TO SURVEYORS AS-CONSTRUCTED DRAWINGS FOR FINISHED SURFACE LEVELS

	0.000	3.772	8.772	10.604	13.772	16.004	17.974	20.000	21.004	26.004	40.000	42.118	60.000	61.514	68.661	80.000	87.701	100.000	105.021	120.000	129.773	140.000	160.000	180.000	200.000	211.925	220.000	240.000	249.425	260.000	280.000	286.925	298.097	300.000	303.097	308.097	308.221	313.791											
CUT (-) / FILL	0.554	0.458	0.361	0.352	0.318	0.264	0.244	0.229	0.222	0.187	0.110	0.111	0.116	0.361	0.455	0.585	0.587	0.637	0.742	0.787	0.832	0.874	0.915	0.972	1.014	0.986	0.958	0.963	0.579	0.413	0.414	0.352	0.416	0.425	0.421	0.400	0.382												
LHS LIP LEVEL	EXISTING																				34.860	34.868	34.848	35.174	35.209	35.388	35.721	35.729	35.961	36.317	36.448	36.820	37.041	37.256	37.676	38.096	38.516	38.766	38.944	39.451	39.723	40.048	40.752	41.016	#				
RHS LIP LEVEL	EXISTING																				34.860	34.868	34.848	35.174	35.209	35.388	35.721	35.729	35.961	36.317	36.448	36.820	37.041	37.256	37.676	38.096	38.516	38.766	38.944	39.451	39.723	40.048	40.752	41.016	#				
DESIGN SURFACE	35.092	34.978	34.859	34.830	34.800	34.768	34.780	34.778	34.804	34.817	34.926	34.945	34.954	35.280	35.315	35.495	35.827	36.068	36.424	36.590	36.932	37.148	37.362	37.782	38.202	38.622	38.873	39.050	39.557	39.829	40.160	40.859	41.123	41.559	41.631	41.742	41.904	41.907	42.097										
EXISTING SURFACE	34.536	34.521	34.498	34.478	34.482	34.524	34.536	34.549	34.557	34.617	34.617	34.634	34.639	34.947	34.954	35.040	35.249	35.430	35.682	35.773	36.099	36.274	36.448	36.810	37.189	37.636	37.915	38.087	38.978	39.416	39.733	40.444	40.771	41.142	41.207	41.321	41.503	41.508	41.715										
CHAINAGES	0.000	3.772	8.772	10.604	13.772	16.004	17.974	20.000	21.004	26.004	40.000	42.118	60.000	61.514	68.661	80.000	87.701	100.000	105.021	120.000	129.773	140.000	160.000	180.000	200.000	211.925	220.000	240.000	249.425	260.000	280.000	286.925	298.097	300.000	303.097	308.097	308.221	313.791											
HORIZONTAL CURVES	R14.750		R11.500																																														

ROAD 11

AS-CONSTRUCTED CERTIFICATION
 Signature: *S. Thomas* Date: 04.01.21
 SCOTT THOMAS RPEQ No. 04618
 For and on behalf of Peakurban PTY LTD


(EW) REFER TO BULK EARTHWORKS DRAWING FOR LOT GRADING AND FINISHED SURFACE LEVELS

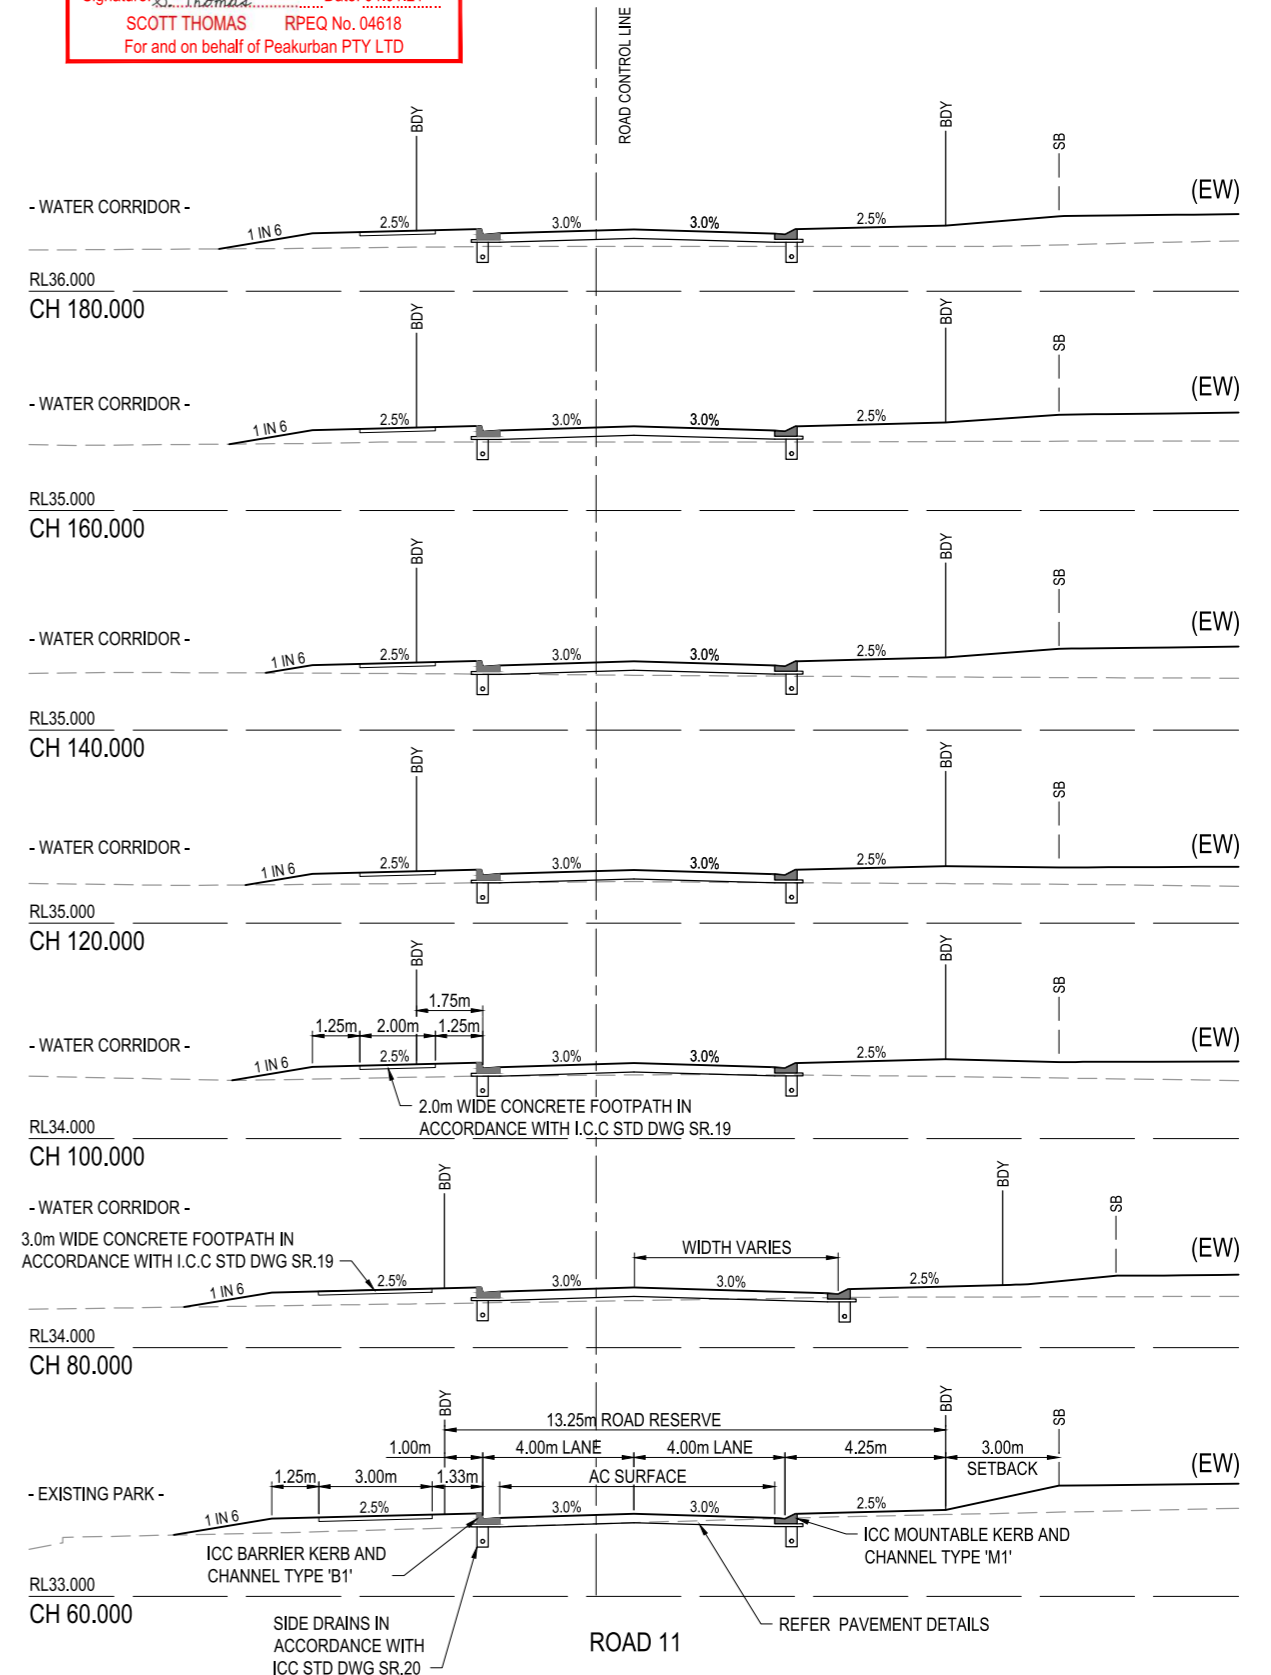

<table border="1"> <thead> <tr> <th>REV</th> <th>DATE</th> <th>DESIGN</th> <th>DRAWN</th> <th>REVISION DETAILS</th> </tr> </thead> <tbody> <tr> <td>A</td> <td>29.07.20</td> <td>AC</td> <td>JW</td> <td>ISSUED FOR CONSTRUCTION</td> </tr> <tr> <td>B</td> <td>29.09.20</td> <td>AC</td> <td>SC</td> <td>ROAD 6 CUTBACK, DRAINAGE LINE UPDATED & STAGE NAME CHANGED</td> </tr> <tr> <td>C</td> <td>04.01.21</td> <td>TD</td> <td>JW</td> <td>AS CONSTRUCTED</td> </tr> </tbody> </table>	REV	DATE	DESIGN	DRAWN	REVISION DETAILS	A	29.07.20	AC	JW	ISSUED FOR CONSTRUCTION	B	29.09.20	AC	SC	ROAD 6 CUTBACK, DRAINAGE LINE UPDATED & STAGE NAME CHANGED	C	04.01.21	TD	JW	AS CONSTRUCTED	<table border="1"> <thead> <tr> <th>DRAWN</th> <th>STATUS</th> </tr> </thead> <tbody> <tr> <td>AS CONSTRUCTED</td> <td></td> </tr> </tbody> </table>	DRAWN	STATUS	AS CONSTRUCTED		<p>DEVELOPMENT ENGINEERS + ADVISORS</p>	<table border="1"> <thead> <tr> <th>SCALE</th> <th>CROSS SECTIONS</th> <th>HORIZONTAL</th> <th>VERTICAL</th> </tr> </thead> <tbody> <tr> <td>1:100</td> <td>1 0 1 2 3 4 5</td> <td>10 0 10 20 30 40 50</td> <td>1 0 1 2 3 4 5</td> </tr> <tr> <td>1:200</td> <td></td> <td></td> <td></td> </tr> </tbody> </table>	SCALE	CROSS SECTIONS	HORIZONTAL	VERTICAL	1:100	1 0 1 2 3 4 5	10 0 10 20 30 40 50	1 0 1 2 3 4 5	1:200				<table border="1"> <thead> <tr> <th>CLIENT</th> <th>PROJECT NAME</th> <th>DRAWING TITLE</th> </tr> </thead> <tbody> <tr> <td>CANBERRA ESTATES CONSORTIUM NO.36 PTY LIMITED</td> <td>WOODLINKS STAGE 9A</td> <td>ROAD 11 LONGITUDINAL AND CROSS SECTIONS</td> </tr> </tbody> </table>	CLIENT	PROJECT NAME	DRAWING TITLE	CANBERRA ESTATES CONSORTIUM NO.36 PTY LIMITED	WOODLINKS STAGE 9A	ROAD 11 LONGITUDINAL AND CROSS SECTIONS	<table border="1"> <thead> <tr> <th>ASSOCIATED CONSULTANT</th> <th>PROJECT No.</th> <th>DRAWING No.</th> <th>REVISION</th> </tr> </thead> <tbody> <tr> <td>SAUNDERS HAVILL GROUP 1300 123 744</td> <td>18-0175</td> <td>109</td> <td>C</td> </tr> </tbody> </table>	ASSOCIATED CONSULTANT	PROJECT No.	DRAWING No.	REVISION	SAUNDERS HAVILL GROUP 1300 123 744	18-0175	109	C
REV	DATE	DESIGN	DRAWN	REVISION DETAILS																																																			
A	29.07.20	AC	JW	ISSUED FOR CONSTRUCTION																																																			
B	29.09.20	AC	SC	ROAD 6 CUTBACK, DRAINAGE LINE UPDATED & STAGE NAME CHANGED																																																			
C	04.01.21	TD	JW	AS CONSTRUCTED																																																			
DRAWN	STATUS																																																						
AS CONSTRUCTED																																																							
SCALE	CROSS SECTIONS	HORIZONTAL	VERTICAL																																																				
1:100	1 0 1 2 3 4 5	10 0 10 20 30 40 50	1 0 1 2 3 4 5																																																				
1:200																																																							
CLIENT	PROJECT NAME	DRAWING TITLE																																																					
CANBERRA ESTATES CONSORTIUM NO.36 PTY LIMITED	WOODLINKS STAGE 9A	ROAD 11 LONGITUDINAL AND CROSS SECTIONS																																																					
ASSOCIATED CONSULTANT	PROJECT No.	DRAWING No.	REVISION																																																				
SAUNDERS HAVILL GROUP 1300 123 744	18-0175	109	C																																																				

(EW) REFER TO BULK EARTHWORKS DRAWING FOR LOT GRADING AND FINISHED SURFACE LEVELS

AS-CONSTRUCTED CERTIFICATION
 Signature: *S. Thomas* Date: 04.01.21
 SCOTT THOMAS RPEQ No. 04618
 For and on behalf of Peakurban PTY LTD

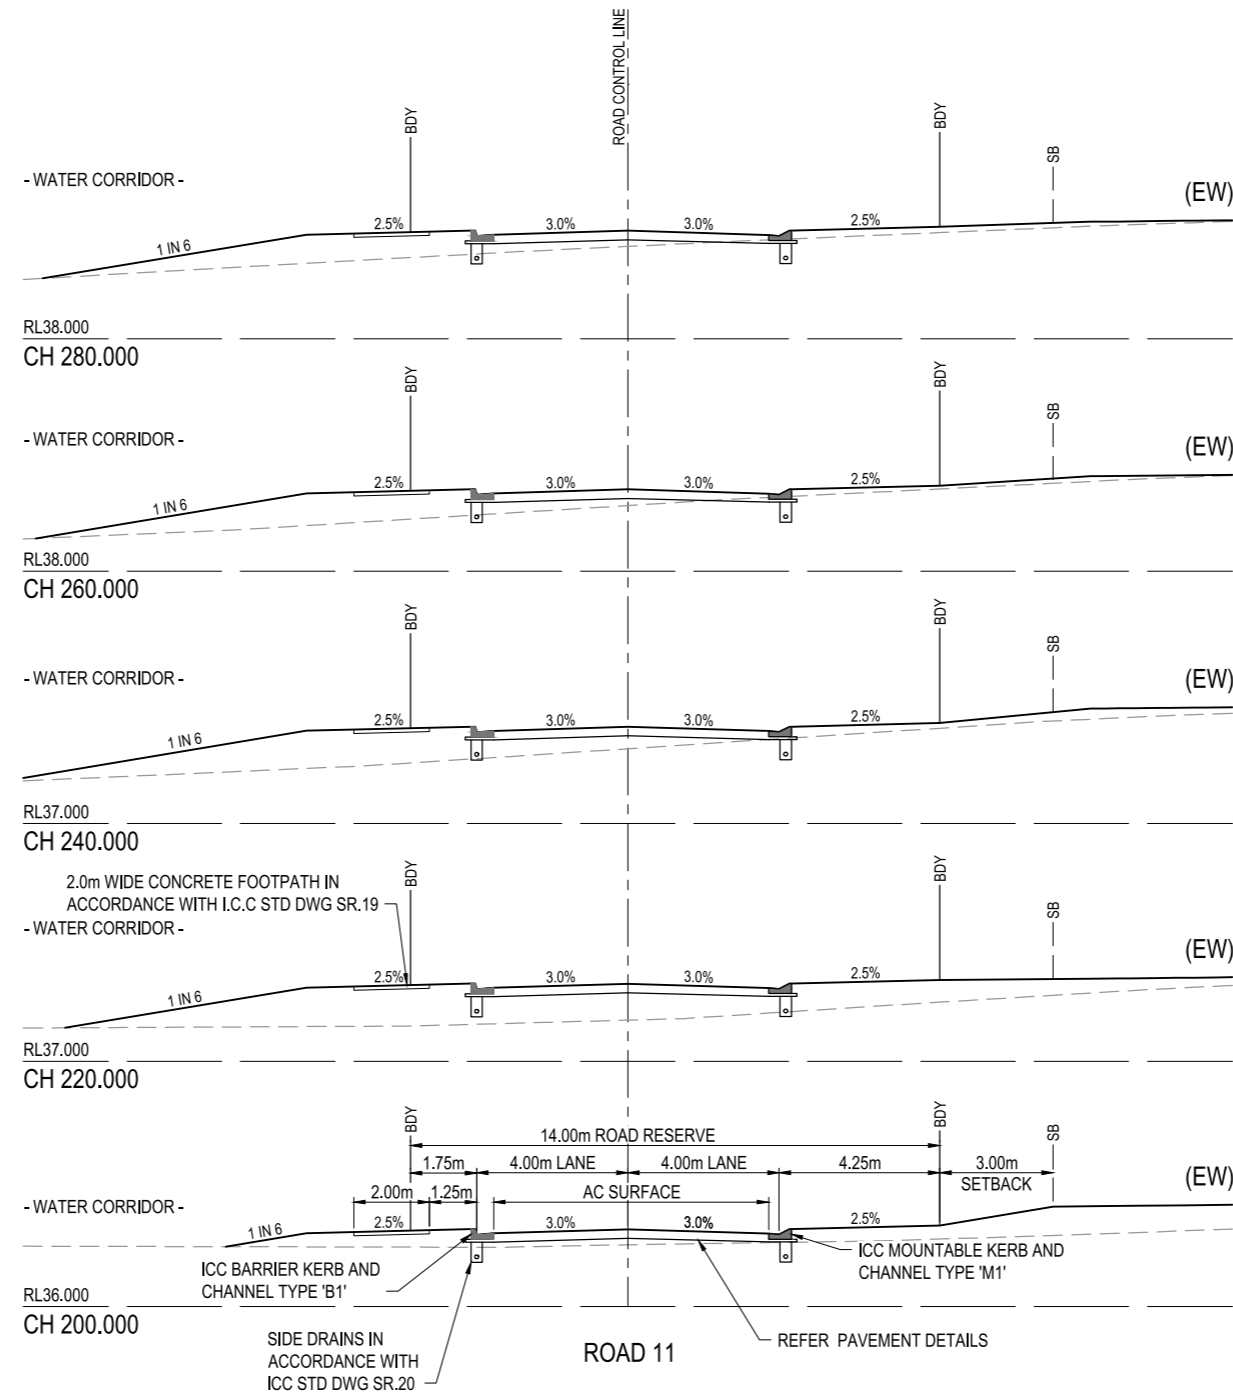

REV	DATE	DESIGN	DRAWN	REVISION DETAILS
A	29.07.20	AC	JW	ISSUED FOR CONSTRUCTION
B	29.09.20	AC	SC	ROAD 6 CUTBACK, DRAINAGE LINE UPDATED & STAGE NAME CHANGED
C	04.01.21	TD	JW	AS CONSTRUCTED

DRAWN	STATUS
	AS CONSTRUCTED

PEAKURBAN
 DEVELOPMENT ENGINEERS + ADVISORS
 ENQUIRIES@PEAKURBAN.COM.AU

SCALE	CROSS SECTIONS	HORIZONTAL	VERTICAL
1:100	1 0 1 2 3 4 5 A1	1 0 1 2 3 4 5 A1	1 0 1 2 3 4 5 A1
1:200	1 0 1 2 3 4 5 A3	1 0 1 2 3 4 5 A3	1 0 1 2 3 4 5 A3
1:1000	10 0 10 20 30 40 50 A1	10 0 10 20 30 40 50 A1	10 0 10 20 30 40 50 A1
1:2000	10 0 10 20 30 40 50 A3	10 0 10 20 30 40 50 A3	10 0 10 20 30 40 50 A3

CLIENT
CANBERRA ESTATES CONSORTIUM NO.36 PTY LIMITED
 ASSOCIATED CONSULTANT
 SAUNDERS HAVILL GROUP
 1300 123 744

PROJECT NAME
WOODLINKS STAGE 9A
 COLLINGWOOD DRIVE,
 COLLINGWOOD PARK

DRAWING TITLE	PROJECT No.	DRAWING No.	REVISION
ROAD 11 CROSS SECTIONS	18-0175	110	C

ASSUMED PAVEMENT DETAILS (SUBJECT TO CBR TESTING)

ROAD	ROAD CLASSIFICATION	DESIGN ESAS	ASSUMED CBR	SUPERFINE	BASE	SUB BASE	LOWER SUB BASE	TOTAL DEPTH
ROAD 12	ACCESS STREET	1.0 x 10 ⁵	3	35mm	125mm	100mm	160mm	420mm


NOTE: THIS PAVEMENT DESIGN IS PRELIMINARY ONLY BASED ON AN ASSUMED CBR. THE CONTRACTOR SHALL SUPPLY THE SUPERINTENDENT WITH SUBGRADE TEST RESULTS NECESSARY FOR FINAL PAVEMENT DESIGN

AS-CONSTRUCTED CERTIFICATION

Signature: *S. Thomas* Date: 04.01.21
 SCOTT THOMAS RPEQ No. 04618
 For and on behalf of Peakurban PTY LTD

(EW) REFER TO BULK EARTHWORKS DRAWING FOR LOT GRADING AND FINISHED SURFACE LEVELS


AS-CONSTRUCTED PAVEMENT DETAILS								
ROAD	ROAD CLASSIFICATION	ROAD CLASS	DESIGN CBR	AC	BASE	UPPER SUB BASE	START CHAINAGE	END CHAINAGE
JOHN DRIVE	ACCESS STREET	CLASS A1	10	35mm	125mm	100mm	0m	81.5m

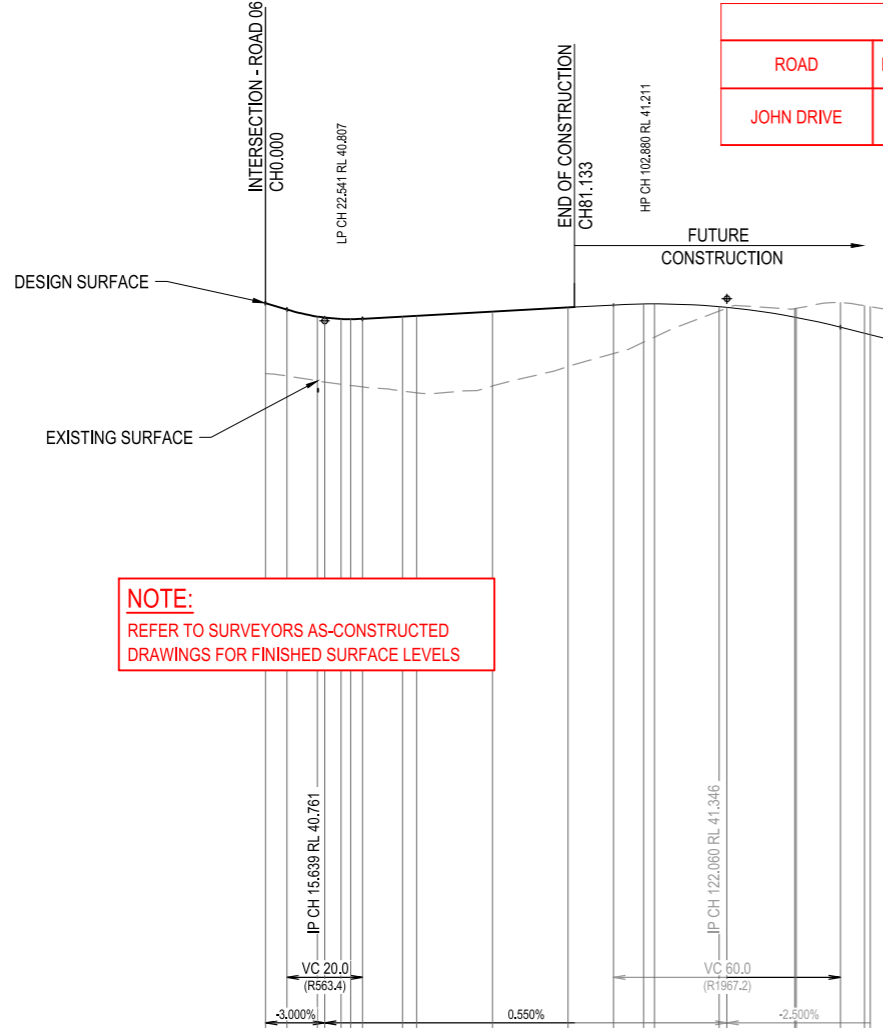

NOTE: REFER TO SURVEYORS AS-CONSTRUCTED DRAWINGS FOR FINISHED SURFACE LEVELS


DATUM RL 21.0		1.859	1.757	1.700	1.708	1.726	1.752	1.798	1.987	2.035	1.987	1.557	1.279	1.009	0.877	0.113	0.017	-0.225	-0.241	-0.651	-0.729	-0.741	
CUT (-) / FILL	#	1.859	1.757	1.700	1.708	1.726	1.752	1.798	1.987	2.035	1.987	1.557	1.279	1.009	0.877	0.113	0.017	-0.225	-0.241	-0.651	-0.729	-0.741	
LHS LIP LEVEL	#			40.738	40.701	40.695	40.704	40.704	40.762	40.783	40.893	41.003	41.069	41.097	41.099	41.024	41.005	40.749	40.741	40.484	40.323	40.287	
RHS LIP LEVEL	#			40.738	40.701	40.695	40.704	40.704	40.762	40.783	40.893	41.003	41.069	41.097	41.099	41.024	41.005	40.749	40.741	40.484	40.323	40.287	
DESIGN SURFACE		41.230	41.061	40.876	40.849	40.813	40.807	40.816	40.874	40.894	41.004	41.114	41.181	41.208	41.211	41.136	41.117	40.860	40.852	40.586	40.435	40.387	
EXISTING SURFACE		39.371	39.303	39.176	39.141	39.086	39.055	39.017	38.907	38.859	39.037	39.557	39.902	40.199	40.334	41.023	41.100	41.085	41.094	41.246	41.164	41.138	
CHAINAGES		0.000	5.639	13.713	15.639	20.000	22.541	25.639	36.263	40.000	60.000	80.000	92.060	100.000	102.880	120.000	122.060	140.000	140.420	152.090	158.484	160.000	
HORIZONTAL CURVES				R30.000																			R-11.500

ROAD 12 # REFER INTERSECTION DRAWINGS FOR LIP LEVELS

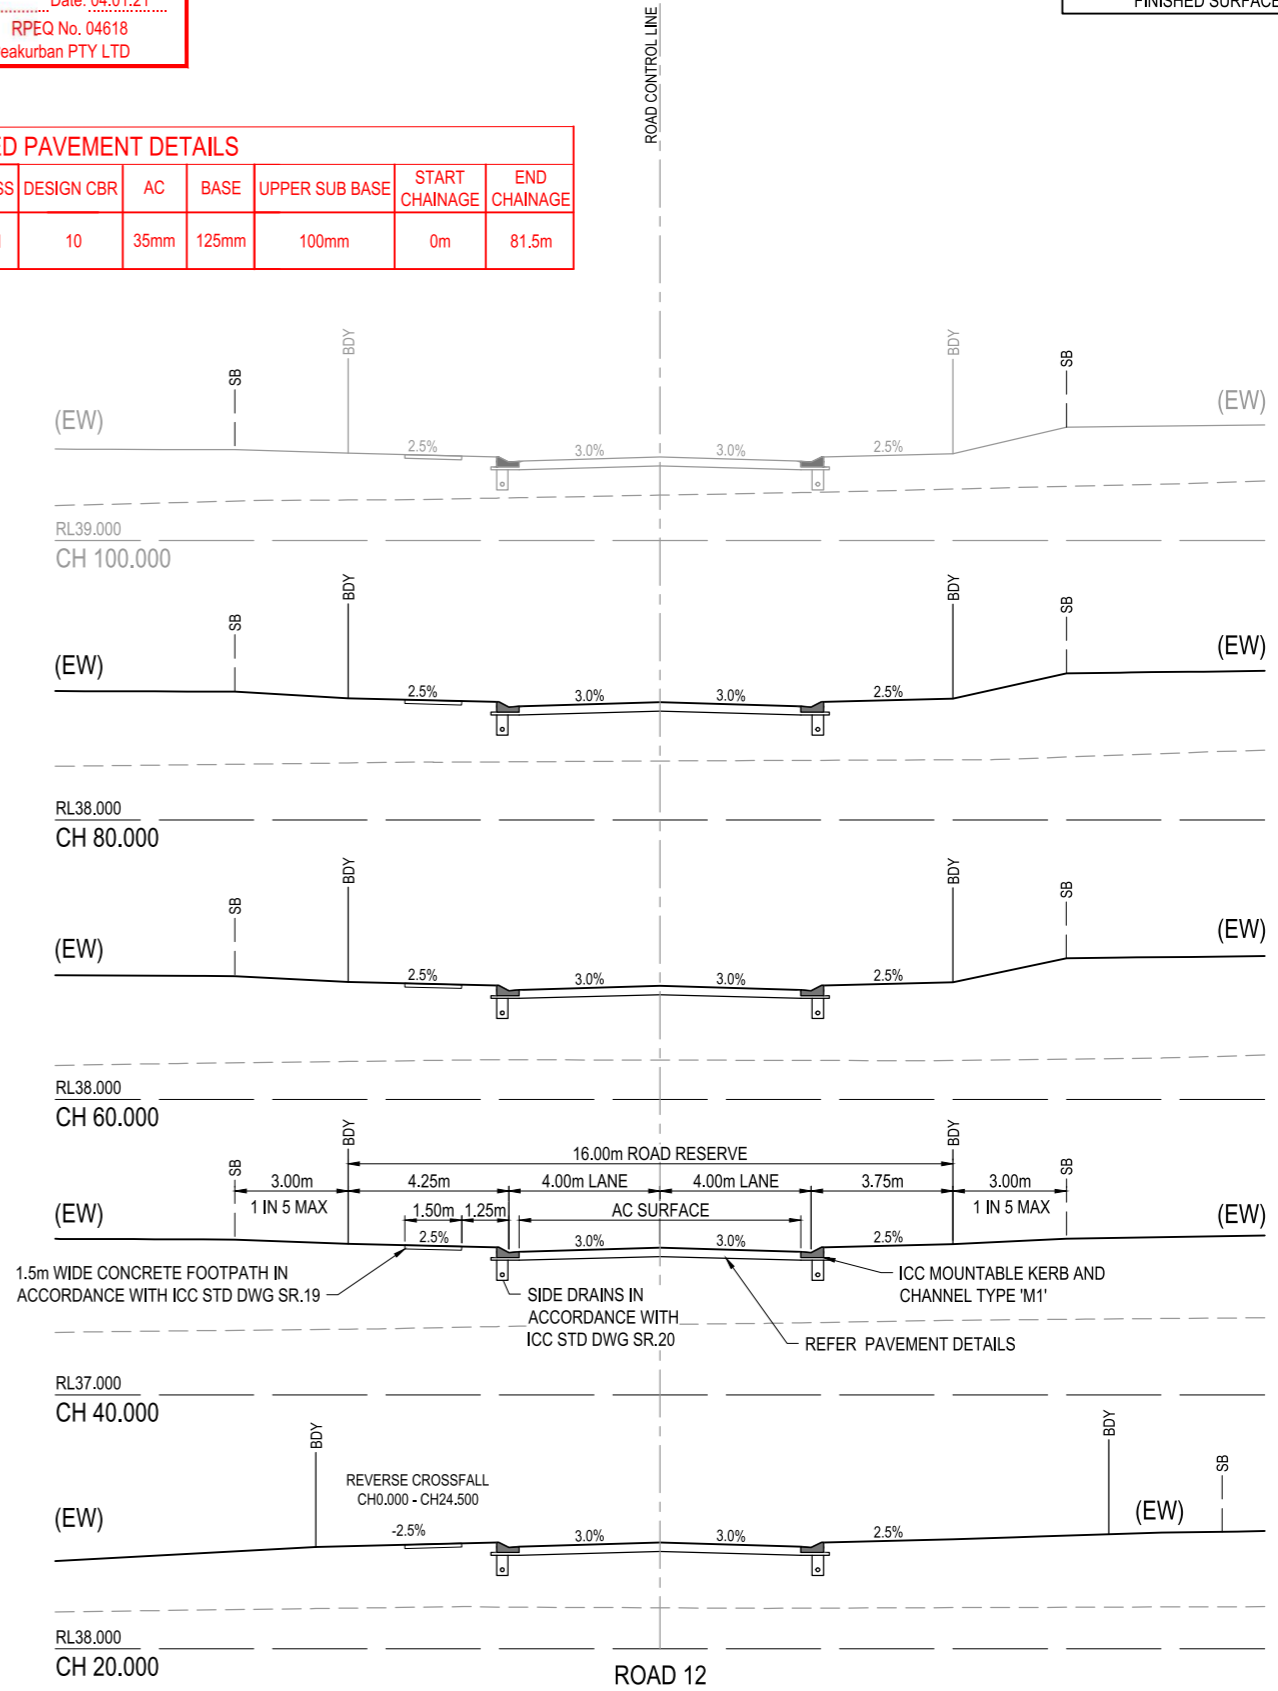

REV	DATE	DESIGN	DRAWN	REVISION DETAILS
A	29.07.20	AC	JW	ISSUED FOR CONSTRUCTION
B	29.09.20	AC	SC	ROAD 6 CUTBACK, DRAINAGE LINE UPDATED & STAGE NAME CHANGED
C	04.01.21	TD	JW	AS CONSTRUCTED

DRAWN	STATUS
AS CONSTRUCTED	APPROVED
SCOTT THOMAS	RPEQ 04618

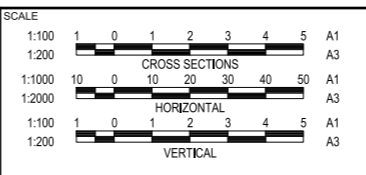

CLIENT: CANBERRA ESTATES CONSORTIUM NO.36 PTY LIMITED
 ASSOCIATED CONSULTANT: SAUNDERS HAVILL GROUP 1300 123 744

PROJECT NAME: WOODLINKS STAGE 9A
 COLLINGWOOD DRIVE, COLLINGWOOD PARK

DRAWING TITLE		
ROAD 12 LONGITUDINAL AND CROSS SECTIONS		
PROJECT No.	DRAWING No.	REVISION
18-0175	111	C

LEGEND





- PROPOSED ROAD CONTROL LINE
- PROPOSED KERB INVERT LINE
- PROPOSED KERB TRANSITION LOCATION
- PROPOSED CONCRETE PATH AND PRAM RAMP
- PROPOSED NEW ROAD PAVEMENT
- INDICATIVE DRIVEWAY LOCATION
- PROPOSED PAVEMENT CONTOUR (0.2m INTERVAL)
- PROPOSED STORMWATER DRAINAGE PIPE
- PROPOSED SEWERAGE MAIN
- PROPOSED WATER MAIN
- PROPOSED WATER CONDUIT
- PROPOSED KERB SETOUT LINE
- PROPOSED KERB SETOUT START POINT
- PROPOSED KERB SETOUT END POINT
- PROPOSED KERB SETOUT TANGENT POINT

WARNING! - EXISTING SERVICES

EXTREME CARE SHOULD BE TAKEN WHEN EXCAVATING IN THIS AREA. THE FOLLOWING EXISTING SERVICES ARE LIKELY TO BE PRESENT IN THE VICINITY OF THE SITE:

- ELECTRICAL CABLES
- TELECOMMUNICATIONS CABLES
- GAS MAINS
- WATER MAINS
- SEWER MAINS


THE CONTRACTOR SHOULD CONTACT THE SERVICE PROVIDER FOR FURTHER INFORMATION AND SATISFY THEMSELVES OF ANY SPECIFIC TREATMENT OR REQUIREMENTS.

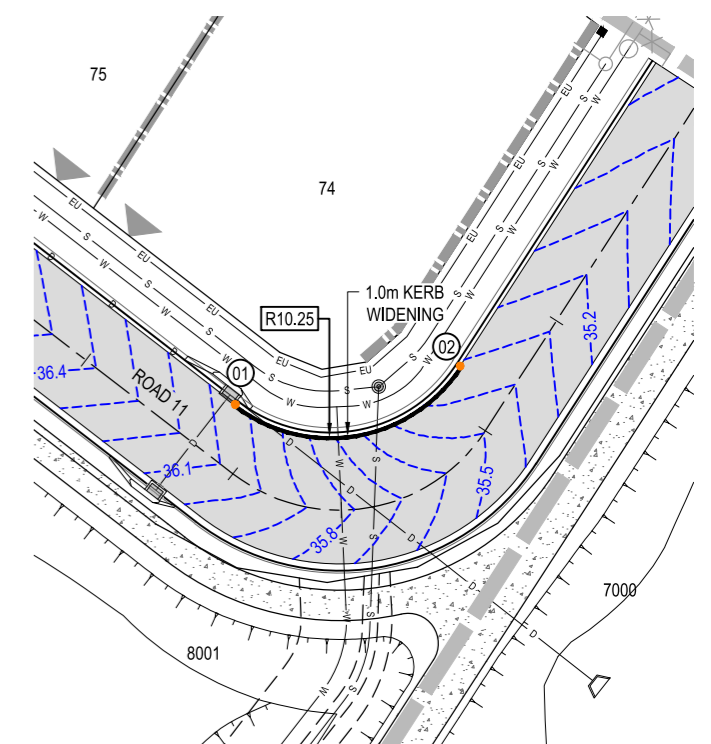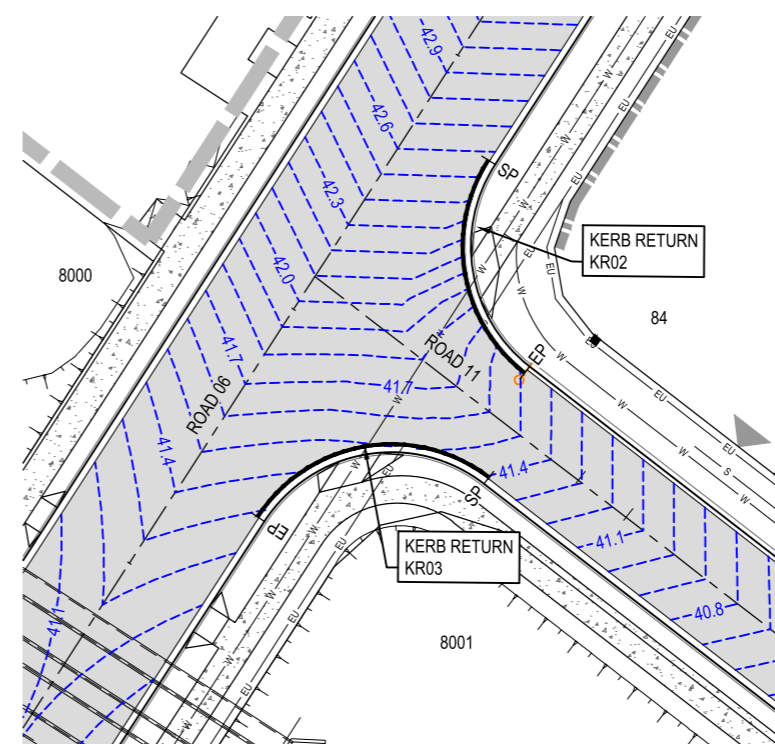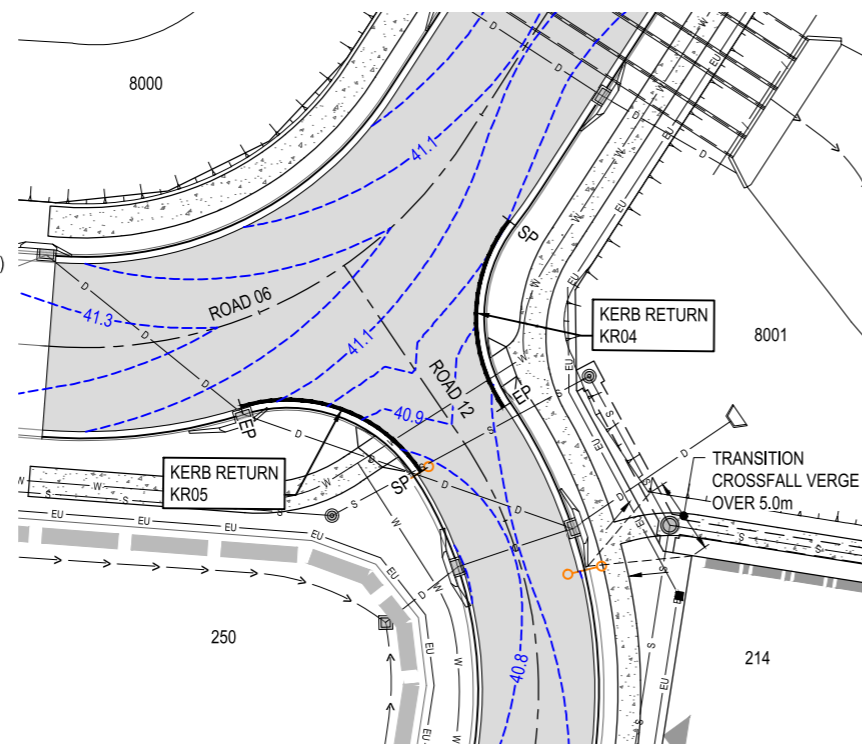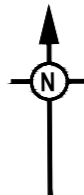


KERB WIDENING SETOUT

NUMBER	EASTING	NORTHING
01	6058.824	3457.844
02	6073.707	3460.384


NOTE:
REFER TO SURVEYORS AS-CONSTRUCTED DRAWINGS FOR FINISHED SURFACE LEVELS

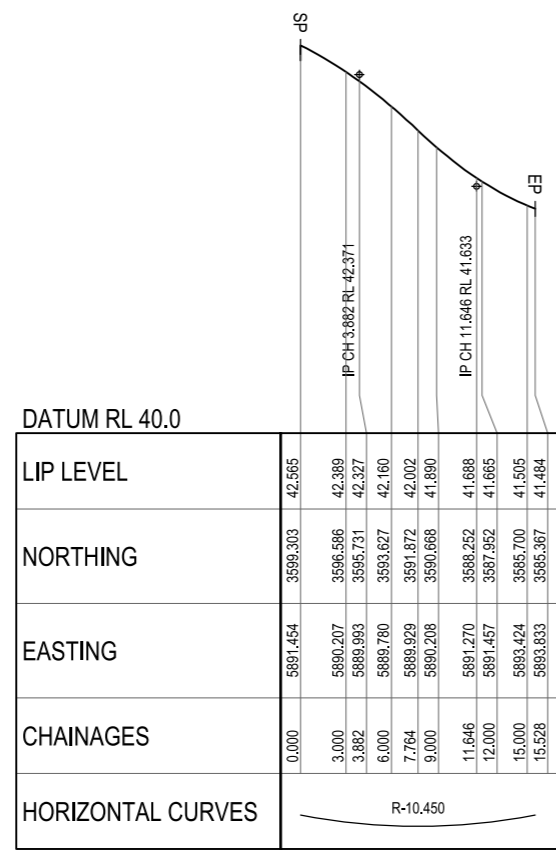


KR02

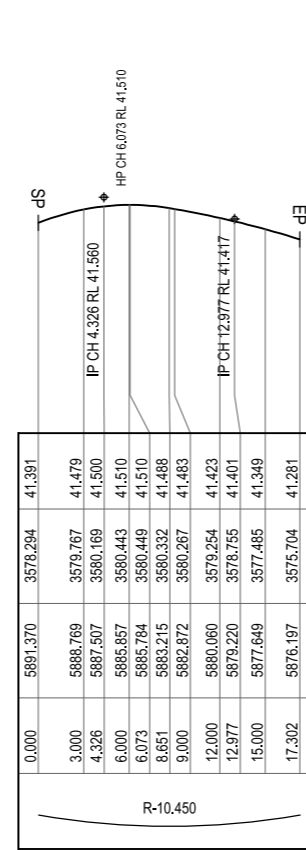

KR03

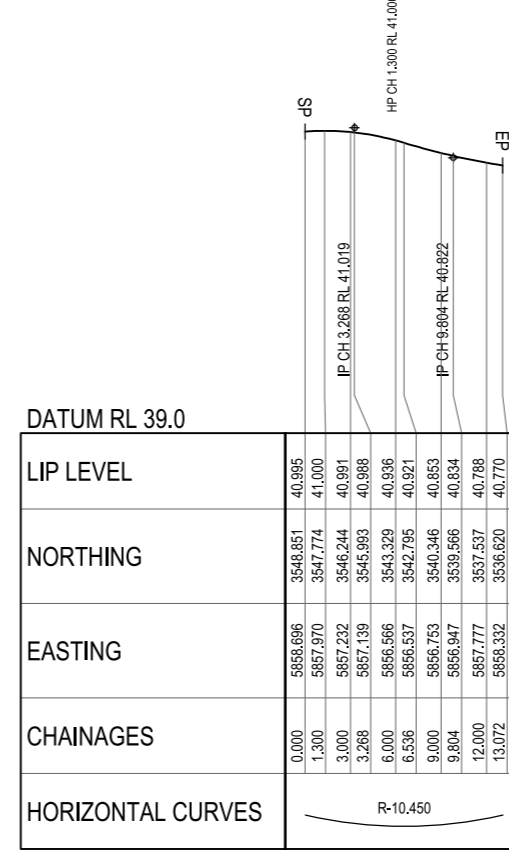

KR04

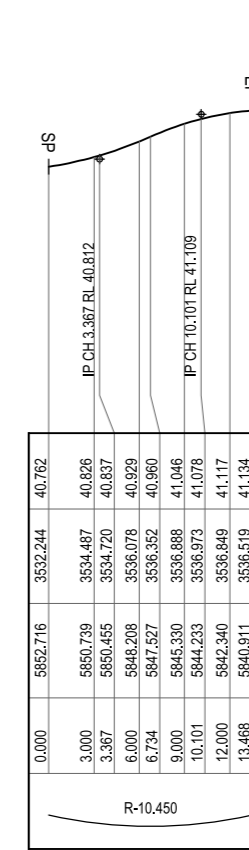

KR05


AS-CONSTRUCTED CERTIFICATION

Signature: *Scott Thomas* Date: 04.01.21
SCOTT THOMAS RPEQ No. 04618
 For and on behalf of Peakurban PTY LTD

REV	DATE	DESIGN	DRAWN	REVISION DETAILS
A	29.07.20	AC	JW	ISSUED FOR CONSTRUCTION
B	19.08.20	AC	SC	AMENDED KERB WIDENING SETOUT
C	23.09.20	AC	SC	ROAD 6 CUTBACK, DRAINAGE LINE UPDATED & STAGE NAME CHANGED
D	04.01.21	TD	JW	AS CONSTRUCTED

DRAWN	STATUS
AS CONSTRUCTED	

PEAKURBAN
 DEVELOPMENT ENGINEERS - ADVISORS
 ENQUIRIES@PEAKURBAN.COM.AU

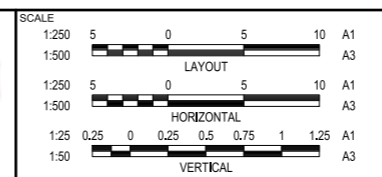


CLIENT
CANBERRA ESTATES CONSORTIUM NO.36 PTY LIMITED

ASSOCIATED CONSULTANT
SAUNDERS HAVILL GROUP
 1300 123 744


PROJECT NAME
WOODLINKS STAGE 9A

COLLINGWOOD DRIVE,
 COLLINGWOOD PARK

DRAWING TITLE		
INTERSECTION DETAILS LAYOUT PLAN		
PROJECT No.	DRAWING No.	REVISION
18-0175	112	D

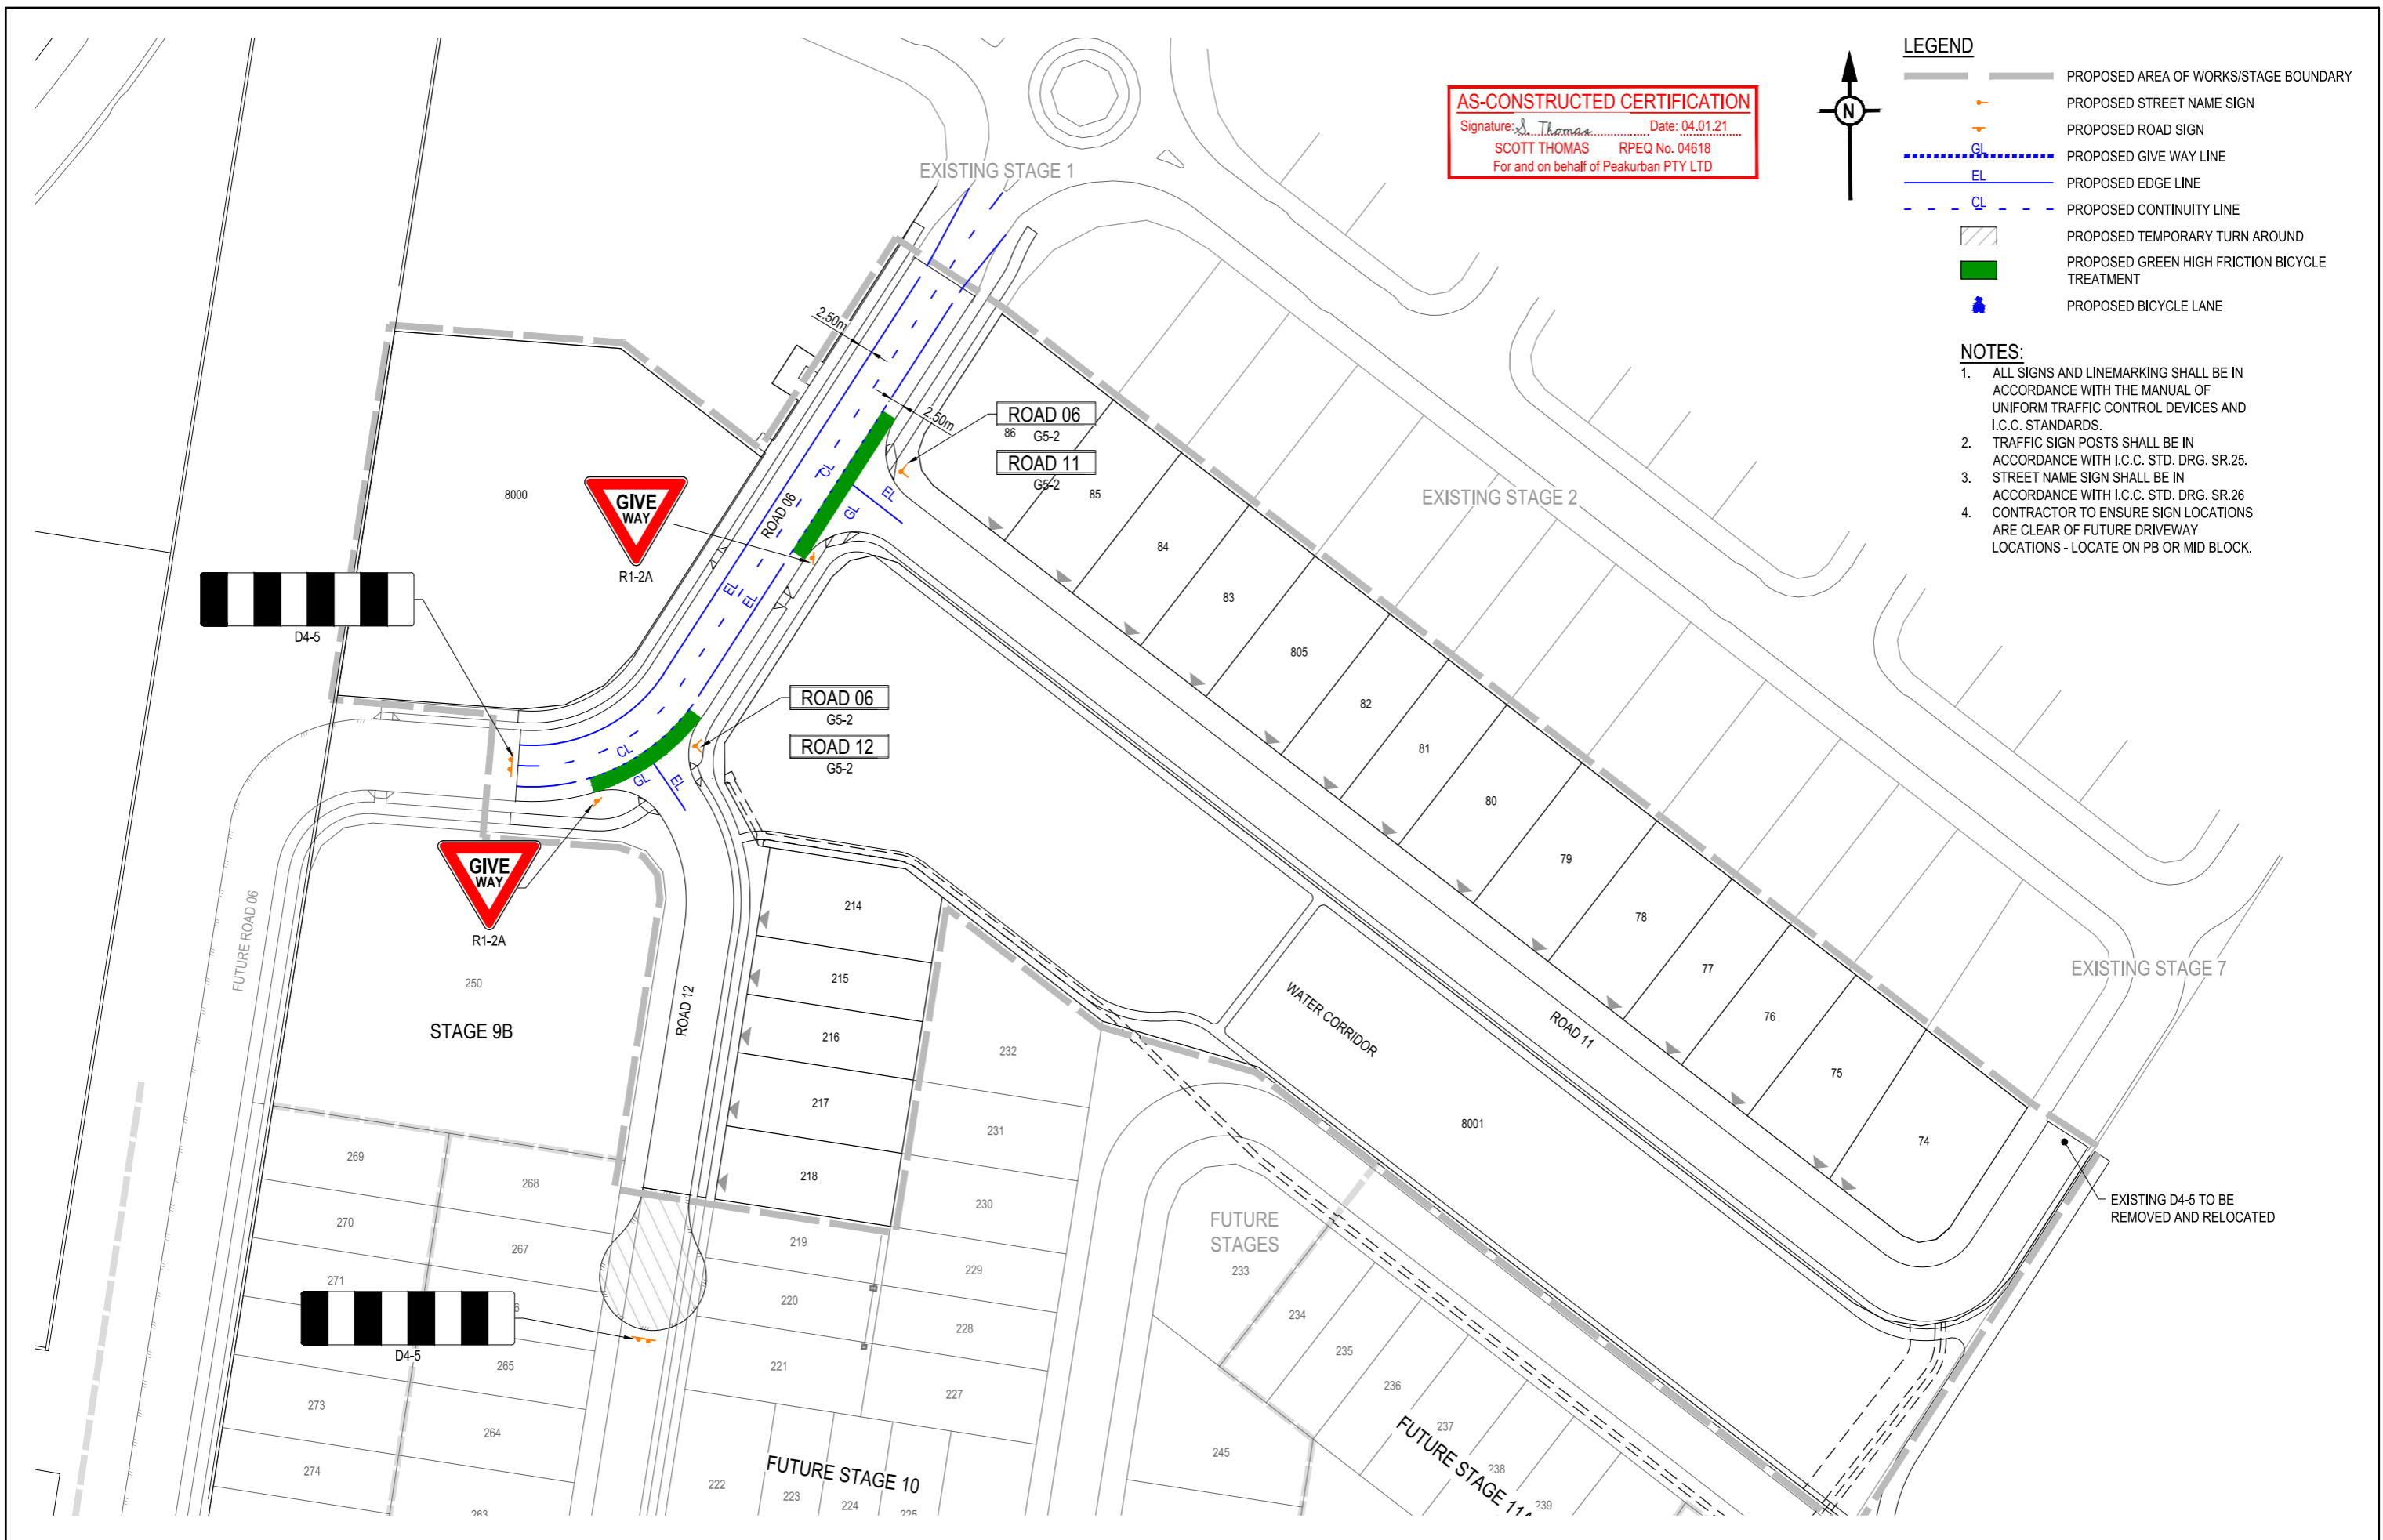

AS-CONSTRUCTED CERTIFICATION
 Signature: *S. Thomas* Date: 04.01.21
 SCOTT THOMAS RPEQ No. 04618
 For and on behalf of Peakurban PTY LTD

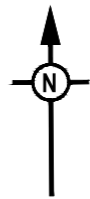


- LEGEND**
- PROPOSED AREA OF WORKS/STAGE BOUNDARY
 - PROPOSED STREET NAME SIGN
 - PROPOSED ROAD SIGN
 - PROPOSED GIVE WAY LINE
 - PROPOSED EDGE LINE
 - PROPOSED CONTINUITY LINE
 - PROPOSED TEMPORARY TURN AROUND
 - PROPOSED GREEN HIGH FRICTION BICYCLE TREATMENT
 - PROPOSED BICYCLE LANE

- NOTES:**
1. ALL SIGNS AND LINEMARKING SHALL BE IN ACCORDANCE WITH THE MANUAL OF UNIFORM TRAFFIC CONTROL DEVICES AND I.C.C. STANDARDS.
 2. TRAFFIC SIGN POSTS SHALL BE IN ACCORDANCE WITH I.C.C. STD. DRG. SR.25.
 3. STREET NAME SIGN SHALL BE IN ACCORDANCE WITH I.C.C. STD. DRG. SR.26
 4. CONTRACTOR TO ENSURE SIGN LOCATIONS ARE CLEAR OF FUTURE DRIVEWAY LOCATIONS - LOCATE ON PB OR MID BLOCK.

REV	DATE	DESIGN	DRAWN	REVISION DETAILS	DRAWN	STATUS
A	29.07.20	AC	JW	ISSUED FOR CONSTRUCTION		<p style="text-align: center;">AS CONSTRUCTED</p> <p style="text-align: center;">APPROVED SCOTT THOMAS RPEQ 04618</p> <p style="text-align: center;">FOR AND ON BEHALF OF PEAKURBAN PTY LTD</p>
B	29.09.20	AC	SC	ROAD 6 CUTBACK, DRAINAGE LINE UPDATED & STAGE NAME CHANGED		
C	04.01.21	TD	JW	AS CONSTRUCTED		

 PEAKURBAN DEVELOPMENT ENGINEERS + ADVISORS ENQUIRIES@PEAKURBAN.COM.AU	SCALE 1:500 10 5 0 10 20 A1 1:1000	CLIENT CANBERRA ESTATES CONSORTIUM NO.36 PTY LIMITED ASSOCIATED CONSULTANT SAUNDERS HAVILL GROUP 1300 123 744	PROJECT NAME WOODLINKS STAGE 9A COLLINGWOOD DRIVE, COLLINGWOOD PARK	DRAWING TITLE SIGNS AND LINEMARKING LAYOUT PLAN PROJECT No. 18-0175 DRAWING No. 113 REVISION C
---	--	--	---	---

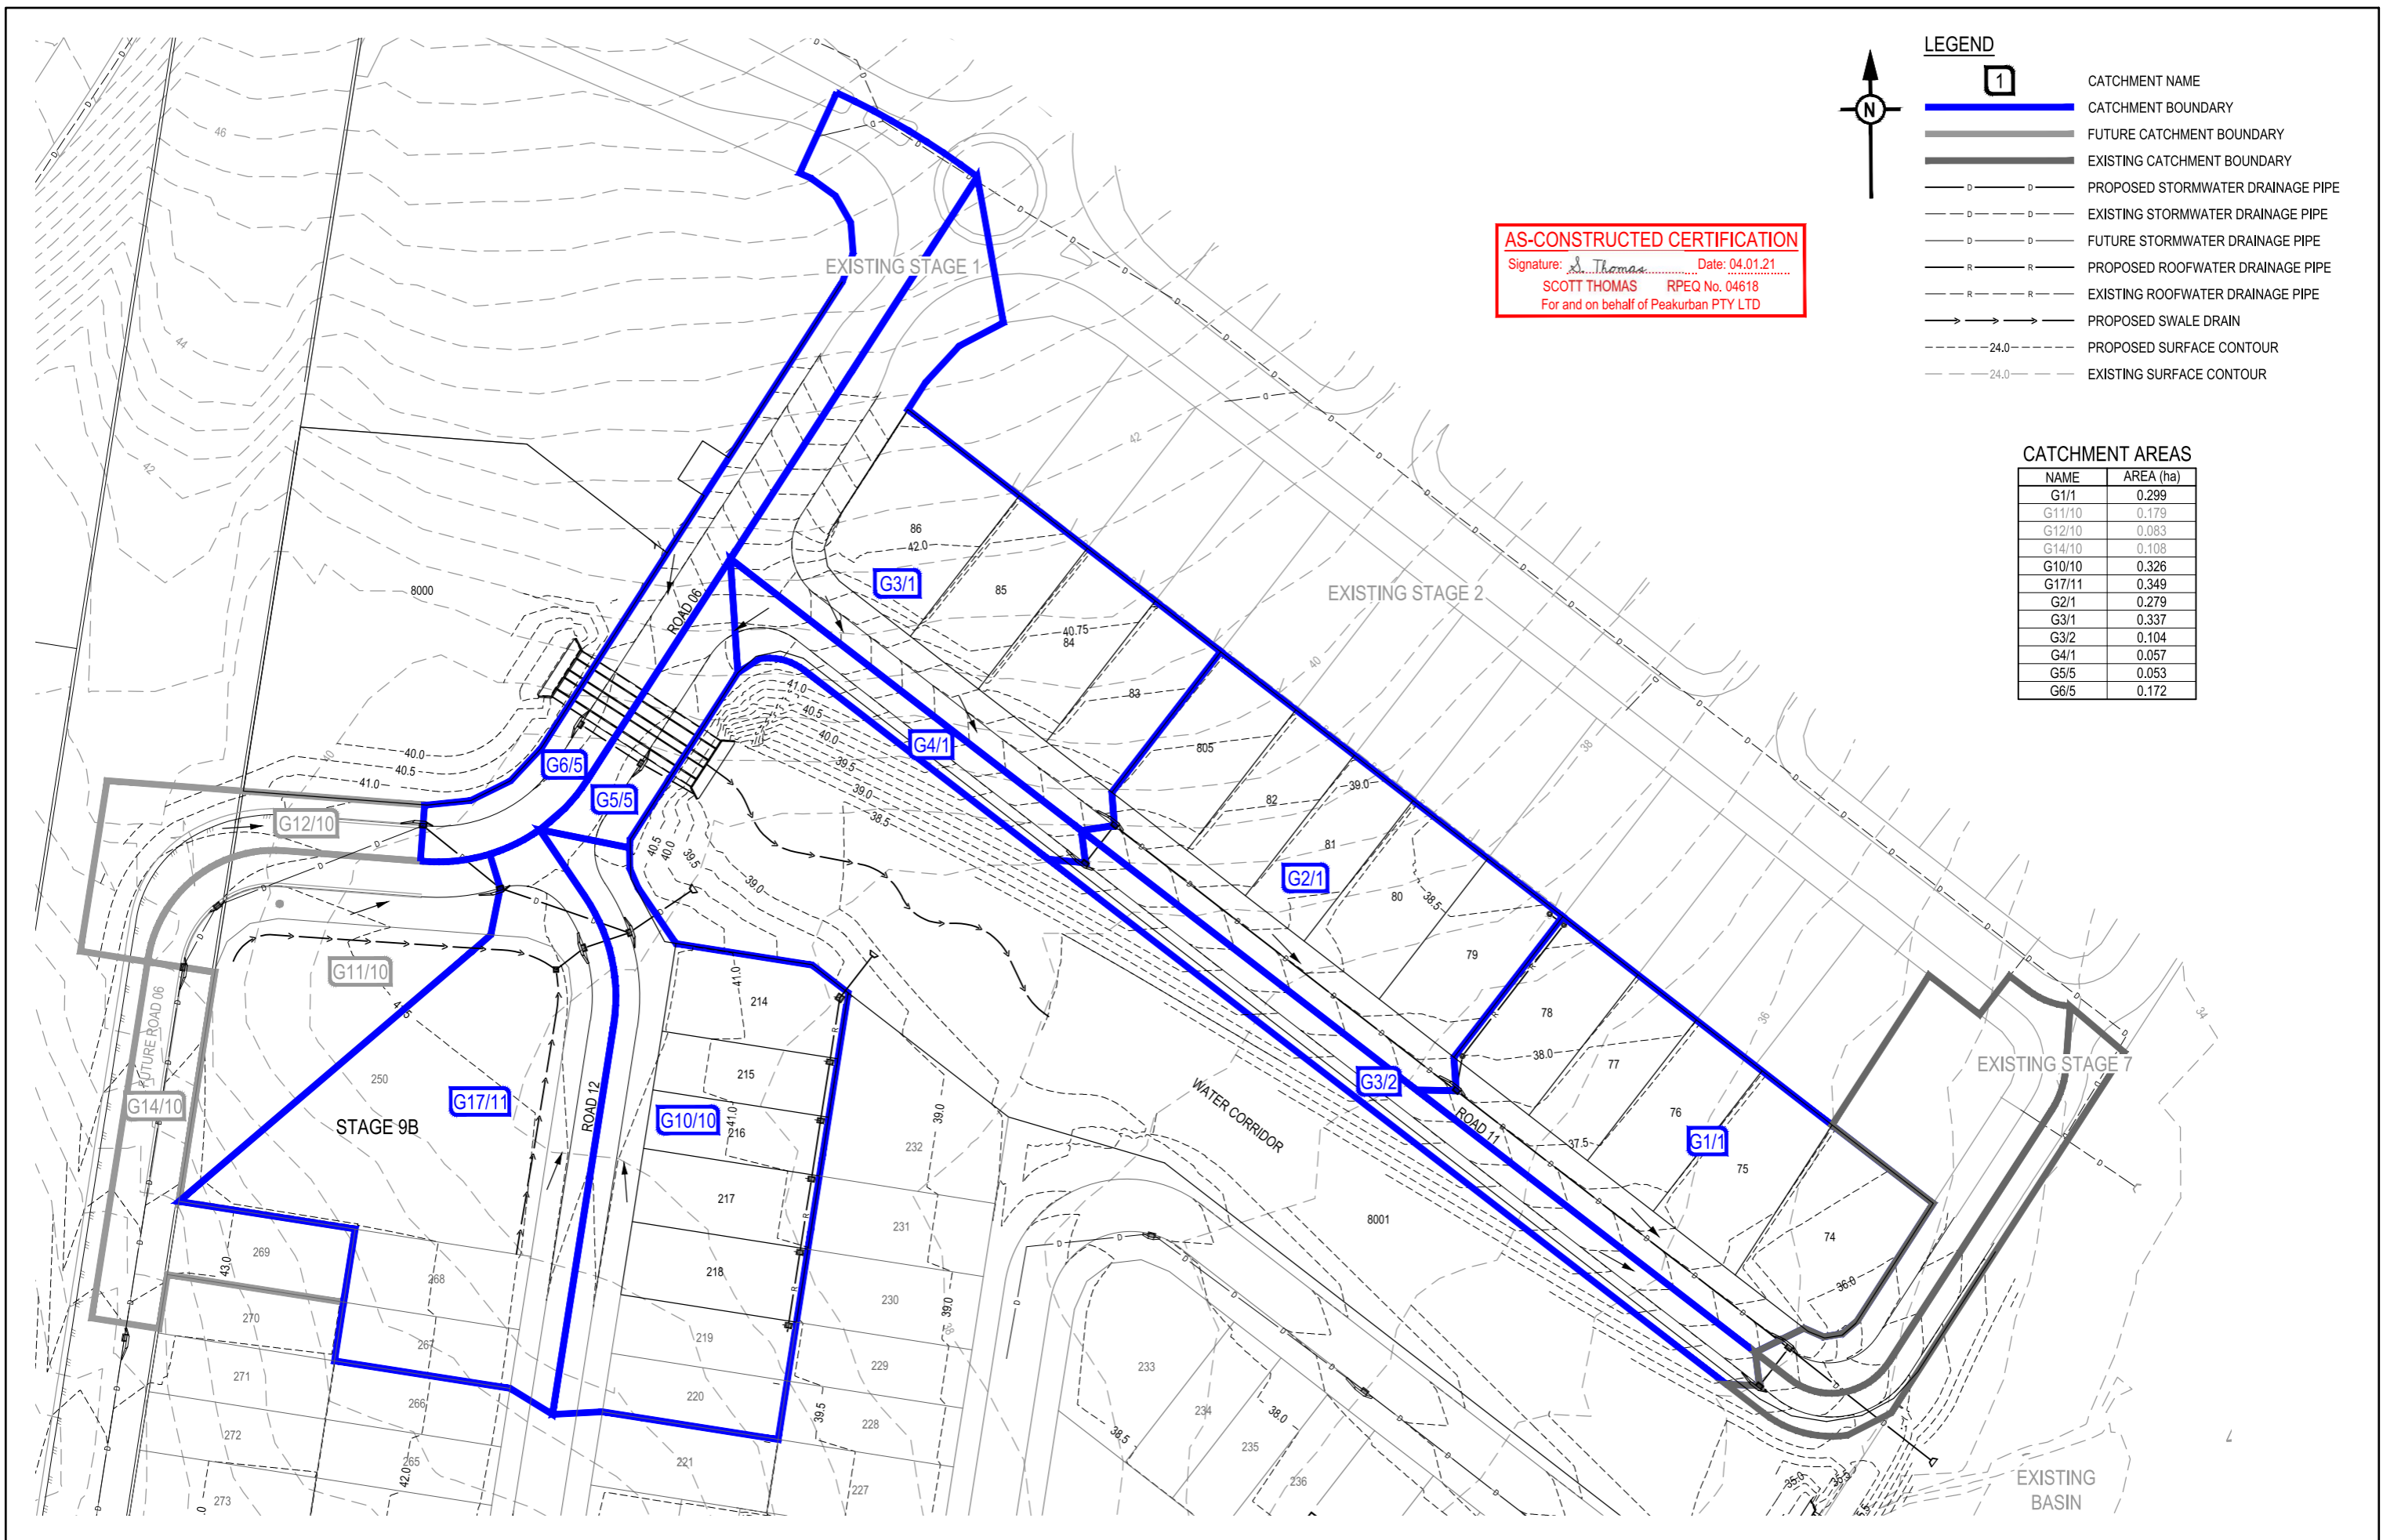

AS-CONSTRUCTED CERTIFICATION
 Signature: *S. Thomas* Date: 04.01.21
 SCOTT THOMAS RPEQ No. 04618
 For and on behalf of Peakurban PTY LTD

LEGEND

	CATCHMENT NAME
	CATCHMENT BOUNDARY
	FUTURE CATCHMENT BOUNDARY
	EXISTING CATCHMENT BOUNDARY
	PROPOSED STORMWATER DRAINAGE PIPE
	EXISTING STORMWATER DRAINAGE PIPE
	FUTURE STORMWATER DRAINAGE PIPE
	PROPOSED ROOFWATER DRAINAGE PIPE
	EXISTING ROOFWATER DRAINAGE PIPE
	PROPOSED SWALE DRAIN
	PROPOSED SURFACE CONTOUR
	EXISTING SURFACE CONTOUR

CATCHMENT AREAS

NAME	AREA (ha)
G1/1	0.299
G11/10	0.179
G12/10	0.083
G14/10	0.108
G10/10	0.326
G17/11	0.349
G2/1	0.279
G3/1	0.337
G3/2	0.104
G4/1	0.057
G5/5	0.053
G6/5	0.172

REV	DATE	DESIGN	DRAWN	REVISION DETAILS
A	29.07.20	AC	JW	ISSUED FOR CONSTRUCTION
B	29.09.20	AC	SC	ROAD 6 CUTBACK, DRAINAGE LINE UPDATED & STAGE NAME CHANGED
C	04.01.21	TD	JW	AS CONSTRUCTED

DRAWN	STATUS
	AS CONSTRUCTED
DESIGN	APPROVED SCOTT THOMAS RPEQ 04618
	FOR AND ON BEHALF OF PEAKURBAN PTY LTD

PEAKURBAN
 DEVELOPMENT ENGINEERS + ADVISORS
 ENQUIRIES@PEAKURBAN.COM.AU

SCALE
 1:500 10 5 0 10 20 A1
 1:1000






CLIENT
**CANBERRA ESTATES
 CONSORTIUM NO.36 PTY LIMITED**
 ASSOCIATED CONSULTANT
 SAUNDERS HAVILL GROUP
 1300 123 744

PROJECT NAME
WOODLINKS STAGE 9A
 COLLINGWOOD DRIVE,
 COLLINGWOOD PARK

DRAWING TITLE
**STORMWATER DRAINAGE
 CATCHMENT LAYOUT PLAN**
 PROJECT No. **18-0175**
 DRAWING No. **114**
 REVISION **C**

STRUCTURE NAME
STRUCTURE DESCRIPTION

STORMWATER STRUCTURE NOTE:
 STANDARD ROUND MANHOLES LESS THAN 3.0m DEEP:
 CONSTRUCT IN ACCORDANCE WITH THE LOCAL AUTHORITY STANDARDS.
 STANDARD ROUND MANHOLES 3.0m > 5.3m DEEP:
 CONSTRUCT IN ACCORDANCE WITH TMR STD DRAWINGS 1307 AND 1308.
 STANDARD ROUND MANHOLES GREATER THAN 5.3m DEEP:
 SHALL BE STRUCTURALLY DESIGNED (CERTIFIED) AND CONSTRUCTED BY CONTRACTOR ON A CASE BY CASE BASIS.
 ROUND EXTENDED (900mm MAX) MANHOLES:
 CONSTRUCT IN ACCORDANCE WITH PEAK URBAN STD DRAWINGS S-101 & S-102.
 RECTANGULAR STRUCTURE (SPECIAL):
 SHALL BE STRUCTURALLY DESIGNED (CERTIFIED) AND CONSTRUCTED BY CONTRACTOR ON A CASE BY CASE BASIS.

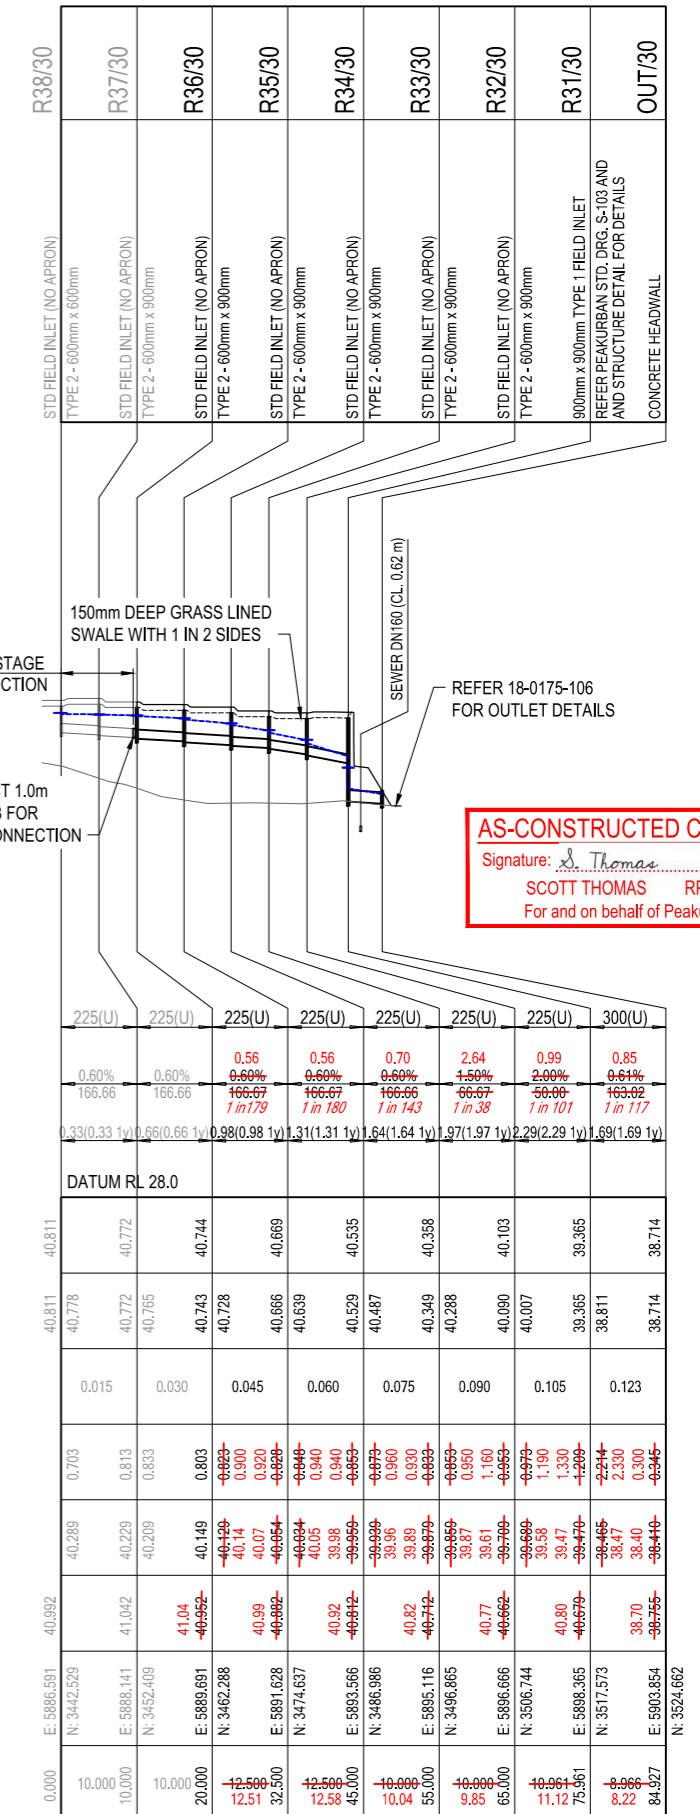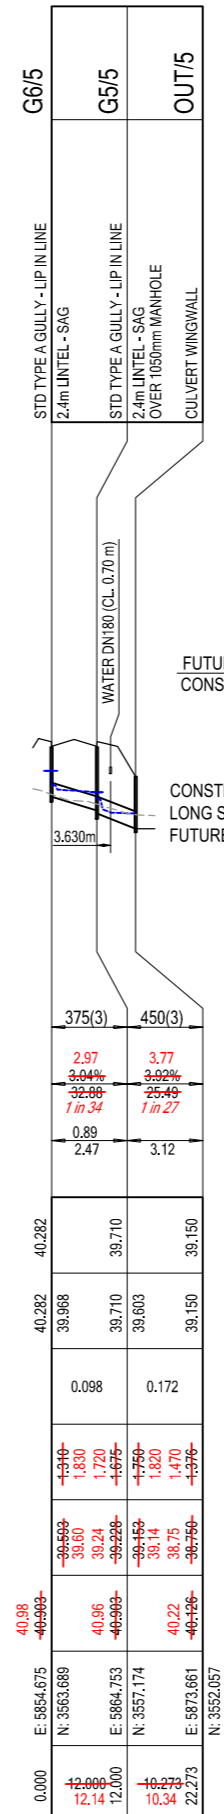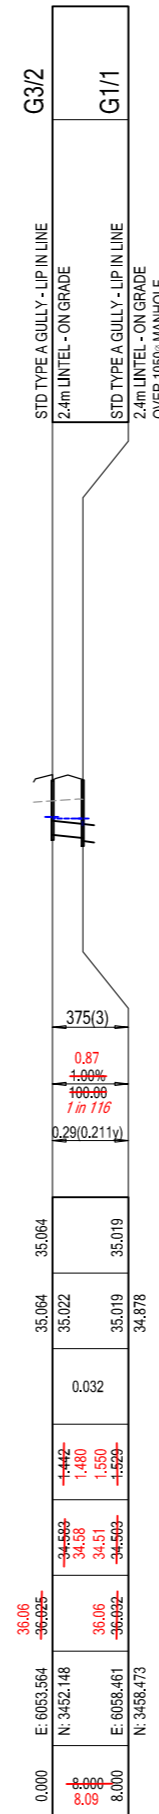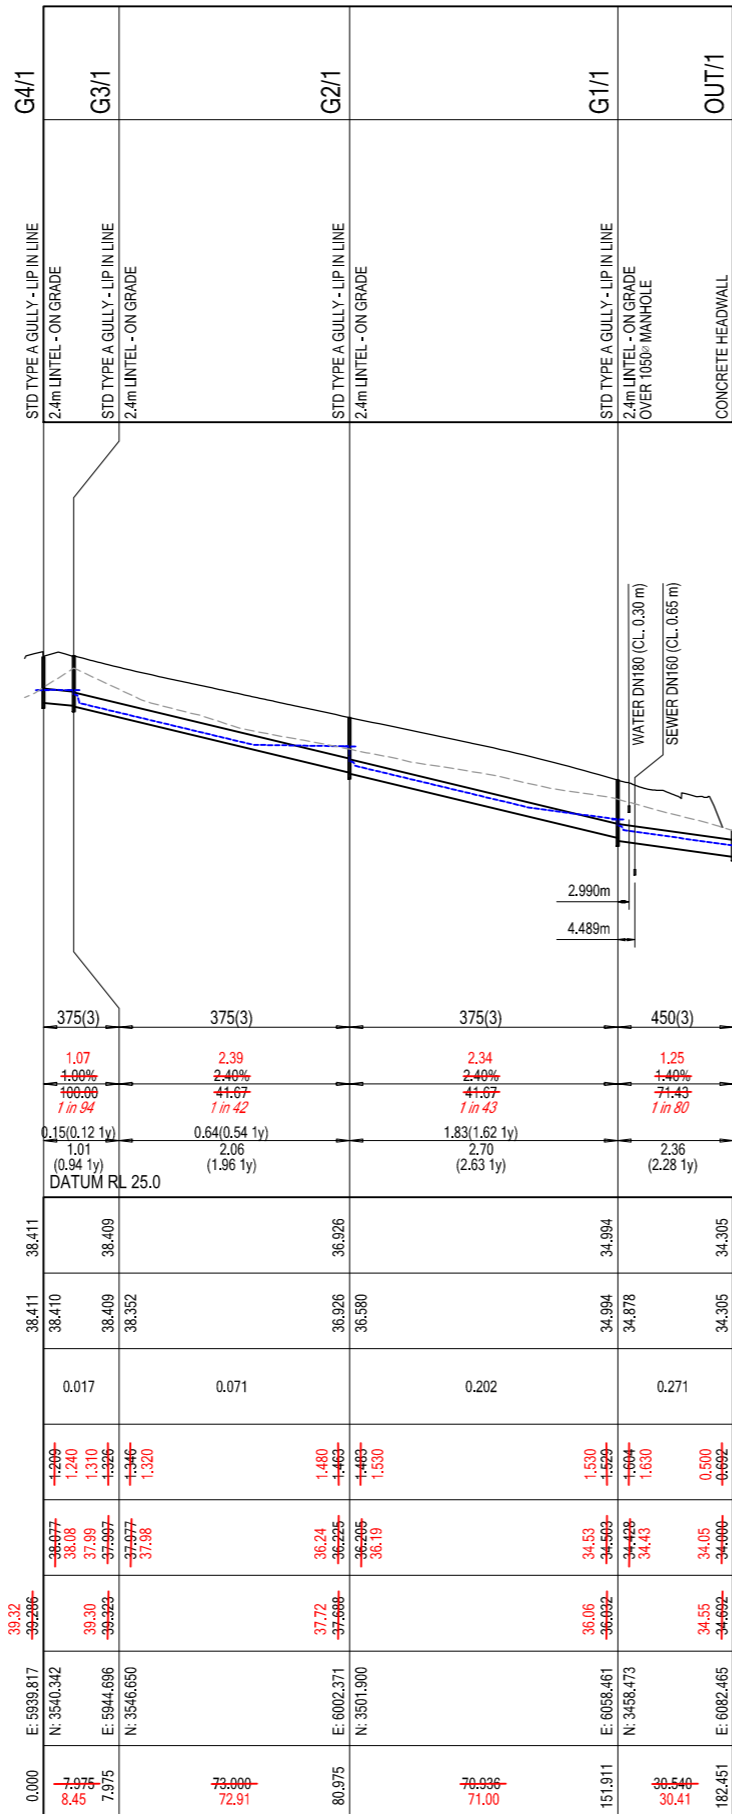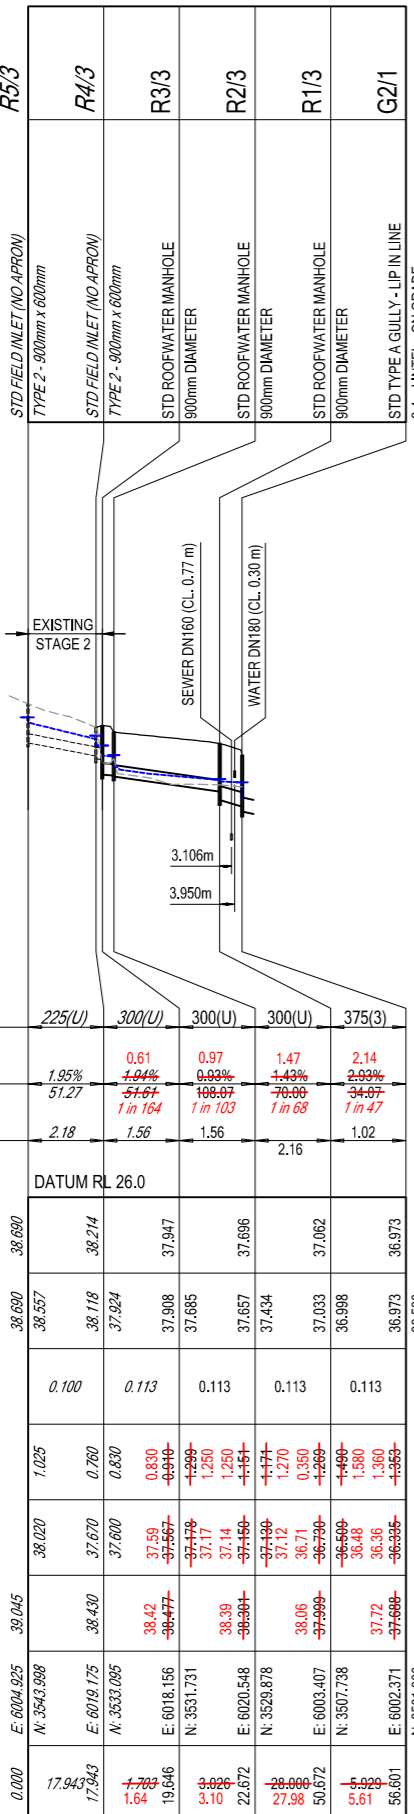

PIPE SIZE (mm Class)	225(U)	300(U)	300(U)	300(U)	375(3)
PIPE GRADE %	1.95%	0.61%	0.97%	1.47%	2.14%
PIPE SLOPE 1 in X	51.27	51.61	108.07	70.00	34.67
FULL PIPE FLOW VELOCITY (m/s)	2.18	1.56	1.56	2.16	1.02
PART FULL FLOW VELOCITY (m/s)					
DATUM RL	26.0				
WATER LEVEL IN STRUCTURE	38.680	38.214	37.947	37.696	36.973
HYDRAULIC GRADE LEVEL	38.357	37.924	37.685	37.434	36.973
PIPE FLOW (Cumecs)	0.100	0.113	0.113	0.113	0.113
DEPTH TO INVERT	1.025	0.830	1.289	1.174	1.365
INVERT LEVEL OF DRAIN	38.020	37.670	37.567	37.117	36.608
DESIGN SURFACE LEVEL	38.045	38.430	38.477	38.39	37.72
SETOUT	E: 6004.925	E: 6019.175	E: 6018.156	E: 6020.548	E: 6003.407
RUNNING CHAINAGE	17.943	19.846	22.872	27.38	53.801

PIPE SIZE (mm Class)	375(3)	375(3)	375(3)	450(3)
PIPE GRADE %	1.07%	2.39%	2.40%	1.25%
PIPE SLOPE 1 in X	100.00	41.67	41.67	71.43
FULL PIPE FLOW VELOCITY (m/s)	0.15	0.64	1.83	2.36
PART FULL FLOW VELOCITY (m/s)				
DATUM RL	25.0			
WATER LEVEL IN STRUCTURE	38.411	38.409	36.926	34.305
HYDRAULIC GRADE LEVEL	38.410	38.409	36.926	34.305
PIPE FLOW (Cumecs)	0.017	0.071	0.202	0.271
DEPTH TO INVERT	1.209	1.240	1.480	1.530
INVERT LEVEL OF DRAIN	38.077	37.699	36.225	34.405
DESIGN SURFACE LEVEL	39.32	39.30	37.72	34.55
SETOUT	E: 5939.817	E: 5944.696	E: 6002.371	E: 6082.465
RUNNING CHAINAGE	7.077	7.975	80.975	182.451

PIPE SIZE (mm Class)	375(3)
PIPE GRADE %	0.87%
PIPE SLOPE 1 in X	100.00
FULL PIPE FLOW VELOCITY (m/s)	0.29
PART FULL FLOW VELOCITY (m/s)	
DATUM RL	28.0
WATER LEVEL IN STRUCTURE	35.064
HYDRAULIC GRADE LEVEL	35.022
PIPE FLOW (Cumecs)	0.032
DEPTH TO INVERT	1.442
INVERT LEVEL OF DRAIN	34.53
DESIGN SURFACE LEVEL	36.06
SETOUT	E: 6053.564
RUNNING CHAINAGE	8.000


PIPE SIZE (mm Class)	375(3)	450(3)
PIPE GRADE %	2.97%	3.77%
PIPE SLOPE 1 in X	32.68	25.49
FULL PIPE FLOW VELOCITY (m/s)	0.89	3.12
PART FULL FLOW VELOCITY (m/s)		
DATUM RL	28.0	
WATER LEVEL IN STRUCTURE	40.282	39.150
HYDRAULIC GRADE LEVEL	39.988	39.150
PIPE FLOW (Cumecs)	0.098	0.172
DEPTH TO INVERT	1.340	1.376
INVERT LEVEL OF DRAIN	38.940	37.774
DESIGN SURFACE LEVEL	40.98	40.22
SETOUT	E: 5954.675	E: 5873.661
RUNNING CHAINAGE	12.000	22.273

PIPE SIZE (mm Class)	225(U)	225(U)	225(U)	225(U)	225(U)	225(U)	225(U)	300(U)
PIPE GRADE %	0.60%	0.60%	0.56%	0.56%	0.70%	2.64%	2.00%	0.85%
PIPE SLOPE 1 in X	166.66	166.66	166.67	166.67	166.66	66.67	50.00	163.82
FULL PIPE FLOW VELOCITY (m/s)	0.33	0.66	0.98	1.31	1.64	1.97	2.29	2.69
PART FULL FLOW VELOCITY (m/s)								
DATUM RL	28.0							
WATER LEVEL IN STRUCTURE	40.811	40.772	40.744	40.669	40.535	40.358	40.103	38.714
HYDRAULIC GRADE LEVEL	40.778	40.772	40.744	40.666	40.529	40.487	40.080	38.714
PIPE FLOW (Cumecs)	0.015	0.030	0.045	0.060	0.075	0.090	0.105	0.123
DEPTH TO INVERT	0.703	0.813	0.833	0.803	0.900	1.160	1.190	1.330
INVERT LEVEL OF DRAIN	40.289	40.229	40.149	40.114	39.988	39.811	39.470	38.440
DESIGN SURFACE LEVEL	40.982	41.042	41.04	40.99	40.92	40.77	40.80	38.70
SETOUT	E: 5886.591	E: 5888.141	E: 5889.691	E: 5891.628	E: 5893.566	E: 5895.116	E: 5896.666	E: 5903.854
RUNNING CHAINAGE	10.000	10.000	12.500	12.500	10.000	10.000	11.112	8.22

AS-CONSTRUCTED CERTIFICATION
 Signature: *Scott Thomas* Date: 04.01.21
 SCOTT THOMAS RPEQ No. 04618
 For and on behalf of Peakurban PTY LTD

REV	DATE	DESIGN	DRAWN	REVISION DETAILS
A	29.07.20	AC	JW	ISSUED FOR CONSTRUCTION
B	19.08.20	AC	SC	AMENDED OUT/5 LOCATION
C	04.09.20	MG	MC	LINE 30 ADDED
D	29.09.20	AC	SC	ROAD 6 CUTBACK DRAINAGE LINE UPDATED & STAGE NAME CHANGED
E	15.12.20	TD	SC	AS CONSTRUCTED

AS CONSTRUCTED
 APPROVED
 SCOTT THOMAS RPEQ 04618
 FOR AND ON BEHALF OF PEAKURBAN PTY LTD

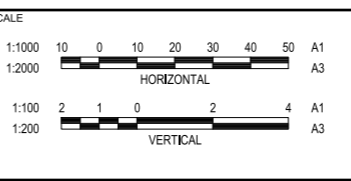

CLIENT
CANBERRA ESTATES CONSORTIUM NO.36 PTY LIMITED
 ASSOCIATED CONSULTANT
 SAUNDERS HAVILL GROUP
 1300 123 744

PROJECT NAME
WOODLINKS STAGE 9A
 COLLINGWOOD DRIVE,
 COLLINGWOOD PARK





DRAWING TITLE
STORMWATER DRAINAGE LONGITUDINAL SECTIONS SHEET 1 OF 2
 PROJECT No. 18-0175
 DRAWING No. 115
 REVISION E

STRUCTURE NAME	
STRUCTURE DESCRIPTION	

STORMWATER STRUCTURE NOTE:
 STANDARD ROUND MANHOLES LESS THAN 3.0m DEEP:
 CONSTRUCT IN ACCORDANCE WITH THE LOCAL AUTHORITY STANDARDS.
 STANDARD ROUND MANHOLES 3.0m > 5.3m DEEP:
 CONSTRUCT IN ACCORDANCE WITH TMR STD DRAWINGS 1307 AND 1308.
 STANDARD ROUND MANHOLES GREATER THAN 5.3m DEEP:
 SHALL BE STRUCTURALLY DESIGNED (CERTIFIED) AND CONSTRUCTED BY CONTRACTOR ON A CASE BY CASE BASIS.
 ROUND EXTENDED (900mm MAX) MANHOLES:
 CONSTRUCT IN ACCORDANCE WITH PEAK URBAN STD DRAWINGS S-101 & S-102.
 RECTANGULAR STRUCTURE (SPECIAL):
 SHALL BE STRUCTURALLY DESIGNED (CERTIFIED) AND CONSTRUCTED BY CONTRACTOR ON A CASE BY CASE BASIS.

PIPE SIZE (mm Class)	375(3)	375(3)	375(3)	450(3)	450(3)	525(3)	525(3)	600(3)
PIPE GRADE %	2.96%	1.38%	2.05%	0.86%	0.98%	2.14%	0.61%	0.95%
PIPE SLOPE 1 in X	33.81	72.23	48.81	116.21	102.29	56.40	141.47	133.26
FULL PIPE FLOW VELOCITY (m/s)	0.38(0.221v)	1.02(0.541v)	1.71(0.891v)	1.48(0.731v)	1.64(0.741v)	1.33(0.601v)	1.57(0.731v)	1.96(0.851v)
PART FULL FLOW VELOCITY (m/s)	1.91 (1.611y)	1.91 (1.611y)						

WATER LEVEL IN STRUCTURE	44.951	44.951	44.951	44.951	44.951	44.951	44.951	44.951	
HYDRAULIC GRADE LEVEL	44.765	42.975	42.837	42.121	41.867	41.162	41.087	40.298	
PIPE FLOW (Cumecs)	0.041	0.112	0.189	0.235	0.260	0.281	0.331	0.554	
DEPTH TO INVERT	1.500	1.480	1.500	1.392	1.412	1.743	1.763	1.600	
INVERT LEVEL OF DRAIN	44.671	42.482	42.462	41.479	41.459	39.705	39.353	38.665	
DESIGN SURFACE LEVEL	46.171	43.962	42.959	41.604	41.479	41.185	41.13	40.68	
SETOUT	E: 5755.519 N: 3316.357	E: 5767.005 N: 3392.467	E: 5778.027 N: 3462.606	E: 5787.478 N: 3522.740	E: 5793.273 N: 3533.126	E: 5828.039 N: 3546.632	E: 5841.043 N: 3536.089	E: 5862.822 N: 3528.563	E: 5873.297 N: 3535.663
RUNNING CHAINAGE	0.000	74.007	71.000	145.007	60.872	205.879	11.893	217.772	37.297

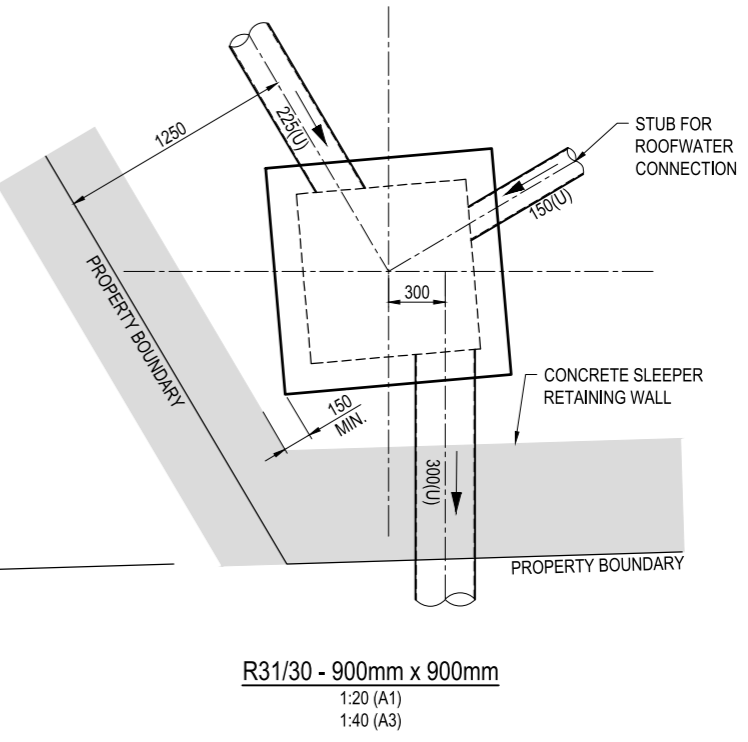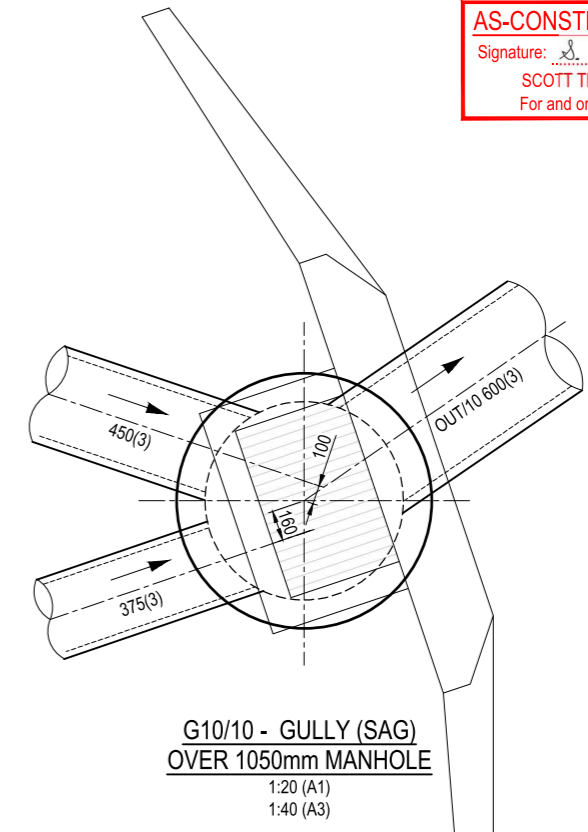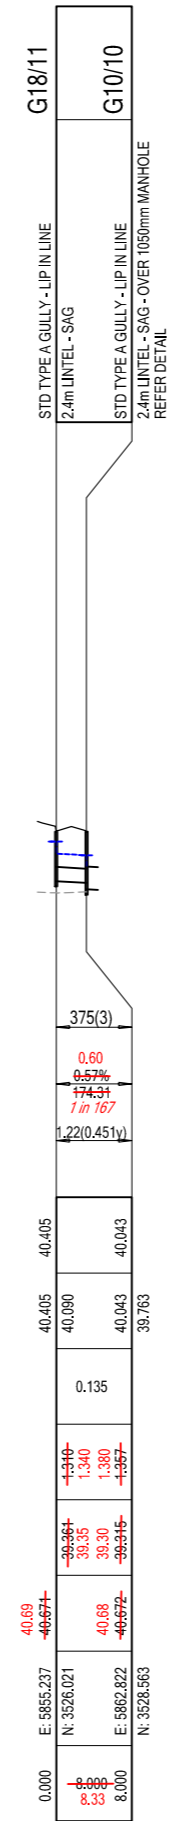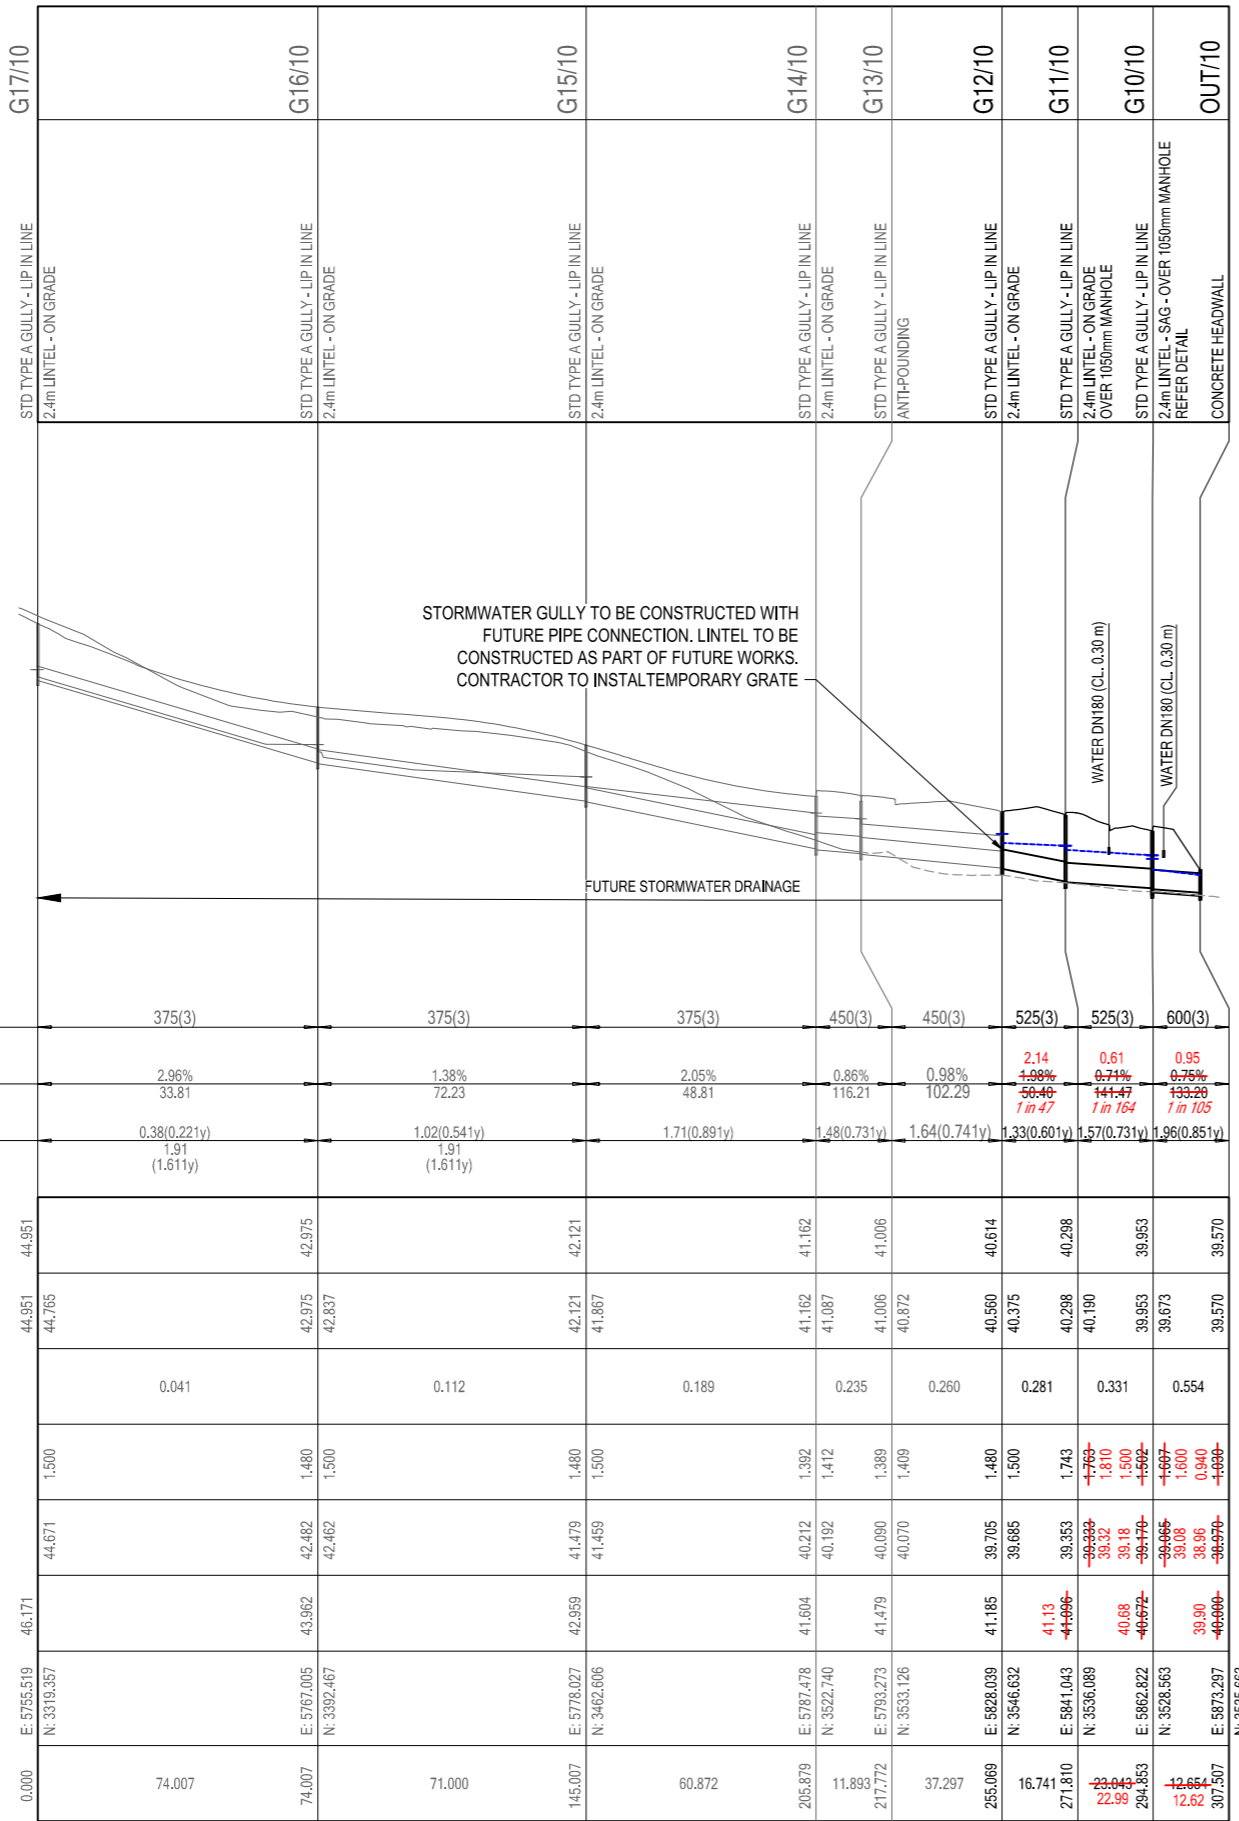


AS-CONSTRUCTED CERTIFICATION
 Signature: *S. Thomas* Date: 04.01.21
 SCOTT THOMAS RPEQ No. 04618
 For and on behalf of Peakurban PTY LTD

REV	DATE	DESIGN	DRAWN	REVISION DETAILS
A	29.07.20	AC	JW	ISSUED FOR CONSTRUCTION
B	19.08.20	AC	SC	AMENDED OUT/10 LOCATION
C	04.09.20	MG	MC	STRUCTURE DETAIL FOR R31/30 ADDED AND PIPE OFFSETS FOR STRUCTURE G10/10 AMENDED
D	29.09.20	AC	SC	ROAD & CUTBACK, DRAINAGE LINE UPDATED & STAGE NAME CHANGED
E	15.12.20	TD	SC	AS CONSTRUCTED

AS CONSTRUCTED

DESIGN APPROVED
 SCOTT THOMAS RPEQ 04618

FOR AND ON BEHALF OF PEAKURBAN PTY LTD

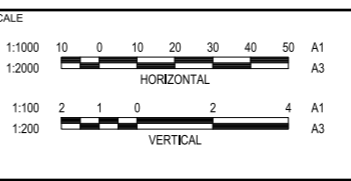

CLIENT
CANBERRA ESTATES CONSORTIUM NO.36 PTY LIMITED

ASSOCIATED CONSULTANT
 SAUNDERS HAVILL GROUP
 1300 123 744

PROJECT NAME
WOODLINKS STAGE 9A

COLLINGWOOD DRIVE,
 COLLINGWOOD PARK

DRAWING TITLE STORMWATER DRAINAGE LONGITUDINAL SECTIONS SHEET 2 OF 2		
PROJECT No. 18-0175	DRAWING No. 116	REVISION E

DESIGN ARI	LOCATION				TIME			SUB-CATCHMENT RUNOFF					INLET DESIGN				DRAIN DESIGN										HEADLOSSES										PART FULL		DESIGN LEVELS								
	STRUCTURE No.	DRAIN SECTION	SUB-CATCHMENTS CONTRIBUTING	LAND USE	%	min	mm/h	C10	C	A	CxA	+CA	Q	Qg	Qb	tc	I	+CA	Qt	Qm	Qs	Qp	L	S	V	T	STRUCTURE RATIOS FOR 'K' VALUE CALCULATIONS	VELOCITY HEAD	U/S HEADLOSS COEFFICIENT	U/S PIPE STRUCT. HEADLOSS	LAT. HEADLOSS CO-EFFICIENT	LAT. PIPE STRUCT. HEADLOSS	W.S.E. CO-EFFICIENT	CHANGE IN W.S.E.	PIPE FRICTION SLOPE	PIPE FRICTION HEADLOSS (L * Sf)	DEPTH	VELOCITY	OBVERT LEVELS	DRAIN SECTION H.G.L.	UPSTREAM H.G.L.	LAT. H.G.L.	W.S.E.	SURFACE OR K&C INVERT LEVEL	STRUCTURE No.		
2100	R5/3	R5/3 to R4/3											24			6.31	135	0.119	100	1920	0	100	17.943	1.95	225(U)	18(2.18)	(1.95)		0.242	0.55	0.133			0.55	0.133	2.44	0.439			38.261	38.557	38.690		38.690	39.045	R5/3	
2100	R4/3	R4/3 to R3/3										24			6.45	134	0.134	112	1920	12	113	1703	1.94	300(U)	56(156)y	(2.27)		0.124	1.57	0.194			2.34	0.290	0.91	0.016			37.904	37.924	38.118		38.214	38.347	R4/3		
2100	R3/3	R3/3 to R2/3										24			6.47	134	0.134	112	1920	0	113	3026	0.93	300(U)	56(156)y	(1.57)		0.124	1.80	0.223			2.11	0.262	0.91	0.028			37.482	37.685	37.908		37.947	38.358	R3/3		
2100	R2/3	R2/3 to R1/3										24			6.50	134	0.134	112	1920	0	113	28.000	1.43	300(U)	56(156)y	(1.95)		0.124	1.80	0.223			2.12	0.262	0.91	0.255	0.206	(0.206)y	2.16	(2.16)y	37.434	37.434	37.657		37.696	38.160	R2/3
2100	R1/3	R1/3 to G2/1										24			6.80	131	0.134	110	3516	0	113	5.929	2.01	375(S)	02(1.02)y	(2.25)		0.053	0.86	0.045			1.42	0.075	0.42	0.025			36.845	36.999	37.044		37.074	37.963	R1/3		
2100	G4/1	G4/1 to G3/1	G4/1		5.00	146	0.74	0.057	0.042	0.042	0.042	17	17	2.65	4.98	1	17	0	G3/2	5.00	3381	34	17	7.975	1.00	375(S)	15(0.12)y	(1.59)	0.001	1.00	0.001			1.00	0.001	0.01	0.001	0.079	1.01	(0.94)y	38.452	38.410	38.411		38.411	39.286	G4/1
2100	G3/1	G3/1 to G2/1	G4/1,G3/1		13.00	100	0.74	0.337	0.249	0.249	0.337	69	69	2.65	4.98	1	59	10	G2/1	13.00	3381	181	71	13.000	2.40	375(S)	64(0.54)y	(2.46)	0.021	2.71	0.057			2.71	0.057	0.16	0.118	0.130	2.06	(0.119)y	38.352	38.352	38.409		38.409	39.323	G3/1
2100	G2/1	G2/1 to G1/1	G4/1,G3/1,G2/1		10.00	112	0.82	0.279	0.195	0.195	0.279	61	71	2.10	4.44	1	60	10	G1/1	14.22	3516	292	202	70.936	2.40	375(S)	83(1.62)y	(2.46)	0.171	2.03	0.346			2.03	0.346	1.33	0.947	0.242	2.70	(0.223)y	36.580	36.580	36.926		36.926	37.688	G2/1
2100	G3/2	G3/2 to G1/1	G3		5.00	146	0.88	0.088	0.078	0.078	0.088	32	32	2.95	5.26	4	32	0	EX PIT	5.00	3325	62	32	8.000	1.00	375(S)	29(0.21)y	(1.59)	0.004	10.11	0.043			10.11	0.043	0.03	0.003			34.958	34.997	35.040		35.040	36.025	G3/2	
2100	G1/1	G1/1 to OUT/1	G4/1,G3/1,G2/1,G1/1		10.00	112	0.82	0.298	0.209	0.209	0.298	65	75	2.95	5.26	1	62	13	EX PIT	14.87	3325	454	271	30.540	1.40	450(S)	70(1.43)y	(2.12)	0.147	0.79	0.116			0.79	0.116	0.90	0.276	0.305	2.36	(0.271)y	34.878	34.878	34.994		34.994	36.032	G1/1
10100	G2/06	G2/06 to G1/06	G2/06		5.00	211	0.88	0.068	0.060	0.060	0.068	35	35	5.00	685	4	35	1		5.00		35	32.729	5.00	375(S)	3(0.11)y	(3.55)	0.005	1.00	0.244			1.00	0.244	0.04	0.013	0.075	2.19	(0.056)y	4.1676	4.1376	4.1620		4.1620	4.2638	G2/06	
10100	G1/06	G1/06 to OUT/06	G2/06,G1/06		5.00	211	0.88	0.010	0.009	0.009	0.010	5	5	2.82	514	4	5	0		5.55		39	9.884	5.00	375(S)	35(0.19)y	(3.55)	0.006	1.00	0.261			1.00	0.261	0.05	0.005	0.080	2.26	(0.059)y	4.0119	39.724	39.985		39.985	4.1176	G1/06	


AS-CONSTRUCTED CERTIFICATION
 Signature: Scott Thomas Date: 04.01.21
SCOTT THOMAS RPEQ No. 04618
 For and on behalf of Peakurban PTY LTD

REV	DATE	DESIGN	DRAWN	ISSUED FOR CONSTRUCTION	DRAWN	STATUS	SCALE	CLIENT	PROJECT NAME	DRAWING TITLE	
A	29.07.20	AC	JW	ISSUED FOR CONSTRUCTION		AS CONSTRUCTED		CANBERRA ESTATES CONSORTIUM NO.36 PTY LIMITED	WOODLINKS STAGE 9A	STORMWATER DRAINAGE CALCULATIONS TABLE SHEET 1 OF 2	
B	04.09.20	MG	MG	LINE 6 ADDED FROM SHEET 2							
C	29.09.20	AC	SC	ROAD 6 CUTBACK, DRAINAGE LINE UPDATED & STAGE NAME CHANGED							
D	15.12.20	TD	SC	AS CONSTRUCTED							
				DESIGN	APPROVED	SCOTT THOMAS	RPEQ 04618	ASSOCIATED CONSULTANT	SAUNDERS HAVILL GROUP	COLLINGWOOD DRIVE, COLLINGWOOD PARK	
				FOR AND ON BEHALF OF PEAKURBAN PTY LTD			ENQUIRIES@PEAKURBAN.COM.AU			PROJECT No. 18-0175	
										DRAWING No. 117	
										REVISION D	

DESIGN ARI		LOCATION				TIME		SUB-CATCHMENT RUNOFF					INLET DESIGN						DRAIN DESIGN										HEADLOSSES							PART FULL					DESIGN LEVELS											
yr/s	Structure No.	Drain Section	Sub-catchments Contributing	Land Use	Slope of Catchment	Sub-catchment Time of Conc.	Rainfall Intensity	10yr runoff Co-efficient	CO-EFFICIENT OF RUNOFF	Sub-catchment Area	Equivalent Area	SUM OF (C * A)	Sub-catchment Discharge	Flow in K&C (inc. bypass)	Road Grade at Inlet	Minor Flow Road Capacity	Inlet Type	Flow into Inlet	Bypass Flow	Bypass Structure No.	Critical Time of Conc.	Rainfall Intensity	TOTAL (C * A)	MAJOR TOTAL FLOW	MAJOR SURFACE FLOW CAPACITY	MAJOR SURFACE FLOW	PIPE FLOW	REACH LENGTH	PIPE GRADE	PIPE / BOX DIMENSIONS (CLASS)	FLOW VELOCITY FULL (PIPE GRADE VELOCITY)	TIME OF FLOW IN REACH	STRUCTURE CHART No.	STRUCTURE RATIOS FOR 'K' VALUE CALCULATIONS	VELOCITY HEAD	U/S HEADLOSS COEFFICIENT	U/S PIPE STRUCT. HEADLOSS	LAT. HEADLOSS CO-EFFICIENT	LAT. PIPE STRUCT. HEADLOSS	W.S.E CO-EFFICIENT	CHANGE IN W.S.E	PIPE FRICTION SLOPE	PIPE FRICTION HEADLOSS (L * Sf)	DEPTH	VELOCITY	OBVERT LEVELS	DRAIN SECTION H.G.L	UPSTREAM H.G.L	LAT. H.G.L	W.S.E.	SURFACE OR K&C INVERT LEVEL	STRUCTURE No.
100	G17/10	G17/10 to G16/10	G16		%	min	mm/h	0.82	0.82	0.164	0.161	0.161	114	61	58.21	2336	4	41	20		10.00	10.00	0.164	114	1341	73	41	74.007	2.96	375(3)	0.38(0.221) (2.73)	123		Qg 0.041 Qo 0.041 Do 375 CHART 32: Vo2/2gDo 0.02 H/Do 0.00 Kg side flow 10.27 end flow 7.27 Part Full downstream pipe	0.007	1.00	0.186	upstream pipe above Set Kp to 1	HGL 44.951 below outlet	1.00	0.186	0.06	0.041	0.094	1.91 (161ty)	4.5046	4.42857	4.4951	44.951	44.951	46.171	G17/10
100	G16/10	G16/10 to G15/10	G16,G15			10.00	164	0.82	0.82	0.249	0.244	0.244	93	53	0.20	137	4	77	16	G15/10	11.23	156	0.338	275	1215	162	112	71000	1.38	375(3)	0.21(0.54ty) (1.87)	116		Qg 0.073 Qo 0.112 Do 375 CHART 33: Angle 0 S/Do 2.5 Du/Do 100 Qg/Do 0.65 K 1.78 S/Do 1.37 cor 0.83 Ku 2.61 Kw 2.61	0.053	2.61	0.138		2.61	0.138	0.41	0.292	0.198	1.91 (161ty)	4.2837	4.2837	4.2975	42.975	42.975	43.962	G16/10	
100	G15/10	G15/10 to G14/10	G16,G15,G14			10.00	164	0.82	0.82	0.295	0.242	0.242	110	127	0.164	392	4	88	38	G14/10	12.39	150	0.580	451	3478	263	189	60.872	2.05	375(3)	0.17(0.89ty) (2.27)	0.59		Qg 0.081 Qo 0.189 Do 375 CHART 33: Angle 0 S/Do 2.5 Du/Do 100 Qg/Do 0.43 K 1.38 S/Do 1.76 cor 0.32 Ku 1.70 Kw 1.70	0.149	1.70	0.254		1.70	0.254	1.16	0.705		1.91 (161ty)	4.1834	4.1867	4.2121	42.121	42.121	42.959	G15/10	
100	G14/10	G14/10 to G13/10	G16,G15,G14,G13			10.00	164	0.82	0.82	0.159	0.130	0.130	59	98	58.95	2351	4	56	42	G13/10	12.98	147	0.710	543	1332	308	235	11893	0.86	450(3)	0.48(0.73ty) (1.66)	0.13		Qg 0.050 Qo 0.235 Do 450 CHART 34: Angle 20 Case3 S/Do 2.5 Du/Do 0.83 Qg/Do 0.21 K 0.61 S/Do 2.16 cor 0.06 Ku 0.67 Kw 0.67	0.112	0.67	0.075		0.67	0.075	0.68	0.081		1.91 (161ty)	4.0642	4.1087	4.1162	41.662	41.662	41.604	G14/10	
100	G13/10	G13/10 to G12/10	G16,G15,G14,G13,G12			5.00	211	0.82	0.82	0.001	0.001	0.001	1	42	6.01	751	4	39	3	G11/10	13.11	146	0.711	541	2918	281	260	37.297	0.98	450(3)	0.64(0.74ty) (1.77)	0.38		Qg 0.027 Qo 0.260 Do 450 CHART 37: Angle 40 Case3 S/Do 2.5 Du/Do 100 Qg/Do 0.10 K 0.95 S/Do 2.08 cor 0.03 Ku 0.98 Kw 0.98	0.137	0.98	0.134		0.98	0.134	0.84	0.312		1.91 (161ty)	4.0520	4.0872	4.1006	4.1006	4.1006	4.1479	G13/10	
100	G12/10	G12/10 to G11/10	G16,G15,G14,G13,G12,G11			5.00	211	0.88	0.88	0.083	0.073	0.073	43	75	373.97	5922	4	33	10	G6/5	13.49	145	0.784	586	580	305	281	16.741	1.98	525(3)	0.33(0.60ty) (2.77)	0.21		Qg 0.023 Qo 0.281 Do 525 Angle 60 Chart 45 S/Do 2.5 chart deg Du/Do 0.86 K 0.228 K 0.5 1.83 Ou/Do 0.92 Cg 0.21 K 2.18 S/Do 2.0 K 2.54 K 0.5 2.39 K 2.51 S/Do 1.5 K 0.28 K 0.5 2.70 K 2.84	0.090	2.05	0.185	Interp val for S/Do 1.79 Kw 2.65	2.65	0.239	0.44	0.077		1.91 (161ty)	4.0203	4.0298	4.0560	4.0560	4.0560	4.1185	4.185	G12/10
100	G11/10	G11/10 to G10/10	G16,G15,G14,G13,G12,G11			10.00	164	0.82	0.82	0.208	0.171	0.171	78	81	189199.80	133199	4	49	32	G18/11	13.70	144	0.955	711	56	381	331	23.043	0.71	525(3)	0.57(0.73ty) (1.65)	0.24		Qg 0.049 Qo 0.331 Do 525 CHART 34: Angle 20 Case3 S/Do 2.5 Du/Do 100 Qg/Do 0.15 K 0.77 S/Do 1.86 cor 0.89 Ku 0.86 Kw 0.86	0.126	0.86	0.108		0.86	0.108	0.64	0.147		1.91 (161ty)	3.9851	4.0190	4.0298	4.0298	4.0298	4.1096	G11/10	
100	G18/11	G18/11 to G18/10	G17			10.00	164	0.82	0.82	0.276	0.226	0.226	103	135	3.20	260	135.1	135	0	G10/10	10.00	164	0.226	191	3278	57	135	8.000	0.57	375(3)	0.22(0.45ty) (1.20)	0.11		Qg 0.135 Qo 0.135 Do 375 CHART 32: Vo2/2gDo 0.20 H/Do 0.95 Kg side flow 4.15 end flow 3.49	0.076	4.15	0.315		4.15	0.315	0.59	0.047		1.91 (161ty)	3.9736	4.0990	4.0405	4.0405	4.0405	4.0671	G18/11	
100	G10/10	G10/10 to OUT/10	G16,G15,G14,G13,G12,G11,G17,G10			10.00	164	0.82	0.82	0.332	0.272	0.272	124	124	16.95	260	135.1	124	0	OUT	13.94	143	1.453	1073	2161	520	554	19.996	0.75	600(3)	0.96(0.85ty) (1.88)	0.17		Qg 0.108 Qo 0.554 Do 600 Routine 3.15 Join Pipes: G11/10 and G18/11 Vel 1517 Vel 2 1063 Eq Dia 637 Angle 222 Flow 0.446	0.196	14.3	0.280	CHART 37 Angle 42 Case3	1.43	0.280	0.81	0.163		1.91 (161ty)	3.9750	3.9760	4.0403	4.0403	4.0403	4.0672	G10/10	
100	G6/5	G6/5 to G5/5	G6			5.00	211	0.88	0.88	0.172	0.151	0.151	89	98	0.50	236	165.1	98	0	G5/5	5.00	211	0.151	155	1920	57	98	12.000	3.04	375(3)	0.89(0.34ty) (2.77)	0.20		Qg 0.098 Qo 0.098 Do 375 CHART 32: Vo2/2gDo 0.11 H/Do 0.00 Kg side flow 7.77 end flow 5.95	0.040	1.77	0.314		1.77	0.314	0.32	0.038	0.146	2.47 (1.89ty)	3.9968	3.9968	4.0282	4.0282	4.0282	4.0903	G6/5	
100	G5/5	G5/5 to OUT/5	G6,G5			5.00	211	0.88	0.88	0.147	0.129	0.129	76	76	7.09	236	165.1	76	0	OUT	5.20	209	0.280	285	2812	113	172	10.715	3.76	450(3)	0.08(0.43ty) (3.47)	0.17		Qg 0.075 Qo 0.172 Do 450 CHART 34: Angle 29 Case3 S/Do 2.5 Du/Do 0.83 Qg/Do 0.43 K 1.34 S/Do 1.26 cor 0.62 Ku 1.96 Kw 1.96	0.059	1.96	0.117		1.96	0.117	0.37	0.039	0.173	3.07 (2.37ty)	3.9603	3.9603	3.9720	3.9720	3.9720	4.0903	G5/5	
100	R38/30	R38/30 to R37/30				5.00	146	0.017	0.017				15	15	10.000		24			225(U)	5.00	146	0.017	15	1920	15	15	10.000	0.60	225(U)	0.33(0.33ty) (1.08)	0.17		Qo 0.015 Do 225 CHART 32: Vo2/2gDo 0.02 H/Do 1.02 Kg side flow 6.11 end flow 4.50	0.006	6.11	0.034		6.11	0.034	0.06	0.006		1.91 (161ty)	4.0531	4.0778	4.0811	4.0811	4.0811	4.0992	R38/30	
100	R37/30	R37/30 to R36/30				5.17	144	0.017	0.033				15	30	10.000		24			225(U)	5.17	144	0.033	30	1920	15	30	10.000	0.60	225(U)	0.66(0.66ty) (1.98)	0.17		Qo 0.030 Do 225 CHART 50 Du/Do 1.00 alpha 0 Kw 0.05 Vu 0.37 WSE 0.01 Ku 0.31 Kw 0.33	0.022	0.31	0.007		0.33	0.007	0.22	0.022		1.91 (161ty)	4.0451	4.0765	4.0772	4.0772	4.0772	4.1042	R37/30	
100	R36/30	R36/30 to R35/30				5.34	143	0.033	0.050				14	45	12.500		24			225(U)	5.34	143	0.050	44	1920	14	45	12.500	0.60	225(U)	0.98(0.98ty) (1.98)	0.21		Qo 0.045 Do 225 CHART 50 Du/Do 1.00 alpha 0 Kw 0.05 Vu 0.75 WSE 0.02 Ku 0.31 Kw 0.34	0.049	0.31	0.015		0.34	0.015	0.50	0.062		1.91 (161ty)	4.0371	4.0728	4.0743	4.0743	4.0743	4.0952	R36/30	
100	R35/30	R35/30 to R34/30				5.55	141	0.050	0.067				14	60	12.500		24			225(U)	5.55	141	0.067	59	1920	14	60	12.500	0.60	225(U)	1.31(1.31ty) (1.98)	0.16		Qo 0.060 Do 225 CHART 50 Du/Do 1.00 alpha 0 Kw 0.05 Vu 1.12 WSE 0.03 Ku 0.31 Kw 0.35	0.087	0.31	0.027		0.35	0.030	0.88	0.110		1.91 (161ty)	4.0276	4.0639	4.0666	4.0666	4.0666	4.0882	R35/30	
100	R34/30	R34/30 to R33/30				5.71	140	0.067	0.085				14	75	10.000		24			225(U)	5.71	140	0.085	74	1920	14	75	10.000	0.60	225(U)	1.64(1.64ty) (1.98)	0.10		Qo 0.075 Do 225 CHART 50 Du/Do 1.00 alpha 0 Kw 0.05 Vu 1.50 WSE 0.05 Ku 0.31 Kw 0.35	0.137	0.31	0.042		0.35	0.048	1.38	0.138		1.91 (161ty)	4.0181	4.0487	4.0529	4.0529	4.0529	4.0812	R34/30	
100	R33/30	R33/30 to R32/30				5.81	139	0.085	0.102				13	90	10.000		24			225(U)	5.81	139	0.102	88	1920	13	90	10.000	1.50	225(U)	1.97(1.97ty) (1.71)	0.08		Qo 0.090 Do 225 CHART 50 Du/Do 1.00 alpha 0 Kw 0.05 Vu 1.87 WSE 0.07 Ku 0.31 Kw 0.36	0.198	0.31	0.061		0.36	0.070	1.98	0.198		1.91 (161ty)	4.0101	4.0288	4.0349	4.0349	4.0349	4.0358	R33/30	
100	R32/30	R32/30 to R31/30				5.89	138	0.102	0.119				12	105	10.961		24			225(U)	5.89	138	0.119	102	1920	12	105	10.961	2.00	225(U)	2.29(2.29ty) (1.98)	0.08		Qo 0.105 Do 225 CHART 50 Du/Do 1.00 alpha 0 Kw 0.05 Vu 2.25 WSE 0.10 Ku 0.31 Kw 0.36	0.267	0.31	0.083		0.36	0.096	2.70	0.295		1.91 (161ty)	3.9931	4.0007	4.0090	4.0090	4.0090	4.0662	R32/30	
100	R31/30	R31/30 to OUT/30				5.97	138	0.119	0.140				15	123	8.966		24			300(U)	5.97	138	0.140	120	1920	15	123	8.966	0.61	300(U)	1.69(1.69ty) (1.28)	0.09		Qo 0.123 Do 300 Flow R32/30 made eqv grate flow CHART 32: Vo2/2gDo 0.48 H/Do 0.14 Kg side flow 3.81 end flow 3.37 K vals above for stepped pipes as grate flow	0.146	3.81	0.554		3.81	0.554	1.08	0.097		1.91 (161ty)	3.9769	3.9814	3.9365	3.9365	3.9365	4.0679	R31/30	

AS-CONSTRUCTED CERTIFICATION
 Signature: S. Thomas Date: 04.01.21


AS-CONSTRUCTED CERTIFICATION
 Signature: *S. Thomas* Date: 04.01.21
 SCOTT THOMAS RPEQ No. 04618
 For and on behalf of Peakurban PTY LTD

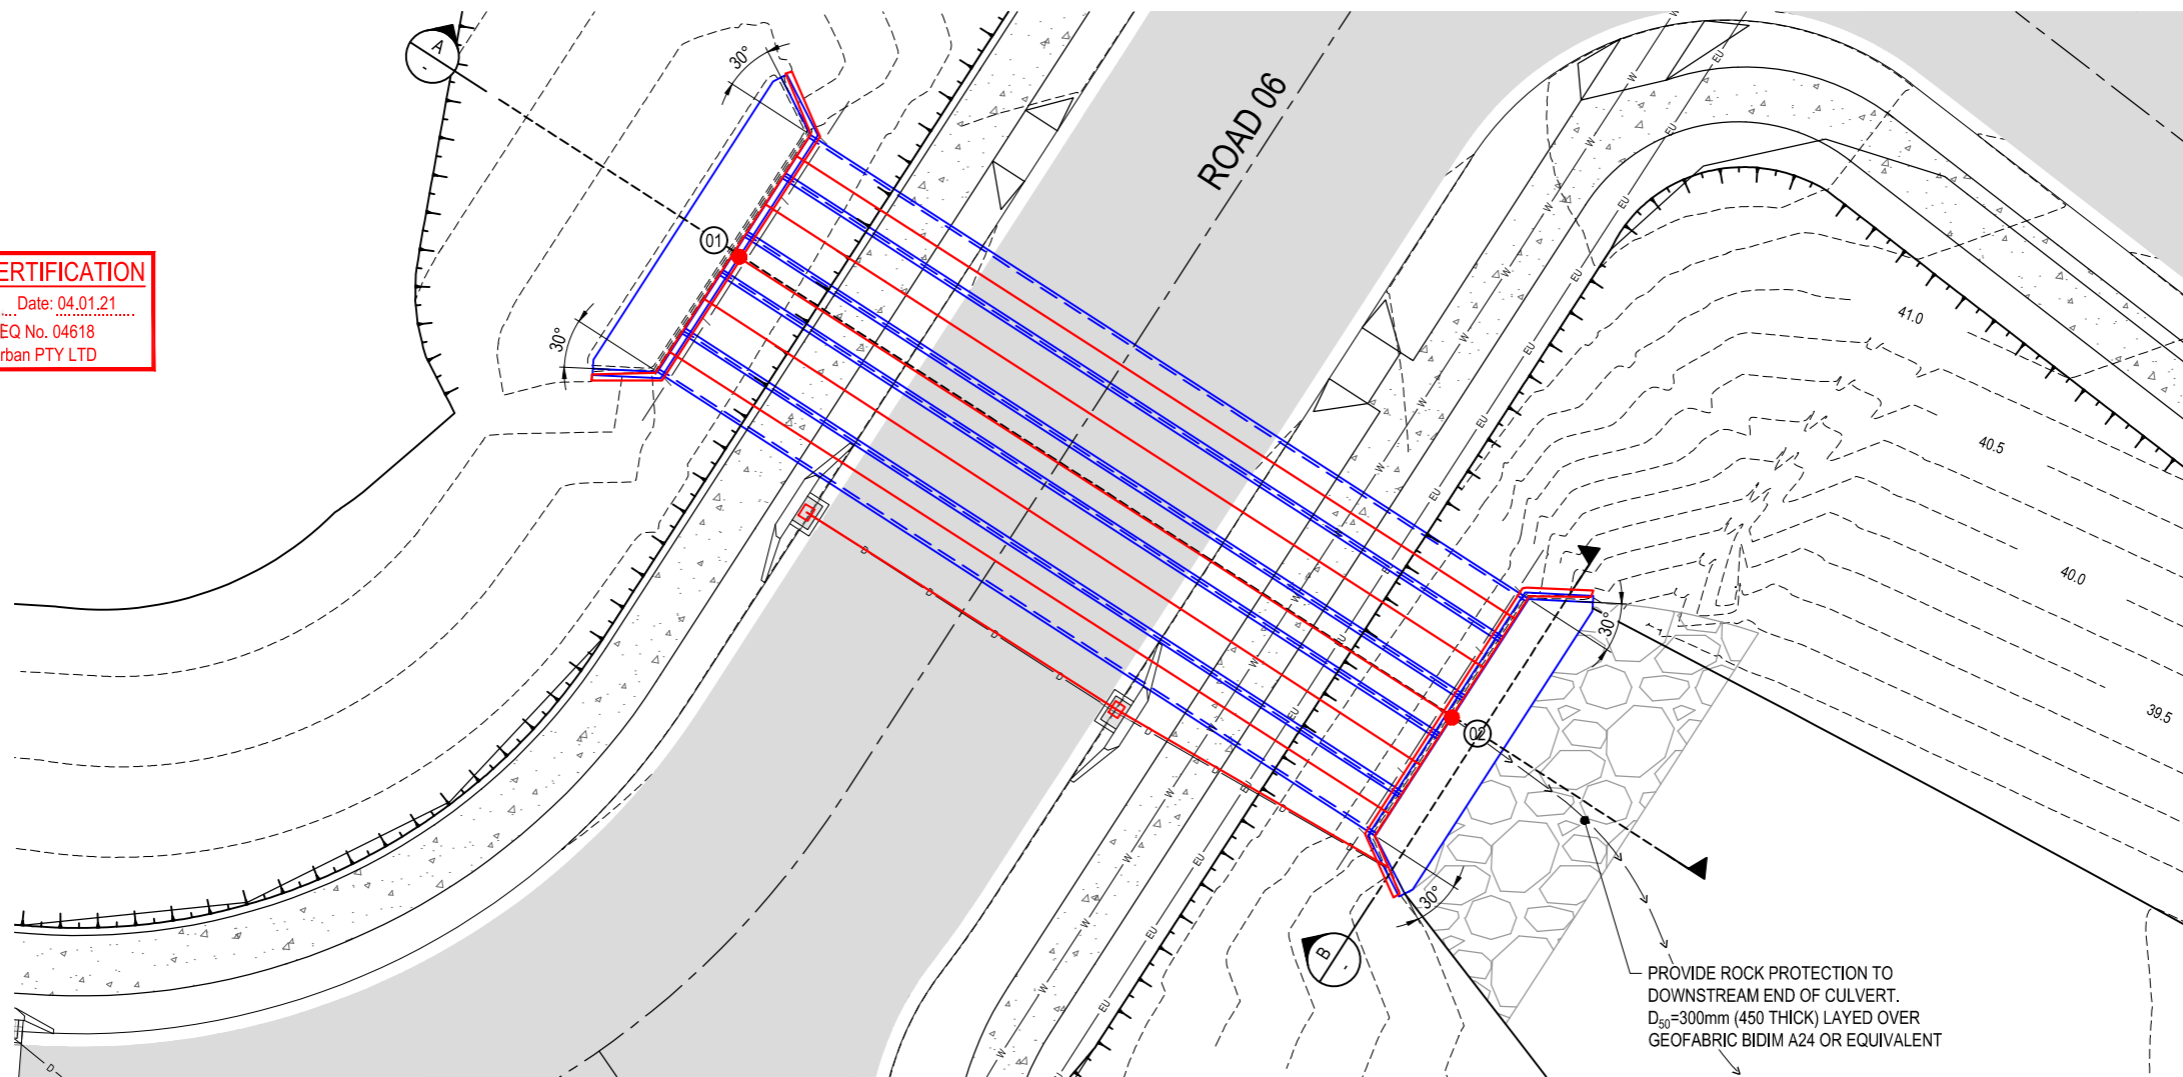


CULVERT SETOUT

NUMBER	EASTING	NORTHING
01	5852.357	3572.202
02	5875.921	3556.967

CULVERT LAYOUT DETAIL
 SCALE 1:125 (A1)
 SCALE 1:250 (A3)


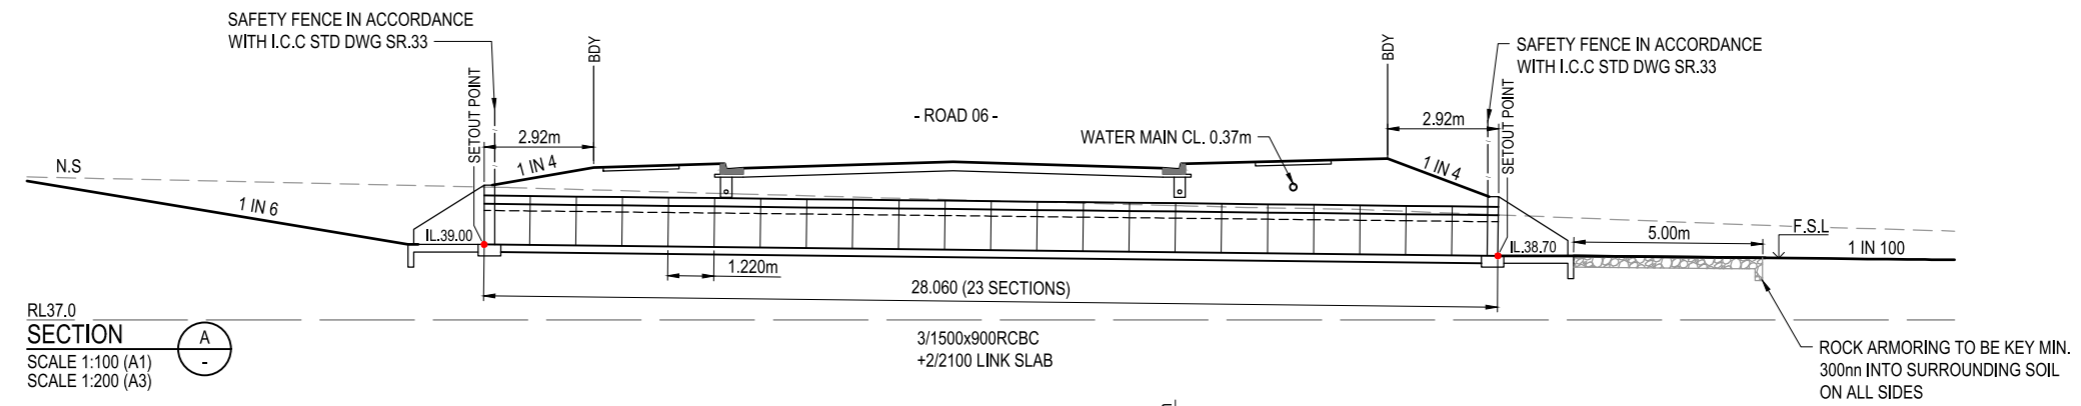


SECTION A
 SCALE 1:100 (A1)
 SCALE 1:200 (A3)

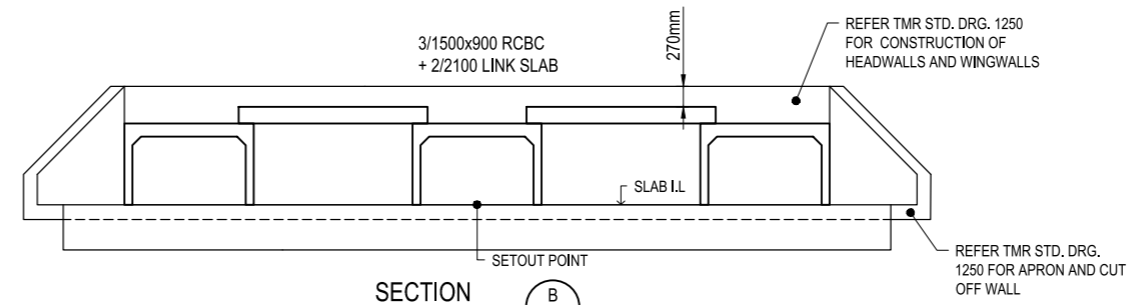

SECTION B
 SCALE 1:50 (A1)
 SCALE 1:100 (A3)

REV	DATE	DESIGN	DRAWN	REVISION DETAILS	DRAWN	STATUS	SCALE	CLIENT	PROJECT NAME	DRAWING TITLE			
A	29.07.20	AC	JW	ISSUED FOR CONSTRUCTION		AS CONSTRUCTED	1:50 1 0.5 0 1 2 A1	CANBERRA ESTATES CONSORTIUM NO.36 PTY LIMITED	WOODLINKS STAGE 9A	CULVERT DETAILS LAYOUT PLAN			
B	29.09.20	AC	SC	ROAD 6 CUTBACK, DRAINAGE LINE UPDATED & STAGE NAME CHANGED			1:100 1 0 1 2 3 4 5 A1				ASSOCIATED CONSULTANT SAUNDERS HAVILL GROUP 1300 123 744	COLLINGWOOD DRIVE, COLLINGWOOD PARK	PROJECT No. 18-0175
C	04.01.21	TD	JW	AS CONSTRUCTED			1:100 1 0 1 2 3 4 5 A1 1:200 1 0 1 2 3 4 5 A1 1:125 2.5 0 2.5 5 A1 1:250 2.5 0 2.5 5 A3						
FOR AND ON BEHALF OF PEAKURBAN PTY LTD							ENQUIRIES@PEAKURBAN.COM.AU						

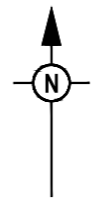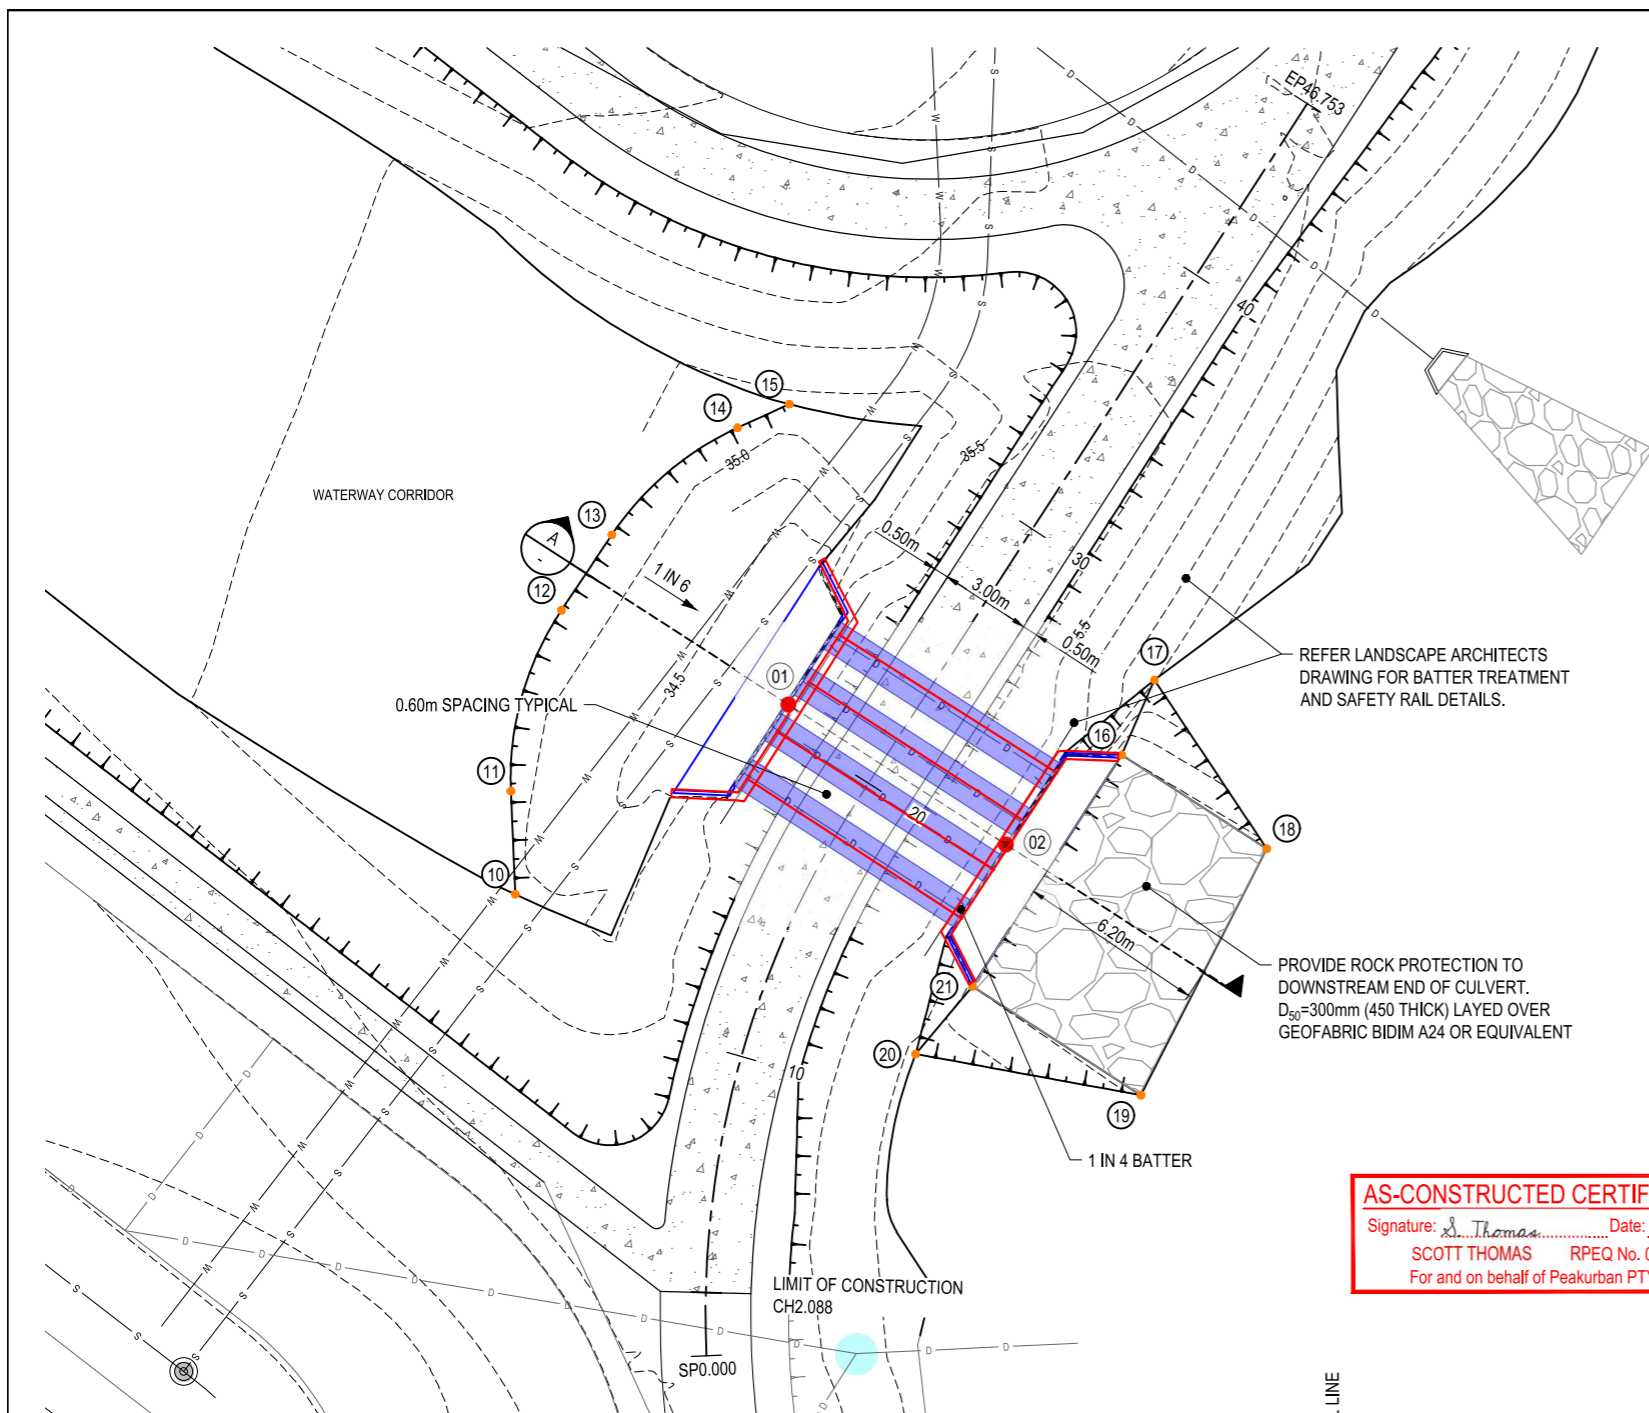


BATTER SETOUT

NUMBER	EASTING	NORTHING
10	6052.110	3421.897
11	6051.964	3425.309
12	6053.638	3431.292
13	6055.301	3433.782
14	6059.460	3437.323
15	6061.171	3438.105
16	6072.159	3426.503
17	6073.246	3428.981
18	6076.959	3423.404
19	6072.802	3415.256
20	6065.347	3416.616
21	6067.224	3418.857

CULVERT SETOUT

NUMBER	EASTING	NORTHING
01	6061.153	3428.186
02	6068.330	3423.559

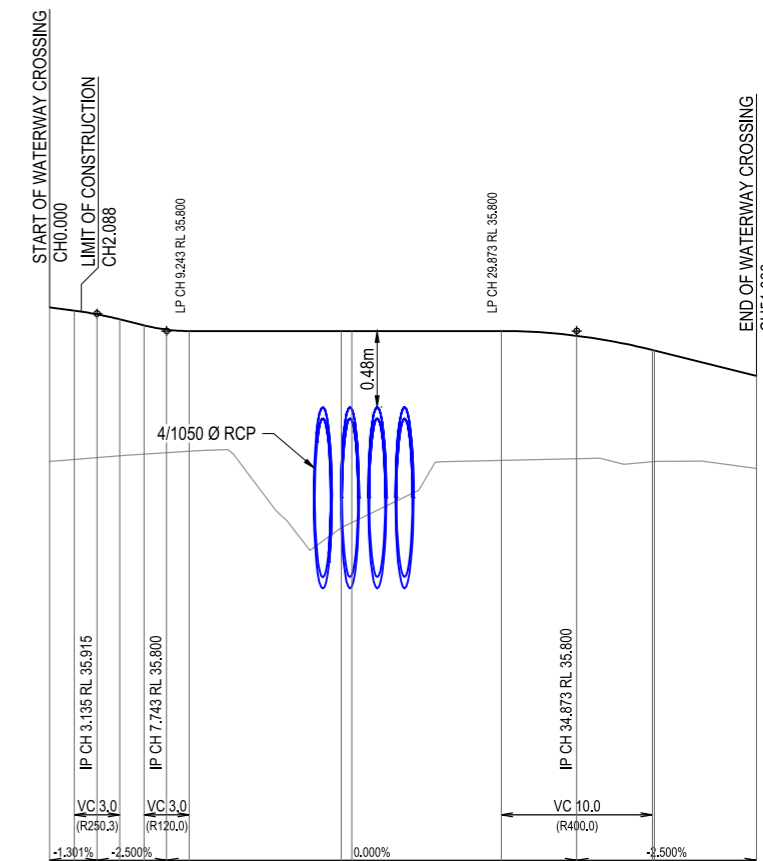

DATUM RL 32.0

	0.000	1.635	3.135	4.635	6.243	7.743	9.243	19.300	20.000	29.873	34.873	39.873	40.000	46.753
DESIGN SURFACE	35.966	35.995	35.911	35.878	35.898	35.809	35.800	35.800	35.800	35.800	35.769	35.675	35.672	35.503
EXISTING SURFACE	34.939	34.952	34.965	34.976	34.988	34.997	35.006	34.499	34.533	34.945	34.956	34.937	34.938	34.891
CHAINAGES	0.000	1.635	3.135	4.635	6.243	7.743	9.243	19.300	20.000	29.873	34.873	39.873	40.000	46.753

AS-CONSTRUCTED CERTIFICATION
 Signature: *S. Thomas* Date: 04.01.21
 SCOTT THOMAS RPEQ No. 04618
 For and on behalf of Peakurban PTY LTD

NOTE:
 REFER TO SURVEYORS AS-CONSTRUCTED DRAWINGS FOR FINISHED SURFACE LEVELS


BIKE PATH

LEGEND

- PROPOSED PATHWAY CONTROL LINE
- PROPOSED TOP OF BATTER
- PROPOSED CONCRETE PATH AND PRAM RAMP
- PROPOSED KERB SETOUT NODE
- PROPOSED ROCK ARMORING
- PROPOSED SEWERAGE MAIN
- PROPOSED WATER MAIN
- PROPOSED STORMWATER DRAINAGE PIPE

CULVERT LAYOUT DETAIL

SCALE 1:100 (A1)
 SCALE 1:200 (A3)

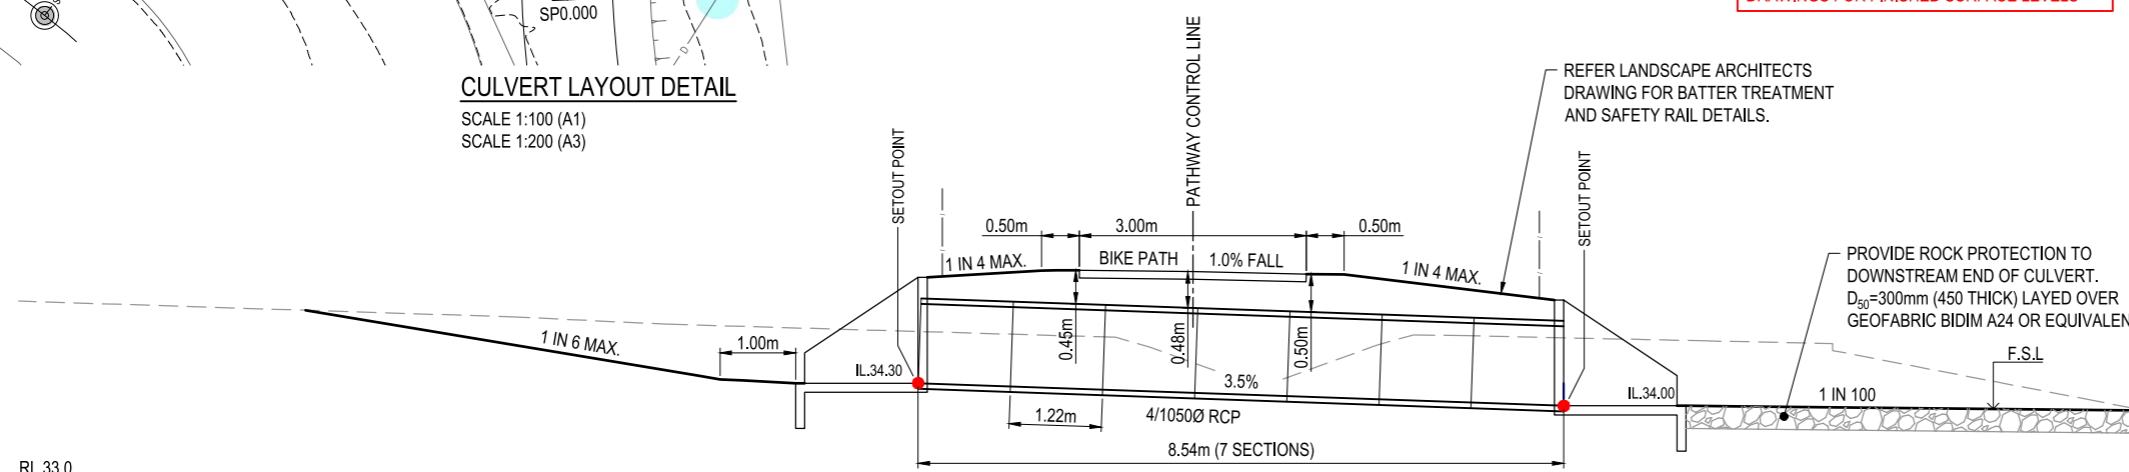

RL 33.0

SECTION
 SCALE 1:50 (A1)
 SCALE 1:100 (A3)

REV	DATE	DESIGN	DRAWN	REVISION DETAILS
A	29.07.20	AC	JW	ISSUED FOR CONSTRUCTION
B	29.09.20	AC	SC	ROAD 6 CUTBACK, DRAINAGE LINE UPDATED & STAGE NAME CHANGED
C	04.01.21	TD	JW	AS CONSTRUCTED

DRAWN	STATUS
AS CONSTRUCTED	APPROVED
SCOTT THOMAS	RPEQ 04618



SCALE

1:50	1 0.5 0 1 2	A1
1:100	1 0 1 2 3 4 5	A1
1:200	1 0 1 2 3 4 5	A3

CLIENT

CANBERRA ESTATES CONSORTIUM NO.36 PTY LIMITED

ASSOCIATED CONSULTANT
 SAUNDERS HAVILL GROUP
 1300 123 744

PROJECT NAME

WOODLINKS STAGE 9A

COLLINGWOOD DRIVE,
 COLLINGWOOD PARK


DRAWING TITLE

BIKE PATH CULVERT DETAILS LAYOUT PLAN

PROJECT No.	DRAWING No.	REVISION
18-0175	120	C



LOCALITY PLAN
1:2500 (A1)
1:5000 (A3)

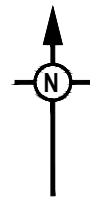

NAME OF ESTATE		WOODLINKS VILLAGE - STAGE 9A
SUBDIVIDER		CANBERRA ESTATES
Q.U.U. APPLICATION No.		18-PNT-37793
Q.U.U. DELEGATE APPROVAL DATE		11.12.2019
DRAWING/PLAN No.		18-0175-300-303
No. OF ALLOTMENTS		19
AREA		2.75 ha
LENGTH	DN160 PE100	619m - 597m
OF SEWERS	DN110 PE100	70m - 71m

ENVIRONMENTAL CONDITIONS

VEGETATION PROTECTION

- TREES LOCATED ALONG THE FOOTPATH SHALL BE, TRANSPLANTED PRIOR TO CONSTRUCTION, OR REPLACED IF DESTROYED.
- WHEN WORKING WITHIN 4m OF TREES, RUBBER OR HARDWOOD GIRDLES SHALL BE CONSTRUCTED WITH 1.8m BATTENS CLOSELY SPACED AND ARRANGED VERTICALLY FROM GROUND LEVEL. GIRDLES SHALL BE STRAPPED TO TREES PRIOR TO CONSTRUCTION AND REMAIN UNTIL COMPLETION.
- TREE ROOTS SHALL BE TUNNELED UNDER, RATHER THAN SEVERED. IF ROOTS ARE SEVERED THE DAMAGED AREA SHALL BE TREATED WITH A SUITABLE FUNGICIDE. CONTACT RELEVANT COUNCIL ARBORIST FOR FURTHER ADVICE.
- ANY TREE LOPPING REQUIRED SHOULD BE UNDERTAKEN BY AN APPROVED ARBORIST.

SOIL

- TOPSOIL AND SUBSOIL SHALL BE STOCKPILED SEPARATELY.
- CARE SHALL BE TAKEN TO PREVENT SEDIMENT FROM ENTERING THE STORMWATER SYSTEM. THIS MAY INVOLVE PLACING APPROPRIATE SEDIMENT CONTROLS AROUND STOCKPILES.

CREEK CROSSINGS

- SILTATION CONTROL MEASURES SHALL BE PLACED DOWNSTREAM OF ANY EXCAVATION WORK.
- APPROPRIATE SEDIMENT CONTROLS SHALL BE USED TO PREVENT SEDIMENT FROM ENTERING THE CREEK.
- NO SOIL SHALL BE STOCKPILED WITHIN 5m OF THE CREEK.

REHABILITATION

- PREDISTURBANCE SOIL PROFILES AND COMPACTION LEVELS SHALL BE REINSTATED.
- PREDISTURBANCE VEGETATION PATTERNS SHALL BE RESTORED.

GENERAL NOTES:

- THE CONTRACTOR SHALL SUPPLY ALL LABOR, MATERIALS, PLANT AND EQUIPMENT TO CONSTRUCT THE WORKS AS DOCUMENTED AND STRICTLY IN ACCORDANCE WITH THE RELEVANT AUTHORITY STANDARDS, SPECIFICATIONS AND REQUIREMENTS.
- THE EXISTING SERVICES THAT ARE SHOWN ON THE DRAWINGS ARE PROVIDED FOR INFORMATION PURPOSES ONLY. NO RESPONSIBILITY IS TAKEN BY THE SUPERINTENDENT OR THE PRINCIPAL FOR INFORMATION THAT HAS BEEN SUPPLIED BY OTHERS, OR ANY EXISTING SERVICES THAT MAY BE PRESENT NOT SHOWN ON THE DRAWINGS. THE CONTRACTOR SHALL VERIFY THE POSITION OF ANY UNDERGROUND SERVICES WITHIN THE AREAS OF WORKS AND SHALL BE RESPONSIBLE FOR MAKING GOOD ANY DAMAGE THERETO. ANY ALTERATION WORKS TO SERVICES WILL BE CARRIED OUT ONLY BY THE SERVICE OWNER AUTHORITY UNLESS APPROVED OTHERWISE.
- ALL DESIGN AND CONSTRUCTION ACTIVITIES UNDERTAKEN SHALL COMPLY WITH CURRENT WORKPLACE HEALTH AND SAFETY REQUIREMENTS AND LEGISLATION.
- PRIOR TO COMMENCING WORK, THE CONTRACTOR IS RESPONSIBLE FOR OBTAINING ALL RELEVANT LOCAL AUTHORITY PERMITS. THE CONTRACTOR SHALL NOT COMMENCE THE DEMOLITION OF ANY EXISTING BUILDINGS AND/OR STRUCTURES WITHOUT APPROVAL FROM THE SUPERINTENDENT.
- THE CONTRACTOR SHALL APPLY INDUSTRY BEST PRACTICE SO WORKS SHALL NOT DISTURB OR AFFECT NEARBY RESIDENTS EITHER BY DUST, NOISE, FLOODING OR DISCONNECTION OF SERVICES. CONTRACTOR TO ENSURE THAT ACCESS AND SERVICES TO EXISTING PROPERTIES ARE AVAILABLE AT ALL TIMES.
- THE CONTRACTOR SHALL VERIFY LEVELS OF EXISTING SERVICE CROSSINGS AND CONNECTION POINTS PRIOR TO COMMENCEMENT OF WORKS AND NOTIFY SUPERINTENDENT OF ANY DISCREPANCIES BETWEEN ACTUAL AND PROPOSED DESIGN LEVELS. THESE ENGINEERING DRAWINGS ARE TO BE READ IN CONJUNCTION WITH THE APPROVED VEGETATION MANAGEMENT PLAN, WHERE APPLICABLE. WHEN IN DOUBT, ALL EXISTING TREES ARE TO REMAIN UNLESS DIRECTED OTHERWISE.
- HOLD POINT:** ONCE THE BASE OF MANHOLES HAVE BEEN POURED, CONSTRUCTION SHALL ONLY RE-COMMENCE ONCE THE SUPERINTENDENT AND/OR ENGINEER HAVE INSPECTED THE WORKS.
- THE CONTRACTOR SHALL NOTE DURING THE COURSE OF THE WORKS WHEN JOINT INSPECTIONS WITH THE AUTHORITY AND THE SUPERINTENDENT ARE REQUIRED. THESE INCLUDE PRE-STARTS, SUBGRADES, PRE-SEALS, CLEARING, AND OTHER SUCH INSPECTIONS AS NOMINATED DURING THE PRE-START, IN THE APPROVAL AND THE SPECIFICATIONS. THE CONTRACTOR SHALL ENSURE NO WORKS PROCEED PAST THE INSPECTION POINT UNTIL THE JOINT INSPECTION HAS BEEN SUCCESSFULLY COMPLETED.

SEWER RETICULATION NOTES

- ALL WORK AND MATERIALS SHALL BE IN ACCORDANCE WITH THE CURRENT WSAA GRAVITY SEWERAGE CODE OF AUSTRALIA SPECIFICATIONS AND STANDARD - SOUTH EAST QUEENSLAND SERVICE PROVIDERS EDITION.
- UNLESS SPECIFIED OTHERWISE ALL MATERIALS AND WORK SHALL COMPLY WITH THE RELEVANT AUSTRALIAN STANDARDS.
- THE CONSTRUCTION OF THE SEWERAGE WORK SHOWN ON THIS DRAWING SHALL BE SUPERVISED BY AN ENGINEER WHO HAS RPEQ REGISTRATION. SEWERAGE WORKS NOT COMPLYING WITH THIS REQUIREMENT WILL NOT BE PERMITTED TO CONNECT INTO THE Q.U.U. SEWERAGE SYSTEM.
- ALL WORK ASSOCIATED WITH LIVE SEWERS OR MAINTENANCE HOLES SHALL BE SUPERVISED BY Q.U.U. AT THE DEVELOPER'S COST.
- ALL PIPES AND MATERIALS SHALL COMPLY WITH THE REQUIREMENTS OF THE "ACCEPTED PRODUCTS AND MATERIALS" LIST.
- EACH ALLOTMENT SHALL BE SERVED BY A DN110 PE PROPERTY CONNECTION. FOR ALLOTMENTS OTHER THAN SINGLE RESIDENTIAL, A DN160 PE PROPERTY CONNECTION SHALL BE PROVIDED.
- PROPERTY CONNECTIONS SHALL BE LOCATED WITHIN THE PROPERTY AS SHOWN IN THE DRAWINGS.
- PROPERTY CONNECTION BRANCHES SHALL EXTEND INTO THE PROPERTY A MINIMUM OF 300mm AND A MAXIMUM OF 750mm.
- WHERE PIPES ARE LAID IN FILL, THE FILLING SHALL BE CARRIED OUT IN LAYERS NOT EXCEEDING 300mm (LOOSE) IN DEPTH AND SHALL BE COMPACTED UNTIL THE COMPACTION IS NOT LESS THAN 95% OF THE MATERIALS MAXIMUM COMPACTION WHEN TESTED IN ACCORDANCE WITH A.S.1289 (MODIFIED COMPACTION). TESTING SHALL BE CARRIED OUT AFTER EACH ALTERNATE LAYER. IN ALL SUCH CASES APPROVAL OF CONSTRUCTED SEWERS WILL NOT BE ISSUED BY Q.U.U. UNLESS CERTIFICATES ARE PRODUCED CERTIFYING THAT THE REQUIRED COMPACTION HAS BEEN ACHIEVED.
- WHERE SEWERS HAVE A GRADE OF 1 IN 20 OR STEEPER, BULKHEADS SHALL BE CONSTRUCTED IN ACCORDANCE WITH CLAUSE 9.10 OF THE SEQ SEWER CODE AND DRGS SEQ-SEW-1206-1 AND 1207-1.
- THE CONTRACTOR SHALL VERIFY THE LOCATION AND DEPTH OF EXISTING SERVICES WITH RELEVANT AUTHORITIES BEFORE COMMENCING WORKS.
- SEWERS SHALL BE DISUSED/ABANDONED IN ACCORDANCE WITH PROCEDURE SET OUT IN THE GRAVITY SEWER CODE.
- BENCH MARK AND LEVELS TO AHD.
- THE DESIGN HAS BEEN UNDERTAKEN TO COMPLY WITH CURRENT Q.U.U. STANDARDS AND THE WSAA GRAVITY SEWERAGE CODE OF AUSTRALIA SPECIFICATIONS AND STANDARD - SOUTH EAST QUEENSLAND SERVICE PROVIDERS EDITION
- CONSTRUCT EMBEDMENT AND TRENCHFILL TO SEQ-SEW-1200-2, 1201-1 TO 1205-1 (TYPE 4 SUPPORT UNLESS GEOTECHNICAL INVESTIGATIONS DEMONSTRATE THAT TYPE 3 SUPPORT IS ADEQUATE. TYPE 4 SUPPORT TO BE USED WHERE MIGRATORY NATIVE SOILS (OR SAND OR FINE CLAY MATERIAL) ARE ENCOUNTERED ADJACENT TO THE EMBEDMENT ZONE AND SINGLE SIZE AGGREGATE IS USED) AND COUNCIL STANDARD FOR ROADWAYS, WHICHEVER IS MORE ONEROUS.
- CONSTRUCT BULKHEADS AND TRENCH STOPS TO SEQ-SEW-1206-1 AND TRENCH DRAINS TO SEQ-SEW-1207-1.
- CONSTRUCT MH'S TO SEQ-SEW-1301-1 TO 1301-7 (TYPE G), 1301-8 TO 1301-13 (TYPE F), 1301-14 TO 1301-25 (TYPE X), 1301-26, 1304-1, 1305-1, 1307-4 (STUB CUT IN), 1313-1 (CONNECTION) AND 1502-1 (INSERTION MH AND REPAIR SYSTEM), 1301-27 (LADDERS).
- CONSTRUCT MAINTENANCE SHAFTS AND TERMINAL ENTRY POINTS TO SEQ-SEW 1315-1, 1316-1 AND 1502-1 (INSERT MS).
- INSTALL MH/MS TYPE B COVERS TO SEQ-SEW-1308-2 TO 1308-7.
- INSTALL MH/MS TYPE D COVERS TO SEQ-SEW-1308-8 TO 1308-11.
- INSTALL DETECTABLE MARKER TAPE ON ALL SEWER MAINS AND PROPERTY CONNECTIONS.

LIVE SEWER WORKS

No.	DESCRIPTION	DIA. SEWER	EXISTING ASSET ID AT CONNECTION	MH/MS TYPE	COVER TYPE	LOT & PLAN No.	F.S.L.	E.S.L.	CONNECTION I.L.	CONNECTION DEPTH TO INVERT	ALTERATION TO EXISTING MH BENCHING REQUIRED (Y/N)
1 (A)	0.50m FROM EXISTING STUB, CONSTRUCTOR, TO LAY NEW SEWERS. AFTER CLEANSING, TESTING AND INSPECTION, NOTIFY Q.U.U.	DN160	MH562 872	G	D		35.070	35.070	32.710	2.360	Y
1 (B)	CONSTRUCTOR, UNDER Q.U.U. SUPERVISION, TO REMOVE TEMPORARY END CAP ON EXISTING STUB AND MAKE LIVE CONNECTION AFTER SUCCESSFUL 'ON MAINTENANCE' INSPECTION.										

LIVE WORKS NOTES:

- ALL WORK ON EXISTING SEWERS TO BE CARRIED OUT BY THE CONTRACTOR (IN ACCORDANCE WITH AN APPROVED NETWORKS ACCESS PERMIT) UNDER Q.U.U. SUPERVISION, AT THE DEVELOPERS EXPENSE.
- LIVE WORKS CANNOT COMMENCE UNTIL ALL RELEVANT TEST CERTIFICATES HAVE BEEN PROVIDED AND ACCEPTED BY Q.U.U.

ENGINEER'S CERTIFICATION

- I, SCOTT THOMAS, hereby certify that:
- The information contained in this drawing / document is in compliance with approved drawings and design.
 - The new water and sewerage works defined by this drawing have been designed and constructed in accordance with the SEQ code.
 - This generally represents an accurate record of as-constructed works
 - I accept responsibility for the information contained in this drawing / document.

S. Thomas

7/01/21

RPEQ (signature) RPEQ No. 04618 Date:

PROPERTY CONNECTIONS HAVE BEEN DESIGNED TO CONTROL THE REQUIRED SERVICE AREA OF EACH LOT AT A GRADE OF 1:60 AND A MAXIMUM DEPTH OF PROPERTY CONNECTION AT 1.5m UNLESS OTHERWISE STATED. FOR JUNCTION DETAILS REFER SEQ-SEW-1106-1 TO SEQ-SEW-1106-6.

ALL ENVIRONMENTAL PROTECTION MEASURES SHALL BE IMPLEMENTED PRIOR TO ANY CONSTRUCTION WORK COMMENCING, INCLUDING CLEARING

ALL WATER AND SEWERAGE CONSTRUCTION SHALL COMPLY WITH ALL QUEENSLAND LEGISLATION

REV	DATE	DESIGN	DRAWN	REVISION DETAILS	DRAWN	STATUS
A	29.07.20	AC	JW	ISSUED FOR CONSTRUCTION		
B	29.09.20	AC	SC	ROAD 6 CUTBACK, DRAINAGE LINE UPDATED & STAGE NAME CHANGED		
C	15.12.20	TD	SC	AS CONSTRUCTED		

DESIGN	APPROVED	SCOTT THOMAS	RPEQ 04618
FOR AND ON BEHALF OF PEAKURBAN PTY LTD			

SCALE	1:2500 50 0 50 100 A1 1:5000
CLIENT	CANBERRA ESTATES CONSORTIUM NO.36 PTY LIMITED
PROJECT NAME	WOODLINKS STAGE 9A
DRAWING TITLE	SEWERAGE COVER PLAN
ASSOCIATED CONSULTANT	SAUNDERS HAVILL GROUP 1300 123 744
PROJECT No.	18-0175
DRAWING No.	300
REVISION	C

ENGINEER'S CERTIFICATION

- I, SCOTT THOMAS, hereby certify that:
1. The information contained in this drawing / document is in compliance with approved drawings and design.
 2. The new water and sewerage works defined by this drawing have been designed and constructed in accordance with the SEQ code.
 3. This generally represents an accurate record of as-constructed works
 4. I accept responsibility for the information contained in this drawing / document.

S. Thomas

RPEQ (signature) RPEQ No. 04618 Date: 7/01/21

WARNING! - EXISTING SERVICES


EXTREME CARE SHOULD BE TAKEN WHEN EXCAVATING IN THIS AREA. THE FOLLOWING EXISTING SERVICES ARE LIKELY TO BE PRESENT IN THE VICINITY OF THE SITE:

- ELECTRICAL CABLES
- TELECOMMUNICATIONS CABLES
- GAS MAINS
- WATER MAINS
- SEWER MAINS


THE CONTRACTOR SHOULD CONTACT THE SERVICE PROVIDER FOR FURTHER INFORMATION AND SATISFY THEMSELVES OF ANY SPECIFIC TREATMENT OR REQUIREMENTS.

LEGEND

- PROPOSED AREA OF WORKS
- PROPOSED EASEMENT
- PROPOSED SEWERAGE MAIN
- EXISTING SEWERAGE MAIN
- FUTURE SEWERAGE MAIN
- SEWER LOT CONTROL SURFACE LEVEL
- FUTURE SEWER LOT CONTROL SURFACE LEVEL
- INDICATIVE DRIVEWAY LOCATION
- ZERO LOT BOUNDARY
- PROPOSED SURFACE CONTOUR
- EXISTING SURFACE CONTOUR
- PROPOSED STORMWATER DRAINAGE PIPE
- EXISTING STORMWATER DRAINAGE PIPE
- PROPOSED ROOFWATER DRAINAGE PIPE
- PROPOSED WATER MAIN
- EXISTING WATER MAIN
- PROPOSED RETAINING WALL
- EXISTING ELECTRICAL CABLE O/H
- EXISTING GAS MAIN

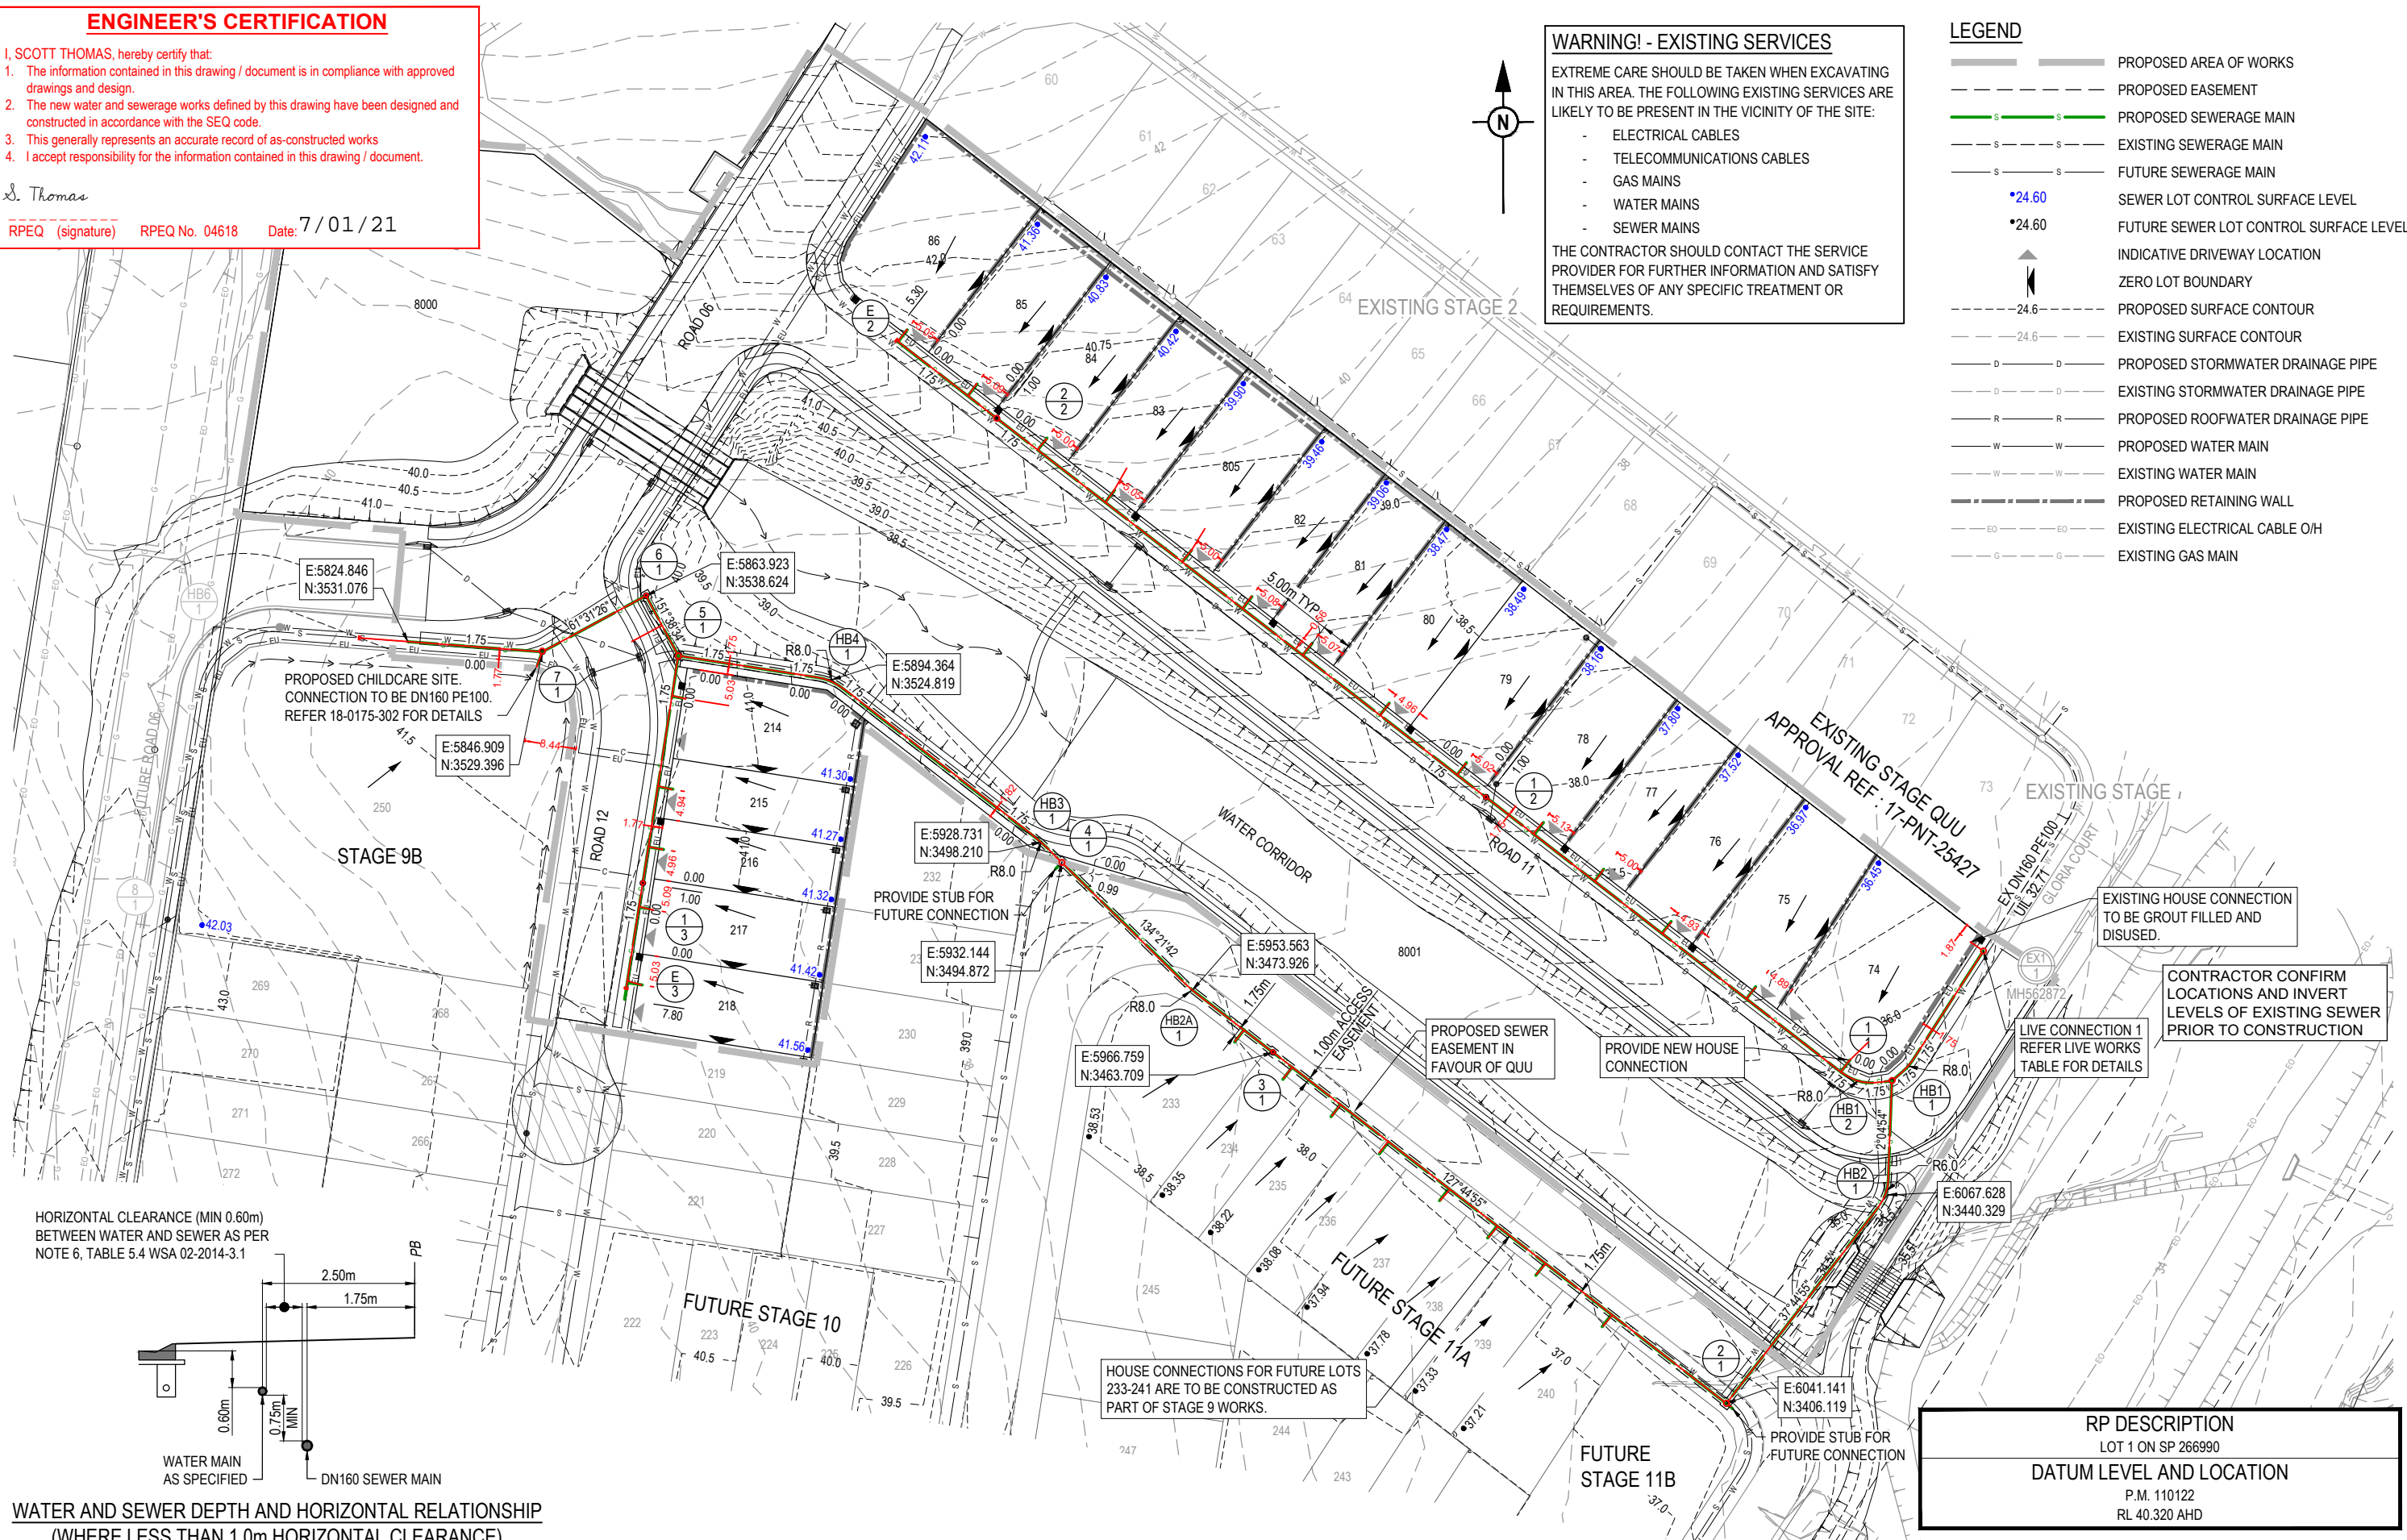

HORIZONTAL CLEARANCE (MIN 0.60m) BETWEEN WATER AND SEWER AS PER NOTE 6, TABLE 5.4 WSA 02-2014-3.1

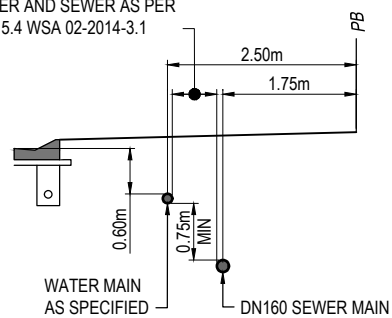

WATER AND SEWER DEPTH AND HORIZONTAL RELATIONSHIP (WHERE LESS THAN 1.0m HORIZONTAL CLEARANCE)

SCALE 1:50 (A1)

RP DESCRIPTION
 LOT 1 ON SP 266990
DATUM LEVEL AND LOCATION
 P.M. 110122
 RL 40.320 AHD

REV	DATE	DESIGN	DRAWN	REVISION DETAILS
A	29.07.20	AC	JW	ISSUED FOR CONSTRUCTION
B	04.08.20	MG	MG	STRUCTURES 1/2 AND 3/1 AND HC TO LOT 250 MOVED AND HB2A/1 ADDED.
C	29.09.20	AC	SC	ROAD 6 CUTBACK, DRAINAGE LINE UPDATED & STAGE NAME CHANGED
D	15.12.20	TD	SC	AS CONSTRUCTED

DRAWN	STATUS
AS CONSTRUCTED	AS CONSTRUCTED

PEAKURBAN
 DEVELOPMENT ENGINEERS • ADVISORS
 ENQUIRIES@PEAKURBAN.COM.AU

SCALE
 1:500 10 5 0 10 20 A1
 1:1000

CLIENT
CANBERRA ESTATES CONSORTIUM NO.36 PTY LIMITED
 ASSOCIATED CONSULTANT
 SAUNDERS HAVILL GROUP
 1300 123 744

PROJECT NAME
WOODLINKS STAGE 9A
 COLLINGWOOD DRIVE,
 COLLINGWOOD PARK

DRAWING TITLE		
SEWERAGE LAYOUT PLAN		
PROJECT No.	DRAWING No.	REVISION
18-0175	301	D

STRUCTURE / BEND / END NAME
STRUCTURE TYPE
STRUCTURE LID TYPE
STRUCTURE DROP TYPE
JUNCTION LINE
DEPTH TO HC
HC INVERT LEVEL
HC TYPE
HC LOT No
CH. FROM D/S STRUC / BEND

STRUCTURE TYPES
 G = CONCRETE 0.900Ø
 F = CONCRETE 1.200Ø
 X = CONCRETE 1.200Ø
 MS = PE 0.600Ø
MH DROP TYPES:
 AS PER SEQ STD DRG SEQ-SEW-1303-1
MS DROP TYPES:
 MS-A = 20mm DROP THROUGH BULB
 MS-B = >750mm DROP INTO RISER
LID TYPES
 B = NON-TRAFFICABLE
 D = TRAFFICABLE
 D(BD) = TRAFFICABLE WITH BOLT DOWN


NOTE: PE LINING OF MANHOLES:
 MAINTENANCE HOLES ≥ 1500Ø IN DIA OR ≥ 4.0m IN DEPTH, REQUIRE PE LINED PROTECTIVE COATING

EMBEDMENT NOTE:
 EMBEDMENT TYPE IS PRELIMINARY ONLY AND IS TO BE CONFIRMED AFTER GEOTECHNICAL INVESTIGATION AND ADJUSTED IF NECESSARY IN ACCORDANCE WITH SEQ STD DRGS SEQ-SEW-1201-1 TO 1205-1

*** STORMWATER BRIDGING NOTE:**
 WHERE A STORMWATER PIPE ≥ 600mm DIA CROSSES OVER A SEWER, THE STORMWATER PIPE SHALL BE SUPPORTED BY A BRIDGE STRUCTURE THAT SPANS THE SEWER TRENCH. REFER DETAIL ON PEAK URBAN STD DRG S-100.

LAND USE
DIAMETER
GRADE
EMBEDMENT
JUNCTION INVERT LEVEL
DEPTH TO INVERT
SEWER INVERT LEVEL
DESIGN SURFACE LEVEL
SETOUT
RUNNING CHAINAGE

LINE

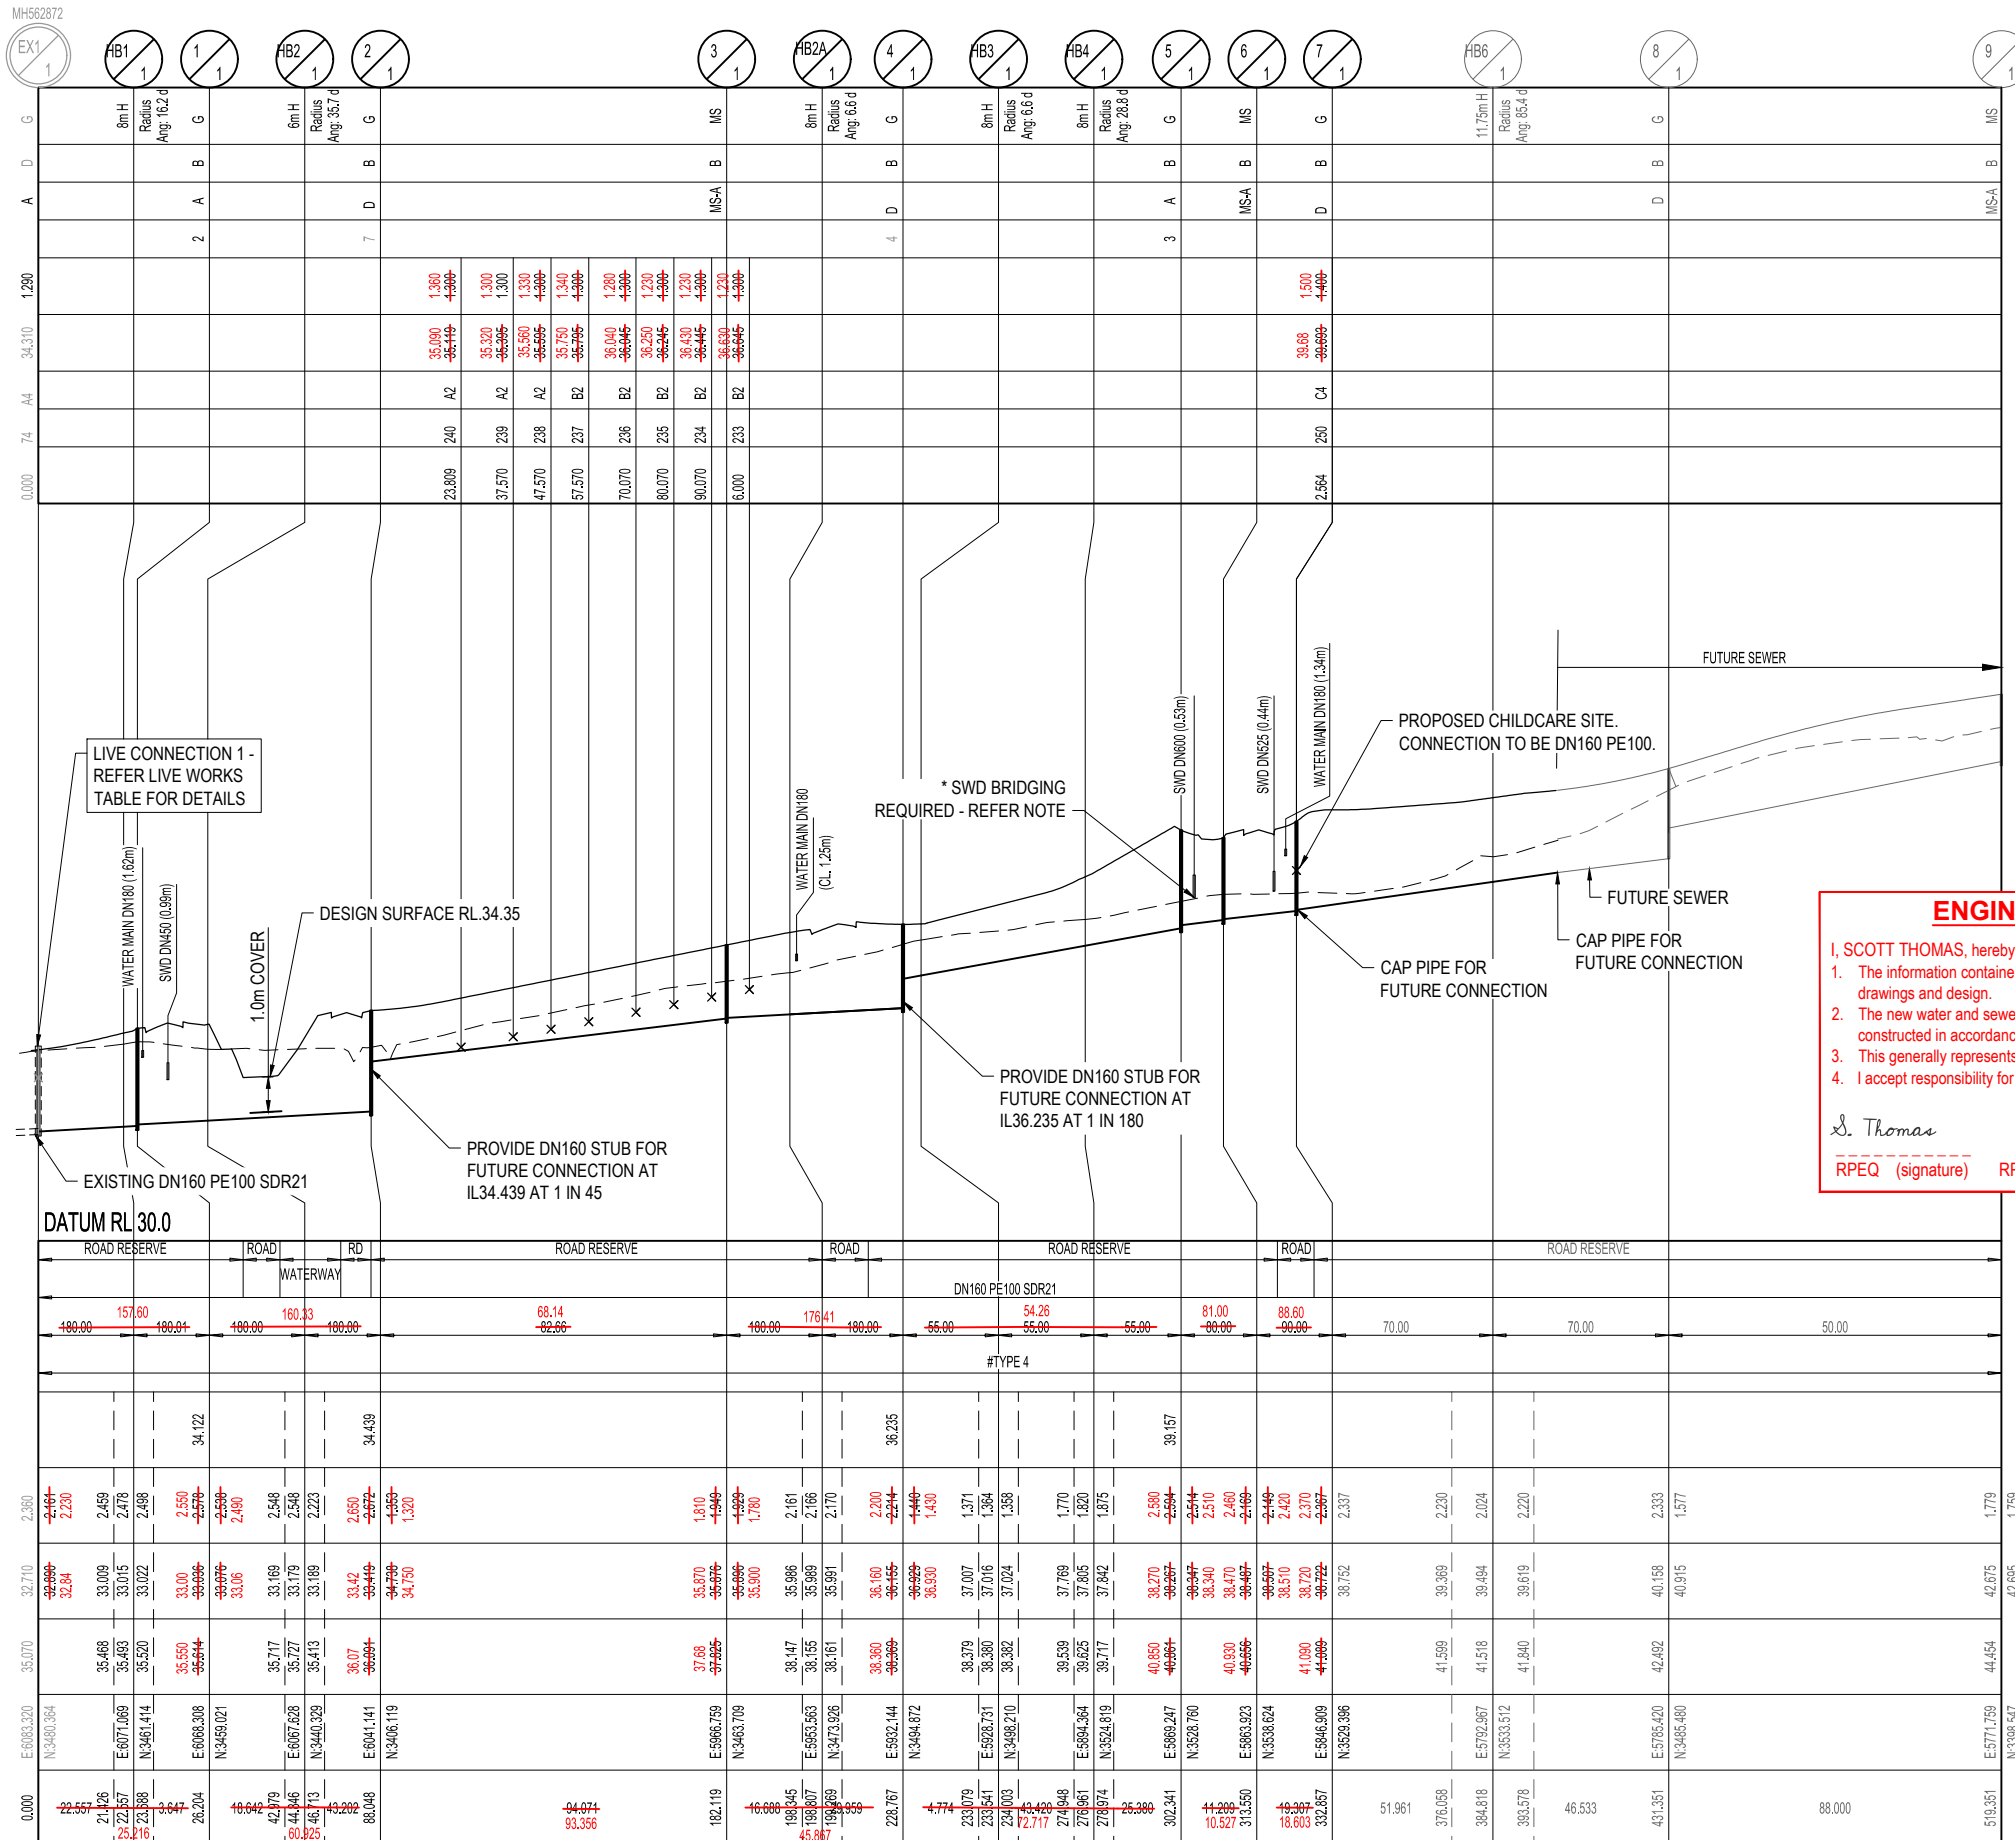

ENGINEER'S CERTIFICATION

I, SCOTT THOMAS, hereby certify that:


- The information contained in this drawing / document is in compliance with approved drawings and design.
- The new water and sewerage works defined by this drawing have been designed and constructed in accordance with the SEQ code.
- This generally represents an accurate record of as-constructed works
- I accept responsibility for the information contained in this drawing / document.

S. Thomas 7/01/21
 RPEQ (signature) RPEQ No. 04618 Date:

REV	DATE	DESIGN	DRAWN	REVISION DETAILS
A	29.07.20	AC	JW	ISSUED FOR CONSTRUCTION
B	04.08.20	MG	MG	LINE 2 AMENDED BETWEEN STRUCTURES 2/1 AND 4/1. HOUSE CONNECTION 250 AMENDED
C	29.09.20	AC	SC	ROAD 6 CUTBACK, DRAINAGE LINE UPDATED & STAGE NAME CHANGED
D	15.12.20	TD	SC	AS CONSTRUCTED

DRAWN	STATUS
AS CONSTRUCTED	

DESIGN APPROVED
 SCOTT THOMAS RPEQ 04618

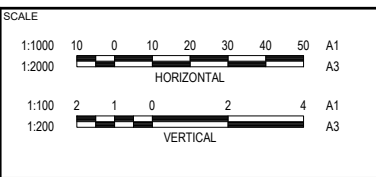

CLIENT
CANBERRA ESTATES CONSORTIUM NO.36 PTY LIMITED

ASSOCIATED CONSULTANT
 SAUNDERS HAVILL GROUP
 1300 123 744

PROJECT NAME
WOODLINKS STAGE 9A

COLLINGWOOD DRIVE,
 COLLINGWOOD PARK

DRAWING TITLE		
SEWERAGE LONGITUDINAL SECTIONS SHEET 1 OF 2		
PROJECT No.	DRAWING No.	REVISION
18-0175	302	D

STRUCTURE / BEND / END NAME
STRUCTURE TYPE
STRUCTURE LID TYPE
STRUCTURE DROP TYPE
JUNCTION LINE
DEPTH TO HC
HC INVERT LEVEL
HC TYPE
HC LOT No
CH. FROM D/S STRUC / BEND



STRUCTURE TYPES
G = CONCRETE 0.900Ø
F = CONCRETE 1.200Ø
X = CONCRETE 1.200Ø
MS = PE 0.600Ø
MH DROP TYPES:
AS PER SEQ STD DRG SEQ-SEW-1303-1
MS DROP TYPES:
MS-A = 20mm DROP THROUGH BULB
MS-B = >750mm DROP INTO RISER
LID TYPES
B = NON-TRAFFICABLE
D = TRAFFICABLE
D(BD) = TRAFFICABLE WITH BOLT DOWN

NOTE: PE LINING OF MANHOLES:
MAINTENANCE HOLES ≥ 1500Ø IN DIA OR ≥ 4.0m IN DEPTH,
REQUIRE PE LINED PROTECTIVE COATING

EMBEDMENT NOTE:
EMBEDMENT TYPE IS PRELIMINARY ONLY AND IS TO BE
CONFIRMED AFTER GEOTECHNICAL INVESTIGATION AND
ADJUSTED IF NECESSARY IN ACCORDANCE WITH SEQ STD
DRGS SEQ-SEW-1201-1 TO 1205-1

*** STORMWATER BRIDGING NOTE:**
WHERE A STORMWATER PIPE ≥ 600mm DIA CROSSES OVER
A SEWER, THE STORMWATER PIPE SHALL BE SUPPORTED
BY A BRIDGE STRUCTURE THAT SPANS THE SEWER
TRENCH. REFER DETAIL ON PEAK URBAN STD DRG S-100.

LAND USE
DIAMETER
GRADE
EMBEDMENT
JUNCTION INVERT LEVEL
DEPTH TO INVERT
SEWER INVERT LEVEL
DESIGN SURFACE LEVEL
SETOUT
RUNNING CHAINAGE

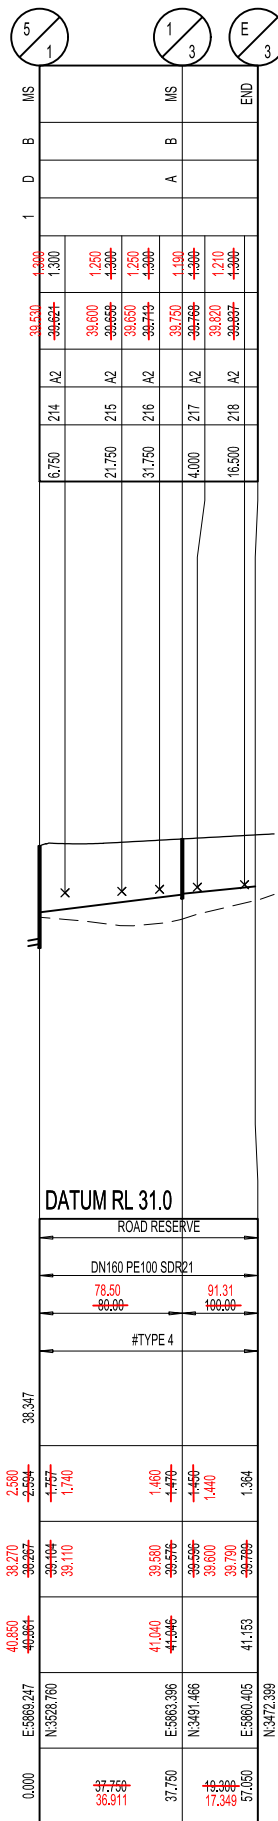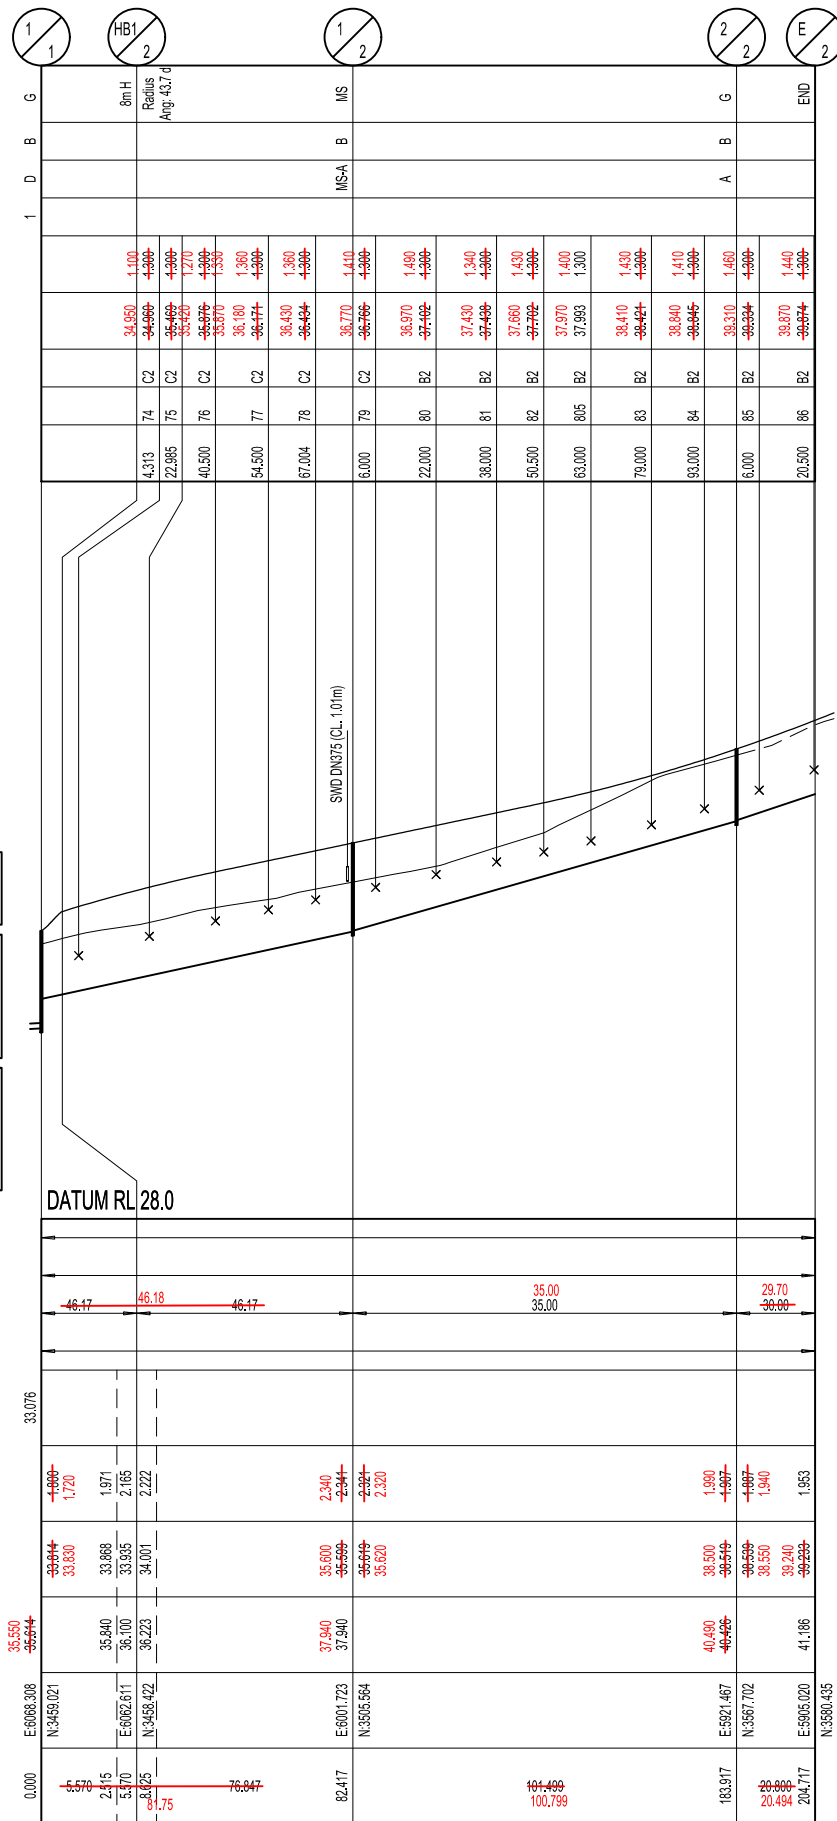

ENGINEER'S CERTIFICATION

- I, SCOTT THOMAS, hereby certify that:
- The information contained in this drawing / document is in compliance with approved drawings and design.
 - The new water and sewerage works defined by this drawing have been designed and constructed in accordance with the SEQ code.
 - This generally represents an accurate record of as-constructed works.
 - I accept responsibility for the information contained in this drawing / document.

S. Thomas

7/01/21


RPEQ (signature)

RPEQ No. 04618

Date:

REV	DATE	DESIGN	DRAWN	REVISION DETAILS
A	29.07.20	AC	JW	ISSUED FOR CONSTRUCTION
B	04.08.20	MG	MG	LINE 2 AMENDED
C	05.08.20	MG	MG	INCORRECT HOUSE CONNECTION REMOVED
D	29.09.20	AC	SC	ROAD & CUTBACK, DRAINAGE LINE UPDATED & STAGE NAME CHANGED
E	15.12.20	TD	SC	AS CONSTRUCTED


DRAWN	STATUS
DESIGN	APPROVED
SCOTT THOMAS	RPEQ 04618
FOR AND ON BEHALF OF PEAKURBAN PTY LTD	

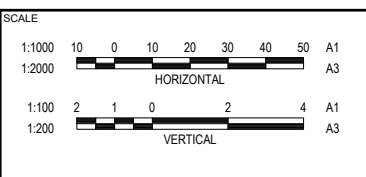

CLIENT
CANBERRA ESTATES CONSORTIUM NO.36 PTY LIMITED
ASSOCIATED CONSULTANT
SAUNDERS HAVILL GROUP
1300 123 744

PROJECT NAME
WOODLINKS STAGE 9A
COLLINGWOOD DRIVE,
COLLINGWOOD PARK

DRAWING TITLE SEWERAGE LONGITUDINAL SECTIONS SHEET 2 OF 2		
PROJECT No. 18-0175	DRAWING No. 303	REVISION E

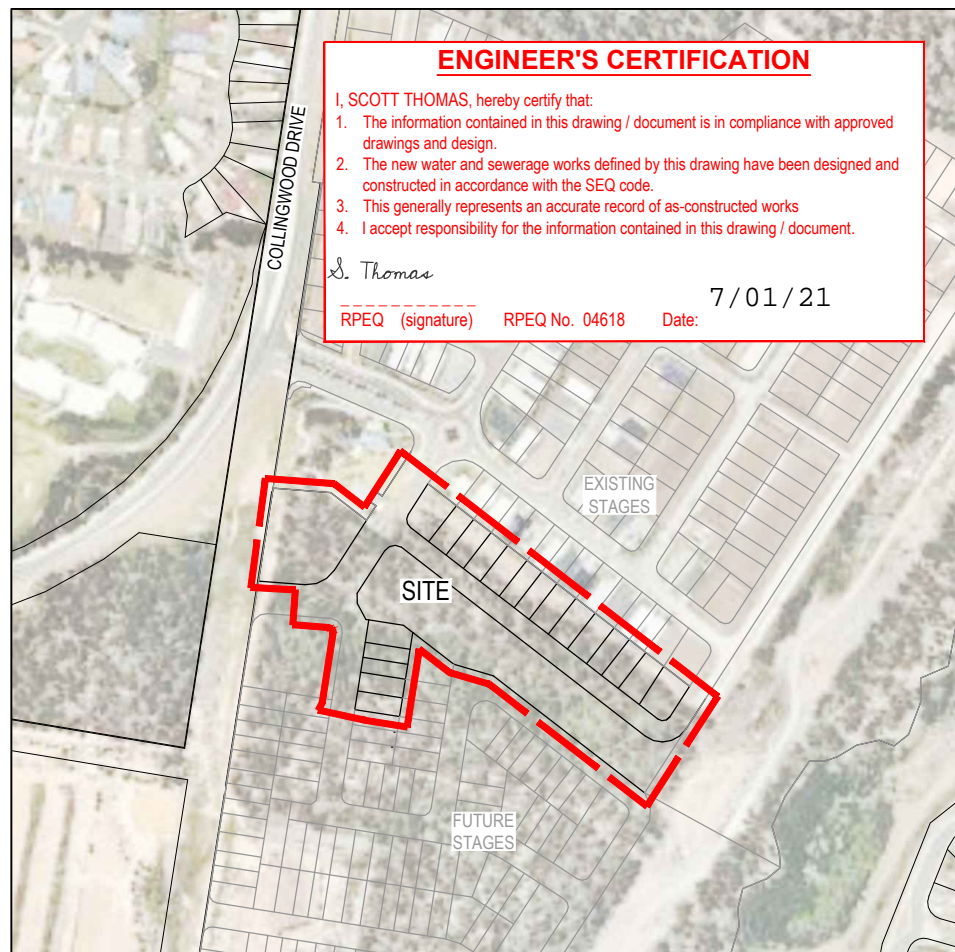

ENGINEER'S CERTIFICATION

I, SCOTT THOMAS, hereby certify that:

- The information contained in this drawing / document is in compliance with approved drawings and design.
- The new water and sewerage works defined by this drawing have been designed and constructed in accordance with the SEQ code.
- This generally represents an accurate record of as-constructed works.
- I accept responsibility for the information contained in this drawing / document.

S. Thomas

RPEQ (signature) RPEQ No. 04618 Date: 7/01/21

LOCALITY PLAN

1:2500 (A1)
1:5000 (A3)

GENERAL NOTES:

- THE CONTRACTOR SHALL SUPPLY ALL LABOR, MATERIALS, PLANT AND EQUIPMENT TO CONSTRUCT THE WORKS AS DOCUMENTED AND STRICTLY IN ACCORDANCE WITH THE RELEVANT AUTHORITY STANDARDS, SPECIFICATIONS AND REQUIREMENTS.
- THE EXISTING SERVICES THAT ARE SHOWN ON THE DRAWINGS ARE PROVIDED FOR INFORMATION PURPOSES ONLY. NO RESPONSIBILITY IS TAKEN BY THE SUPERINTENDENT OR THE PRINCIPAL FOR INFORMATION THAT HAS BEEN SUPPLIED BY OTHERS, OR ANY EXISTING SERVICES THAT MAY BE PRESENT NOT SHOWN ON THE DRAWINGS. THE CONTRACTOR SHALL VERIFY THE POSITION OF ANY UNDERGROUND SERVICES WITHIN THE AREAS OF WORKS AND SHALL BE RESPONSIBLE FOR MAKING GOOD ANY DAMAGE THERETO. ANY ALTERATION WORKS TO SERVICES WILL BE CARRIED OUT ONLY BY THE SERVICE OWNER AUTHORITY UNLESS APPROVED OTHERWISE.
- ALL DESIGN AND CONSTRUCTION ACTIVITIES UNDERTAKEN SHALL COMPLY WITH CURRENT WORKPLACE HEALTH AND SAFETY REQUIREMENTS AND LEGISLATION.
- PRIOR TO COMMENCING WORK, THE CONTRACTOR IS RESPONSIBLE FOR OBTAINING ALL RELEVANT LOCAL AUTHORITY PERMITS.
- THE CONTRACTOR SHALL NOT COMMENCE THE DEMOLITION OF ANY EXISTING BUILDINGS AND/OR STRUCTURES WITHOUT APPROVAL FROM THE SUPERINTENDENT.
- THE CONTRACTOR SHALL APPLY INDUSTRY BEST PRACTICE SO WORKS SHALL NOT DISTURB OR AFFECT NEARBY RESIDENTS EITHER BY DUST, NOISE, FLOODING OR DISCONNECTION OF SERVICES. CONTRACTOR TO ENSURE THAT ACCESS AND SERVICES TO EXISTING PROPERTIES ARE AVAILABLE AT ALL TIMES.
- THE CONTRACTOR SHALL VERIFY LEVELS OF EXISTING SERVICE CROSSINGS AND CONNECTION POINTS PRIOR TO COMMENCEMENT OF WORKS AND NOTIFY SUPERINTENDENT OF ANY DISCREPANCIES BETWEEN ACTUAL AND PROPOSED DESIGN LEVELS.
- THESE ENGINEERING DRAWINGS ARE TO BE READ IN CONJUNCTION WITH THE APPROVED VEGETATION MANAGEMENT PLAN, WHERE APPLICABLE. WHEN IN DOUBT, ALL EXISTING TREES ARE TO REMAIN UNLESS DIRECTED OTHERWISE.
- THE CONTRACTOR SHALL NOTE DURING THE COURSE OF THE WORKS WHEN JOINT INSPECTIONS WITH THE AUTHORITY AND THE SUPERINTENDENT ARE REQUIRED. THESE INCLUDE PRE-STARTS, SUBGRADES, PRE-SEALS, CLEARING, AND OTHER SUCH INSPECTIONS AS NOMINATED DURING THE PRE-START, IN THE APPROVAL AND THE SPECIFICATIONS. THE CONTRACTOR SHALL ENSURE NO WORKS PROCEED PAST THE INSPECTION POINT UNTIL THE JOINT INSPECTION HAS BEEN SUCCESSFULLY COMPLETED.

ENVIRONMENTAL CONDITIONS

VEGETATION PROTECTION

- TREES LOCATED ALONG THE FOOTPATH SHALL BE, TRANSPLANTED PRIOR TO CONSTRUCTION, OR REPLACED IF DESTROYED.
- WHEN WORKING WITHIN 4m OF TREES, RUBBER OR HARDWOOD GIRDLES SHALL BE CONSTRUCTED WITH 1.8m BATTENS CLOSELY SPACED AND ARRANGED VERTICALLY FROM GROUND LEVEL. GIRDLES SHALL BE STRAPPED TO TREES PRIOR TO CONSTRUCTION AND REMAIN UNTIL COMPLETION.
- TREE ROOTS SHALL BE TUNNELED UNDER, RATHER THAN SEVERED. IF ROOTS ARE SEVERED THE DAMAGED AREA SHALL BE TREATED WITH A SUITABLE FUNGICIDE. CONTACT RELEVANT COUNCIL ARBORIST FOR FURTHER ADVICE. ANY TREE LOPPING REQUIRED SHOULD BE UNDERTAKEN BY AN APPROVED ARBORIST.

SOIL

- TOPSOIL AND SUBSOIL SHALL BE STOCKPILED SEPARATELY.
- CARE SHALL BE TAKEN TO PREVENT SEDIMENT FROM ENTERING THE STORMWATER SYSTEM. THIS MAY INVOLVE PLACING APPROPRIATE SEDIMENT CONTROLS AROUND STOCKPILES.

CREEK CROSSINGS

- SILTATION CONTROL MEASURES SHALL BE PLACED DOWNSTREAM OF ANY EXCAVATION WORK.
- APPROPRIATE SEDIMENT CONTROLS SHALL BE USED TO PREVENT SEDIMENT FROM ENTERING THE CREEK.
- NO SOIL SHALL BE STOCKPILED WITHIN 5m OF THE CREEK.

REHABILITATION

- PREDISTURBANCE SOIL PROFILES AND COMPACTION LEVELS SHALL BE REINSTATED.
- PREDISTURBANCE VEGETATION PATTERNS SHALL BE RESTORED.

WATER RETICULATION NOTES

- ALL WORK AND MATERIALS SHALL BE IN ACCORDANCE WITH CURRENT SOUTH EAST QUEENSLAND WATER SUPPLY CODE SPECIFICATIONS AND STANDARDS.
- UNLESS SPECIFIED OTHERWISE ALL MATERIALS AND WORK SHALL COMPLY WITH THE RELEVANT AUSTRALIAN STANDARDS.
- ADOPT LIP OF KERB OR SHOULDER OF ROAD AS PERMANENT LEVEL.
- COVER ON MAINS FROM PERMANENT LEVEL TO BE AS SHOWN IN SEQ-WAT-1200-2.
- CONDUITS TO BE INSTALLED IN ACCORDANCE WITH THE STANDARD DRAWINGS.
- A WATER METER SUPPLIED AT THE DEVELOPER'S COST, IS TO BE INSTALLED AT THE SERVICE POINT OF EACH LOT IN ACCORDANCE WITH THE STANDARD DRAWING FOR THE SEQ-SP.
- ALL MATERIALS USED IN THE WORKS SHALL COMPLY WITH THE SEQ-SP'S ACCEPTED PRODUCTS AND MATERIALS LIST OR BE APPROPRIATELY SHOWN, LISTED AND DEFINED IN THE ENGINEERING SUBMISSION SO THAT THE ALTERNATIVE PRODUCT OR MATERIAL CAN BE ASSESSED AND IF APPROPRIATE, APPROVED BY THE SEQ-SP.
- TEST/CHLORINATION POINTS TO BE INSTALLED IN ACCORDANCE WITH STANDARD DRAWING No. SEQ-WAT-1410-1.
- THE CONSTRUCTION OF THE WATER RETICULATION WORK SHOWN ON THIS DRAWING MUST BE SUPERVISED BY AN ENGINEER WHO HAS RPEQ REGISTRATION. WORKS NOT COMPLYING WITH THIS REQUIREMENT WILL NOT BE PERMITTED TO CONNECT TO THE RETICULATION SYSTEM.
- THE DESIGN HAS BEEN UNDERTAKEN TO COMPLY WITH CURRENT SOUTH EAST QUEENSLAND SEWERAGE CODE AND QUU STANDARDS.
- CONSTRUCT EMBEDMENT AND TRENCHFILL TO SEQ-WAT-1200-2, 1201-1 TO SEQ-WAT-1204-1 ANS COUNCIL STANDARDS FOR ROADWAY CROSSINGS, WHICHEVER IS MORE ONEROUS.
- PROVIDE BULKHEADS/TRENCHSTOPS IN ACCORDANCE WITH SEQ WATER SUPPLY CODE TABLE 7.5 AND SEQ-WAT-1209-1 AND 1210-1.
- CONSTRUCT THRUST BLOCKS ON ALL VALVES, BENDS, TEES, TAPERS, DEAD ENDS, AND TRANSITIONS TO UNRESTRAINED PIPEWORK TO SEQ-WAT-1205-1 AND 1206-1.
- CONSTRUCT SMALL DIAMETER PROPERTY SERVICES TO SEQ-WAT-1107-1 AND 1107-3.
- INSTALL DETECTABLE MARKER TAPE ON ALL WATER MAINS AND PROPERTY SERVICES.
- CONSTRUCT FIRE HYDRANTS AND STOP VALVES TO SEQ-WAT-1301-1, 1302-1, 1303-2, 1305-1, 1306-1 AND 1409-1.
- CONSTRUCT SCOURS TO SEQ-WAT-1307-2 WHERE NECESSARY. SCOURS WITHIN IPSWICH CITY COUNCIL REGION MUST DISCHARGE INTO AN OPEN STORMWATER GULLY PIT, NOT TO THE INVERT OF KERB AND CHANNEL. DISCHARGE TO KERB AND CHANNEL VIA A STANDARD KERB ADAPTOR THROUGH THE FACE OF THE KERB IS NOT ACCEPTED BY QUEENSLAND URBAN UTILITIES.
- INSTALL PAVEMENT MARKERS TO SEQ-WAT-1300-1 AND 1300-2.
- CONSTRUCT TEST POINTS TO SEQ-WAT-1410-1 AT THE ENDS OF ALL NEW MAINS BEFORE THE SCOUR AND WHERE REQUIRED FOR COMMISSIONING PURPOSES. QUEENSLAND URBAN UTILITIES PREFERENCE IS TO AVOID TAPPING BANDS FOR TEST POINTS AND PROVIDE EITHER A TEMPORARY DUCKFOOT HYDRANT OR FLANGED SHORT PIPE WITH A TEMPORARY TAPPED BLANK FLANGE. TESTING AGAINST LIVE MAINS AND VALVES IS NOT PERMITTED.
- TESTING LOCATIONS AND TEMPORARY FITTINGS ARE REQUIRED ON SERVICES OVER 10M LONG UNLESS APPROVED IN WRITING FOR WORKS TO BE UNDERTAKEN AS LIVE WORKS. TESTING AND AS-CONSTRUCTED REQUIREMENTS TO BE DOCUMENTED ON DRAWINGS.
- 316SS BACKING RINGS SHALL BE USED WITH FULL-FACE PE FLANGES. PE STUB-FLANGES ARE NOT ACCEPTED WHEN JOINING TO EXISTING UNRESTRAINED PIPELINES, PROVIDE A DICL SHORT PIPE WITH THRUST FLANGE AND THRUST BLOCK. BOLT ON UNI FLANGES SHALL NOT BE USED AS THRUST FLANGES. THRUST (PUDDLE) FLANGES SHALL BE AN APPROVED PREFABRICATED DICL/MSC L SHORT PIPE WITH PREFABRICATED THRUST FLANGE.
- AC MAINS SHALL BE REPLACED COLLAR-COLLAR.
- ALL DISUSED SERVICES SHALL BE PLUGGED AT THE MAIN AND FERRULE CLOSED OR TAPPING BAND REMOVED AND SECTION OF MAIN SUBSTITUTED AS LIVE WORKS. LARGE DIAMETER SERVICES SHALL BE DISUSED BY REMOVING ANY PROPERTY SERVICE PIPEWORK AT THE POINT OF CONNECTION TO THE MAIN, AND INSTALLING A BLANK FLANGE DIRECTLY ON THE TEE.
- PROVIDE DN40PE (OR DN32 CU) WATER SERVICES FOR ROAD CROSSINGS SERVICING TWO DWELLINGS. PROVIDE DN32PE (OR DN25 CU) WATER SERVICES FOR ROAD CROSSINGS SERVICING A SINGLE DWELLING. IF THE LONG TERM STATIC HEAD OF THE PROPERTY SERVICE IS LESS THAN 350 kPa (35m) OR IF PRIVATE BOOSTER IS REQUIRED, THE MINIMUM SIZE OF PROPERTY SERVICE SHALL BE 32mm ID.


ASSET REGISTER - WATER RETICULATION					
ESTATE/STAGE		WOODLINKS VILLAGE - STAGE 9A			
SITE ADDRESS		LOT 1 ON SP 266990			
SP FILE/APPLICATION		18-PNT-37793			
Q.U.U. DELEGATES APPROVAL DATE		11.12.2019			
CLIENT		CANNBERRA ESTATES			
DRAWING/PLAN No.		18-0175-304-305			
MAINS	DIAMETER	MATERIAL		LENGTH	
		DESIGN	CONST	DESIGN	CONST
	DN180	PE100 PN16	PE100 PN16	194	189
	DN125	PE100 PN16	PE100 PN16	313	311
SERVICES	DIAMETER	MATERIAL		LENGTH	
		DESIGN	CONST	DESIGN	CONST
	DN25	PE100 PN16	PE100 PN16	37	34
	DN32	PE100 PN16	PE100 PN16	44	13
DN40	PE100 PN16	PE100 PN16	38	27	
METERS	DIAMETER	NUMBER			
		DESIGN	CONST		
	200	19	19		
	250	1	1		
320					

LIVE CONNECTIONS

CONNECTION 1					
STREET ROAD 6					
LOCATION ADJACENT LOT 86 NORTHERN SIDE					
LENGTH	3.00m	TYPE OF MAIN	DN180 PE		
DATE COMMENCED		DATE COMPLETED			
SIGNATURE					
CONNECTION 2					
STREET ROAD 11					
LOCATION ADJACENT LOT 74 NORTHERN SIDE					
LENGTH	3.00m	TYPE OF MAIN	DN125 PE		
DATE COMMENCED		DATE COMPLETED			
SIGNATURE					

SERVICE DETAILS

NO	SIZE	LOT NUMBERS
15	DN25PE	74-86, 250, 805
5	DN32PE	214-218

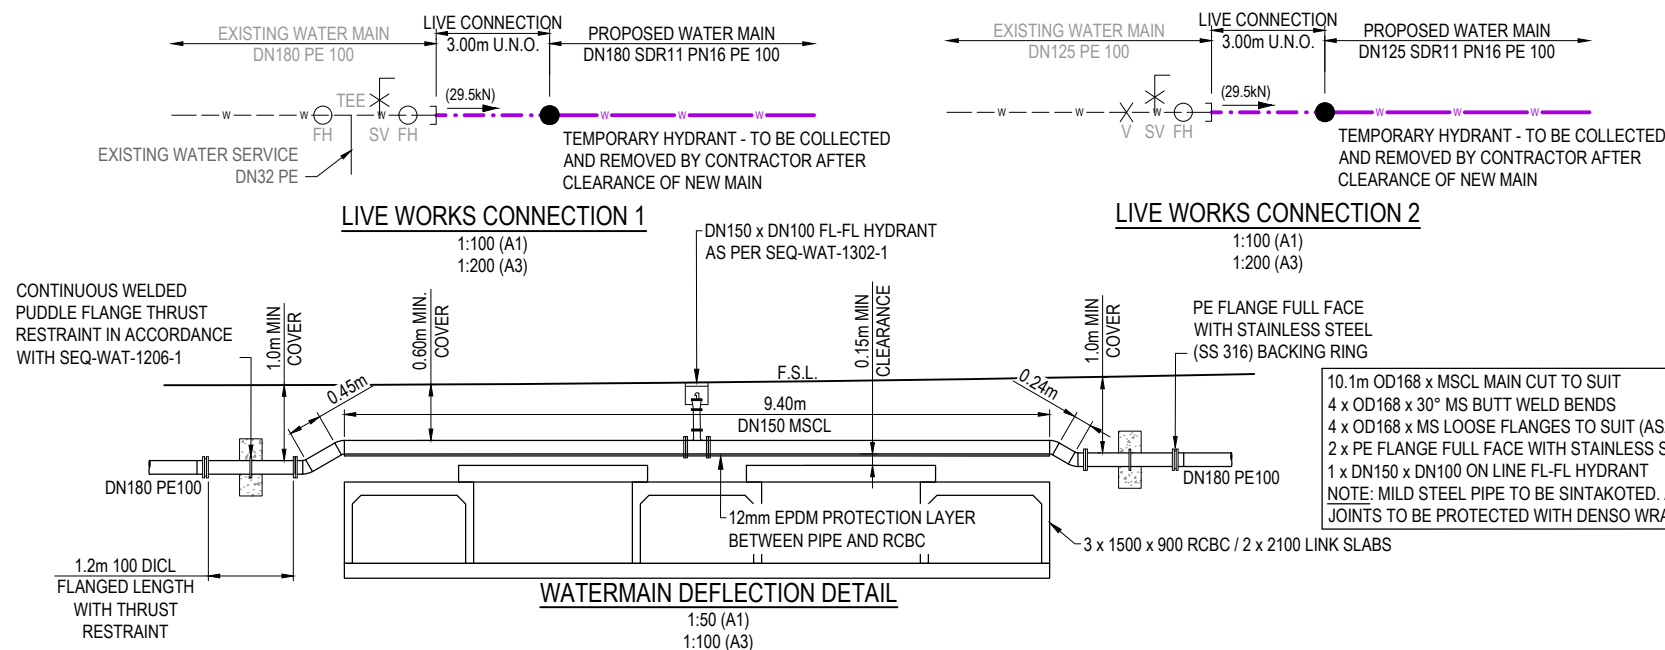

ALL ENVIRONMENTAL PROTECTION MEASURES SHALL BE IMPLEMENTED PRIOR TO ANY CONSTRUCTION WORK COMMENCING, INCLUDING CLEARING

ALL WATER AND SEWERAGE CONSTRUCTION SHALL COMPLY WITH THE REQUIREMENTS OF THE QUEENSLAND WORK HEALTH AND SAFETY ACT 2011. CONTACT THE DIVISION OF WORKPLACE HEALTH AND SAFETY FOR INFORMATION. PHONE 1300 362 128

REV	DATE	DESIGN	DRAWN	ISSUED FOR CONSTRUCTION	REVISION DETAILS	DRAWN	STATUS	SCALE	CLIENT	PROJECT NAME	DRAWING TITLE
A	29.07.20	AC	JW	ISSUED FOR CONSTRUCTION				1:2500 50 0 50 100 A1	CANBERRA ESTATES CONSORTIUM NO.36 PTY LIMITED	WOODLINKS STAGE 9A	WATER RETICULATION COVER PLAN
B	29.09.20	AC	SC	ROAD 6 CUTBACK, DRAINAGE LINE UPDATED & STAGE NAME CHANGED							
C	15.12.20	TD	SC	AS CONSTRUCTED							
					AS CONSTRUCTED	SCOTT THOMAS	RPEQ 04618		SAUNDERS HAVILL GROUP 1300 123 744	COLLINGWOOD DRIVE, COLLINGWOOD PARK	PROJECT No. 18-0175
											DRAWING No. 304
											REVISION C

ENGINEER'S CERTIFICATION

I, SCOTT THOMAS, hereby certify that:
 1. The information contained in this drawing / document is in compliance with approved drawings and design.
 2. The new water and sewerage works defined by this drawing have been designed and constructed in accordance with the SEQ code.
 3. This generally represents an accurate record of as-constructed works
 4. I accept responsibility for the information contained in this drawing / document.

S. Thomas

RPEQ (signature) RPEQ No. 04618 Date: 7/01/21

WATER FITTINGS LEGEND

- PROPOSED:
- FIRE HYDRANT
 - ISOLATION VALVE
 - DEAD END
- EXISTING:
- FIRE HYDRANT
 - ISOLATION VALVE
 - DEAD END
 - REDUCER
 - SCOUR VALVE AND ASSEMBLY
 - WATER SERVICE POINT

LEGEND

- PROPOSED AREA OF WORKS
- PROPOSED WATER MAIN (DN125 PE)
- PROPOSED WATER MAIN (DN180 PE)
- EXISTING WATER MAIN
- FUTURE WATER MAIN
- PROPOSED WATER CONDUIT
- EXISTING WATER CONDUIT
- HIGH POINT / LOW POINT
- INDICATIVE DRIVEWAY LOCATION
- ZERO LOT BOUNDARY
- PROPOSED STORMWATER DRAINAGE PIPE
- EXISTING STORMWATER DRAINAGE PIPE
- PROPOSED ROOFWATER DRAINAGE PIPE
- EXISTING ROOFWATER DRAINAGE PIPE
- PROPOSED SEWER MAIN
- EXISTING SEWER MAIN
- EXISTING ELECTRICAL CABLE U/G
- EXISTING GAS MAIN

NOTE:
 MARKERS FOR PROPERTY SERVICES SHALL BE IN ACCORDANCE WITH SEQ-WAT-1106-1108. MARKERS FOR WATER MAIN CROSSINGS, HYDRANTS AND VALVES SHALL BE IN ACCORDANCE WITH SEQ-WAT-1300-1

LIVE WORKS CONNECTION 1
 (AFTER CLEARANCE ON NEW MAIN):
 3m CONNECTION TO EXISTING MAIN

LIVE WORKS CONNECTION 2
 (AFTER CLEARANCE ON NEW MAIN):
 3m CONNECTION TO EXISTING MAIN

WARNING! - EXISTING SERVICES

EXTREME CARE SHOULD BE TAKEN WHEN EXCAVATING IN THIS AREA. THE FOLLOWING EXISTING SERVICES ARE LIKELY TO BE PRESENT IN THE VICINITY OF THE SITE:

- ELECTRICAL CABLES
- TELECOMMUNICATIONS CABLES
- GAS MAINS
- WATER MAINS
- SEWER MAINS

THE CONTRACTOR SHOULD CONTACT THE SERVICE PROVIDER FOR FURTHER INFORMATION AND SATISFY THEMSELVES OF ANY SPECIFIC TREATMENT OR REQUIREMENTS.




WATERMANS COVER NOTE:

- MINIMUM COVER TO WATERMANS (FROM PERMANENT LEVEL) TO BE:
- ROADS 11 AND 12 = 600mm
 - ROAD 06 = 1000mm

REV	DATE	DESIGN	DRAWN	ISSUED FOR CONSTRUCTION	REVISION DETAILS	DRAWN	STATUS	SCALE	CLIENT	PROJECT NAME	DRAWING TITLE	
A	29.07.20	AC	JW	ISSUED FOR CONSTRUCTION								
B	04.08.20	MG	MG	FIRE HYDRANT LOCATIONS AMENDED								
C	29.09.20	AC	SC	ROAD 6 CUTBACK, DRAINAGE LINE UPDATED & STAGE NAME CHANGED								
D	15.12.20	TD	SC	AS CONSTRUCTED								
<p style="text-align: center;">AS CONSTRUCTED</p>									<p>CANBERRA ESTATES CONSORTIUM NO.36 PTY LIMITED</p>		<p>WOODLINKS STAGE 9A</p>	
<p>DESIGN APPROVED SCOTT THOMAS RPEQ 04618</p>									<p>ASSOCIATED CONSULTANT SAUNDERS HAVILL GROUP 1300 123 744</p>		<p>WATER RETICULATION LAYOUT PLAN</p>	
<p>FOR AND ON BEHALF OF PEAKURBAN PTY LTD</p>							<p>ENQUIRIES@PEAKURBAN.COM.AU</p>		<p>COLLINGWOOD DRIVE, COLLINGWOOD PARK</p>		<p>PROJECT No. 18-0175 DRAWING No. 305 REVISION D</p>	

LEGEND

- EXISTING OVERHEAD CABLE
- PROPOSED OVERHEAD CABLE
- EXISTING UNDERGROUND CABLE
- PROPOSED UNDERGROUND CABLE
- E - PROPOSED ELECTRICAL SERVICE CONDUIT
- ET - PROPOSED ELECTRICAL & COMMUNICATION SERVICE CONDUITS
- POLE TRANSFORMER
- PADMOUNT TRANSFORMER
- HV POLE
- HV / LV POLE
- LV POLE
- HV UNDERGROUND POLE TERMINATION
- LV UNDERGROUND POLE TERMINATION
- AERIAL STAY
- GROUND STAY
- EARTH
- EXISTING PILLAR
- PROPOSED PILLAR
- LINK PILLAR
- CONDUIT / CABLE CROSS-SECTION
- EXISTING STREET LIGHT
- WM X WATER METER (BY OTHERS)
- WM X WATER METER (EXISTING)

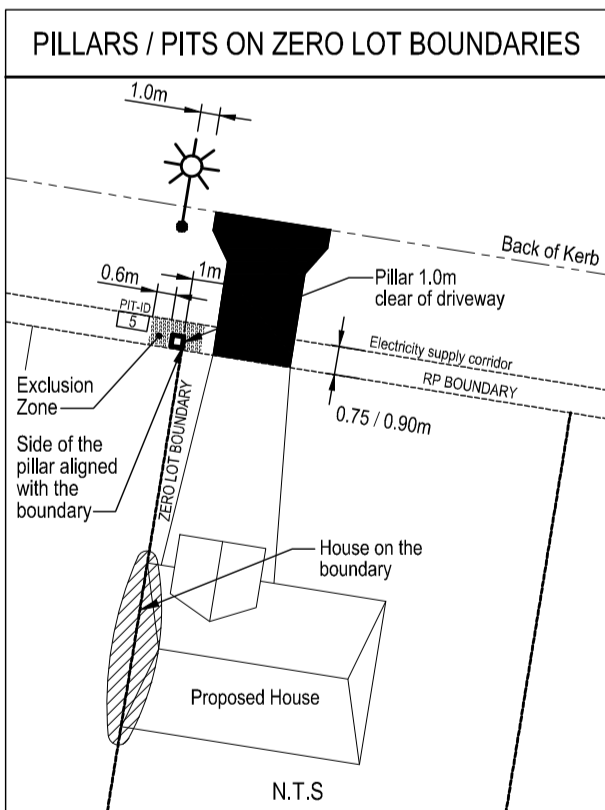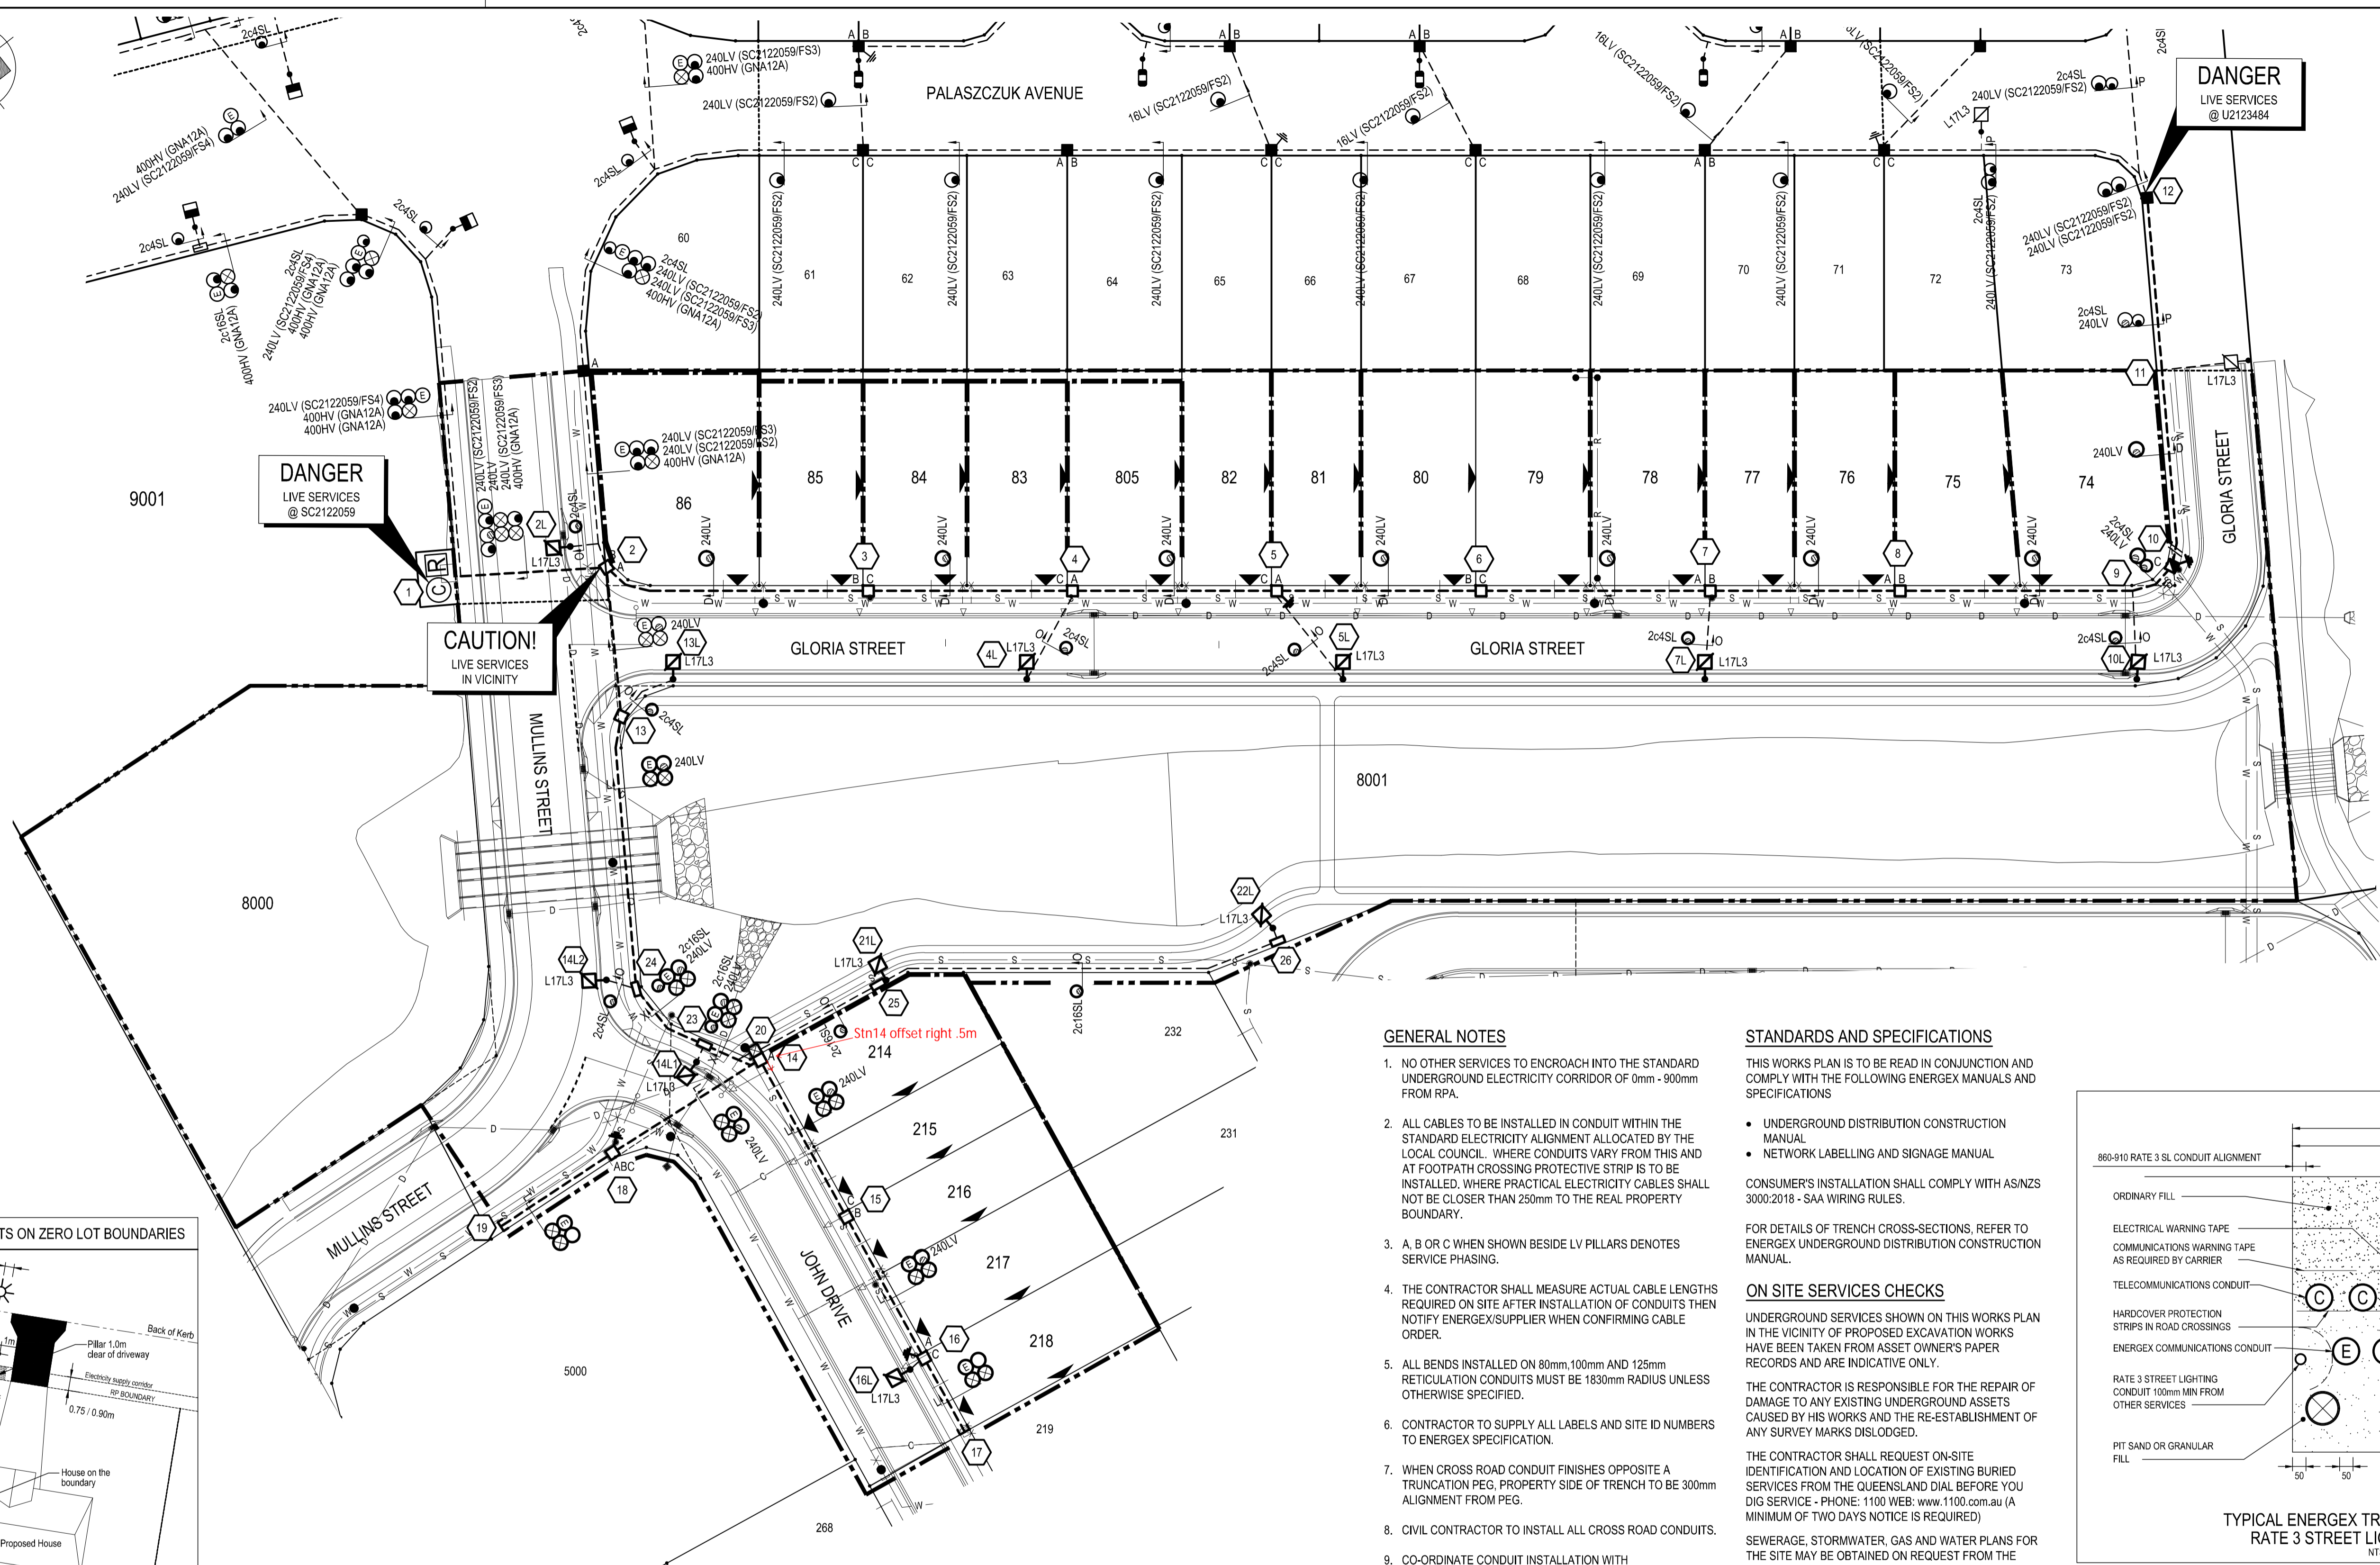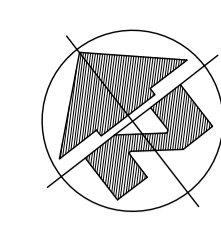

REQUIREMENTS FOR ELECTRICAL, GAS & COMMUNICATIONS

The proposed pillar shall be offset at the zero lot boundary with the side of the pillar being aligned with the lot boundary in order to provide a 1.0m minimum clearance from the future driveway.

A proposed streetlight shall be offset 1.0m from the boundary peg to centre of pole.

COMMUNICATIONS PITS are to remain outside 600mm pillar exclusion zone shall not clash with future driveways.

GAS SERVICE TEE-OFFS are to remain outside 600mm pillar exclusion zone where a pillar is offset to align on one side with the boundary peg.

N.T.S.



NO NON-ENERGEX ASSETS TO BE INSTALLED WITHIN 600mm PILLAR EXCLUSION ZONE.

QUU REQUIRE 1.1m CLEARANCE BETWEEN ELECTRICAL PILLARS AND WATER METERS. INSTALL WATER METERS MINIMUM 1.5m FROM BOUNDARY PEG WHERE WATER METERS SHARE A COMMON BOUNDARY WITH ELECTRICAL PILLARS.

ENERGEX REQUIRE 1.0m CLEARANCE BETWEEN SERVICE PILLARS AND DRIVEWAYS. IF LESS THAN 1.0m SEPARATION THEN PROTECTIVE BOLLARDS MUST BE INSTALLED.

GENERAL NOTES

1. NO OTHER SERVICES TO ENCRUSH INTO THE STANDARD UNDERGROUND ELECTRICITY CORRIDOR OF 0mm - 900mm FROM RPA.
2. ALL CABLES TO BE INSTALLED IN CONDUIT WITHIN THE STANDARD ELECTRICITY ALIGNMENT ALLOCATED BY THE LOCAL COUNCIL. WHERE CONDUITS VARY FROM THIS AND AT FOOTPATH CROSSING PROTECTIVE STRIP IS TO BE INSTALLED. WHERE PRACTICAL ELECTRICITY CABLES SHALL NOT BE CLOSER THAN 250mm TO THE REAL PROPERTY BOUNDARY.
3. A, B OR C WHEN SHOWN BESIDE LV PILLARS DENOTES SERVICE PHASING.
4. THE CONTRACTOR SHALL MEASURE ACTUAL CABLE LENGTHS REQUIRED ON SITE AFTER INSTALLATION OF CONDUITS THEN NOTIFY ENERGEX/SUPPLIER WHEN CONFIRMING CABLE ORDER.
5. ALL BENDS INSTALLED ON 80mm, 100mm AND 125mm RETICULATION CONDUITS MUST BE 1830mm RADIUS UNLESS OTHERWISE SPECIFIED.
6. CONTRACTOR TO SUPPLY ALL LABELS AND SITE ID NUMBERS TO ENERGEX SPECIFICATION.
7. WHEN CROSS ROAD CONDUIT FINISHES OPPOSITE A TRUNCATION PEG, PROPERTY SIDE OF TRENCH TO BE 300mm ALIGNMENT FROM PEG.
8. CIVIL CONTRACTOR TO INSTALL ALL CROSS ROAD CONDUITS.
9. CO-ORDINATE CONDUIT INSTALLATION WITH COMMUNICATIONS CARRIER CONTRACTORS.
10. ELECTRICITY PILLARS TO HAVE 600mm EXCLUSION ZONE FROM ALL OTHER SERVICES.

CONSTRUCTION CONTRACTOR

THE CONTRACTOR SHALL BE RATED BY ENERGEX FOR THE FOLLOWING PROCESS:

- WCS 2 - UNDERGROUND CONSTRUCTION
- WCS 31 - COMMISSIONING AND OPERATION OF THE NETWORK
- WCS 34 - EARTHING SYSTEMS
- WCS 61 - UNDERGROUND CIVIL CONSTRUCTION

STANDARDS AND SPECIFICATIONS

THIS WORKS PLAN IS TO BE READ IN CONJUNCTION AND COMPLY WITH THE FOLLOWING ENERGEX MANUALS AND SPECIFICATIONS

- UNDERGROUND DISTRIBUTION CONSTRUCTION MANUAL
- NETWORK LABELLING AND SIGNAGE MANUAL

CONSUMER'S INSTALLATION SHALL COMPLY WITH AS/NZS 3000:2018 - SAA WIRING RULES.

FOR DETAILS OF TRENCH CROSS-SECTIONS, REFER TO ENERGEX UNDERGROUND DISTRIBUTION CONSTRUCTION MANUAL.


ON SITE SERVICES CHECKS

UNDERGROUND SERVICES SHOWN ON THIS WORKS PLAN IN THE VICINITY OF PROPOSED EXCAVATION WORKS HAVE BEEN TAKEN FROM ASSET OWNER'S PAPER RECORDS AND ARE INDICATIVE ONLY.

THE CONTRACTOR IS RESPONSIBLE FOR THE REPAIR OF DAMAGE TO ANY EXISTING UNDERGROUND ASSETS CAUSED BY HIS WORKS AND THE RE-ESTABLISHMENT OF ANY SURVEY MARKS DISLODGED.

THE CONTRACTOR SHALL REQUEST ON-SITE IDENTIFICATION AND LOCATION OF EXISTING BURIED SERVICES FROM THE QUEENSLAND DIAL BEFORE YOU DIG SERVICE - PHONE: 1100 WEB: www.1100.com.au (A MINIMUM OF TWO DAYS NOTICE IS REQUIRED)

SEWERAGE, STORMWATER, GAS AND WATER PLANS FOR THE SITE MAY BE OBTAINED ON REQUEST FROM THE PROJECT SERVICE SUPERVISOR.

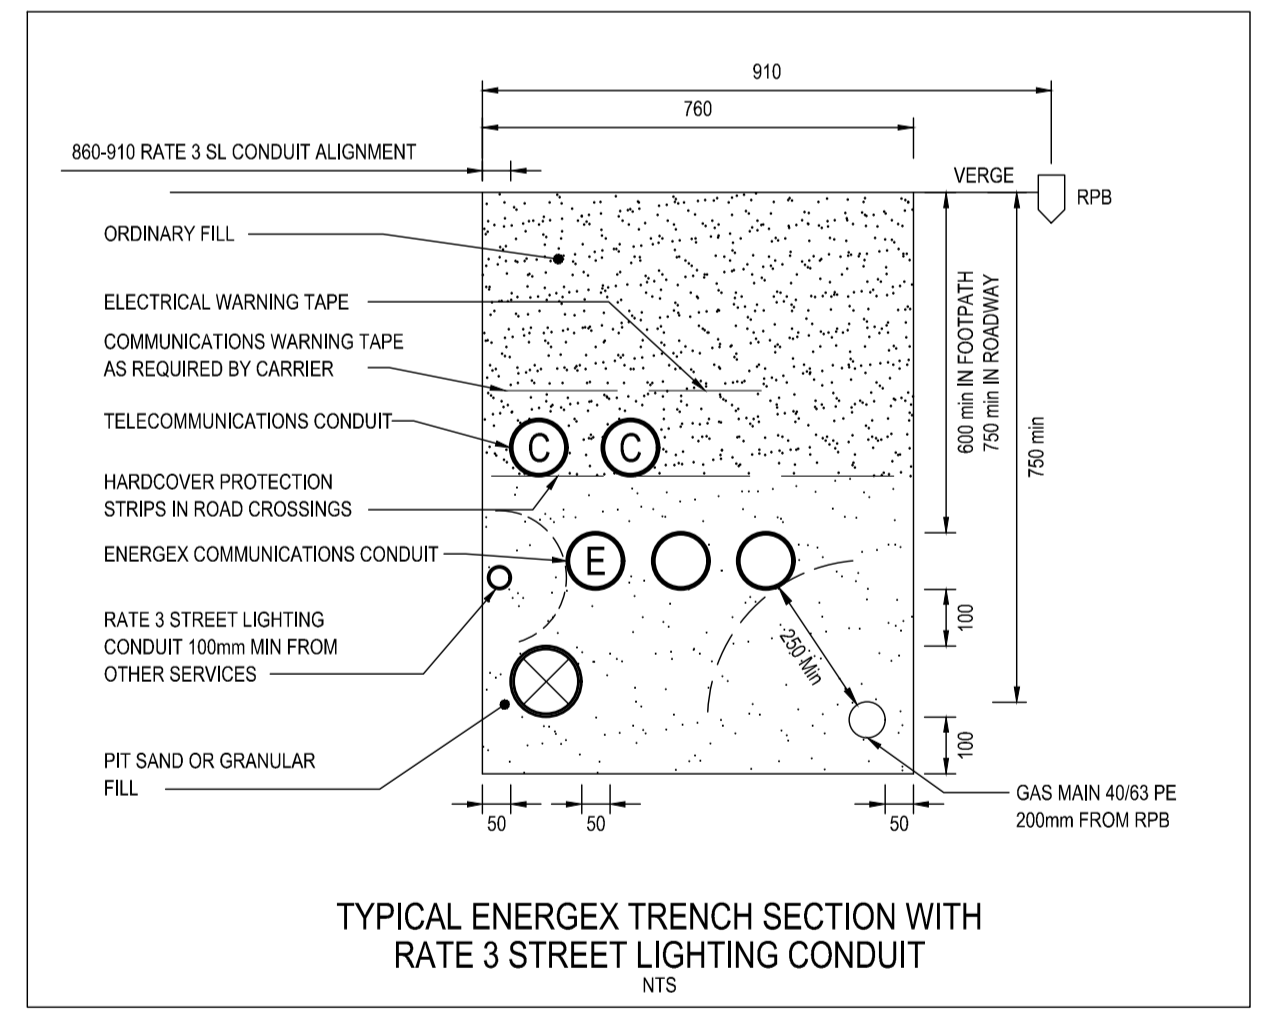

TYPICAL ENERGEX TRENCH SECTION WITH RATE 3 STREET LIGHTING CONDUIT N.T.S.

REFER TO DWG S2601679 FOR RATE 3 STREET LIGHTING.

Fire Ant Biosecurity

Caution

Zone 1

For Info

Call 13 25 23

ALL KERB OUTLET PIPES TO BE 600mm CLEAR OF THE PROPOSED ELECTRICAL PILLARS

WHERE CROSS-ROAD ELECTRICITY CONDUITS RUN PARALLEL TO OTHER SERVICES OR CONDUITS, A MINIMUM SEPARATION OF 1.0m MUST BE MAINTAINED.

DO NOT CONSTRUCT DRIVEWAYS/CROSSOVERS UNTIL ELECTRICAL WORKS ARE COMPLETED.

FOR CONSTRUCTION

03/03/2021 9:25 AM

AS CONSTRUCTED

Garry Edwards Date: 25/01/21

INZ ELECTRICAL SERVICES PTY LTD

97 ZILLMERE ROAD

BOONDALL 4034 QLD

PH 3865 2122 FAX 3865 4475



TO BE BUILT IN CONJUNCTION WITH TELECOMMUNICATIONS CABLE PROVISIONING AND JOINT USE GAS



Electrical and Telecommunications Consultants

07 3372 9280 - projects@ampflo.com.au

ampflo.com.au

CERTIFICATION:

APPROVED: Brad Kunde

RPEQ No: 16286

DATE: 3/03/2021

CHECKED: S.THOMPSON

DESIGNER: B.HYLAND

ISSUE DATE: 27.08.20

PROJECT

WOODLINKS VILLAGE STAGE 9

MULLINS STREET, COLLINGWOOD PARK

ELECTRICAL RETICULATION PLAN

LEGEND AND NOTES

CLIENT: CANBERRA ESTATES CONSORTIUM NO.36 PTY LTD

DRAWING: A201339

PROJECT: 201339

SHEET 1 OF 2

ISSUE

E

This document is the property of Ampflo Pty Ltd and may only be used for the purpose for which it was commissioned. Unauthorised use is prohibited.

REV	DATE	DETAILS	DRAWN	CHECKED	APPRVD
E	27.08.20	PATHWAY LIGHTING ADDED AS PER ICC DEMAND	BH	BK	BK
D	25.08.20	REVISED TO CORRECT WORKSPLAN NUMBER	BH	BK	BK
C	13.08.20	ISSUED FOR CONSTRUCTION	BH	BK	BK
B	13.08.20	ISSUED FOR APPROVAL	BH	BK	BK
A	24.07.20	PRELIMINARY ISSUE	BH	ST	CR

NOTES LEGEND

NOTES FOR DEVELOPERS ATTENTION
NOTES FOR ELECTRICAL CONTRACTORS ATTENTION
NOTES FOR CIVIL CONTRACTORS ATTENTION

SITE CONTACT DETAILS		ALIGNMENTS		PROJECT / SUB PROJECT NO.	
NAME	REBECCA DELAY	ENERGEX OH	0.7 FR KI	S2601678	
COMPANY	CANBERRA ESTATES	ENERGEX UG	0-0.91	PARENT PROJECT NO.	
PHONE	0421 078 630	TELSTRA	0.91-1.3	WORK REQUEST NO.	
FAX		GAS	3.41-3.81	PLANNER & PHONE	SUBDIVISIONS
		HP GAS	3.41-3.81	LOTS	LOTS 74-86, 805, 214-218
		WATER	2.21-2.81	CANCELLING LOTS	PART LOT 5007 ON SP317659
		STORMWATER	IN ROAD	LOCAL AUTHORITY	IPSWICH CITY COUNCIL
		SEWERAGE	1.3-2.21	PEGGED?	ON REQUEST

FILE: P:\20133901\WORKING DRAWINGS\20133901.DWG

CIVIL WORKS SCHEDULE - ROAD CROSSINGS													
LOCATION	STATIONS FROM - TO	CONDUIT LENGTH (m)						X-SECTION (m)		DRAW WIRE	KERB MARK	REMARKS	
		40 HD		100		125		P100 COMMS	EXCAV /TAPE				TRENCH DETAIL
		No.	m	No.	m	No.	m						
MULLINS STREET	1-2										EXISTING CONDUITS		
GLORIA STREET	2-13										EXISTING CONDUITS		
JOHN DRIVE	14-18			1	25	2	25	25	25	L			
TOTAL					25m		50m	25m	25				

RATE 3 CIVIL WORKS SCHEDULE - ROAD CROSSINGS													
LOCATION	STATIONS FROM - TO	CONDUIT LENGTH (m)						X-SECTION (m)		DRAW WIRE	KERB MARK	REMARKS	
		40 HD		100		125		P100 COMMS	EXCAV /TAPE				TRENCH DETAIL
		No.	m	No.	m	No.	m						
GLORIA STREET	4-4L	1	16						16	O	18	2	
	5-5L	1	17						17	O	19	2	
	7-7L	1	14						14	O	16	2	
	9-10L	1	15						15	O	17	2	
TOTAL			62m						62		70	8	

URD CIVIL WORKS SCHEDULE													
LOCATION	STATIONS FROM - TO	CONDUIT LENGTH (m)						X-SECTION (m)		DRAW WIRE	KERB MARK	REMARKS	
		40 HD		100mm		125mm		P100 COMMS	EXCAV /TAPE				TRENCH DETAIL
		No.	m	No.	m	No.	m						
GLORIA STREET	2-3			1	39				39	D	41		
	3-4			1	29				29	D	31		
	4-5			1	30				30	D	32		
	5-6			1	29				29	D	31		
	6-7			1	33				33	D	35		
	7-8			1	27				27	D	29		
	8-9			1	34				34	D	36		
	9-10			1	8				8	P	10	REFER TO RATE 3 SCHEDULE	
	10-11			1	29				29	D	31		
	11-12											EXISTING CONDUITS	
MULLINS STREET	13-14			1	60	2	60	60	60	L	248		
JOHN DRIVE	14-15			1	26	2	26	26	26	L	112		
	15-16			1	23	2	23	23	23	L	100		
	16-17			1	14	2	14	14	14	L	64		
MULLINS STREET	18-19			1	20	2	20	20	20	L	88		
TOTAL					401m		286m		143m		888		

RATE 3 URD CIVIL WORKS SCHEDULE													
LOCATION	STATIONS FROM - TO	CONDUIT LENGTH (m)						X-SECTION (m)		DRAW WIRE	KERB MARK	REMARKS	
		40 HD		100		125		P100 COMMS	EXCAV /TAPE				TRENCH DETAIL
		No.	m	No.	m	No.	m						
MULLINS STREET	2-2L	1	9						9	O	11		
GLORIA STREET	9-10	1	8							P	10		
	13-13L	1	11						11	O	13		
JOHN DRIVE	14-20	1	6						6	O	8		
	20-14L1	1	13						6	X+O	15		
	14L1-14L2	1	22						6	X+O	24		
	16-16L	1	4						4	O	6		
PATHWAY	20-21L	1	25						25	O	27		
	21L-22L	1	62						62	O	64		
TOTAL			160m						129		178		


UNDERGROUND CABLE SCHEDULE									
LOCATION	STATIONS FROM - TO	EX	REC	IN	11kV CABLE		415 VOLT		REMARKS
					240mm AL TRIPLEX	11AT24XSH	240mm AL XLPE	LVA424XPV	
MULLINS STREET	1-2			*			30		
GLORIA STREET	2-5			*			43		
	2-13			*			26		
	3-4			*			33		
	4-5			*			34		
	5-6			*			33		
	6-7			*			37		
	7-8			*			31		
	8-10			*			46		
	10-12			*			57		
MULLINS STREET	13-14			*			64		
JOHN DRIVE	14-15			*			30		
	14-18			*			29		
	15-16			*			27		
TOTAL							520		

EQUIPMENT SCHEDULE												
LOCATION	STN NO	SITE ID	EXIST	REC	INSTALL	SIZE AND DESCRIPTION	IN	COMP ID	PLANT No.	MODEL ID	QTY	REMARKS
MULLINS STREET	1	SC2122059	*		*	EXISTING TRANSFORMER TO REMAIN						
					*	315A LV FUSE LINK FOR LV BOARD				DSLVF31	1	
					*	LV TERMINATION				LVP74C240	1	
GLORIA STREET	2	U2232803			*	SERVICE PILLAR 3 WAY + SL		P11		LVSP9-6SL	1	3x240LV
	3	U2232804			*	SERVICE PILLAR 2 WAY		P11		LVSP4-6	1	2x240LV
	4	U2232805			*	SERVICE PILLAR 2 WAY + SL		P11		LVSP4-6SL	1	2x240LV
	5	U2232806			*	SERVICE PILLAR 2 WAY + SL		P11		LVSP4-6SL	1	2x240LV
	6	U2232807			*	MEN PILLAR EARTHING				LV4CMEN	1	
	7	U2232808			*	SERVICE PILLAR 2 WAY		P11		LVSP4-6	1	2x240LV
	8	U2232809			*	SERVICE PILLAR 2 WAY + SL		P11		LVSP4-6SL	1	2x240LV
	10	LP2232810			*	LINK PILLAR + SL		P13		LVSP14-6SL	1	2x240LV
	12	U2123484	*		*	MEN PILLAR EARTHING				LV4CMEN	1	
					*	CONVERT 2 WAY PILLAR TO 3 WAY				LVSPC2W3	1	2x240LV
					*	240mm 4 CORE CABLE LV LUG SET				LVSP1240	1	1x240LV
MULLINS STREET	13	U2232811			*	SERVICE PILLAR 2 WAY + SL		P11		LVSP4-6SL	1	2x240LV
JOHN DRIVE	14	U2232812			*	SERVICE PILLAR 3 WAY + SL		P11		LVSP9-6SL	1	3x240LV
	15	U2232813			*	SERVICE PILLAR 2 WAY		P11		LVSP4-6	1	2x240LV
	16	U2232814			*	SERVICE PILLAR 1 WAY + SL		P11		LVSP2-6SL	1	1x240LV
	18	U2232815			*	MEN PILLAR EARTHING				LV4CMEN	1	
					*	SERVICE PILLAR 1 WAY		P11		LVSP2-6	1	1x240LV
					*	MEN PILLAR EARTHING				LV4CMEN	1	

SUMMARY SHEET - S02601678			
UNDERGROUND MATERIALS			
(Supplied by the URD Contractor)		(Supplied by the URD Contractor)	
MODEL No.	No. OFF	MODEL No.	No. OFF
LVSP9-6	1	S25117	
LVSP2-6SL	1	S25118	
LVSP4-6	4	SC34141	
LVSP4-6SL	4	SC34142	
LVSP9-6	2	DSHV3SLK	
LVSP9-6SL	2	DSHV3SLK	
LVSP12-6		DSLVF31	1
LVSP12-6SL		DSLVF31	
LVSP14-6		2DBST424D	
LVSP14-6SL	1	1CF09824XLG	
LVSP21-6		1SGT0M9524XG	
LVSP21-6SL		DSSOPMEG	
LVSP12-6			
LVSP12-6SL			
LVSP14-6			
LVSP14-6SL			
LVSP21-6			
LVSP21-6SL			
LVSP1016			
LVSP1240	1		
LVSP4CCB1			
LVSPH11		SC0008351	
LVP74C240	1	11AT240XSH	
LV4CMEN	4	11CT240XSH	
LVSPC2W3	1		
TOTAL			
TRENCH LENGTH	401		

URD CONTRACTOR SHALL NOTE THAT THIS SUMMARY SHEET MUST NOT BE USED FOR TENDER PURPOSES. THE CONTRACTOR SHALL CHECK QUANTITIES AGAINST ACTUAL SCHEDULES ON THESE DRAWINGS.

- SWITCHING & COMMISSIONING PLAN - LV**
(subject to site conditions, amendments by switching co-ordinator and approval by LV outage co-ordinator)
- SWITCHING**
1. INSTALL PROPOSED UG NETWORK AS PER PLANS
 2. OPEN SC2122059 SWITCHFUSE 2
 3. MAKE NEW CONNECTIONS AT U2123484 (STN 12)
 4. CLOSE SC2122059 SWITCHFUSE 5 & 2
 5. TEST AND COMMISSION
 6. PERFORM POST COMMISSIONING CHECKS

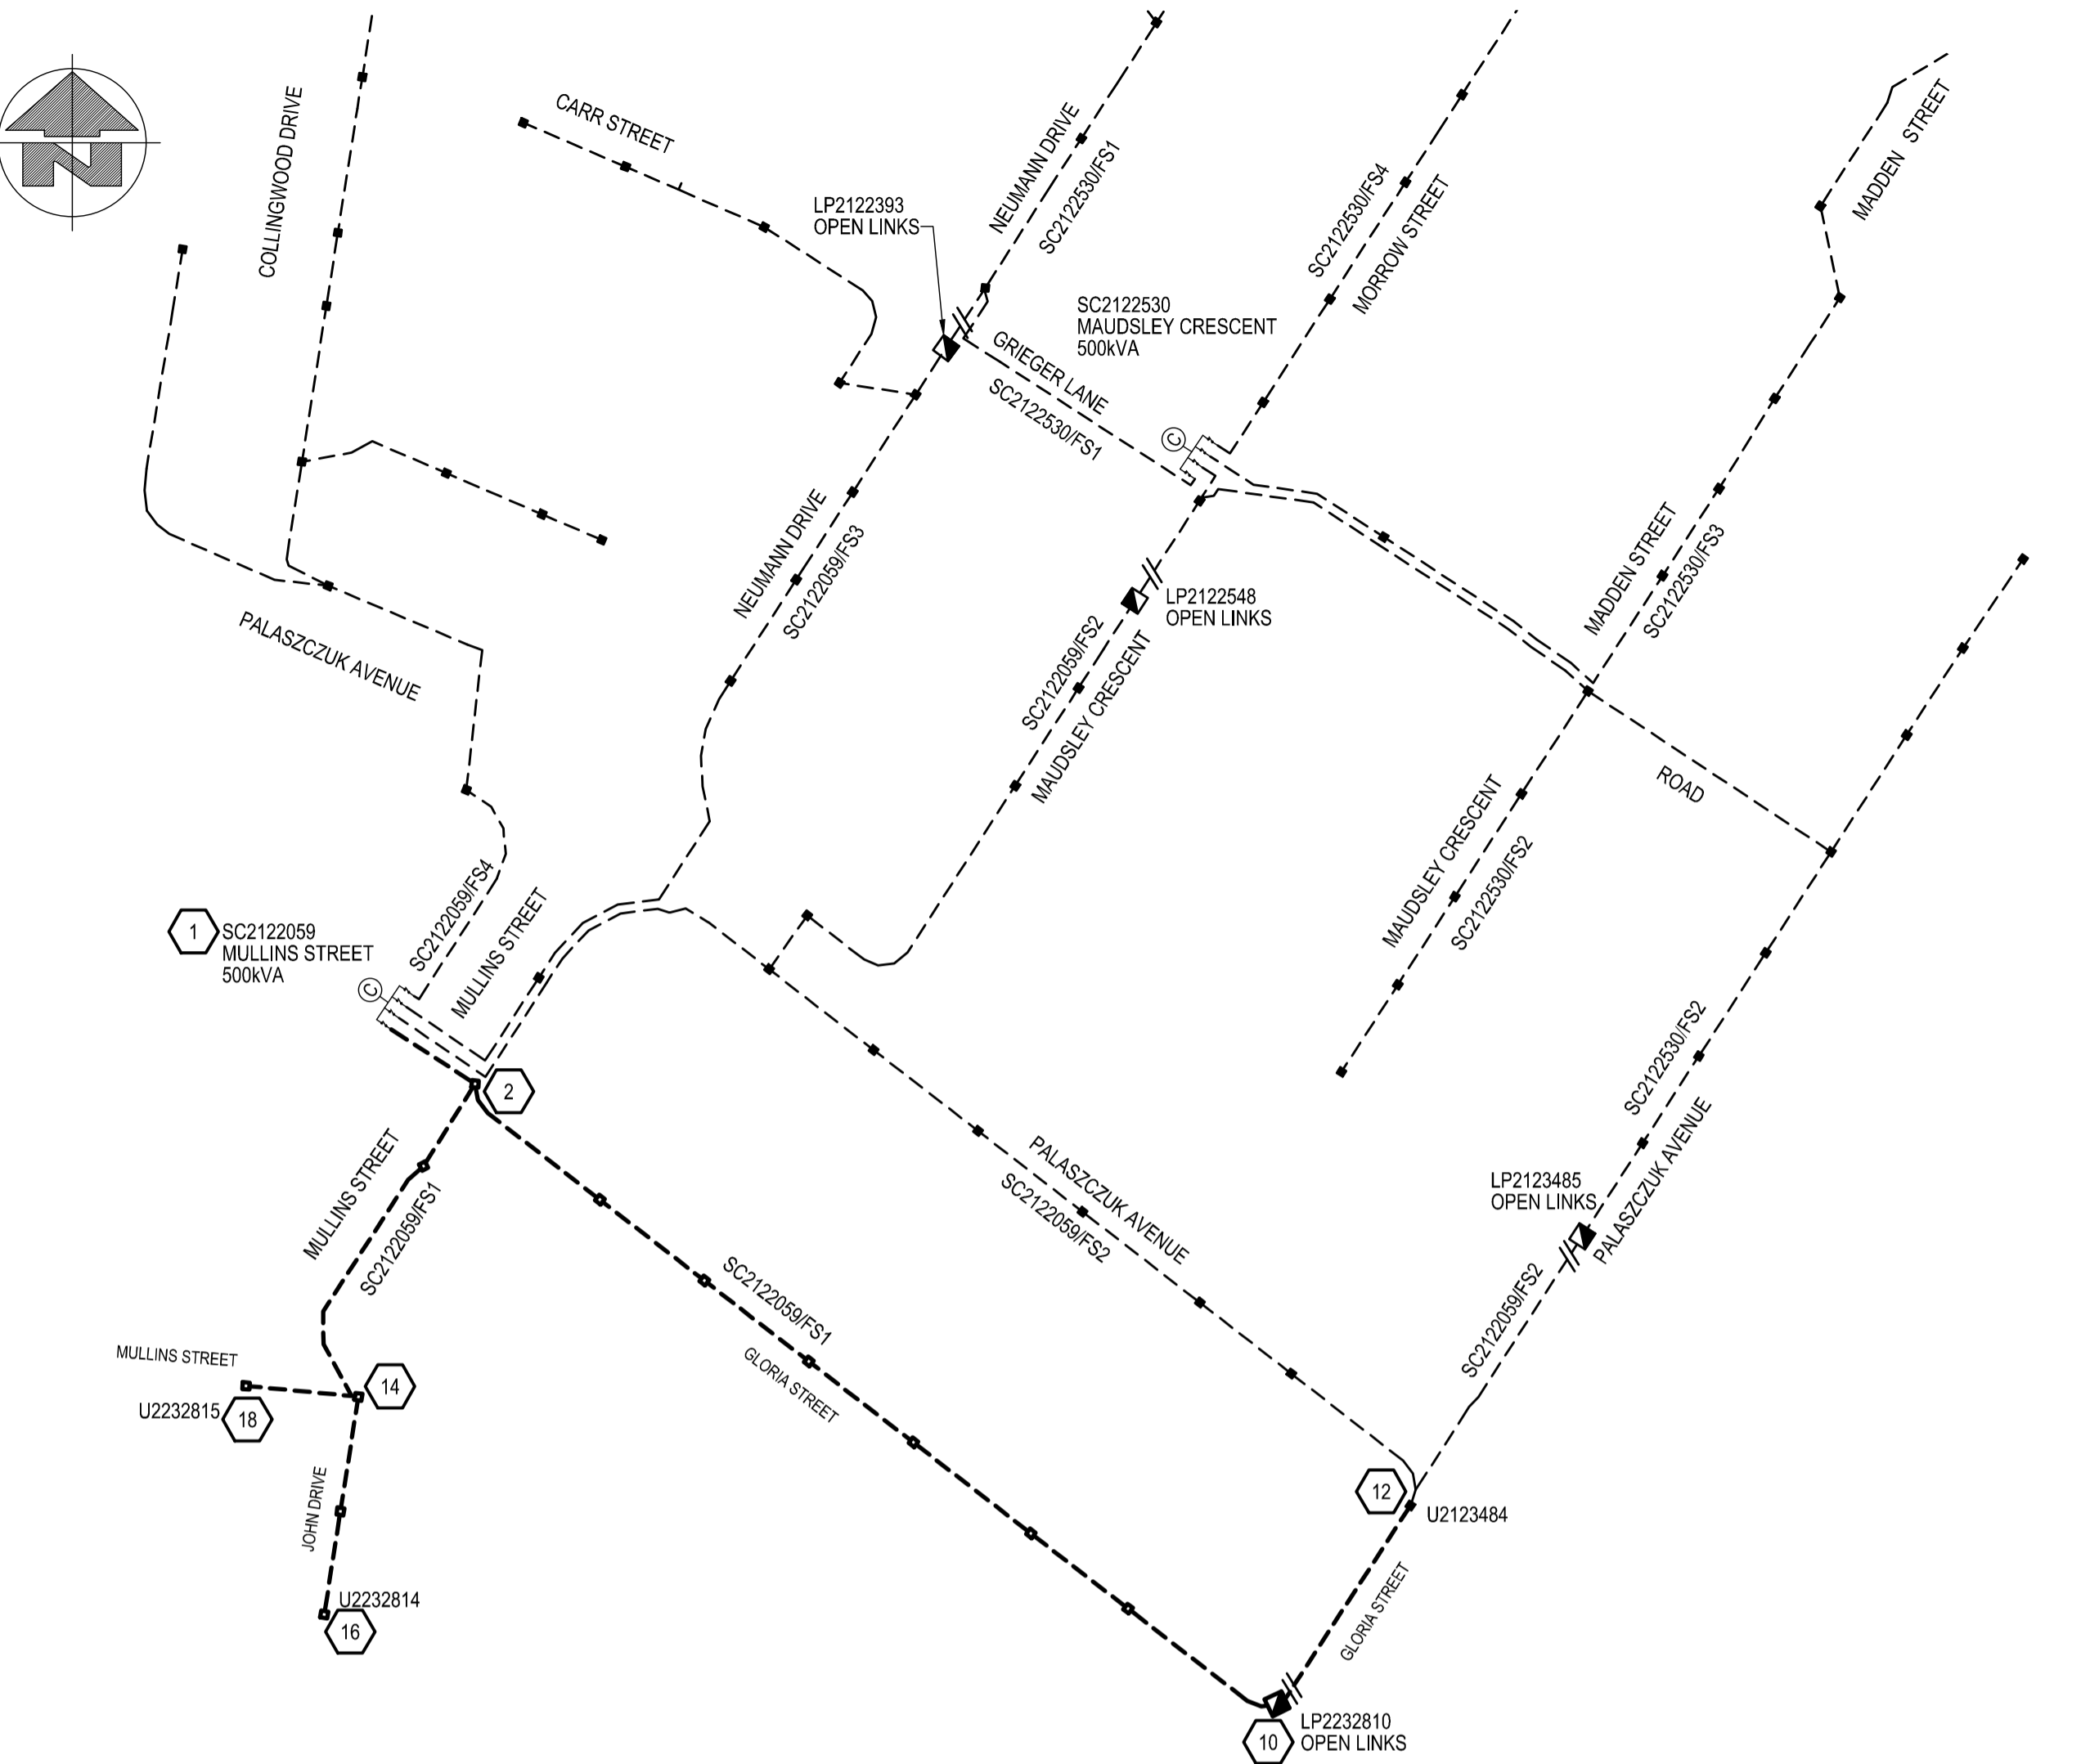

EXISTING & PROPOSED LV SCHEMATIC DIAGRAM
 SCALE 1:1500
 ALL NEW LV CABLES TO BE 4c 240mm AL XLPE UNO

LP2123485 - PALASZCZUK AVENUE				
CABLE No.	LABEL SIZE	LABEL COLOUR	LETTER SIZE	LABEL INFORMATION
1	150x50	WB	5mm	TO MULLINS STREET SC2122059 / MAUDSLEY CRESCENT LP2122548 / GLORIA STREET LP2232810 AND SERVICES
2	150x50	WB	5mm	EXISTING LABEL

LP2122548 - MAUDSLEY CRESCENT				
CABLE No.	LABEL SIZE	LABEL COLOUR	LETTER SIZE	LABEL INFORMATION
1	150x50	WB	5mm	TO MULLINS STREET SC2122059 / PALASZCZUK AVENUE LP2123485 / GLORIA STREET LP2232810 AND SERVICES
2	150x50	WB	5mm	EXISTING LABEL

LP2232810 - GLORIA STREET				
CABLE No.	LABEL SIZE	LABEL COLOUR	LETTER SIZE	LABEL INFORMATION
1	150x50	WB	5mm	TO MULLINS STREET SC2122059 / MAUDSLEY CRESCENT LP2122548 / PALASZCZUK AVENUE LP2123485 AND SERVICES
2	150x50	WB	5mm	TO MULLINS STREET SC2122059 AND SERVICES

SC2122059 - MULLINS STREET				
CCT No.	LABEL SIZE	LABEL COLOUR	LETTER SIZE	LABEL INFORMATION
	80x35	WB	6mm	TRANSFORMER ISOLATOR
1	80x35	WB	5mm	TO GLORIA STREET LP2232810 / TO MULLINS STREET U2232815 / JOHN DRIVE U2232814 AND SERVICES
2	80x35	WB	5mm	TO MAUDSLEY CRESCENT LP2122548 / PALASZCZUK AVENUE LP2123485 / GLORIA STREET LP2232810 AND SERVICES
3	80x35	WB	5mm	EXISTING LABEL
4	80x35	WB	5mm	EXISTING LABEL

AS CONSTRUCTED
 Garry Edwards (Date: 25/01/21)
 INZ ELECTRICAL SERVICES PTY LTD
 97 ZILLMERE ROAD
 BOONDALL 4034 QLD
 PH 3865 2122 FAX 3865 4475

FOR CONSTRUCTION
 03/03/2021 9:25 AM



This document is the property of Ampflo Pty Ltd and may only be used for the purpose for which it was commissioned. Unauthorised use is prohibited.

REV	DATE	DETAILS	DRAWN	CHECKED	APPRVD
E	27.08.20	PATHWAY LIGHTING ADDED AS PER ICC DEMAND	BH	BK	BK
D	25.08.20	REVISED TO CORRECT WORKSPLAN NUMBER	BH	BK	BK
C	13.08.20	ISSUED FOR CONSTRUCTION	BH	BK	BK
B	13.08.20	ISSUED FOR APPROVAL	BH	BK	BK
A	24.07.20	PRELIMINARY ISSUE	BH	ST	CR

NOTES LEGEND


NOTES FOR DEVELOPERS ATTENTION

NOTES FOR ELECTRICAL CONTRACTORS ATTENTION

NOTES FOR CIVIL CONTRACTORS ATTENTION

SITE CONTACT DETAILS		ALIGNMENTS		PROJECT / SUB PROJECT NO.	
NAME	REBECCA DELAY	ENERGEX OH	0.7 FR KI	S2601678	
COMPANY	CANBERRA ESTATES	ENERGEX UG	0-0.91	PARENT PROJECT NO.	
PHONE	-	TELSTRA	0.91-1.3	WORK REQUEST NO.	
MOBILE	0421 078 630	GAS	3.41-3.81	PLANNER & PHONE	SUBDIVISIONS
FAX	-	HP GAS	3.41-3.81	LOTS	LOTS 74-86, 805, 214-218
		WATER	2.21-2.81	CANCELLING LOTS	PART LOT 5007 ON SP317659
		STORMWATER			

- NOTES**
1. INSTALL PIT AND PIPE INFRASTRUCTURE TO NBN Co SPECIFICATION AND STANDARDS. NBN Co PIT AND CONDUIT INFRASTRUCTURE GUIDE LINES FOR DEVELOPERS CAN BE FOUND ONLINE AT <http://www.nbnco.com.au/industry/new-developments.html>
 2. PIT AND PIPE INFRASTRUCTURE TO BE INSPECTED BY NBN Co AFTER INSTALLATION.
 3. INSTALL P23 LEAD-IN PIPES FROM PIT TO PROPERTY ENTRY POINT AND PLUG.
 4. ALL CONDUITS TO BE INSTALLED IN JOINT USE TRENCH UNLESS DETAILED OTHERWISE.
 5. ALL MATERIALS SHALL BE TO NBN Co SPECIFICATION. ALTERNATIVES WILL ONLY BE ACCEPTED IF AGREED TO IN WRITING BY NBN Co.
 6. THE LOCATION OF PIT AND PIPE INFRASTRUCTURE SHALL ALSO COMPLY WITH THE REQUIREMENTS OF ENERGEX.
 7. CONSTRUCTOR TO CONFIRM FINAL LOCATION OF PROPOSED DRIVEWAYS AND SERVICES PRIOR TO CONSTRUCTION. NBN Co PITS TO BE INSTALLED CLEAR OF DRIVEWAYS & OTHER SERVICES INCLUDING ALL PROPOSED.

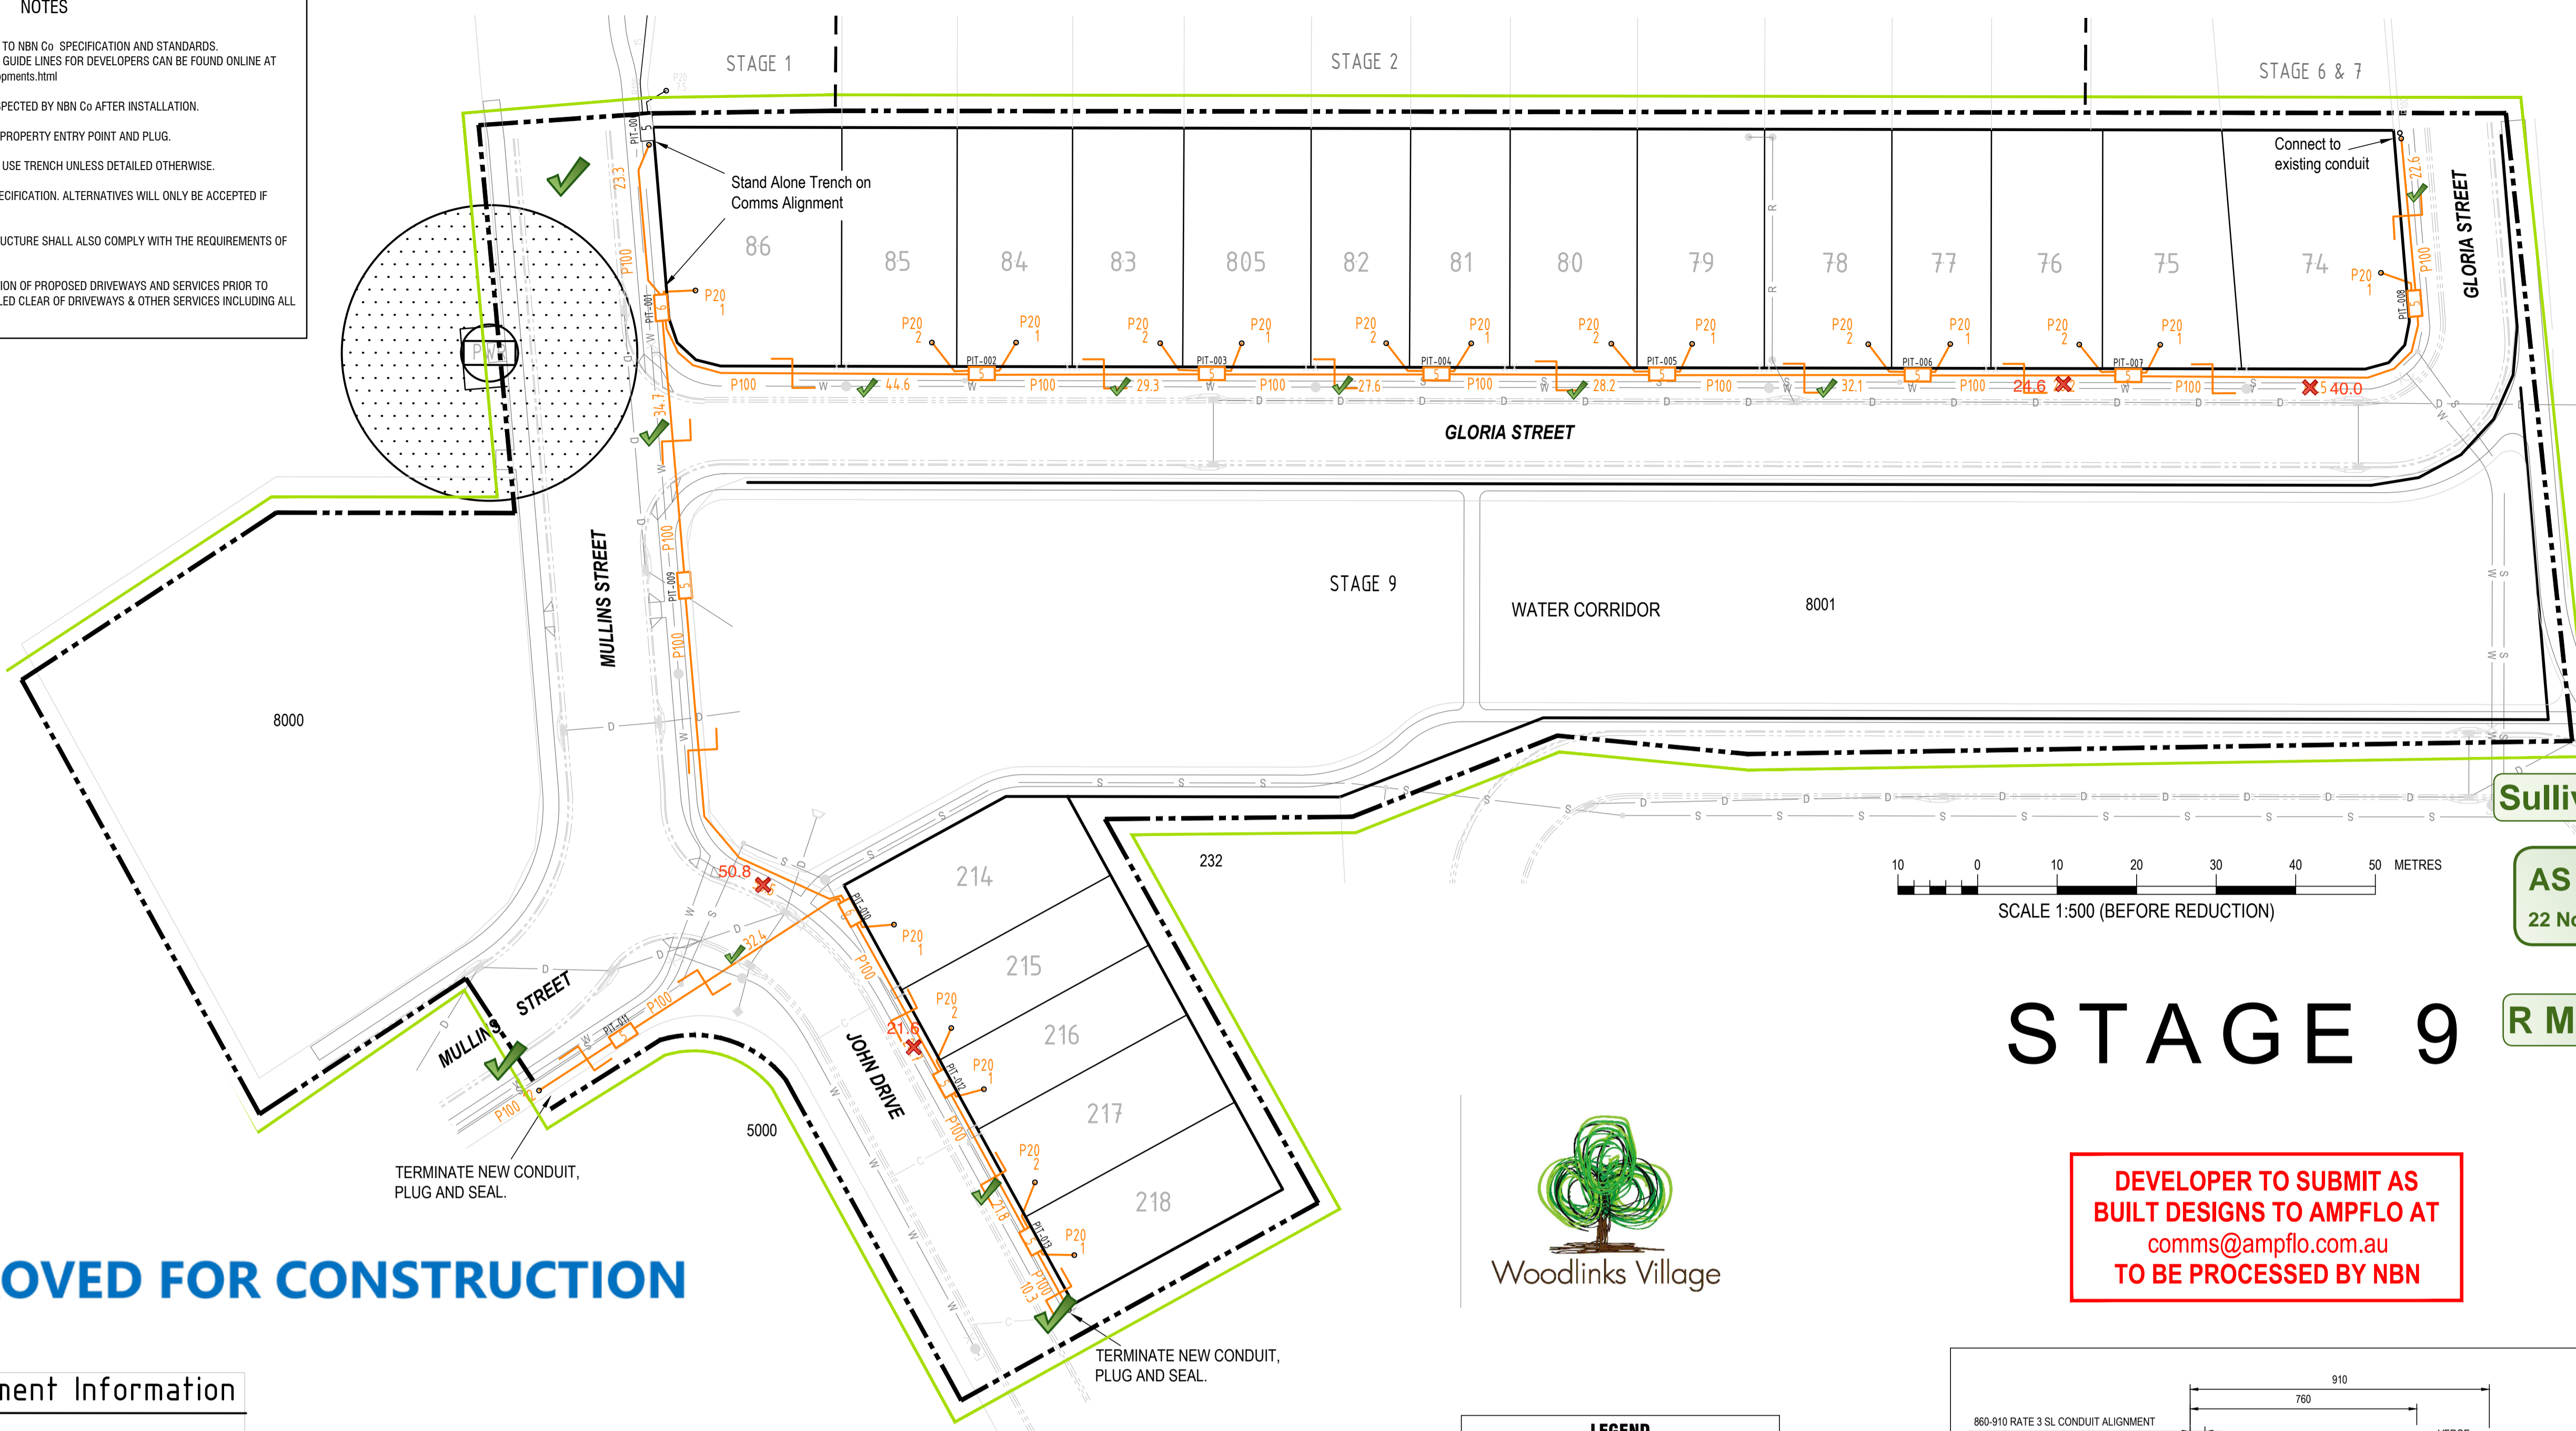

Sullivan Underground Services

AS CON
22 Nov 2020

R Morgan



STAGE 9

APPROVED FOR CONSTRUCTION

SDU Development Information

Development Name:
246 Collingwood Dr COLLINGWOOD PARK

Developer Company:
Canberra Estates Consortium NO 36 Pty Limited

Development Address:
246 Collingwood Dr COLLINGWOOD PARK

Authorised Rep:
Ampflo Pty Ltd
Phone: 07 3372 9280
E-Mail: comms@ampflo.com.au

nbn Reference Number: STG Stage Number: 9


Design Revision: A

BILL OF MATERIAL

NO OF LOTS: 19 ✓

PITS		DUCTS		
SIZE	QTY	SIZE	QTY	MTRS
2	0	P100	16	465.8
5	11	P50	0	0
6	2	P20	19	27
8	0			
9	0			

TOTAL NUMBER OF PITS: 13 ✓
 TOTAL NUMBER OF MANHOLES: 0
 TOTAL NUMBER OF CONDUITS: 35
 TOTAL LENGTH OF CONDUITS: 492.8
 STAND ALONE TRENCHING : 25m

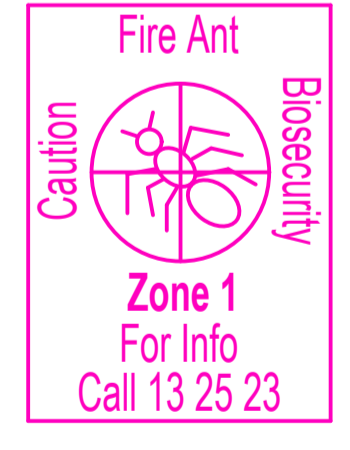


DO NOT CONSTRUCT DRIVEWAYS/CROSSOVERS UNTIL ELECTRICAL WORKS ARE COMPLETED.


- LEGEND**
- EXISTING TELSTRA UG CABLE
 - EXISTING AERIAL CABLE
 - TELSTRA PLANT IN SHARED UTILITY TRENCH
 - PROPOSED NBN UNDERGROUND CONDUIT IN SHARED UTILITY TRENCH
 - Service Drop Access Pit (650mmx280mmx365mm)
 - Network Boundary/Local Network Pit (Single Lid) (700mmx450mmx365mm)
 - Distribution/Local Network Connection Pit (1360mmx555mmx360mm)
 - Fibre Distribution Hub (FDH) Pit (2000mmx555mmx300mm)
 - Existing Telstra manhole
 - Existing Telstra Pit (2,3,4,5,6,7,8,9)
 - Telstra exchange
 - Example of Telstra Major Conduit Layout with Proposed duct marked to be used by NBN
 - Premise Connection Device (PCD)
 - Fan Access Node site (FAN)
 - Multi Dwelling Unit (MDU)



DEVELOPER TO SUBMIT AS BUILT DESIGNS TO AMPFLO AT comms@ampflo.com.au TO BE PROCESSED BY NBN

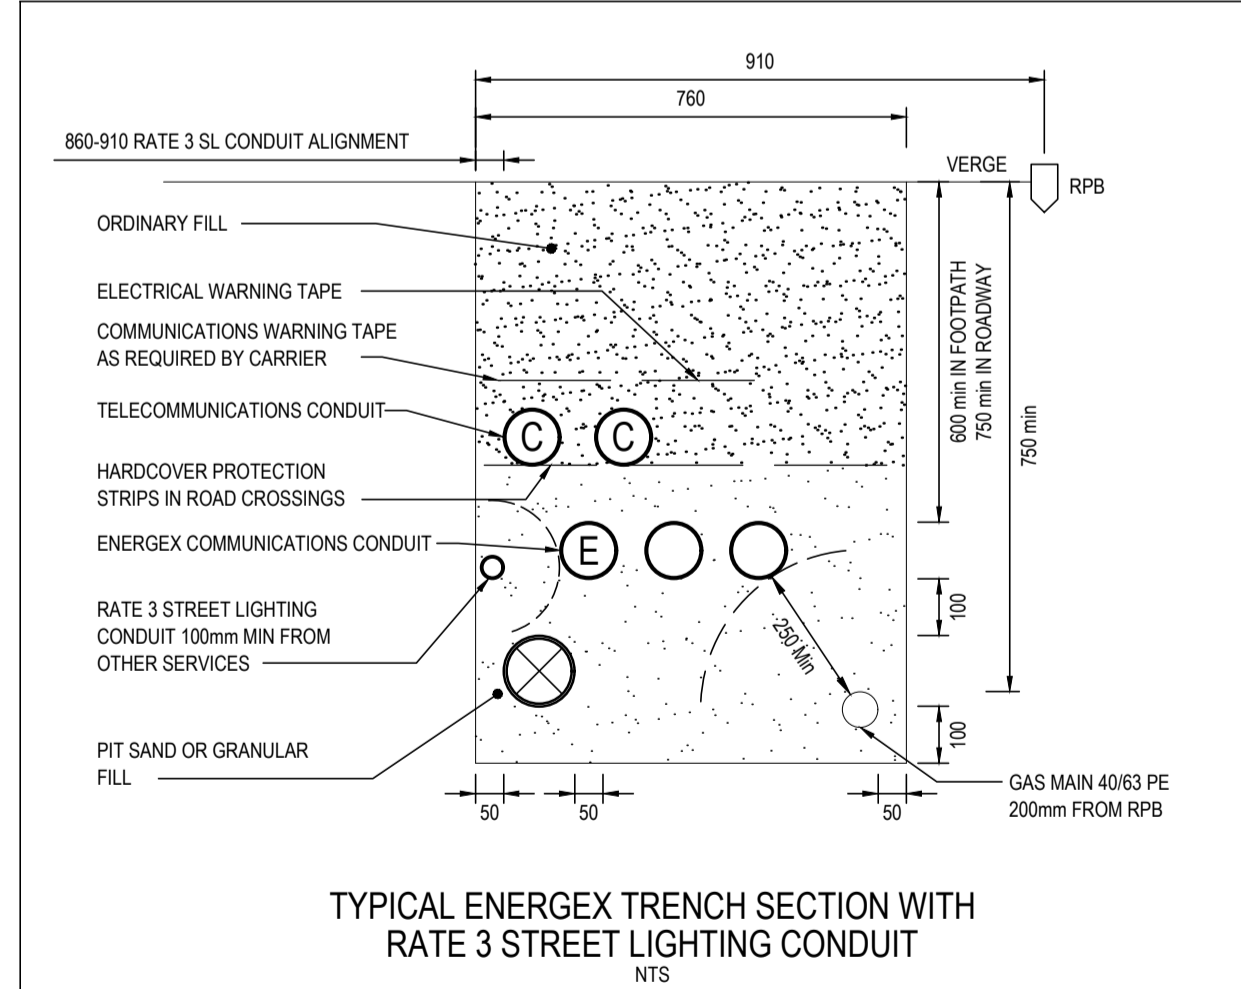

REFER TO DWG S2601679 FOR RATE 3 STREET LIGHTING.

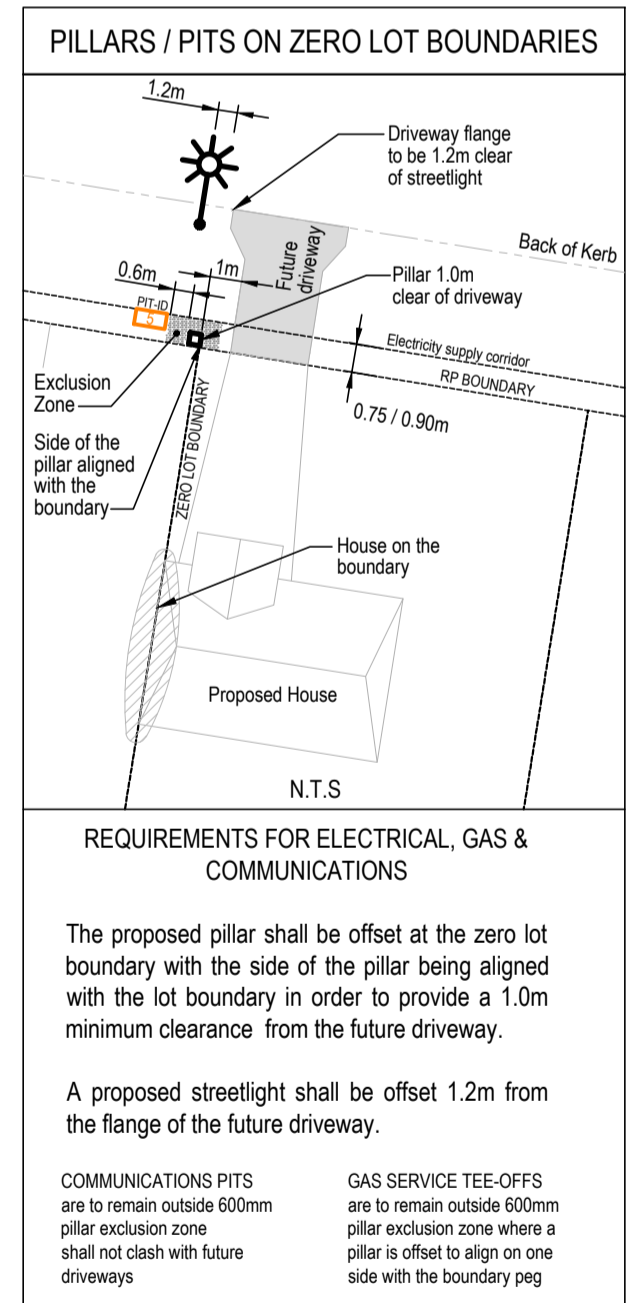

REV	DATE	DRAFTER	DESCRIPTION	APPROVED
A	17.08.20	JB	Initial Design	CR

STRICTLY CONFIDENTIAL

NBNCO APPROVAL RECORD:

SIGNATURE _____ DATE _____

DD _____
 WD _____
 AB _____

QUALITY RECORD :

NBNCO DISCLAIMER
 THIS DOCUMENT HAS BEEN PREPARED SOLELY FOR THE USE OF NBNCO LIMITED (ABN 86 136 533 741) FOR USE IN MAINTAINING NBNCO FACILITIES. IT HAS NOT BEEN CREATED FOR ANY OTHER USE. IT SHOULD NOT BE SCALED TO LOCATE NBNCO ASSETS. NO WARRANTY IS GIVEN THAT THE INFORMATION IS ACCURATE OR COMPLETE.

Australia's broadband network

ampflo
 ABN 28 111 423 842
 Electrical and Telecommunications Consultants
 07 3372 9280 - projects@ampflo.com.au
ampflo.com.au

KEY PLAN

DRAWING TITLE:
246 Collingwood Dr COLLINGWOOD PARK

ENABLE#: 280530

STATE: _____ REGION: _____

FSA: _____ SAM: _____ ADA: _____

PROJECT No: 201339

CADREF No: T201339

SCALE 1:500 SHEET No. 1 OF 1 REV. A