

A1									
REV NO	DATE	REVISION PURPOSE / DESCRIPTION	DRAWN	RPEQ	RPEQ No	INITIALS	DATE		
A	14.12.2023	Builders Issue							

DRAWN	TG	14.12.2023
CHECKED	CU	14.12.2023
APPROVED		

saunders havill group
 Saunders Havill Group Pty Ltd ABN 24 144 972 949
 head office 5 Thompson St Bowen Hills Q 4006
 phone 1900 628 5HG web www.saundershavill.com
 ■ surveying ■ town planning ■ urban design ■ environmental management ■ landscape architecture
 Drawing No: 6777 S 72 AC A

UrbanUtilities

WOODLINKS VILLAGE - STAGE 20
COLLINGWOOD PARK
PLAN OF ADAC SURVEY DATA
SEWERAGE RETICULATION 22-PNT-56373

DRAWING STATUS	
AS CONSTRUCTED	
SHEET 2 OF 6 SHEETS	
DRAWING NO.	REV.
	A



EMT N
SP332780

EMT M
SP332780

EMT L
SP332780

EMT J
SP332780

5007 (Pt)




WATER FITTINGS LEGEND

- Hydrant
- Valve
- Bend
- Water Fitting
- Dead End Cap
- Reducer
- Water Meter
- Conduit Crossing and Service Pipe

SEE SHEET 2

SEE SHEET 2

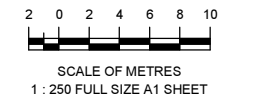

A1

REV NO	DATE	REVISION PURPOSE / DESCRIPTION	DRAWN	RPEQ	RPEQ No
A	14.12.2023	Builders Issue			

DRAWN	TG	14.12.2023
CHECKED	CU	14.12.2023
APPROVED		

saunders havill group
 Saunders Havill Group Pty Ltd ABN 24 44 592 549
 head office 9 Thompson St Bowen Hills Q 4006
 phone (0)2 433 5161 web www.saundershavill.com
 ■ surveying ■ town planning ■ urban design ■ environmental management ■ landscape architecture


UrbanUtilities

**WOODLINKS VILLAGE - STAGE 20
 COLLINGWOOD PARK**
**PLAN OF ADAC SURVEY DATA
 WATER RETICULATION 22-PNT-56373**

DRAWING STATUS AS CONSTRUCTED	
SHEET 1 OF 3 SHEETS	
DRAWING NO.	REV. A

Drawing No: 6777 S 72 AC A

EAGLE STREET

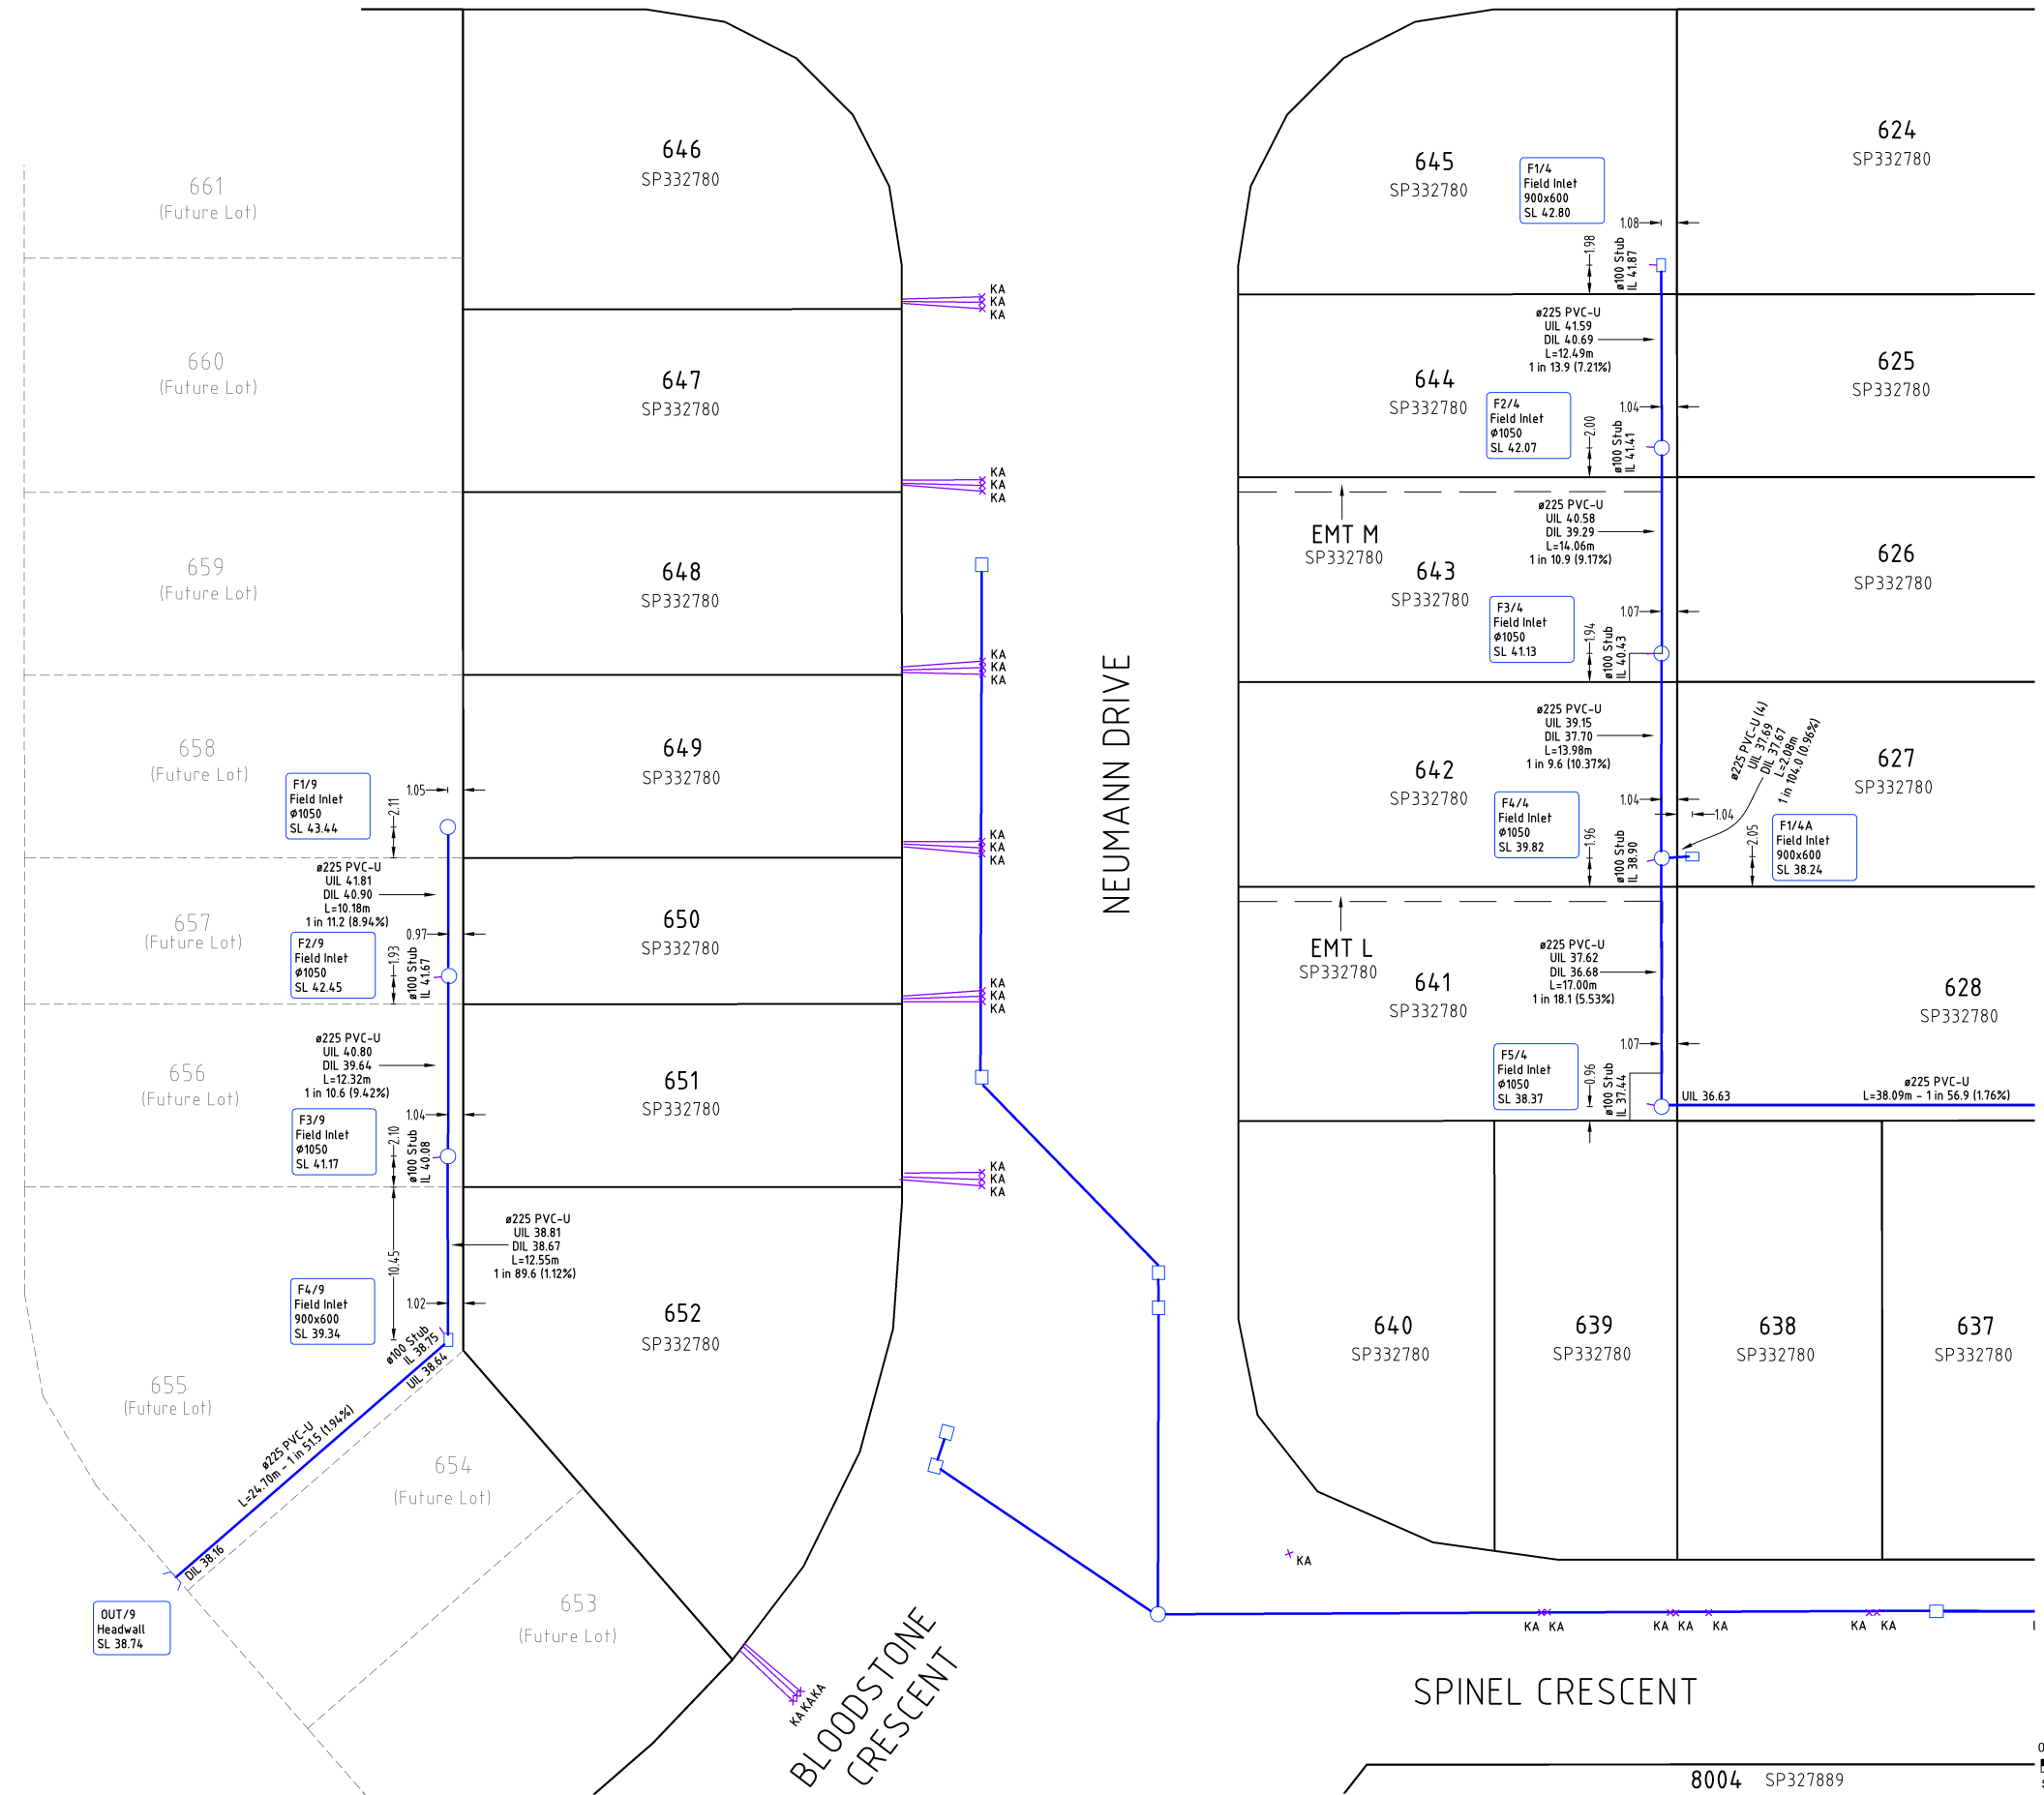


NEUMANN DRIVE

BLOODSTONE CRESCENT

SPINEL CRESCENT

SEE SHEET 2

AS CONSTRUCTED

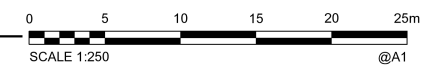

8004 SP327889

A1	INDEX	DATE	REVISIONS	DRAWN	CHECKED	PASSED
	A	19/12/2023	Builders Issue			

DRAWN	CM	14-12-2023
CHECKED	CU	18-12-2023
PASSED		
INITIALS		DATE

saunders havill group
 Brisbane Springfield
 head office 9 Thompson St Bowen Hills Q 4006
 phone 1900 423 SHG web www.saundershavill.com
 Drawing No: 6777 S 73 AC A

Colliers INTERNATIONAL

City of Ipswich

IPSWICH CITY COUNCIL
 AS CONSTRUCTED - ROADS & DRAINAGE
 WOODLINKS VILLAGE - STAGE 20
 COLLINGWOOD PARK

SCALE	1:250
SHEET	1 OF 3 SHEETS
DRAWING NO.	




EAGLE STREET

CAMEO COURT

SPINEL CRESCENT

SPINEL CRESCENT

8004 SP327889

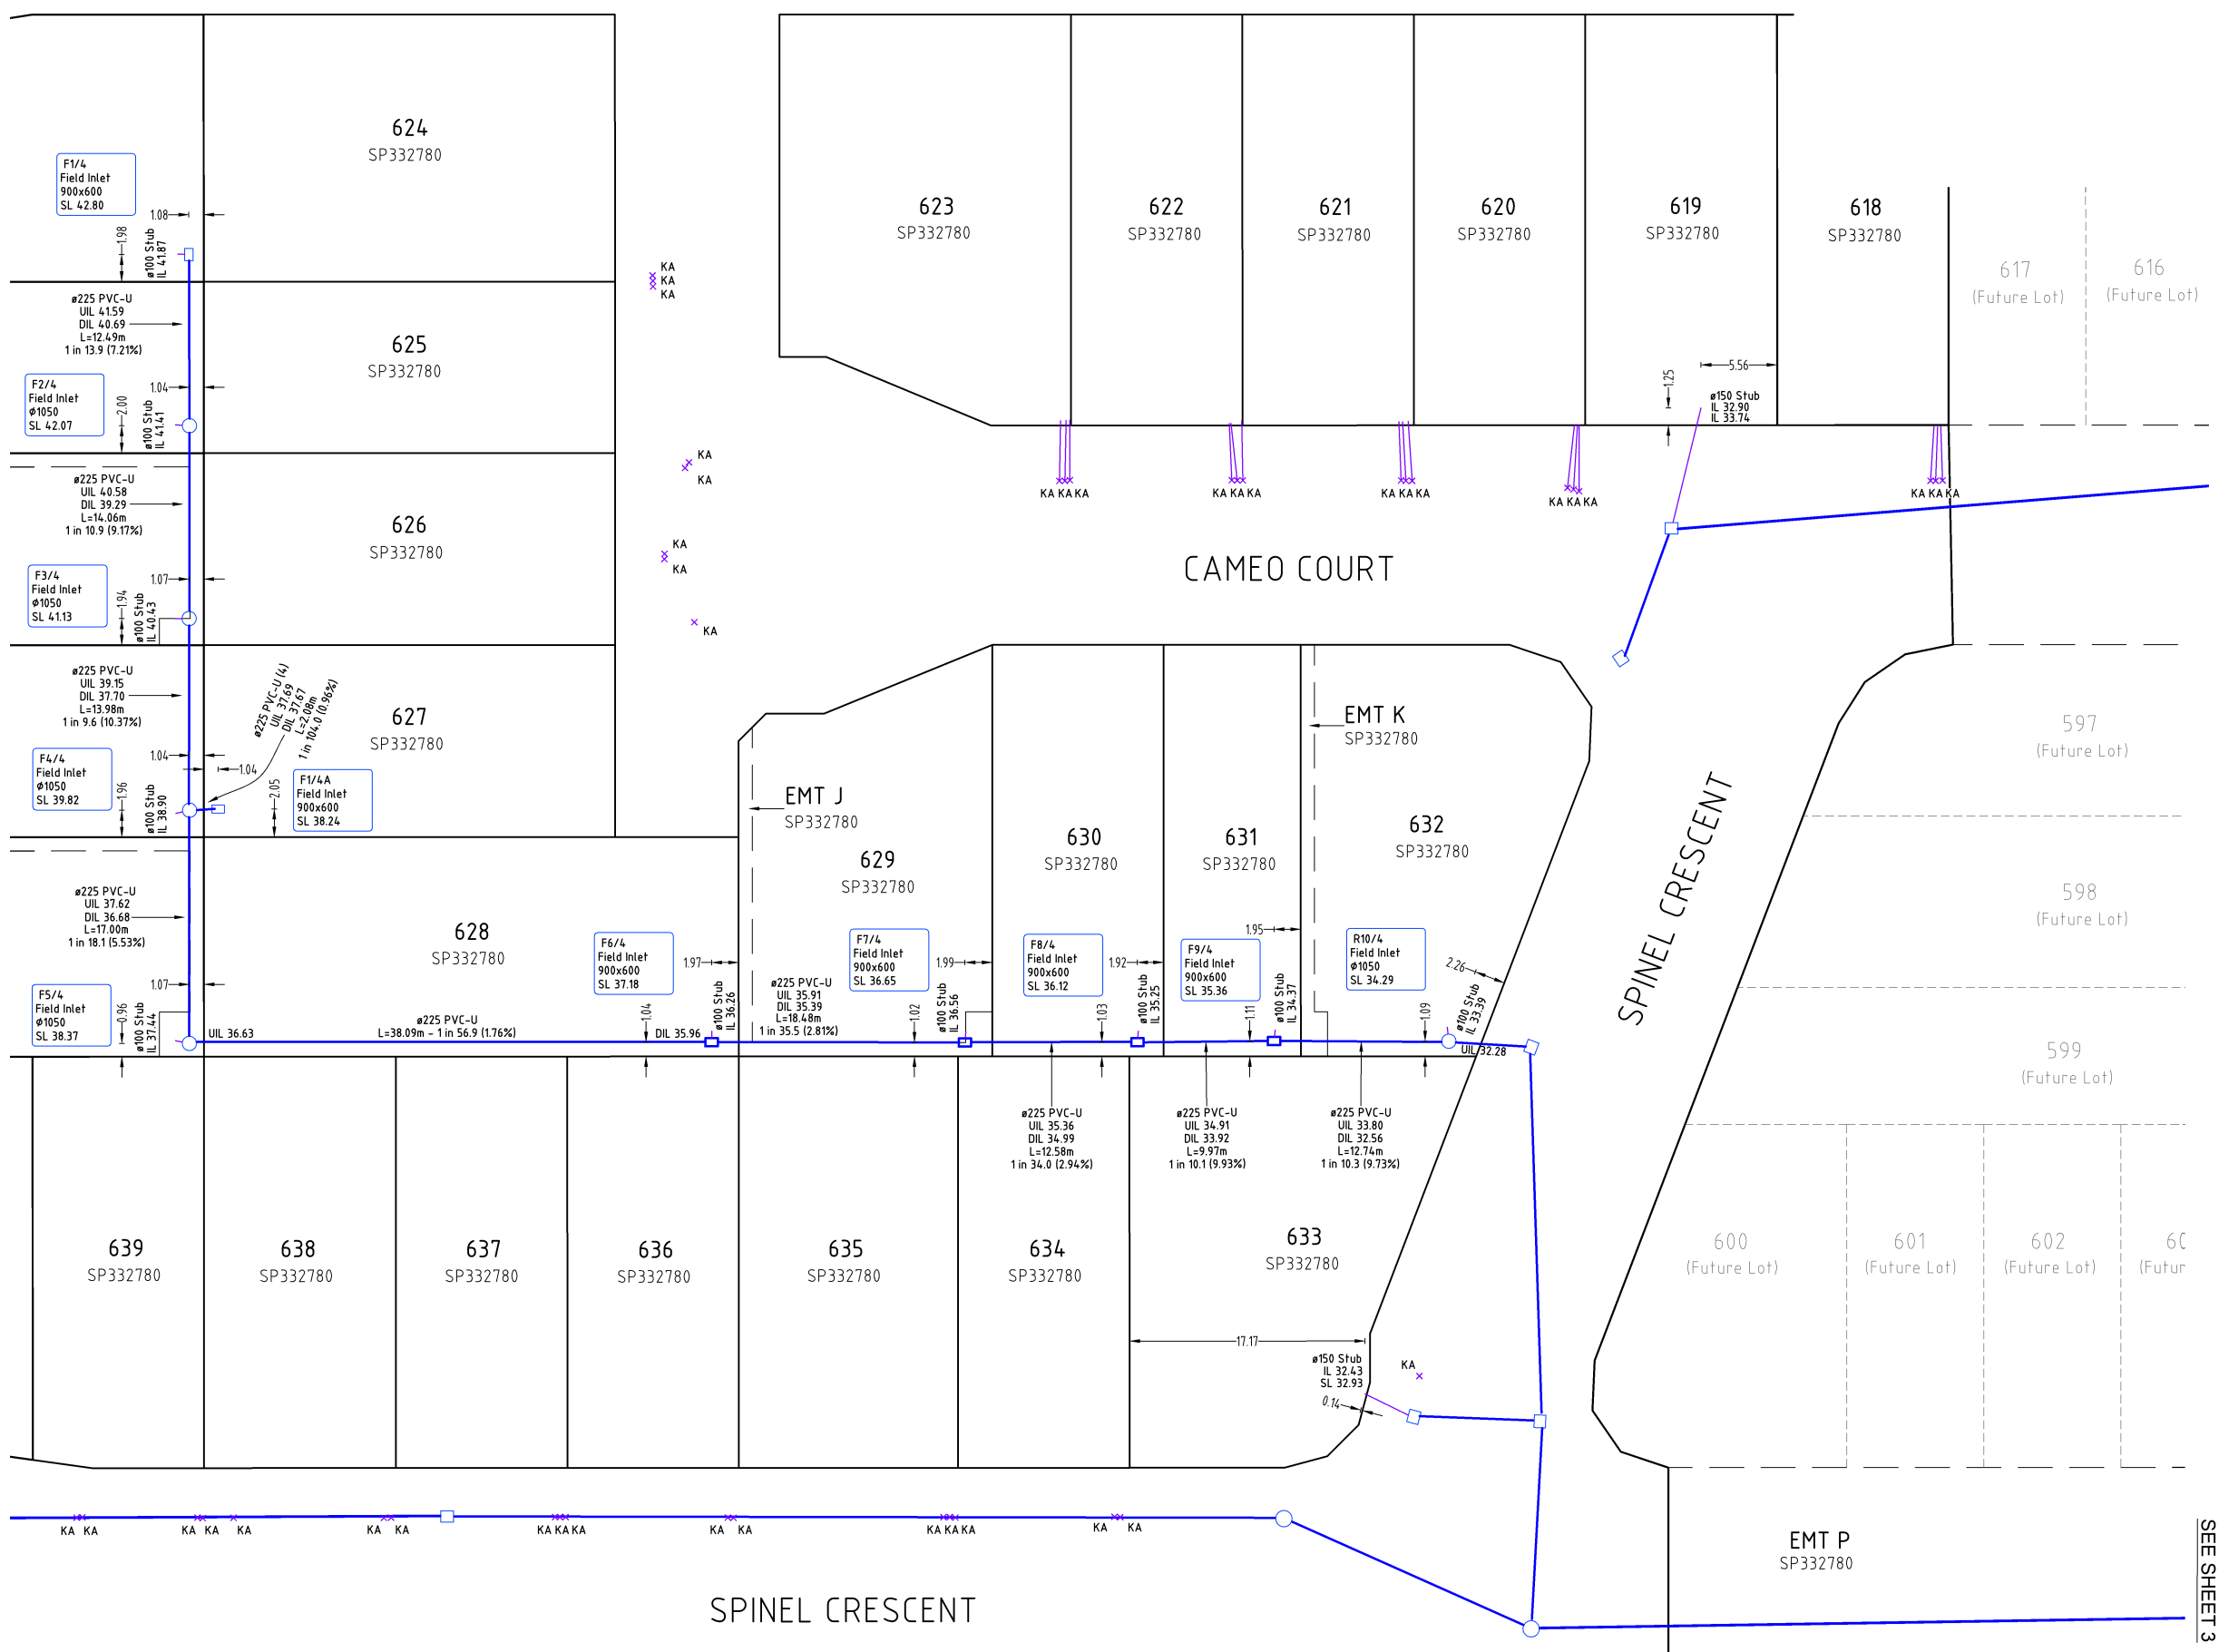


SEE SHEET 1

SEE SHEET 3

SEE SHEET 3

AS CONSTRUCTED

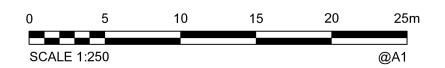

A1									
	A	19/12/2023	Builder's Issue						
INDEX	DATE	REVISIONS	DRAWN	CHECKED	PASSED				

DRAWN	CM	14-12-2023
CHECKED	CU	18-12-2023
PASSED		
INITIALS	DATE	

saunders havill group
 Brisbane Springfield
 head office 9 Thompson St Bowen Hills Q 4006
 phone 1900 423 SHG web www.saundershavill.com
 Drawing No: 6777 S 73 AC A


Colliers INTERNATIONAL

City of Ipswich


IPSWICH CITY COUNCIL
 AS CONSTRUCTED - ROADS & DRAINAGE
 WOODLINKS VILLAGE - STAGE 20
 COLLINGWOOD PARK

SCALE	1:250
SHEET	2 OF 3 SHEETS
DRAWING NO.	

EAGLE STREET

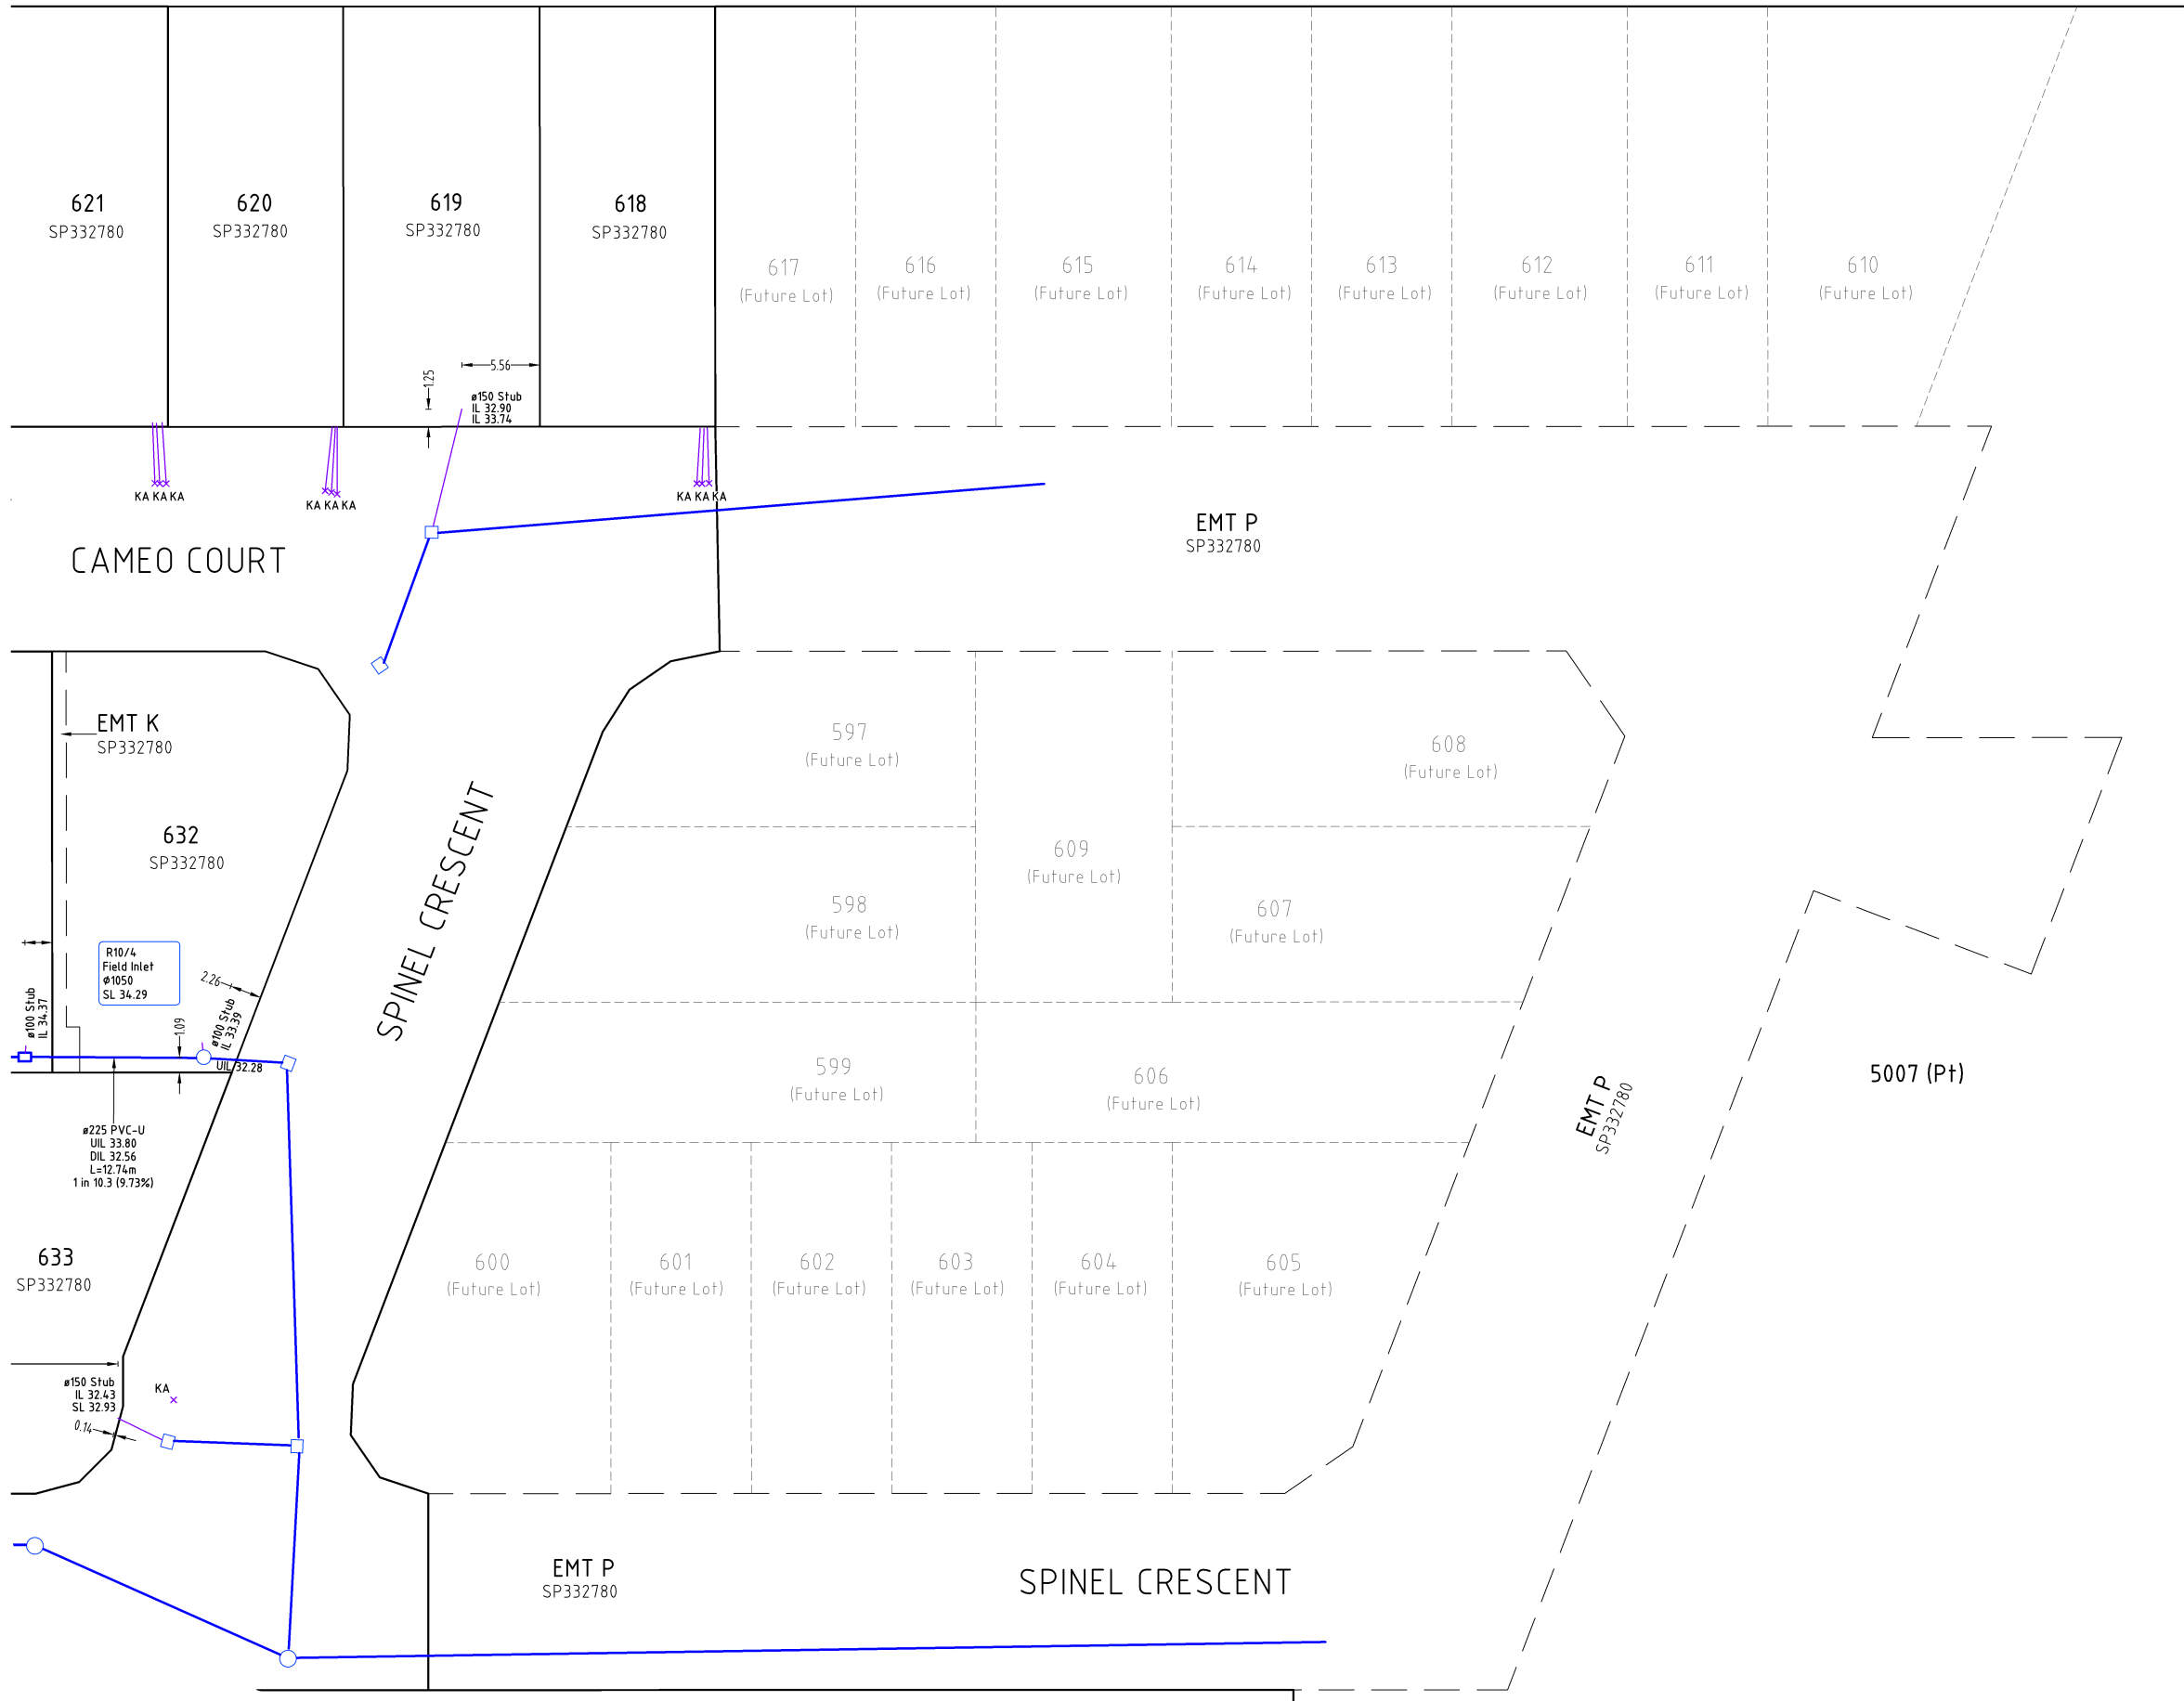

AS CONSTRUCTED

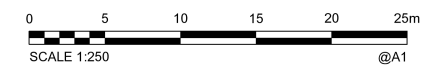

A1

INDEX	DATE	REVISIONS	DRAWN	CHECKED	PASSED
A	19/12/2023	Builders Issue			

DRAWN	CM	14-12-2023
CHECKED	CU	18-12-2023
PASSED		
INITIALS	DATE	

saunders havill group
 Brisbane Springfield
 head office 9 Thompson St Bowen Hills Q 4006
 phone 1800 423 SHG web www.saundershavill.com
 Drawing No: 6777 S 73 AC A

Colliers INTERNATIONAL

City of Ipswich

IPSWICH CITY COUNCIL
 AS CONSTRUCTED - ROADS & DRAINAGE
 WOODLINKS VILLAGE - STAGE 20
 COLLINGWOOD PARK

SCALE	1:250
SHEET	3 OF 3 SHEETS
DRAWING NO.	